

STATE OF TEXAS
STATE DEPARTMENT OF HIGHWAYS AND PUBLIC TRANSPORTATION

PLANS OF PROPOSED
STATE HIGHWAY IMPROVEMENT

CONTROL 0074-06-164
FEDERAL AID PROJECT NO. HES000S(606)
US 181

NUECES COUNTY
LIMITS: FROM SOUTH END OF CORPUS CHRISTI SHIP CHANNEL BRIDGE TO 0.47 MILES WEST,
NET LENGTH OF PROJECT = 3581.6 FT = 0.670 MI.
CONSTRUCTION OF: THE UPGRADING OF A FREEWAY FACILITY CONSISTING OF
THE WIDENING OF AN EXISTING STRUCTURE, REPLACEMENT OF METAL
BEAM GUARD FENCE, AND TRAFFIC RAILING.



END PROJECT
STA 24+81.6
CONT. 0074-06-164

NO RAILROAD CROSSINGS
EQUATION: 32+04.37 BK = 21+04.37 FWD
NO EXCEPTIONS

DESCRIPTION	SHEET NO.
TITLE SHEET	1
TRAFFIC CONTROL PLAN AND LC(16)-2 *	2-5
GENERAL NOTES AND SPECIFICATION DATA	6-6A
ESTIMATE AND QUANTITY	7
EXISTING PLAN SHEETS	8-9
PROPOSED PLAN SHEETS AND INLET ADJUSTMENT SUMMARY	10A-10B+
RETAINING WALL LAYOUTS	11-15A-Field Change #2 and #4
RETAINING WALL EXTENSIONS AND TSOI	16-17-Field Change #2
RAIL RETROFIT	
INLET ADJUSTMENTS	18-18A
GRATE DETAILS	19
ILLUMINATION ESTIMATE & QUANTITY, SUMMARY, AND DETAILS	20-36
RID (1)-88 THRU RID (2)-88	37-38
RID (3)-88 (MOD)	39
RID (4)-88	40
RID (5)-88 (MOD)	41
RID (6)-88 (MOD) THRU RID (7)-88	42-43
BRIDGE LAYOUT & DETAILS	44-55
* RR 8 & RR-9	56-49-A Field Change #1
* TSOI	57
* TSOI R	58
* GREAT-89	59
* GF(TD)-87 (DIST 15)	60
* GF(3)	61
* TCP(5-1) 91	62
* TCP(5-2) 91	63
* TB(MBGF)-88	64
* TRF	65
* CLF-90	66
* BC(1)-89 THRU BC(7)-89	67-73

+ 10 NOT USED

* THE ABOVE STANDARD SHEETS SPECIFICALLY IDENTIFIED HAVE BEEN
ISSUED BY ME AND ARE APPLICABLE TO THIS PROJECT.



RESPONSIBLE ENGINEER

DATE

DESIGN SPEED 50MPH
PRESENT (1985) ADT 41,600
FUTURE (2006) ADT 78,800
DESIGN HOURLY VOL. 10.4%
DIRECTIONAL DISTRIBUTION 66-34%
PERCENT TRUCKS (ADT) 4.6%

SPECIFICATIONS ADOPTED BY THE STATE DEPARTMENT OF HIGHWAYS & PUBLIC
TRANSPORTATION OF TEXAS, SEPTEMBER 1, 1982, AND SPECIFICATION ITEMS
LISTED AND DATED AS FOLLOWS, SHALL GOVERN ON THIS PROJECT:
REQUIRED CONTRACT PROVISIONS FEDERAL AID CONSTRUCTION
CONTRACTS (FORM FHWA 1273, AUGUST, 1989) AND ADDENDUM TO FHWA FORM
FHWA 1273, REQUIRED CONTRACT PROVISIONS, FEDERAL AID CONSTRUCTION CONTRACTS
(FEBRUARY, 1991)

CERTIFICATION FOR FINAL PLANS

Project was built according to the Plans and
Specifications. These final Plans reflect the
work done and the quantities shown thereon
and on the final estimate are final quantities.

Final Plans

Contractor: Hess-Anderson Const. Inc.
Date Work Began: Aug 28, 1991
Date Work Completed: April 21, 1992
Contract Amount: \$ 590,827.91
Final Estimate: \$ 591,573.55
Working Days Allotted: 111
Working Days Used: 109

BRIDGES: 180.0 FT. = 0.034 MI.

ROADWAY: 3401.6 FT. = 0.644 MI.
TOTAL: 3581.6 FT. = 0.670 MI.



Supervising Resident Engineer

DATE

FIELD CHANGES

- FC.#1, To modify the design of the proposed Concrete Slab Extension on the East side of bridge.
- FC.#2, To remove existing concrete in order to place T-501 (Retrofit) Rail and replace concrete after the work on said Rail is completed. Along Retaining Wall C replace the existing two course surface treatment removed because of placement of T-501 (Retrofit) Rail with concrete Riprap.
- FC.#3, Reduction of Bid prices for Item No. 450, Conc. Traffic Rail.
- FC.#4, Construction of a Horizontal Inlet against the proposed outside Traffic Rail.
- FC.#5, Reduction of Bid Prices for Item No. 422, 423, 425 and 430.
- FC.#6, Increase total Plan Quantity for Item No. 502, "Barricades, Signs, and Traffic Handling".
- FC.#7, Purchase of Metal Beam Guard Fence Timber Post.

RETURN TO
RECORDS MANAGEMENT
DEPARTMENT OF
TRANSPORTATION

STATE DEPARTMENT OF HIGHWAYS
AND PUBLIC TRANSPORTATION

Rev. 2-B-91
Rev. 12-14-90

SUBMITTED BY: 21 Sep 90
SUPERVISING RESIDENT ENGINEER
RECOMMENDED FOR LETTING: April 21, 1992
DISTRICT DESIGN ENGINEER
RECOMMENDED FOR LETTING: 5/1/91
DISTRICT ENGINEER

APPROVED FOR LETTING: 5-14-91
APPROVED FOR LETTING: 5-14-91
APPROVED FOR LETTING: 5-21-91
CHIEF ENGINEER OF HIGHWAY DESIGN

U.S. DEPARTMENT OF TRANSPORTATION
FEDERAL HIGHWAY ADMINISTRATION
APPROVED: Robert R. Kowalski, P.E.
DIVISION ADMINISTRATOR
DATE



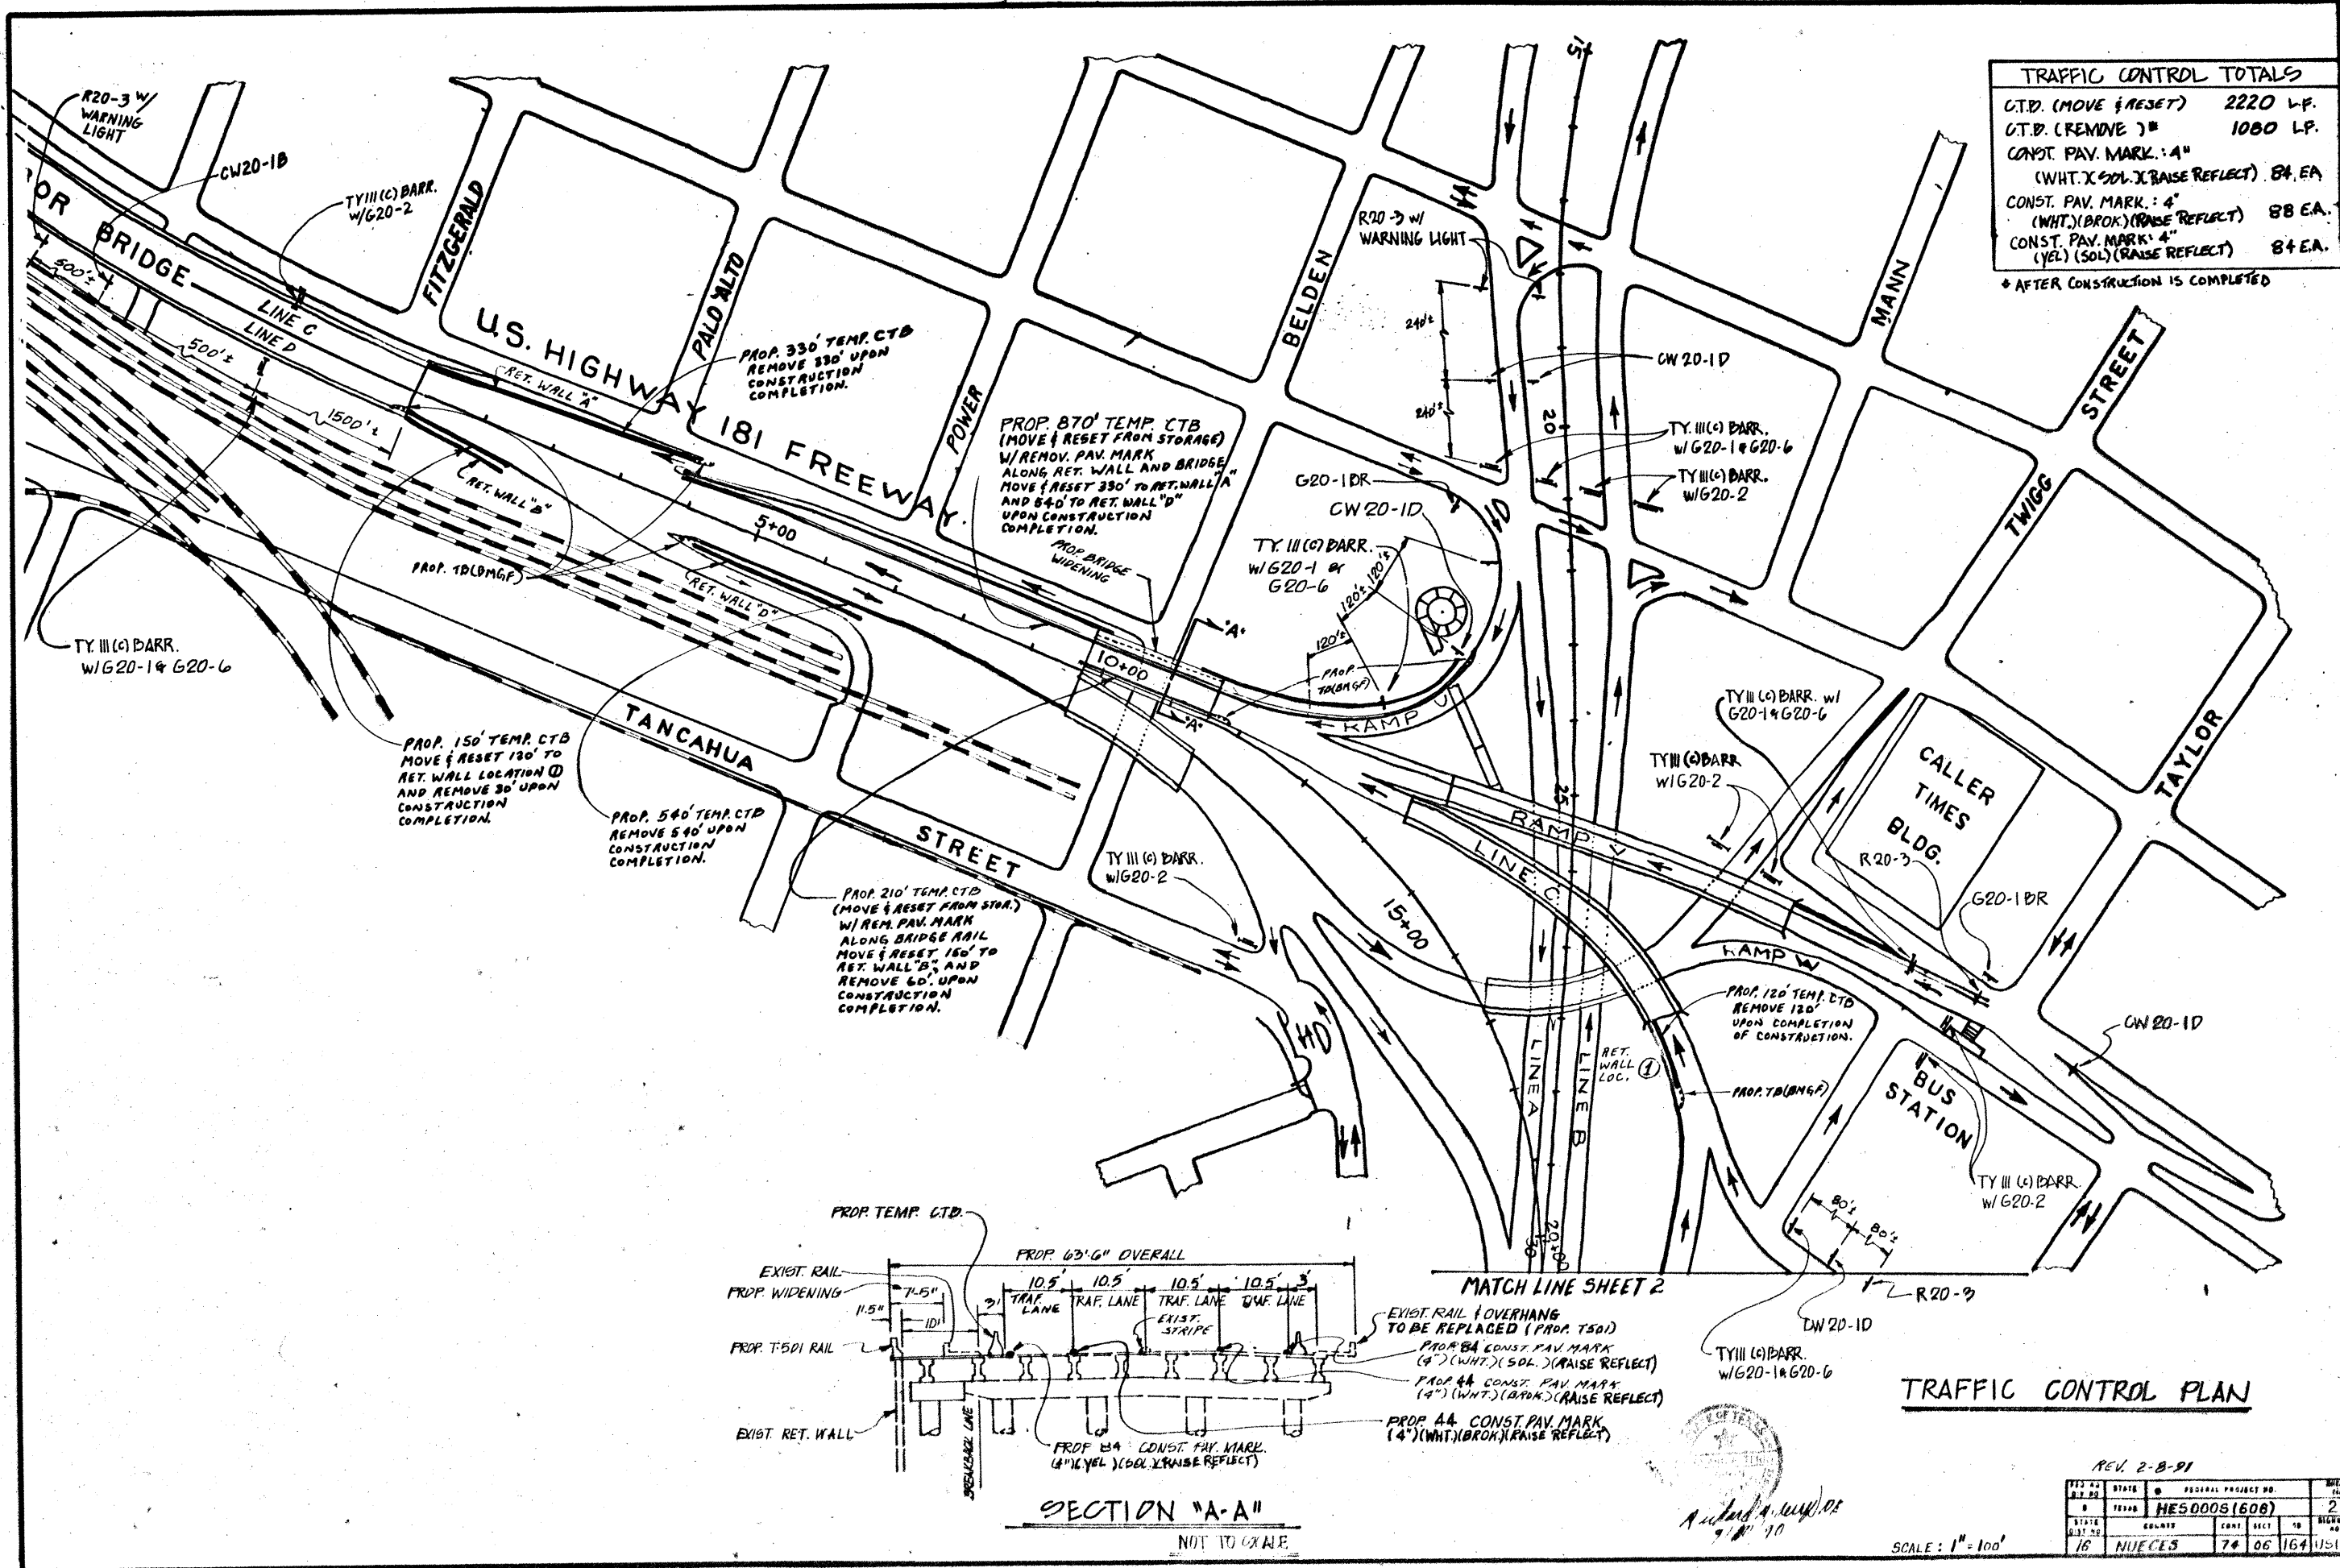


FIG. NO.	SHEET NO.	FEDERAL PROJECT NO.	SHEET NO.
16	16	HES00061608	2
16	16	74	06
16	16	164	164

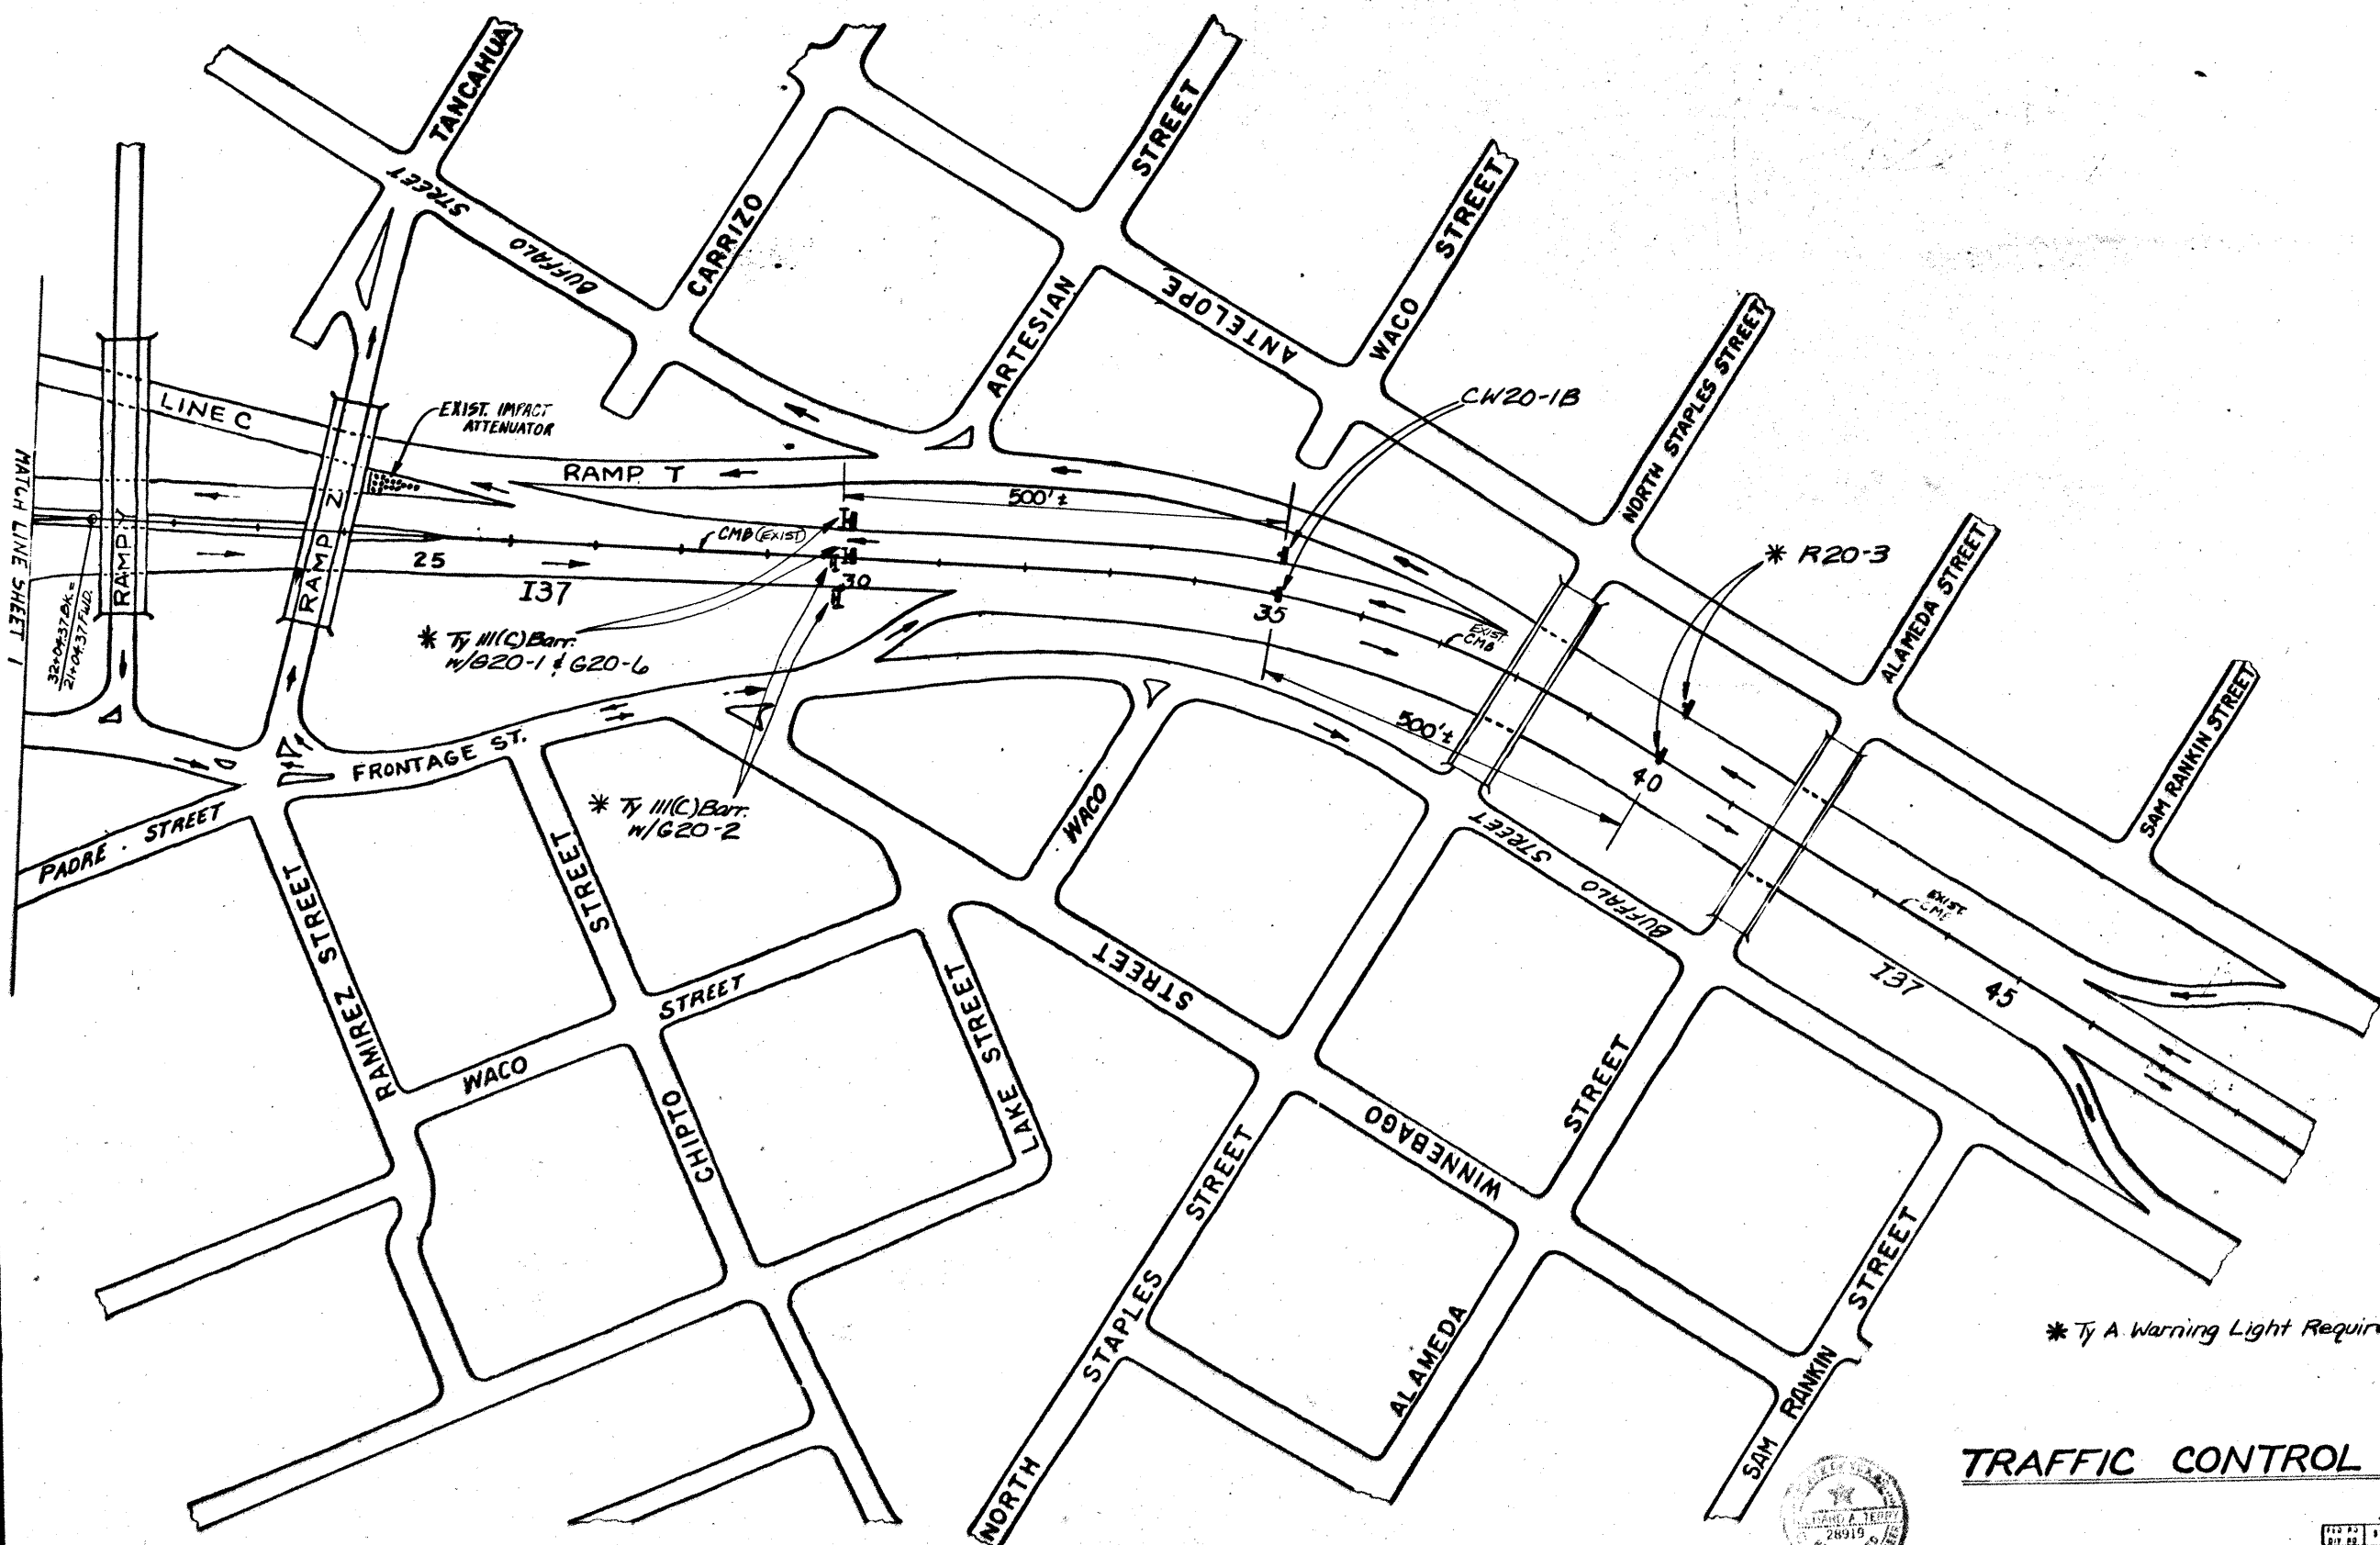

* Ty A Warning Light Required

TRAFFIC CONTROL PLAN

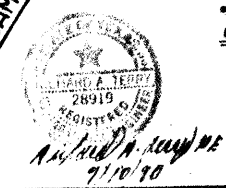


SCALE: 1" = 100'

Sheet 2 of 3


FED. RD. DIST. NO.	STATE	FEDERAL PROJECT NO.	SHEET NO.
0	TEXAS	HE50005(608)	3
STATE DIST. NO.	COUNTY	CONTRACT	SECTION
16	NUECES	74	6

164 US181

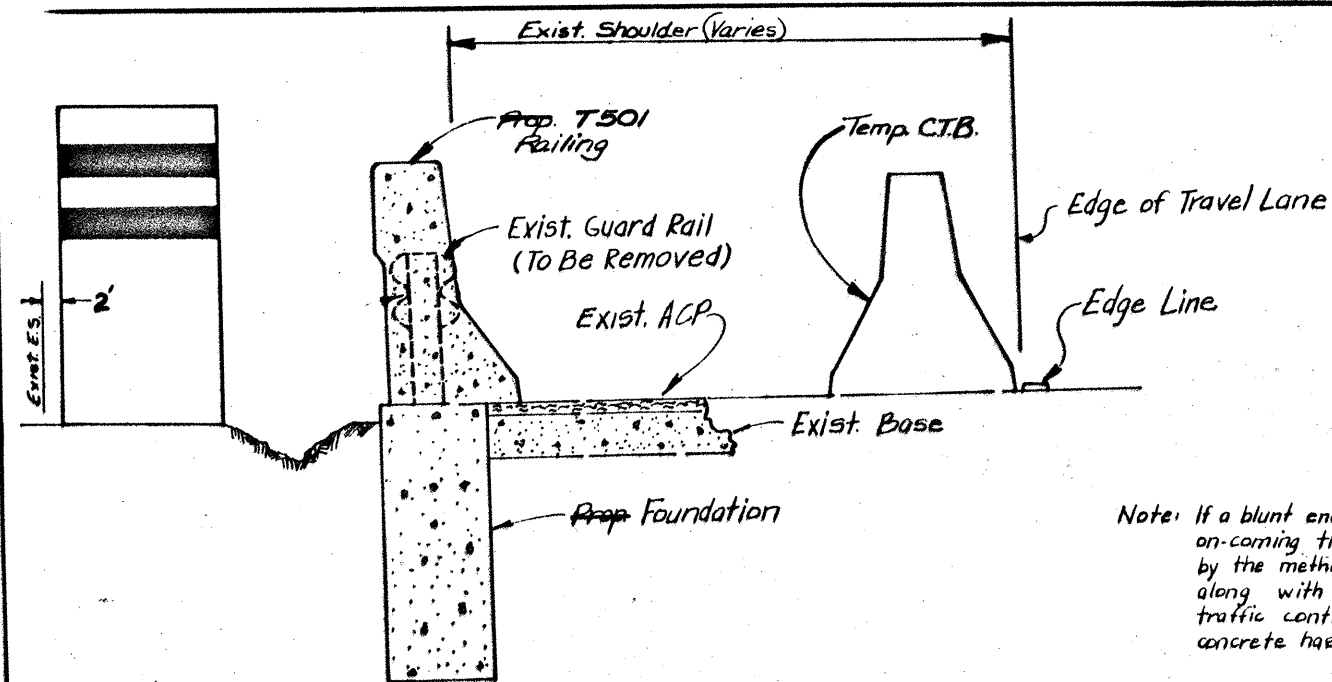

SECTION A-A

Note: If a blunt end or form is left facing on-coming traffic, it shall be protected by the method shown on sheet 1B-(BMGF)-28 along with traffic control shown. The traffic control shall remain in place until concrete has 500 lb. beam break.

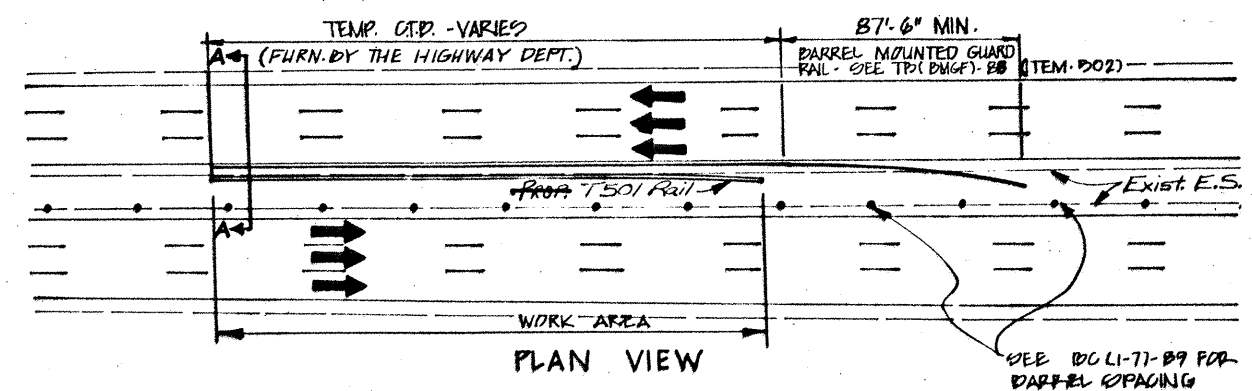

PLAN VIEW

TRAFFIC CONTROL PLAN




1-2-2014 4:00 PM/DE
9/10/90

Rev. 2-8-91


Sheet 3 of 3

FED. RD. DIST. NO.	STATE	FEDERAL PROJECT NO.	SHEET NO.
16	TEXAS	HE30008(608)	4
COUNTY	CONTRACT NO.	SECTION	HIGHWAY NO.
NUECES	077	06	164



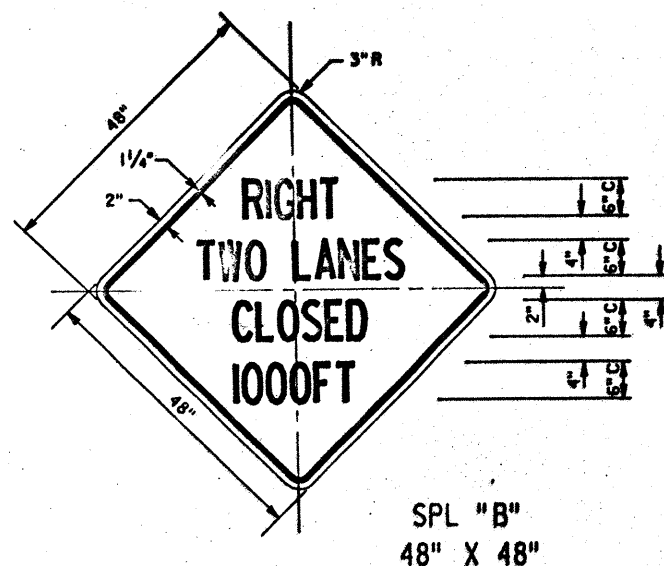

NOTE: ARROWS ARE SYMMETRICAL ABOUT CENTERLINES.

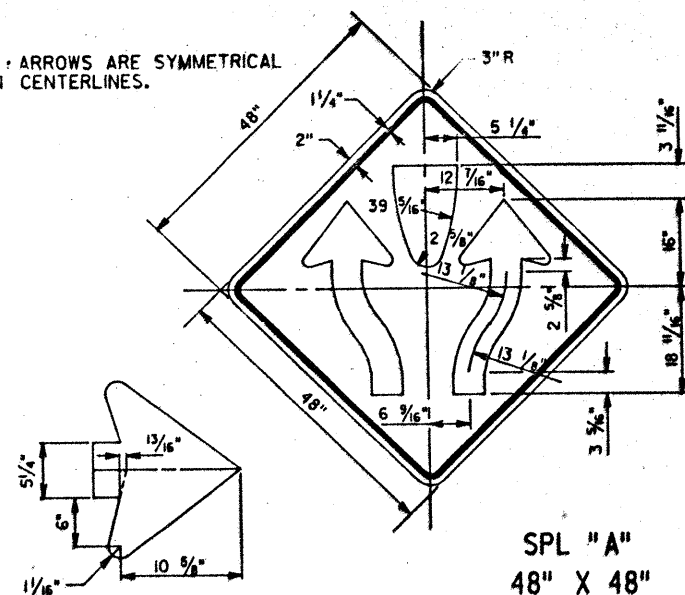

GENERAL NOTES


1. THE TRAFFIC CONTROL DEVICES SHOWN ARE THE MINIMUM REQUIRED. ADDITIONAL TRAFFIC CONTROL DEVICES MAY BE NECESSARY TO ROUTE TRAFFIC AROUND THE WORK AREA.
2. THE FOLLOWING TRAFFIC CONTROL DEVICES SHALL BE PLACED IN ADVANCE OF THE PROJECT LIMITS. OBSERVE WARNING SIGNS STATE LAW (R20-3), END CONSTRUCTION (G20-2), CONTRACTORS NAME (G20-6), ROAD CONSTRUCTION NEXT XX MILES (G20-1), AND TYPE III (C) BARRICADES.
3. SIGNING SHOWN FOR ONE DIRECTION ONLY.
4. CONES SHALL BE A MINIMUM HEIGHT OF 28\".
5. ARROW PANEL SHALL BE TYPE C (15 LAMPS, MINIMUM SIZE OF 48\" X 96\").
6. ONE OR MORE FLAGGERS ARE TO BE USED WHERE TRAFFIC, ROAD CONDITIONS, OR TERRAIN WARRANT THEIR USE.

TABLE FOR DIMENSION "X"
(SIGN SPACING)


POSTED SPEED OR 85% SPEED (MPH)	X MIN. DISTANCE (FEET)
30 OR LESS	80
35	120
40	160
45	240
50	320
55	500

LEGEND


- CHANNELIZING DEVICES
- FLAGGER
- TRAILER OR TRUCK MOUNTED ARROW PANEL TYPE C

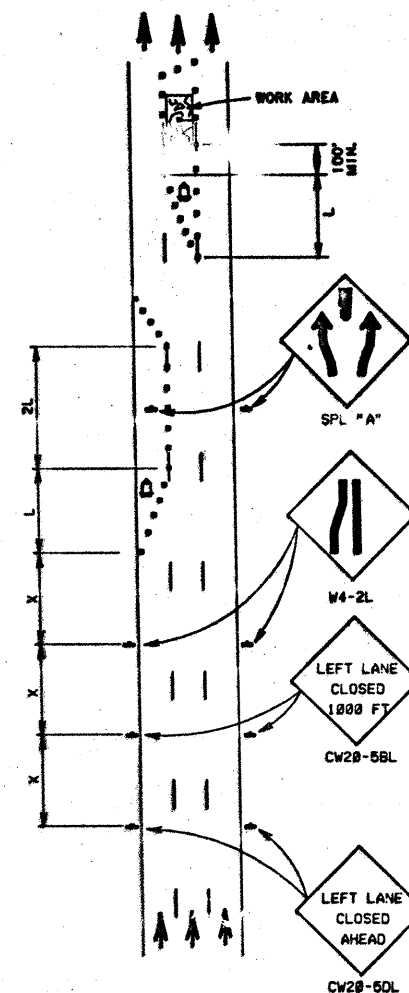

MIDDLE LANE CLOSURE

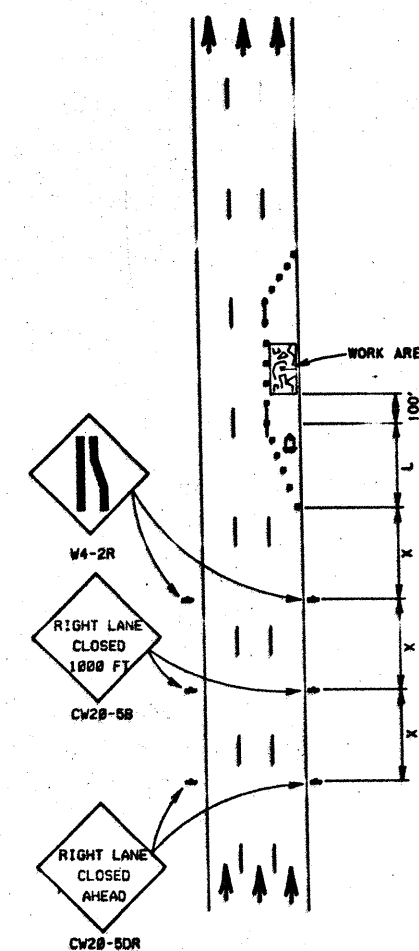

SINGLE LANE CLOSURE

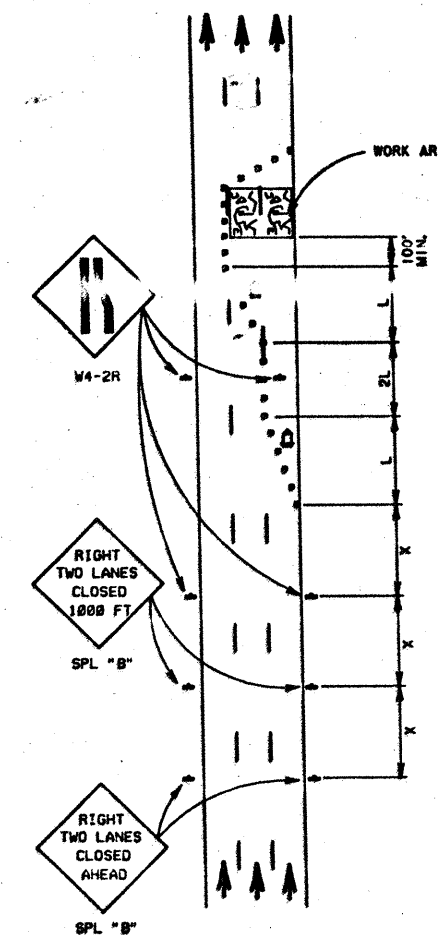

TWO LANE CLOSURE

POSTED SPEED *	FORMULA	MINIMUM DESIRABLE TAPER LENGTHS **			SUGGESTED MAXIMUM SPACING OF DEVICE	
		10' OFFSET	11' OFFSET	12' OFFSET	ON A TAPER	ON A TANGENT
30	$L = \frac{WS^2}{60}$	150'	165'	180'	30'	60' - 75'
35		205'	225'	245'	35'	70' - 90'
40		265'	295'	320'	40'	80' - 100'
45	L=WS	450'	495'	540'	45'	90' - 110'
50		500'	550'	600'	50'	100' - 125'
55		550'	605'	660'	55'	110' - 140'
60		600'	660'	720'	60'	120' - 150'

* 85TH. PERCENTILE SPEED MAY BE USED ON ROADS WHERE TRAFFIC SPEEDS NORMALLY EXCEED THE POSTED SPEED LIMIT.

** TAPER LENGTHS HAVE BEEN ROUNDED OFF.

L = LENGTH OF TAPER (FT)
W = WIDTH OF OFFSET (FT)
S = POSTED SPEED (MPH)



Amended 9/10/90

TRAFFIC CONTROL FOR LANE CLOSURES LC(16)-2

PROJ. NO.	STATE	FEDERAL PROJECT NO.	SHEET NO.
HE30005(606)	TEXAS		54
COUNTY	CITY	STATE	ROUTE
NUECES	74	06	164 US 181

F.R. DIV.6	TEXAS	HES 0008(606)	SHEET 6
NUECES	COUNTY	HWY US 181	CONT 0074-6-164
GENERAL NOTES AND SPECIFICATION DATA--			
GENERAL NOTES AND SPECIFICATION DATA			
PERMANENT STRIPING WILL BE DONE BY STATE FORCES.			
THE FOLLOWING STANDARD DETAIL SHEETS HAVE BEEN MODIFIED: RID (S)-88, RID (S)-88, GPR-2 AND GPR-2.			
ALL EXISTING PAVEMENTS THAT ARE TO REMAIN IN SERVICE THAT ARE CUT BY THE CONTRACTOR IN THE PROCESS OF HIS WORK SHALL BE REPLACED WITH MATERIAL EQUAL TO EXISTING OR AS APPROVED BY THE ENGINEER. REPAIRS SHALL BE MADE IN A TIMELY MANNER AS APPROVED BY THE ENGINEER. THIS WORK WILL NOT BE PAID FOR DIRECTLY BUT WILL BE CONSIDERED SUBSIDIARY TO THE VARIOUS BID ITEMS.			
ITEM 940			
THE CONTRACTOR SHALL APPLY ASPHALTIC CONCRETE TYPE D LEVEL-UP TO WIDENED THE PORTION OF THE BELDEN STREET BRIDGE TO MATCH PREVIOUS OVERLAYS ON THE EXISTING PORTION OF THE STRUCTURE.			
THE STATE DEPARTMENT OF HIGHWAYS AND PUBLIC TRANSPORTATION WILL FURNISH THE LABORATORY BUILDING REQUIRED FOR TESTING ALL ASPHALTIC MATERIAL FOR THIS ITEM. THE CONTRACTOR SHALL PROVIDE ELECTRICITY, WATER AND GAS SERVICE AT THIS FACILITY AT HIS OWN EXPENSE.			
A MINIMUM POLISH VALUE OF 32, WHEN TESTED IN ACCORDANCE WITH TEST METHOD TEX-438-A, WILL BE REQUIRED FOR THE AGGREGATE USED IN THE SURFACE COURSE, UNLESS SILICEOUS AGGREGATE WITH KNOWN SATISFACTORY PERFORMANCE HISTORY BASED ON S.D.H.P.T. SKID TRAILER MEASUREMENTS IS USED. THE SOURCES FOR THESE SATISFACTORY AGGREGATES MAY BE REVIEWED WITH THE RESIDENT ENGINEER ASSIGNED TO THIS PROJECT AND LISTED IN THE "NOTICE TO CONTRACTORS". IF SILICEOUS AGGREGATE IS USED, A MAXIMUM FLAKINESS INDEX OF 17 AS DETERMINED BY TEST METHOD TEX-224-F SHALL APPLY.			
THE SURFACE COURSE SHALL BE CONSTRUCTED IN WIDTHS THAT WILL MAKE THE LONGITUDINAL JOINTS COINCIDE WITH THE PROPOSED LANE STRIPES.			
SAMPLES FOR TEST METHOD TEX-217-F (PARTS I AND II) SHALL BE FROM THE HOT BINS FOR CONVENTIONAL BATCH PLANTS AND FROM THE STOCKPILE FOR DRYER DRUM PLANTS.			
COARSE AGGREGATES USED SHALL BE SUBJECTED TO FOUR CYCLES OF THE MAGNESIUM SULFATE SOUNDNESS TEST IN ACCORDANCE WITH TEST METHOD TEX-411-A. THE LOSS SHALL NOT BE GREATER THAN 35 PERCENT. SAMPLING AND			
SPECIFICATION DATA			
06/25 SHEET A			

F.R. DIV.6	TEXAS	HES 0008(606)	SHEET 6
NUECES	COUNTY	HWY US 181	CONT 0074-6-164
GENERAL NOTES AND SPECIFICATION DATA--			
ITEM 940, CONT'D			
TESTING SHALL BE AT THE RATE OF 1 FOR EACH 10,000 TONS OR FRACTION THEREOF. IF AGGREGATES ARE BLENDED, EACH INDIVIDUAL AGGREGATE SHALL NOT HAVE A LOSS GREATER THAN 55% AND THE BLEND SHALL NOT HAVE A LOSS GREATER THAN 35%.			
SAND EQUIVALENT VALUE OF THE COMBINED MINERAL AGGREGATE SHALL NOT BE LESS THAN 45. AN ADDITIONAL TEST, TEST METHOD TEX-203-F, SHALL BE PERFORMED ON THE SAND ONLY, AND SHALL HAVE A VALUE OF NOT LESS THAN 25.			
THE MATERIAL SHALL BE PLACED WITH AN APPROVED SPREADING AND FINISHING MACHINE MEETING THE REQUIREMENTS OF ITEM 628.			
AGGREGATE STOCKPILES TESTED AND DESIGNATED FOR DEPARTMENTAL PROJECTS WILL NOT BE USED FOR OTHER SALES AND WILL NOT BE ADDED TO, RESHAPED OR MOVED, WITHOUT APPROVAL OF THE ENGINEER.			
WHERE STONE SCREENINGS ARE SPECIFIED FOR USE, OR AUTHORIZED BY THE ENGINEER, THE PERCENT BY WEIGHT PASSING THE #10 SIEVE SHALL BE 70-100. NO OTHER REQUIREMENTS OF THIS ITEM ARE WAIVED OR CHANGED HEREBY.			
IF THE CONTRACTOR CHANGES SOURCES OF MATERIALS, THE COST TO REDESIGN THE MIX SHALL BE AT THE CONTRACTOR'S EXPENSE. THE DEPARTMENT'S LABORATORY WILL RUN THE TESTS AT THE CURRENT UNIT PRICE AT THE TIME THE TEST IS RUN. THE CONTRACTOR SHALL REIMBURSE THE STATE FOR THE COST OF THE ADDITIONAL TESTS AND SUCH REIMBURSEMENT WILL BE MADE TO THE STATE BY MAKING DEDUCTIONS FROM THE CONTRACTOR'S ESTIMATE.			
ITEM 420			
AS SOON AS FORMS ARE REMOVED FROM ALL CONCRETE, AN ORDINARY SURFACE FINISH SHALL BE APPLIED TO THE EXPOSED CONCRETE SURFACES PREPARATORY TO THE HIGHER GRADE OR CLASS FINISH.			
ITEMS 421 & 422			
BENT CONCRETE SHALL BE PAID FOR AS PLAN QUANTITY.			
THE ENGINEER WILL SAMPLE ALL CONCRETE AND MAKE AND TEST ALL TEST BEAMS AND CYLINDERS IN ACCORDANCE WITH TEST METHODS TEX-418-A AND TEX-420-A.			
ALL TEST HOLDS WILL BE FURNISHED BY THE ENGINEER AND THE CONTRACTOR SHALL MAINTAIN THEM IN THE PROPER CONDITION. IN ADDITION, THE CONTRACTOR SHALL BE RESPONSIBLE FOR FURNISHING PERSONNEL TO REMOVE THE			
SPECIFICATION DATA			
06/25 SHEET B			

F.R. DIV.6	TEXAS	HES 0008(606)	SHEET 6
NUECES	COUNTY	HWY US 181	CONT 0074-6-164
GENERAL NOTES AND SPECIFICATION DATA--			
ITEMS 421 & 422, CONT'D			
TEST SPECIMENS FROM THE MOLDS AND TO TRANSPORT THEM TO THE PROPER CURING LOCATION AT THE SCHEDULE DESIGNATED BY THE ENGINEER AND IN ACCORDANCE WITH THE GOVERNING SPECIFICATION. FOR ALL CONCRETE ITEMS THE CONTRACTOR SHALL HAVE A WHEELBARRON, OR OTHER CONTAINER ACCEPTABLE TO THE ENGINEER, AVAILABLE TO USE IN THE SAMPLING OF THE CONCRETE.			
ALL LABOR AND EQUIPMENT FURNISHED BY THE CONTRACTOR WILL BE CONSIDERED SUBSIDIARY TO THE VARIOUS BID ITEMS AND WILL NOT BE PAID FOR DIRECTLY.			
ITEM 422			
THE USE OF PERMANENT METAL DECK FORMS WILL NOT BE PERMITTED ON THIS PROJECT. EXISTING OVERLAY ON BRIDGE WILL BE REMOVED PRIOR TO ANY OTHER CONSTRUCTION. TRANSITION FROM END OF BRIDGE TO EXISTING ASPHALT SHALL BE SMOOTH AND UNIFORM, AS DIRECTED BY THE ENGINEER. BREAK-BACK ON EXISTING SLAB MUST BE SAW CUT TO PROVIDE STRAIGHT CLEAN JOINT FOR WIDEN SECTION, AS DIRECTED BY ENGINEER. REMOVAL OF EXISTING ASPHALT AND SAW CUTTING OF JOINT SHALL BE SUBSIDIARY TO VARIOUS BID ITEMS.			
ITEM 427			
GRADE SEPARATION STRUCTURES INCLUDING THE EXPOSED FACES OF BENT CAPS, OUTSIDE BEAMS, AND COLUMNS SHALL RECEIVE A GRADE 1, CLASS A OR B FINISH. THE T601 RAIL AND RETAINING WALL COPING SHALL RECEIVE A CLASS B FINISH.			
ITEM 427			
HIGH RANGE WATER REDUCERS WILL BE USED ONLY TO MEET SPECIAL REQUIREMENTS AND WILL REQUIRE THE WRITTEN APPROVAL OF THE ENGINEER ON EACH SPECIFIC PROJECT. A SATISFACTORY WORK PLAN FOR CONTROL SHALL BE SUBMITTED BY THE CONTRACTOR FOR APPROVAL AND AN EVALUATION OF THE CONCRETE CONTAINING THE AD MIXTURE WILL BE PERFORMED BY THE ENGINEER.			
ITEM 442			
ARMOR JOINTS SHALL RECEIVE PROTECTION SYSTEM I OR II PRIME COAT.			
SPECIFICATION DATA			
06/25 SHEET C			

F.R. DIV.6	TEXAS	HES 0008(606)	SHEET 6
NUECES	COUNTY	HWY US 181	CONT 0074-6-164
GENERAL NOTES AND SPECIFICATION DATA--			
ITEM 446			
PRICES CHARGED FOR PAINT FURNISHED BY THE DEPARTMENT WILL BE AS FOLLOWS:			
PROTECTION SYSTEM I PRIME COAT, EPOXY ----- \$75.90 / 5 GAL.			
PROTECTION SYSTEM II PRIME COAT, EPOXY ----- \$106.50 / 9 GAL.			
ITEM 450			
REMOVAL OF CONCRETE FOR RAIL RETROFIT AND REMOVAL OF RETAINING WALL WINGS WILL NOT BE PAID FOR DIRECTLY, BUT SHALL BE CONSIDERED SUBSIDIARY TO ITEM 450.			
ITEM 502			
3-LINE PORTABLE CHANGEABLE MESSAGE SIGNS WILL BE REQUIRED WITH LANE CLOSURES.			
CWI-B'S SHALL BE REQUIRED ON THE OUTSIDE OF CURVES AND SHALL BE MOUNTED ON BARRICADES (SEE BC SHEETS).			
PLASTIC DRUMS SHALL BE USED IN ACCORDANCE WITH THE PLANS AND MANUFACTURER'S RECOMMENDATIONS AS APPROVED BY THE ENGINEER.			
ITEM 504			
ONE FIELD OFFICE (TYPE B) WILL BE REQUIRED FOR THIS PROJECT. THE BUILDING SHALL BE ADEQUATELY VENTILATED AS DIRECTED BY THE ENGINEER. IN ADDITION, THE BUILDING SHALL BE FURNISHED WITH AN APPROVED WASHROOM EQUIPPED WITH A TANK TYPE FLUSH TOILET AND WASHBASIN, BOTH CONNECTED TO ADEQUATE SANITARY FACILITIES. THE BUILDING SHALL BE EQUIPPED WITH ELECTRICITY, NATURAL GAS AND CITY WATER. THE ARRANGEMENT AND NUMBER OF OUTLETS FOR THESE UTILITIES SHALL BE AS DIRECTED BY THE ENGINEER. ADEQUATE ENCLOSED SPACE SHALL BE PROVIDED FOR BEAM CURING TANKS AND BEAM BREAKING MACHINE. THE CONTRACTOR SHALL APPLY AND SECURE ANY PERMITS NECESSARY FOR THE BUILDING. UTILITY METER DEPOSITS AND SERVICE BILLS WILL BE PAID BY THE CONTRACTOR. THE FIELD OFFICE WILL BE AS ABOVE OR AN EQUIVALENT AS APPROVED BY THE ENGINEER.			
ITEM 506			
AFTER TEMPORARY EROSION CONTROL DEVICES ARE NO LONGER REQUIRED, CLEANUP AND RESHAPING OF THOSE AREAS WILL BE REQUIRED. THIS WORK WILL NOT BE PAID FOR DIRECTLY BUT SHALL BE CONSIDERED SUBSIDIARY TO THE VARIOUS BID ITEMS.			
SPECIFICATION DATA			
06/25 SHEET D			

F.R. DIV.6	TEXAS	HES 0008(606)	SHEET 6
NUECES	COUNTY	HWY US 181	CONT 0074-6-164
GENERAL NOTES AND SPECIFICATION DATA--			
ITEM 512			
APPROXIMATELY 1000 LF OF TYPE 2 CONCRETE TRAFFIC BARRIERS WILL BE SUPPLIED BY THE STATE DEPARTMENT OF HIGHWAYS AND PUBLIC TRANSPORTATION AND SHALL BE PICKED UP BY THE CONTRACTOR AT A SITE IN THE CORPUS CHRISTI AREA. THE HANDLING AND INSTALLATION OF THE CONCRETE TRAFFIC BARRIERS SHALL BE INCLUDED IN THE UNIT PRICE BID FOR "CONC TRAF BAR (MOVE AND RESET)" AND "CONC TRAF BAR (REMOVE)".			
CONCRETE TRAFFIC BARRIER UNITS DAMAGED DUE TO CONTRACTOR'S OPERATIONS, HANDLING OR NEGLECT, SHALL BE REPAIRED OR REPLACED AS DIRECTED BY THE ENGINEER BEFORE BEING REUSED OR RETURNED TO STORAGE.			
ITEM 526			
IF MEMBRANE CURING IS USED FOR CURING CONCRETE STRUCTURES, ONLY TYPE 1-D CURING COMPOUND CONFORMING TO THE REQUIREMENTS OF ITEM 526 WILL BE PERMITTED.			
ITEM 540			
TIMBER POSTS, USED FOR THIS ITEM, ARE NOT TO BE PAINTED.			
ITEM 542			
ALL GALVANIZED STEEL BEAM GUARD FENCE REMOVED BY THE CONTRACTOR SHALL BE STOCKPILED AT THE JOBSITE, AS DIRECTED BY THE ENGINEER. THE STOCKPILED GUARD FENCE WILL BE PICKED UP BY STATE MAINTENANCE FORCES.			
ITEM 512			
EXISTING TRANSFORMER BASES ARE TO BE REUSED FOR POLES RELOCATED IN PLACE AND ARE PROTECTED BY RETAINING WALL OR T-501 RAIL.			
ALL POLES TO BE RELOCATED SHALL HAVE ALL INTERNAL CONDUCTORS REPLACED WITH NO. 12 TYPE XHHW CONDUCTORS AND ALL FUSED DISCONNECTS MEETING REQUIREMENTS SHOWN ON ROADWAY ILLUMINATION DETAIL SHEETS.			
ITEM 616			
THE TOP EIGHT (8) INCHES OF FOUNDATIONS SHALL BE FORMED AND STRUCK LEVEL.			
BOTH ENDS OF EACH RACEWAY SHALL BE FITTED WITH A TEMPORARY CAP TO PREVENT DIRT AND DEBRIS FROM ENTERING RACEWAY DURING CONSTRUCTION. WHERE STEEL RACEWAY IS USED, BUSHING SHALL BE GROUND-TYPE AND A BONDING			
SPECIFICATION DATA			
06/25 Rev. 6-25-91 SHEET E			

F.R. DIV.6	TEXAS	HES 0008(606)	SHEET 6
NUECES	COUNTY	HWY US 181	CONT 0074-6-164
GENERAL NOTES AND SPECIFICATION DATA--			
ITEM 616, CONT'D			
JUMPER SHALL BE CONNECTED BETWEEN BUSHING AND GROUND ROD.			
ITEM 618			
CONDUITS UNDER ROADWAYS SHALL BE PLACED A MINIMUM OF 18 IN. BELOW THE SUBGRADE MATERIAL AND LOCATION MARKED ACCORDING WITH PLANS.			
AFTER CONDUIT AND WIRING INSTALLATION IS COMPLETED, ALL CONDUIT ENDS SHALL BE SEALED WITH A SEALANT TO BE MADE OF A POLYURETHANE OR EQUIVALENT MATERIAL OF A COMPOSITION THAT WILL CURE IN THE PRESENCE OF MOISTURE. THE SEALANT SHALL ENCAPSULATE AND PROTECT ELECTRICAL CONDUCTORS AND SEAL CONDUIT ENDS FROM MOISTURE AND DIRT. THE CONDUIT SHALL BE SEALED A MINIMUM OF THREE INCHES.			
FOR CONDUIT PLACED BY TRENCHING, TRENCHING AND BACKFILLING WILL BE IN ACCORDANCE WITH THE ITEM "EXCAVATION AND BACKFILL FOR SEWERS", EXCEPT FOR MEASUREMENT AND PAYMENT.			
CONDUITS ENTERING GROUND BOXES SHALL BE PLACED SO THAT THE CONDUIT ENDS SHALL NOT BE LESS THAN 6 IN. NOR MORE THAN 9 IN. FROM THE BOX COVER.			
OPEN ENDS OF ALL CONDUITS AND RACEWAYS SHALL BE FITTED WITH TEMPORARY CAPS OR PLUGS TO PREVENT THE ENTRY OF DIRT, DEBRIS, AND RODENTS DURING CONSTRUCTION.			
A PULL WIRE OR PULL ROPE SHALL BE PLACED IN ALL EMPTY CONDUIT THAT IS BEING INSTALLED FOR FUTURE USE. FOR NON-METALLIC CONDUIT, AN APPROVED NON-METALLIC ROPE OR TAPE SHALL BE INSTALLED. ALL CONDUIT ENDS SHALL BE CAPPED WITH AN APPROVED REMOVABLE CAP.			
THE ENDS OF ALL METALLIC CONDUIT TERMINATING IN A GROUND BOX, JUNCTION BOX, OR POLE BASE, AND CARRYING INDIVIDUAL CONDUCTORS SHALL BE FITTED WITH INSULATED GROUND BUSHINGS. A BONDING JUMPER SHALL BE INSTALLED FROM BUSHING TO NEAREST GROUND ROD. GROUNDING LUG OR GROUNDING CONNECTOR AT SERVICE POLES, BONDING JUMPER SHALL BE AWG SIZE NO. 6. ALL OTHER JUMPERS SHALL BE MINIMUM SIZE AWG NO. 10. CONDUIT USED AS CASING UNDER ROADWAYS FOR DUCT CABLE NEED NOT BE GROUNDING IF DUCT EXTENDS FULL LENGTH THROUGH THE CASING.			
AT ENDS OF ALL NON-METALLIC CONDUIT (PVC OR HDPE) WHERE A THREADED CONNECTOR IS USED (E.G. METAL JUNCTION BOX) A BUSHING SHALL BE INSTALLED.			
SPECIFICATION DATA			
06/25 Rev. 6-25-91 SHEET F			

F.R. DIV. 6	TEXAS	HES 0006(606)	SHEET 6A
NUECES	COUNTY	HWY US 101	CONT 0074-6-164

GENERAL NOTES AND SPECIFICATION DATA--

ITEM 620

A NON-METALLIC PULL WIRE OR PULL ROPE SHALL BE USED IN PULLING CONDUCTOR IN NON-METALLIC CONDUIT. A MINIMUM LENGTH OF 9 FT. OF CONDUCTOR SHALL BE LEFT IN GROUND BOXES AND POLE BASES FOR MAKING UP CONNECTIONS.

AFTER CONDUCTOR IS PLACED IN CONDUIT, A PULL TEST WILL BE MADE ON CONDUCTORS. ANY LENGTH OF CONDUCTOR THAT CANNOT BE PULLED EASILY WILL BE REPLACED BY THE CONTRACTOR AT HIS EXPENSE.

ITEM 624

ALL GROUND BOXES SHALL BE PERMANENTLY MARKED WITH MANUFACTURER'S NAME OR LOGO AND MODEL NUMBER. MARKING SHALL BE ON TOP RIM OF BOX OR INSIDE BOX NEAR TOP. COVERS FOR GROUND BOXES SHALL ALSO BE MARKED AS ABOVE. CONTRACTOR SHALL ALSO PROVIDE CERTIFICATION THAT ALL GROUND BOX AND LID COMBINATIONS MEET LOADING REQUIREMENTS.

IN AREAS OF HEAVY TRAFFIC OR OTHER AREAS AS DIRECTED BY THE ENGINEER, GROUND BOX WILL BE ENCASED IN CONCRETE.

ITEM 662

PAINT OR FOIL-BACKED PAVEMENT MARKINGS WILL NOT BE PERMITTED AS REMOVABLE MARKINGS. REMOVABLE PAVEMENT MARKINGS SHALL BE WORK ZONE RAISED PAVEMENT MARKERS (SEE STANDARD SHEET TCP(6-1) AND TCP(6-2) PLACED USING A BITUMINOUS ADHESIVE.

ALL DETOURS AND ROADWAYS SHALL HAVE EDGE LINES AND CENTERLINES AS APPLICABLE. ALL CONFLICTING PAVEMENT MARKINGS SHALL BE REMOVED OR OBLITERATED BY THE CONTRACTOR AND PAID FOR AT THE UNIT BID PRICE FOR REMOVE PAVEMENT MARKINGS.

06/26 Rev. 6-25-91

SPECIFICATION DATA

SHEET 0

F.R. DIV. 6	TEXAS	HES 0006(606)	SHEET 6A
NUECES	COUNTY	HWY US 101	CONT 0074-6-164

GENERAL NOTES AND SPECIFICATION DATA--

SPECIFICATION DATA

ITEM 1147 ----- EMBANKMENT (DENS CONT) (TY C)

PLASTICITY INDEX ----- 45 MAX

PLASTICITY INDEX ----- 6 MIN

ITEM 340

340 HOT MIX ASPH PAY 150 LBS / CY

AGGR (TY D) 94.5 % BY WT

ASPH 5.5 % BY WT

06/26

SPECIFICATION DATA

SHEET H

ESTIMATE SUMMARY


						CONTROL 74-6-164				A L T	ITEM- CODE			DESCRIPTION	U N I T	TOTAL	
						US 181											
						ROADWAY		BRIDGE									
EST.	FINAL	EST.	FINAL	EST.	FINAL	EST.	FINAL	EST.	FINAL		ITEM NO	DESC CODE	SP NO			EST.	FINAL
						18.000				340	027	131	ASPH CONC (TY D)(LEVEL-UP)	TON	18.000		
								100.000		409	003		CONC PIL (16 IN SQ)	LF	100.000		
								33.000		417	002		SLURRY DISPL DRILL SHAFT (24 IN)	LF	33.000		
						34.800				421	015	046	CL C CONC (MISC)	CY	34.800		
								2592.000		422	002	001	REINF CONC SLAB (EXT STR)	SF	2592.000		
						236.000				423	001	049	RETAINING WALL	SF	236.000		
								178.430		425	003	006	PRESTR CONC BEAM (TY C)	LF	178.430		
								14.000		430	006	002	CL C CONC FOR EXT STR (BENT)	CY	14.000		
								4.100		430	007	002	CL C CONC FOR EXT STR (ABUT)	CY	4.100		
						3.000				432	008		RIPRAP (CONC)(CL B)	CY	3.000		
								90.000		442	001	007	STR STL (HYC)	LB	90.000		
								940.000		442	003	007	STR STL (ARMOR JT)	LB	940.000		
						290.000		360.000		450	036	002	RAIL (TY T 501)	LF	650.000		
						1752.000				450	053	002	RAIL (TY T 501R)	LF	1752.000		
						34.200				450	098	002	RAIL (TY T501)(SPL)	LF	34.200		
						360.000				452	001		REMOV RAIL	LF	360.000		
						22.000				471	001		GRATE	EA	22.000		
						22.000				479	002		ADJ INLET	EA	22.000		
						6.000				502	001	015	BARCD,SIGN AND TRAF HANDLING	MO	6.000		
						2220.000				512	002		CONC TRAF BAR (MOVE AND RESET)	LF	2220.000		
						1080.000				512	003		CONC TRAF BAR (REMOVE)	LF	1080.000		
						3800.000				540	010		METAL BEAM GD FENCE (12 GA)(TIM POST)	LF	3800.000		
						22.000				540	011		TERM-ANCH SECT (12 GA)	EA	22.000		
						2975.000				540	015		MET BM GD FE (BLK OUT)(12 GA)(TIM POST)	LF	2975.000		
						20.000				542	003	001	REMOV TERM-ANCH SECT	EA	20.000		
						8581.000				542	006	001	REMOV METAL BEAM GD FENCE (STEEL POST)	LF	8581.000		
						65.000				550	002	003	CHAIN LINK BAR FENCE (6 FT)	LF	65.000		
								2.000		610	164		RDWY ILL ASM (U/P TY 1)(.15KW)S(SPL CO)	EA	2.000		
						13.000		2.000		612	004		RELOC RDWY ILL ASSEM, TRANS BASE	EA	15.000		
						1.000				616	001		RDWY ILL ASSEM FND (TY A)	EA	1.000		
						3180.000		250.000		618	046		CONDT (PVC)(SCH 40)(1 1/2 IN)	LF	3430.000		
						3855.000		250.000		620	002		ELEC CONDR (NO. 6 BAR)	LF	4105.000		
						1670.000				620	032		ELEC CONDR (NO. 6)(TY XHHW)	LF	1670.000		
						6340.000		500.000		620	033		ELEC CONDR (NO. 4)(TY XHHW)	LF	6840.000		
						3.000				624	022		GROUND BOX (RPM)(TY A)(122311) APRON	EA	3.000		
						172.000				662	057	015	CONST PAV MARK (RAISE REFLECT)(TY C)	EA	172.000		
						84.000				662	058	015	CONST PAV MARK (RAISE REFLECT)(TY A)	EA	84.000		
						80.000				1147	002		EMBANK (DC)(TY C)	CY	80.000		
						525.000				5044	001		TEMP METAL BEAM GD FENCE	LF	525.000		
						1.000				5641	001		MOBILIZATION	LS	1.000		
						3.000				5653	014		GD RAIL EN ABS TERM (3FT)(6 BAY)(TY C)	EA	3.000		
						110.000				6427	002		REMOV PAV MARKINGS (4 IN)	LF	110.000		
</																	

ESTIMATE & QUANTITY SHEET

Rev. 6-25-91

STATE DIST. NO.	COUNTY	PROJECT NO.	SHEET NO.
16	NUECES	HES 000616061	7



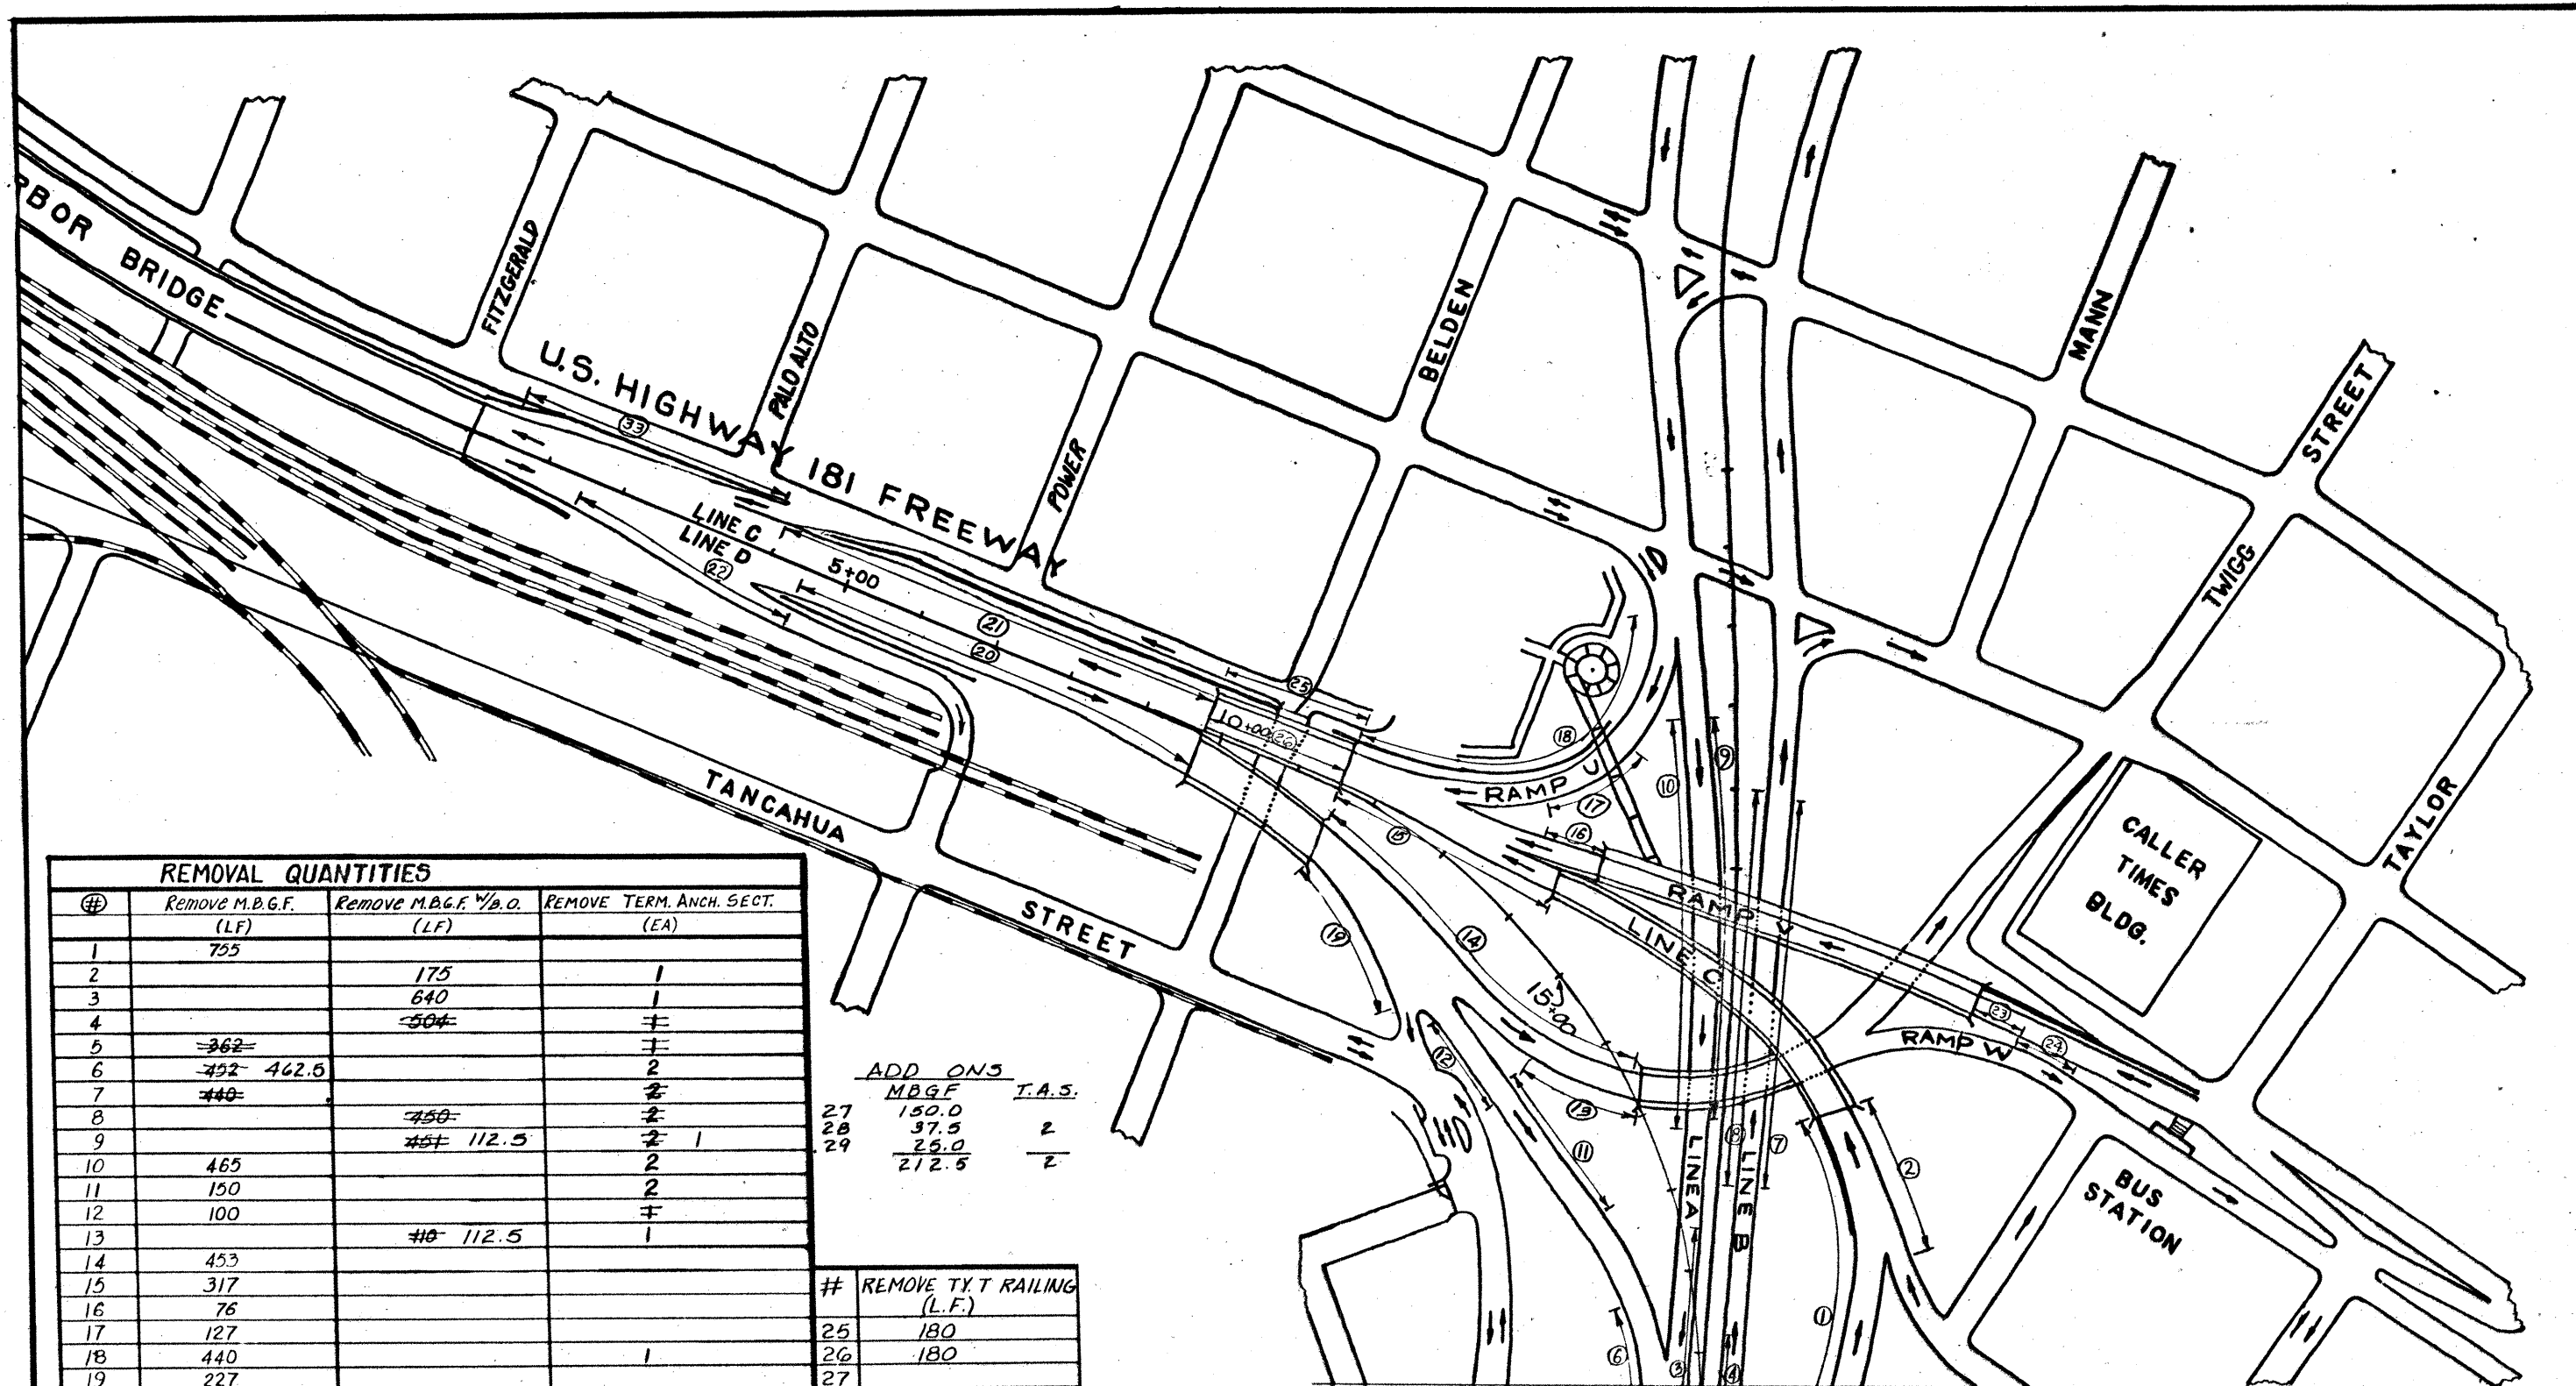

REMOVAL QUANTITIES			
#	Remove M.B.G.F. (LF)	Remove M.B.G.F. W/O. (LF)	REMOVE TERM. ANCH. SECT. (EA)
1	755		
2		175	1
3		640	1
4		504	1
5	362		1
6	452 462.5		2
7	440		2
8		450	2
9		451 112.5	2 1
10	465		2
11	150		2
12	100		1
13		110 112.5	1
14	453		
15	317		
16	76		
17	127		
18	440		1
19	227		
20	530		
21	594		
22	275		1
23	65		
24	EXIST. TO REMAIN 75		
25	345		
Total	6251 5456.5	2330 1040	20 12
+ 212.5 ADD ONS			
5669.0 TOTAL			

#	REMOVE T.Y.T. RAILING (L.F.)
25	180
26	180
27	
28	
29	
30	
31	
32	
Total	360

ADD ONS	M.B.G.F.	T.A.S.
27	150.0	
28	37.5	2
29	25.0	2
Total	212.5	2


MATCH LINE SHEET B

Andrew H. Smith, P.E.

 7/10/90

EXISTING PLAN 8

FED. PROJ. NO.	STATE	FEDERAL PROJECT NO.	SHEET NO.
16	TEXAS	HES0005(606)	8
CONTRACT NO.	COUNTY	CONTRACT NO.	CONTRACT NO.
16	HUFFES	74	06 164
			US181

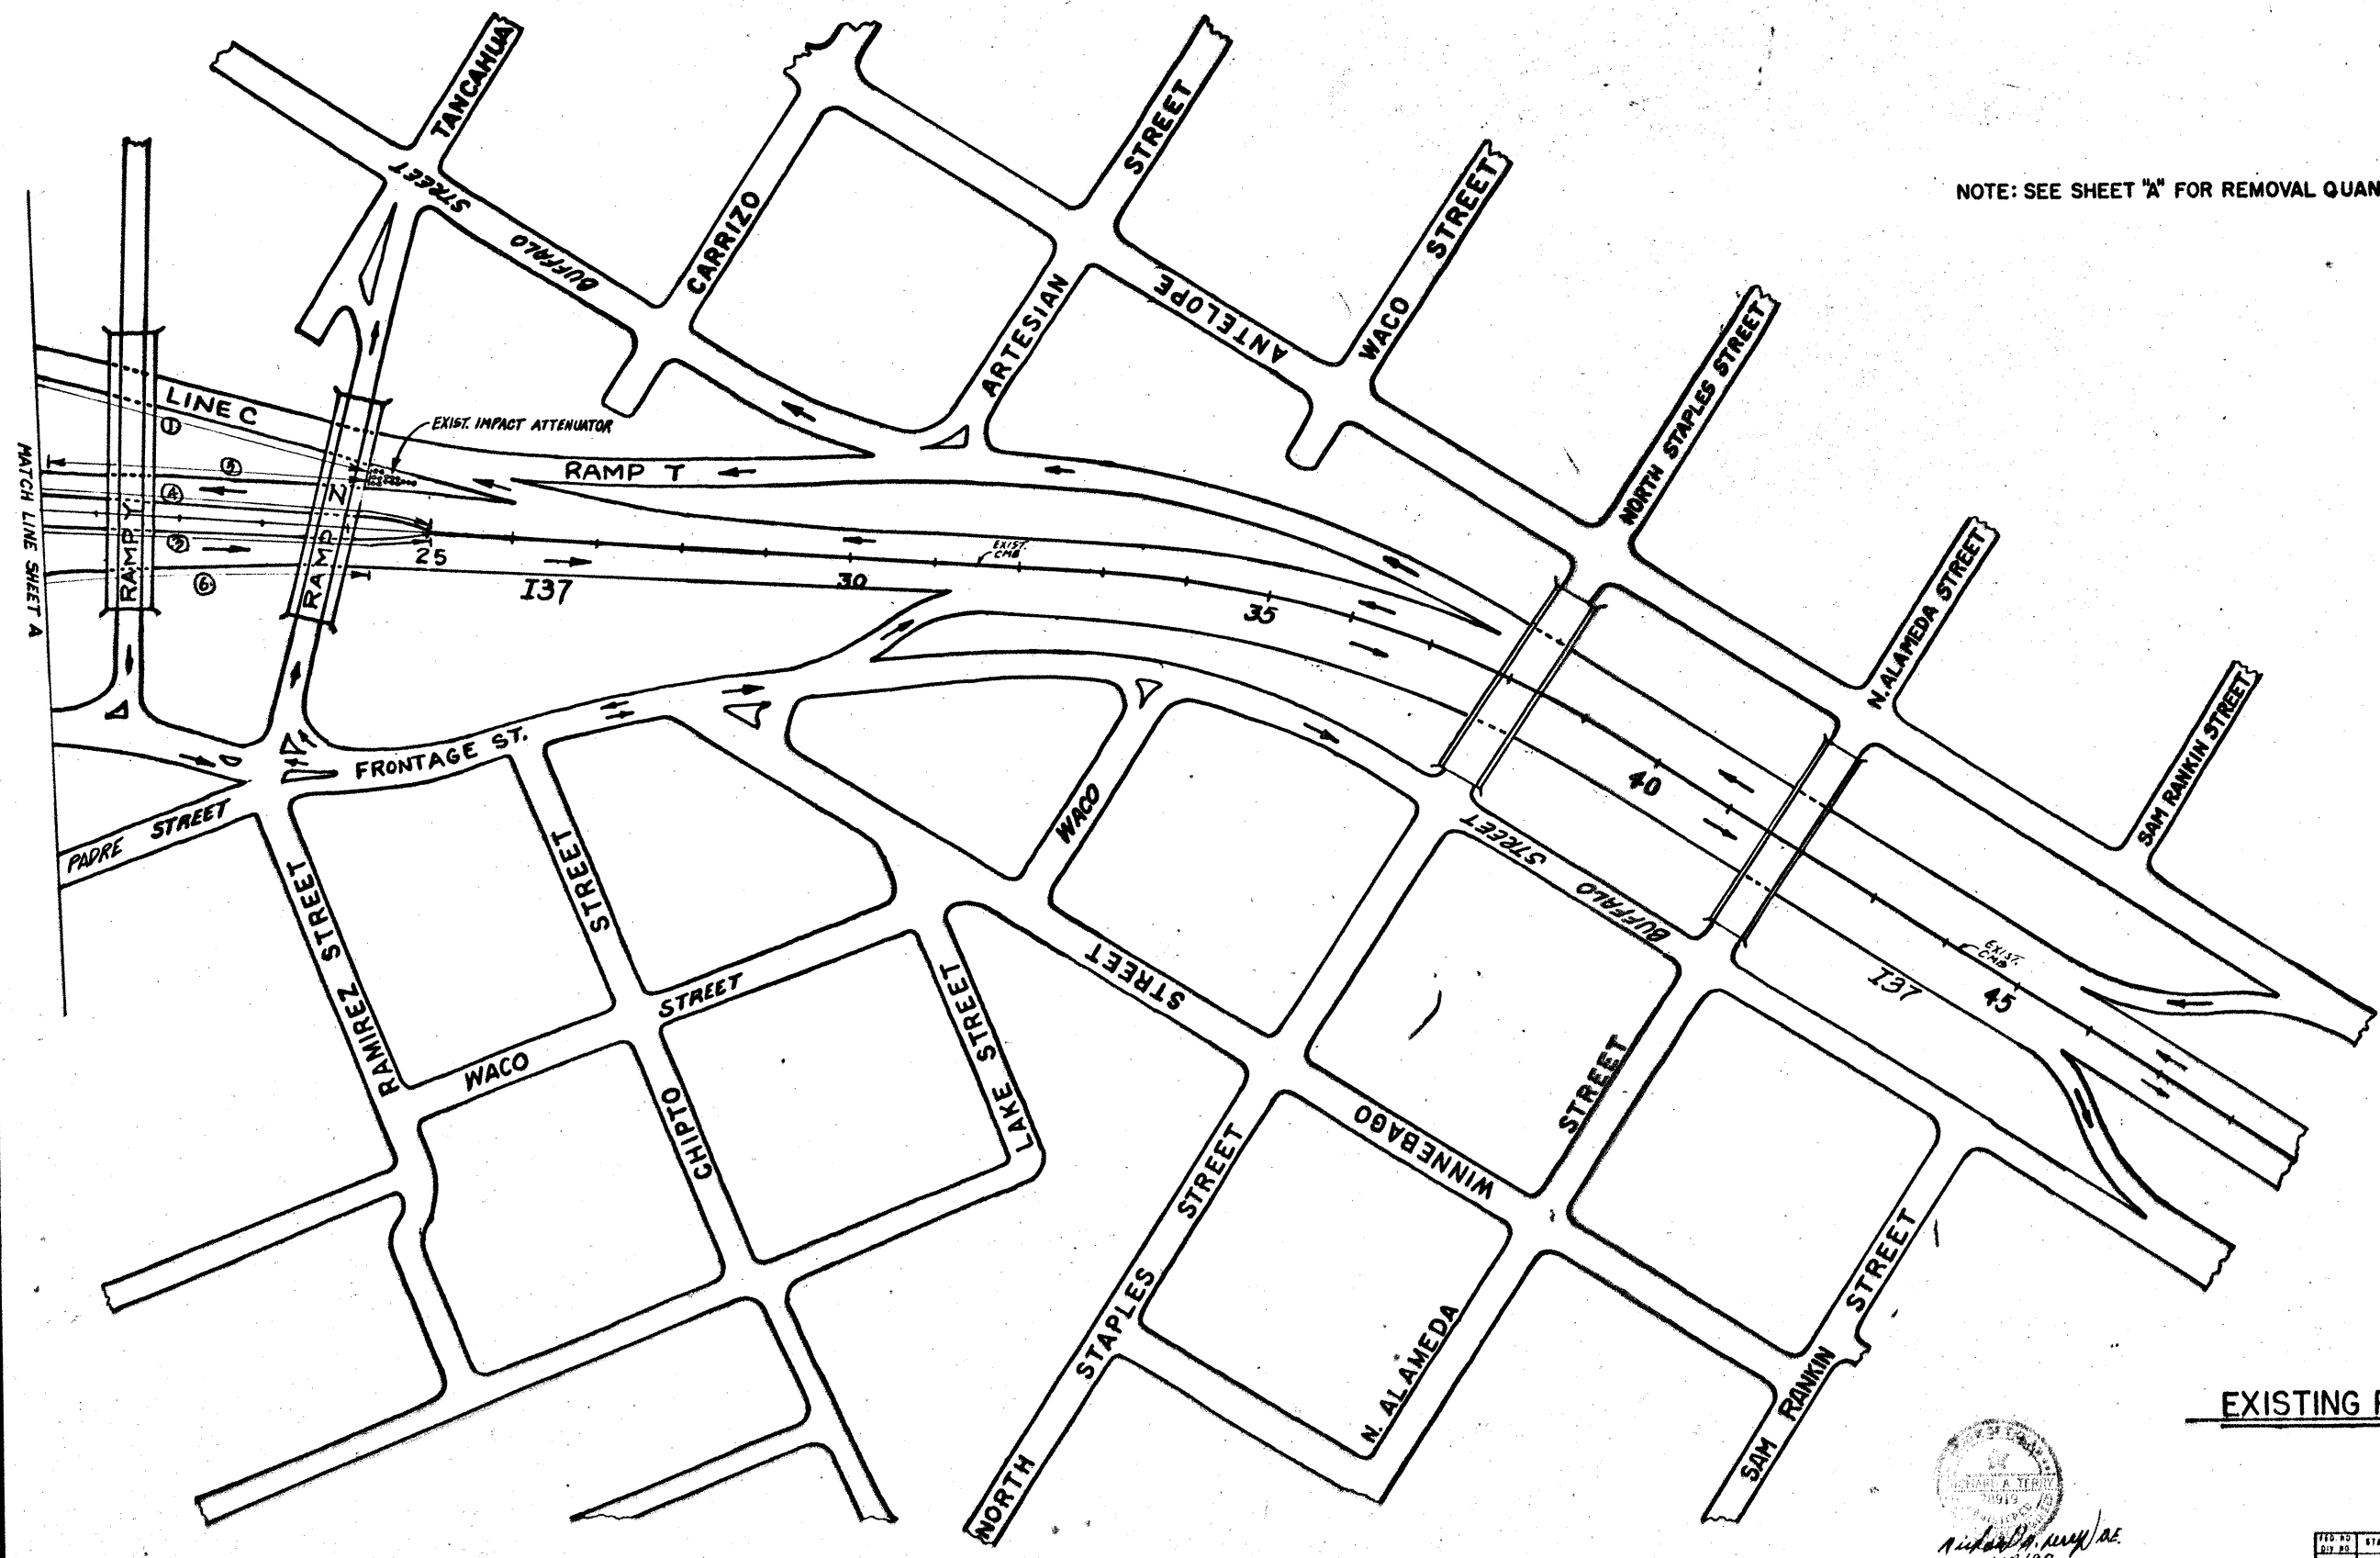

NOTE: SEE SHEET "A" FOR REMOVAL QUANTITIES.


EXISTING PLAN

Richard A. [unclear] / ae
9/10/90

SCALE: 1" = 100'

FED. RD. DIST. NO.	STATE	FEDERAL PROJECT NO.	SHEET NO.
16	TEXAS	HE50005(606)	9
COUNTY	CONTRACT	SECTION	JOB
NUECES	74	6	164
			US181

9

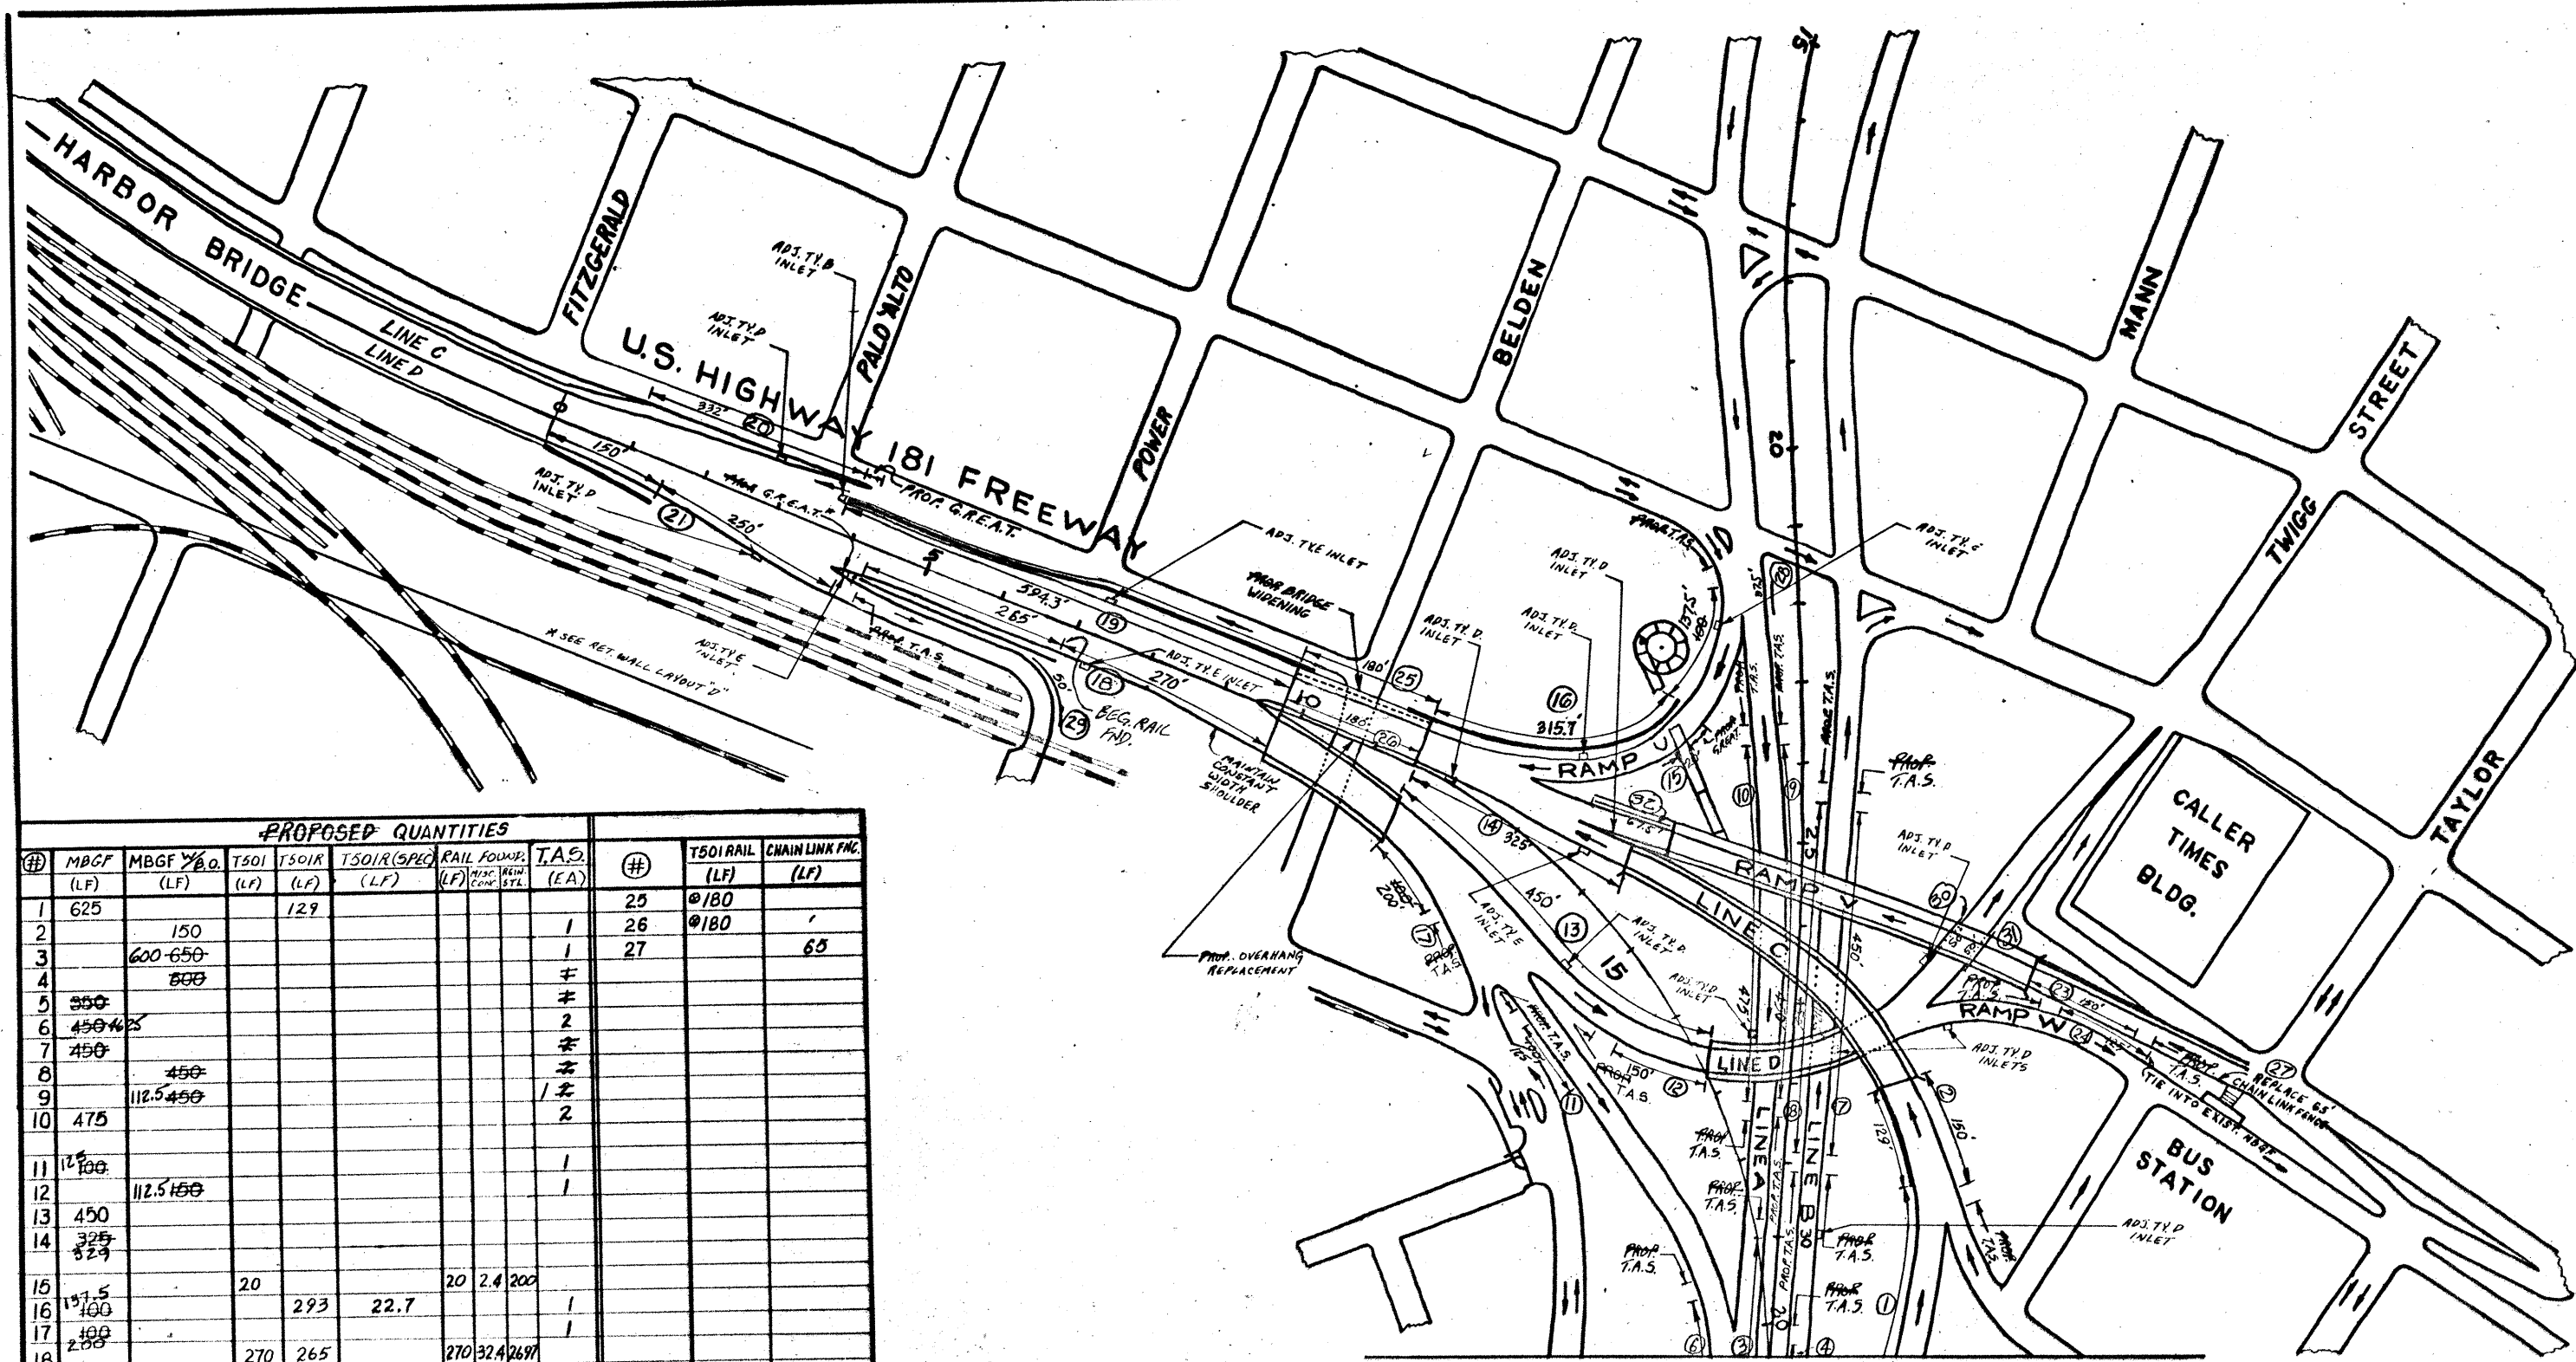

PROPOSED QUANTITIES												
#	MBGF (LF)	MBGF % (LF)	T501 (LF)	T501R (LF)	T501R (SPEC) (LF)	RAIL FOUND. (LF)	TA.S. (EA)	#	T501 RAIL (LF)	CHAIN LINK FNC. (LF)		
1	625			129				25	180			
2		150					1	26	180			
3		600-650					1	27		65		
4		800					#					
5	550						#					
6	450-475						2					
7	450						#					
8		450					#					
9		112.5-450					1 #					
10	475						2					
11	125						1					
12		112.5-150					1					
13	450											
14	325 329											
15			20			20	2.4	200				
16	151.5 100			293	22.7		1					
17	100 250						1					
18			270	265		270	32.4	2697				
19				583	11.5							
20	* 50			332			2					
21	300 200			150			1					
22	* 675						1					
23		450-475					2 #					
24		50-150					2 #					
25	425	125					2 #					
26	* 375						2					
27	* 50						2					
28	* 50						2					
29		50					2					
30	* 50						2					
TTL	3800 3300	1650 2970	290	1752	34.2	290	34.8	2697 22	TOTAL	3360	65	

* Add on quantities
 (C) Accounted for on Bridge Q'tys

PROPOSED PLAN


10A

Rev 2-B-91
 Rev 12-14-90

9/10/90

FED. PROJ. NO.	STATE	FEDERAL PROJECT NO.	SHEET NO.
16	TEXAS	HES0005(606)	10A
STATE PROJ. NO.	COUNTY	CONTRACT	USIBI
16	NUECES	74 06 164	

SCALE: 1" = 100'

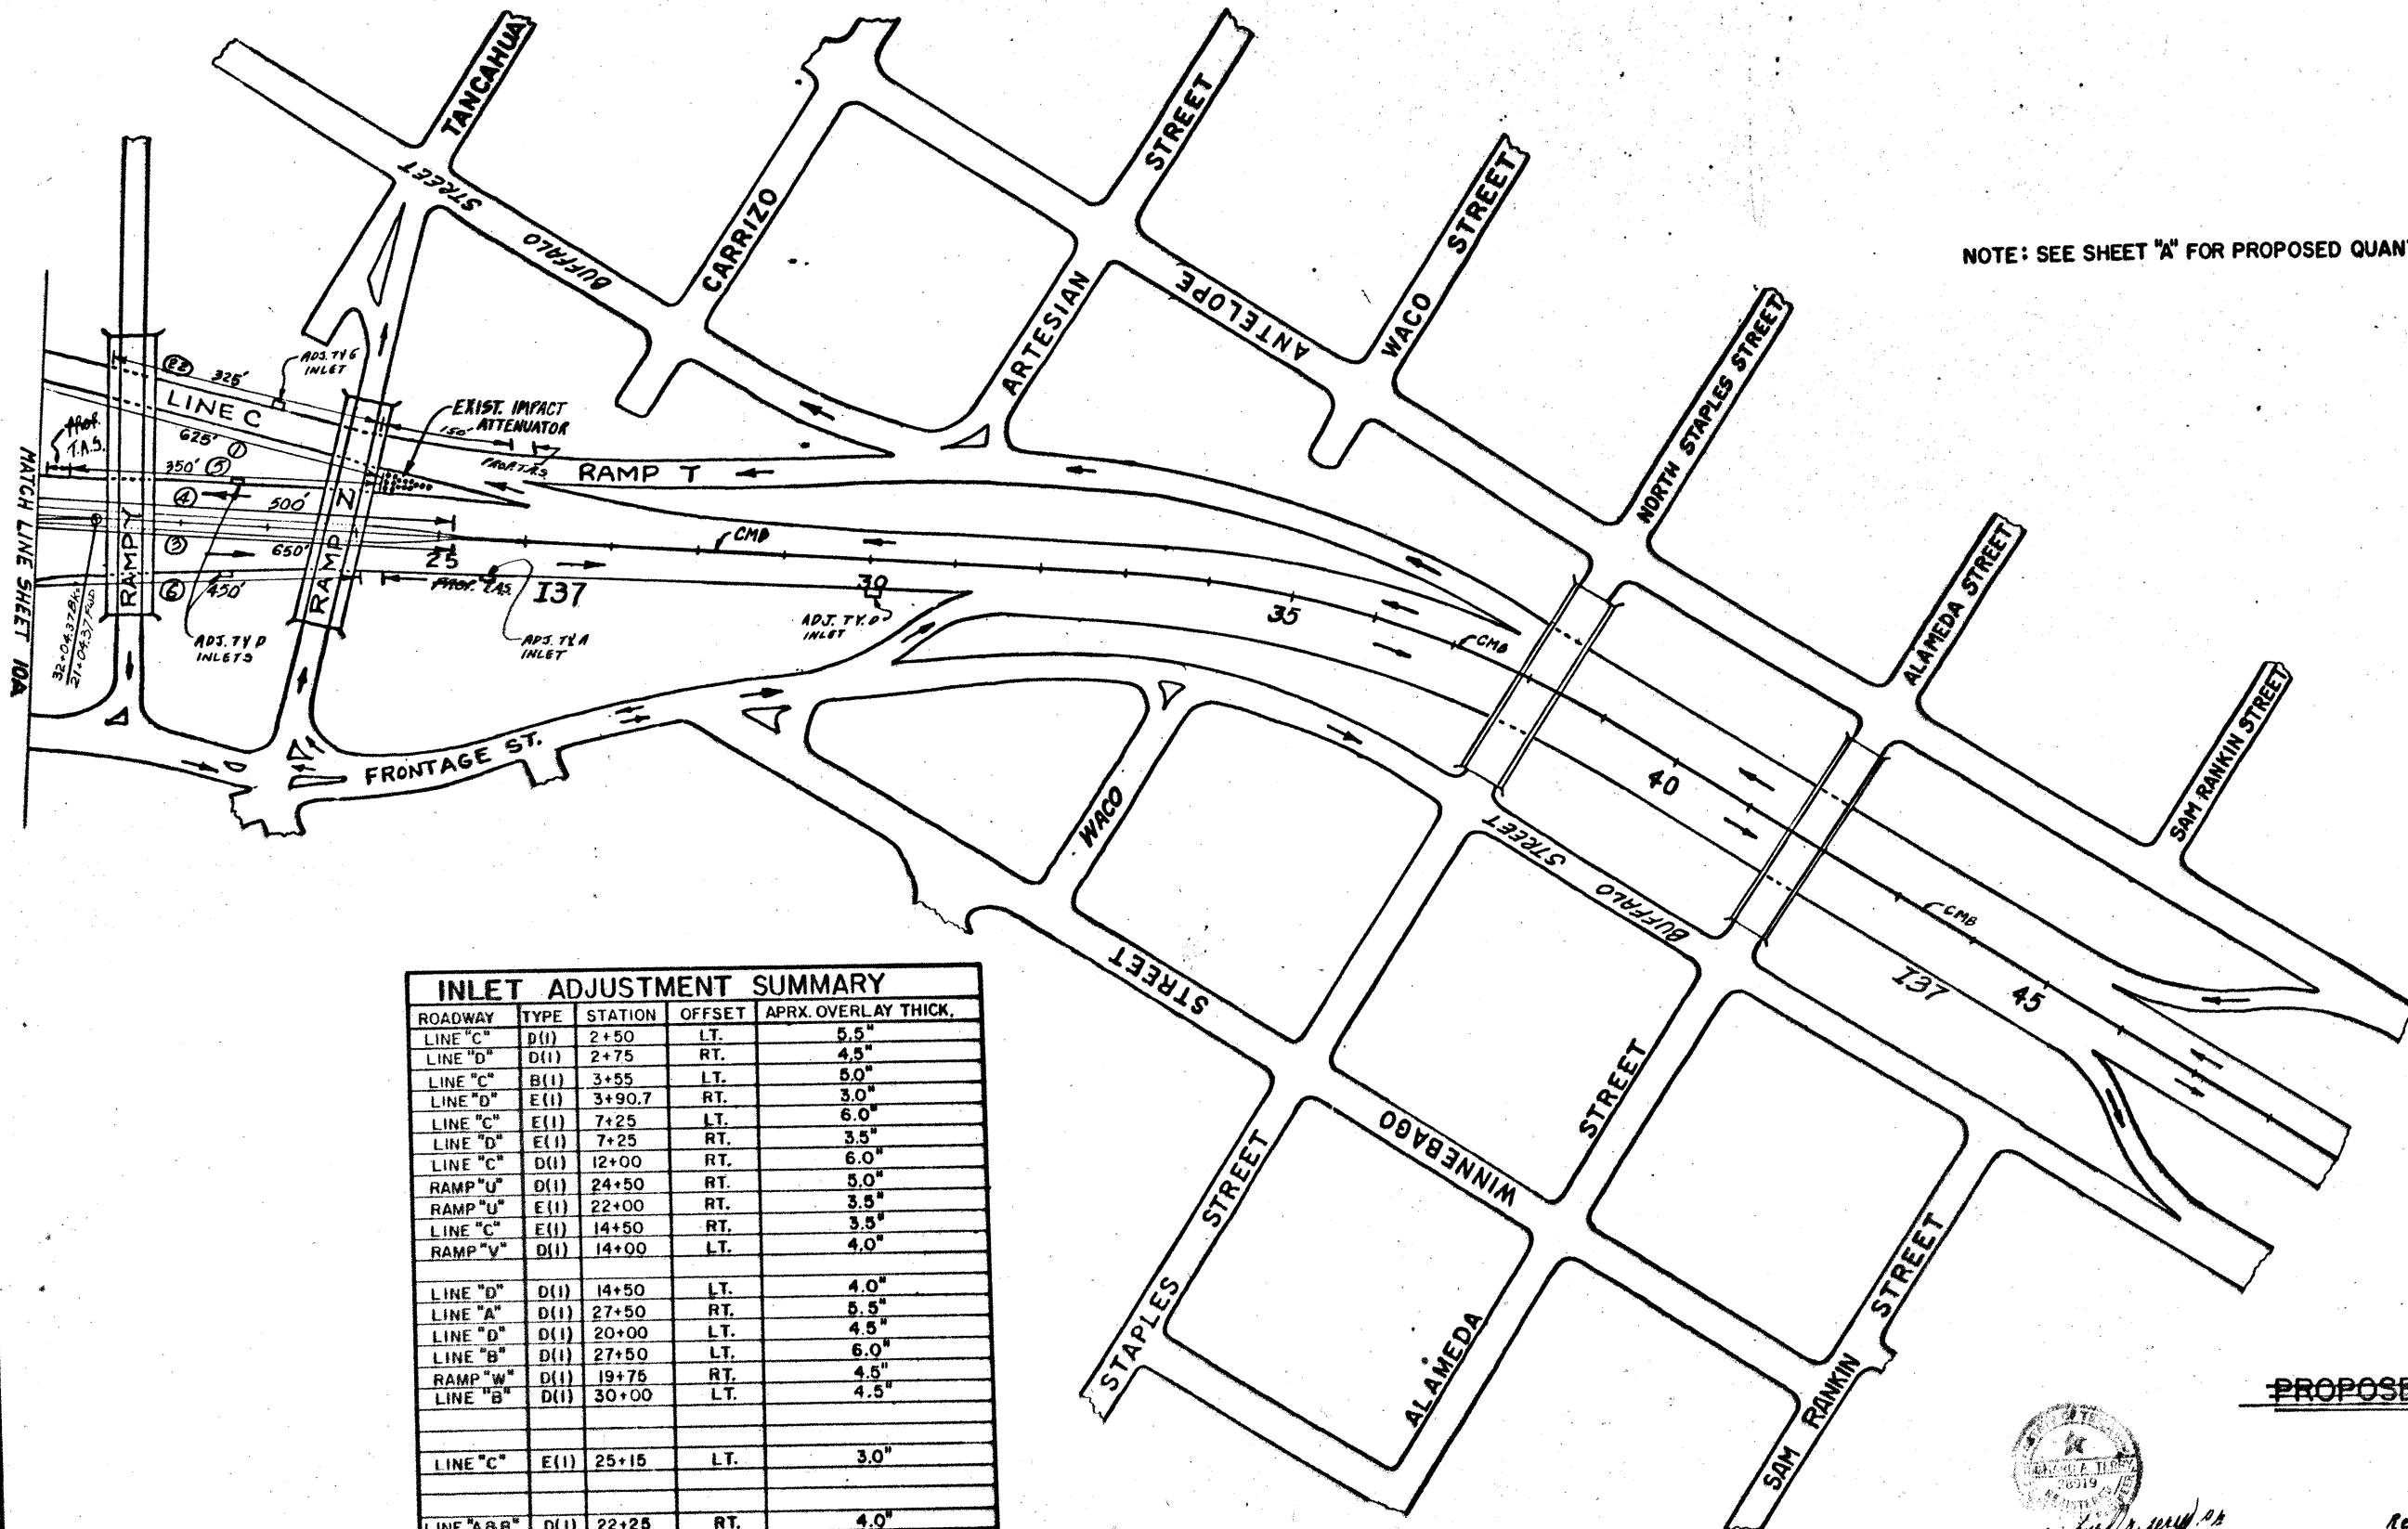

NOTE: SEE SHEET "A" FOR PROPOSED QUANTITIES.

INLET ADJUSTMENT SUMMARY				
ROADWAY	TYPE	STATION	OFFSET	APRX. OVERLAY THICK.
LINE "C"	D(I)	2+50	LT.	5.5"
LINE "D"	D(I)	2+75	RT.	4.5"
LINE "C"	B(I)	3+55	LT.	5.0"
LINE "D"	E(I)	3+90.7	RT.	3.0"
LINE "C"	E(I)	7+25	LT.	6.0"
LINE "D"	E(I)	7+25	RT.	3.5"
LINE "C"	D(I)	12+00	RT.	6.0"
RAMP "U"	D(I)	24+50	RT.	5.0"
RAMP "U"	E(I)	22+00	RT.	3.5"
LINE "C"	E(I)	14+50	RT.	3.5"
RAMP "V"	D(I)	14+00	LT.	4.0"
LINE "D"	D(I)	14+50	LT.	4.0"
LINE "A"	D(I)	27+50	RT.	5.5"
LINE "D"	D(I)	20+00	LT.	4.5"
LINE "B"	D(I)	27+50	LT.	6.0"
RAMP "W"	D(I)	19+75	RT.	4.5"
LINE "B"	D(I)	30+00	LT.	4.5"
LINE "C"	E(I)	25+15	LT.	3.0"
LINE "ABB"	D(I)	22+25	RT.	4.0"
LINE "ABB"	D(I)	22+50	LT.	3.0"
LINE "ABB"	A(I)	25+25	RT.	4.0"
LINE "ABB"	D(I)	30+00	RT.	4.0"
TOTAL		22		


PROPOSED PLAN


 9/10/90

SCALE: 1" = 100'

Rev 2-B-91		SHEET	
STATE	TEXAS	NO.	10B
COUNTY	HES00008(606)	CON.	10P
DATE	10/10/90	REV.	164
BY	NUECES	APP.	USIBI


10B

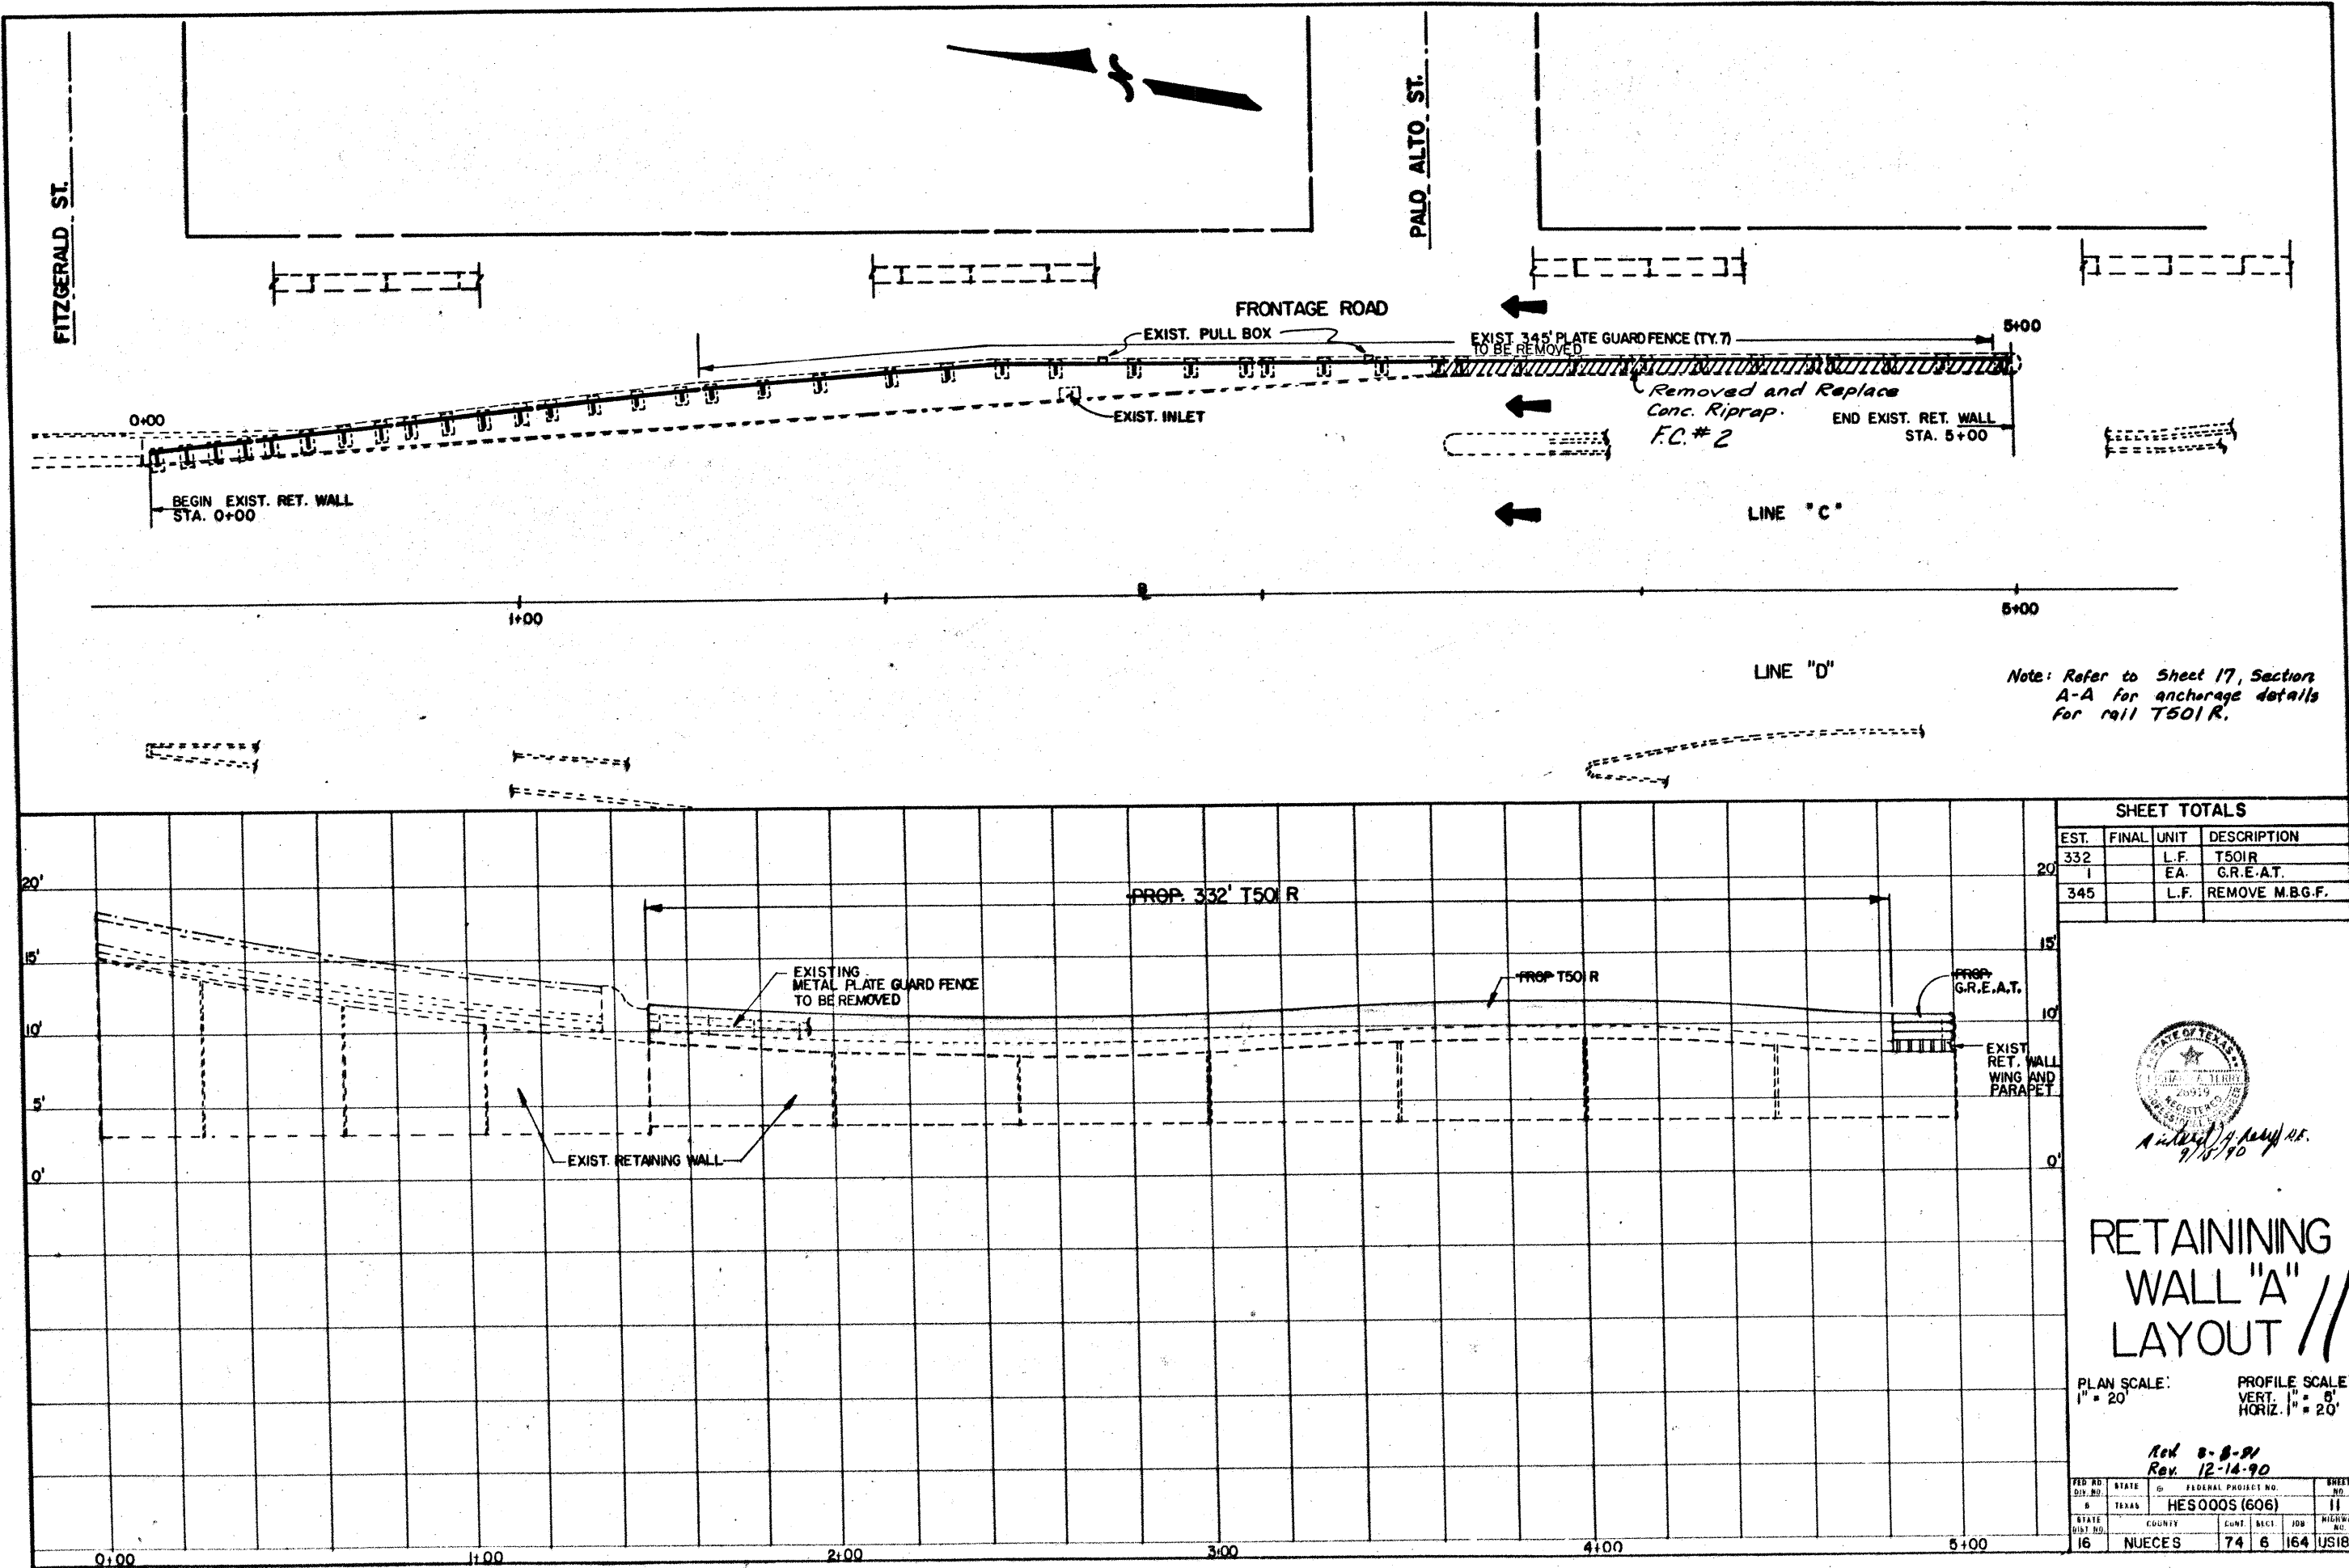

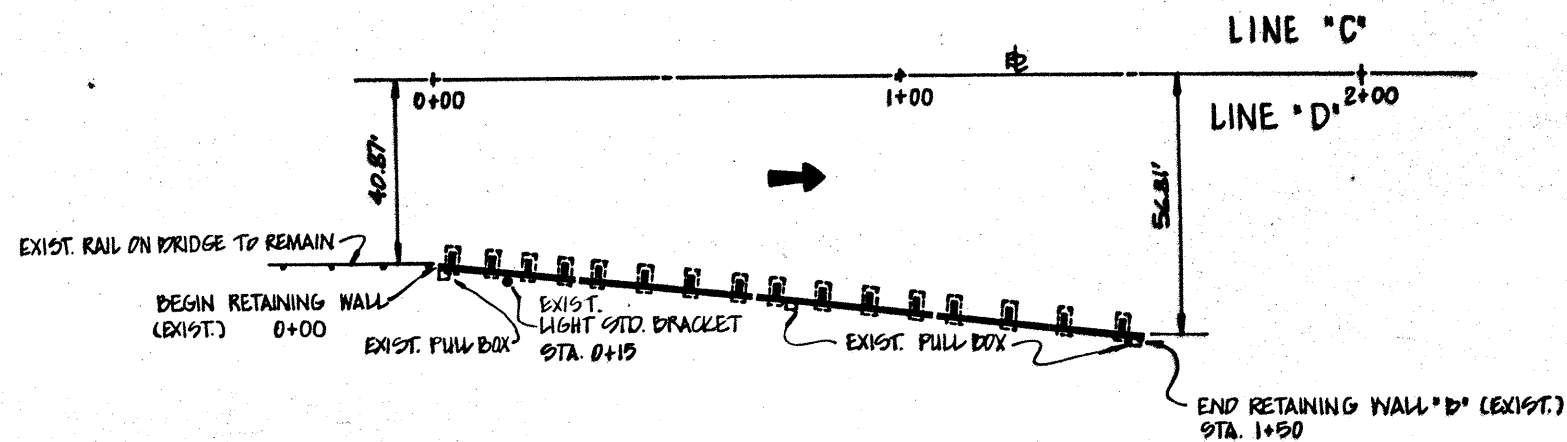

Note: Refer to Sheet 17, Section A-A for anchorage details for rail T501 R.

SHEET TOTALS			
FINAL	EST.	UNIT	DESCRIPTION
	150	L.F.	T501 R RAIL
	150	L.F.	REMOVE M.D.G.F.
	250	L.F.	M.D.G.F.
	1	EA.	TERM. ANCHOR SECT.

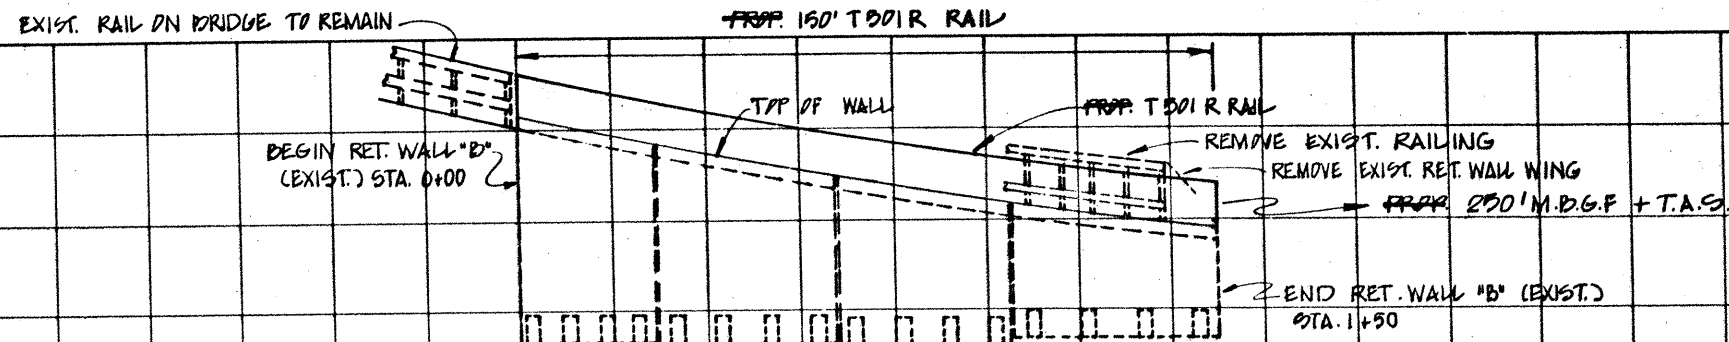

Richard A. Nuyes
9/10/98


RETAINING WALL "D"
LAYOUT

12


Rev. 12-14-90			
DESIGN NO.	STATE	FEDERAL PROJECT NO.	SHEET NO.
16	TEXAS	HES 0005 (606)	12
DATE	COUNTY	CONTRACT	JOB
9/10/98	NUECES	0074 06	164 (1918)

ESTIMATED QUANTITIES

*CLASS 'C' CONC. FOR EXT. STRUCTURES	C.Y.	L.F.
TRAFFIC RAIL TY. T 501 R	L.F.	583
TRAFFIC RAIL TY. T 501 R (SPECIAL)	L.F.	11.5
REMOVE M.D.G.P.	L.F.	594
RETAINING WALL	SF	86
EMBANK (DENS. CONT. XTY. C)	CY	12

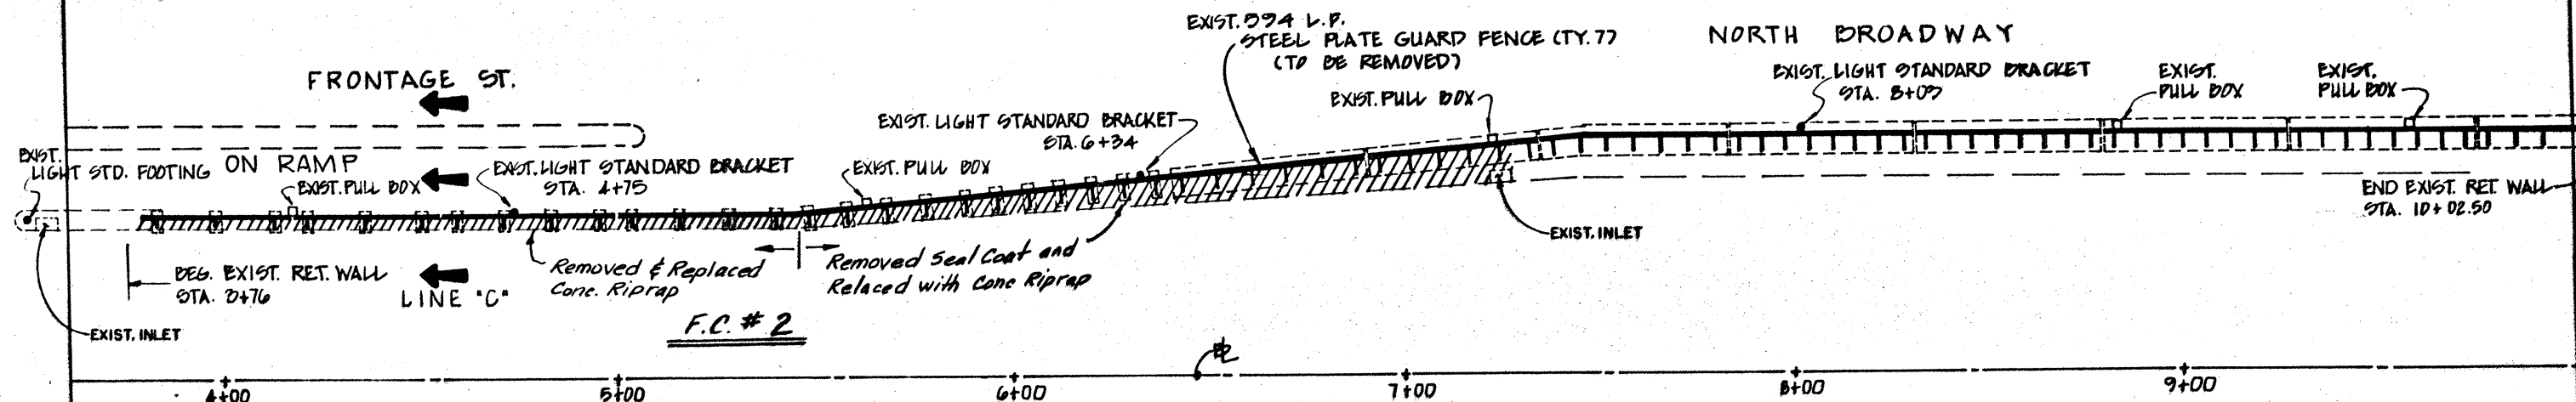



* FOR CONTRACTOR'S INFORMATION ONLY
(RETAIN. WALL EXTENSION)
DEG. BRIDGE STA. 9+69.57 LINE 'C'

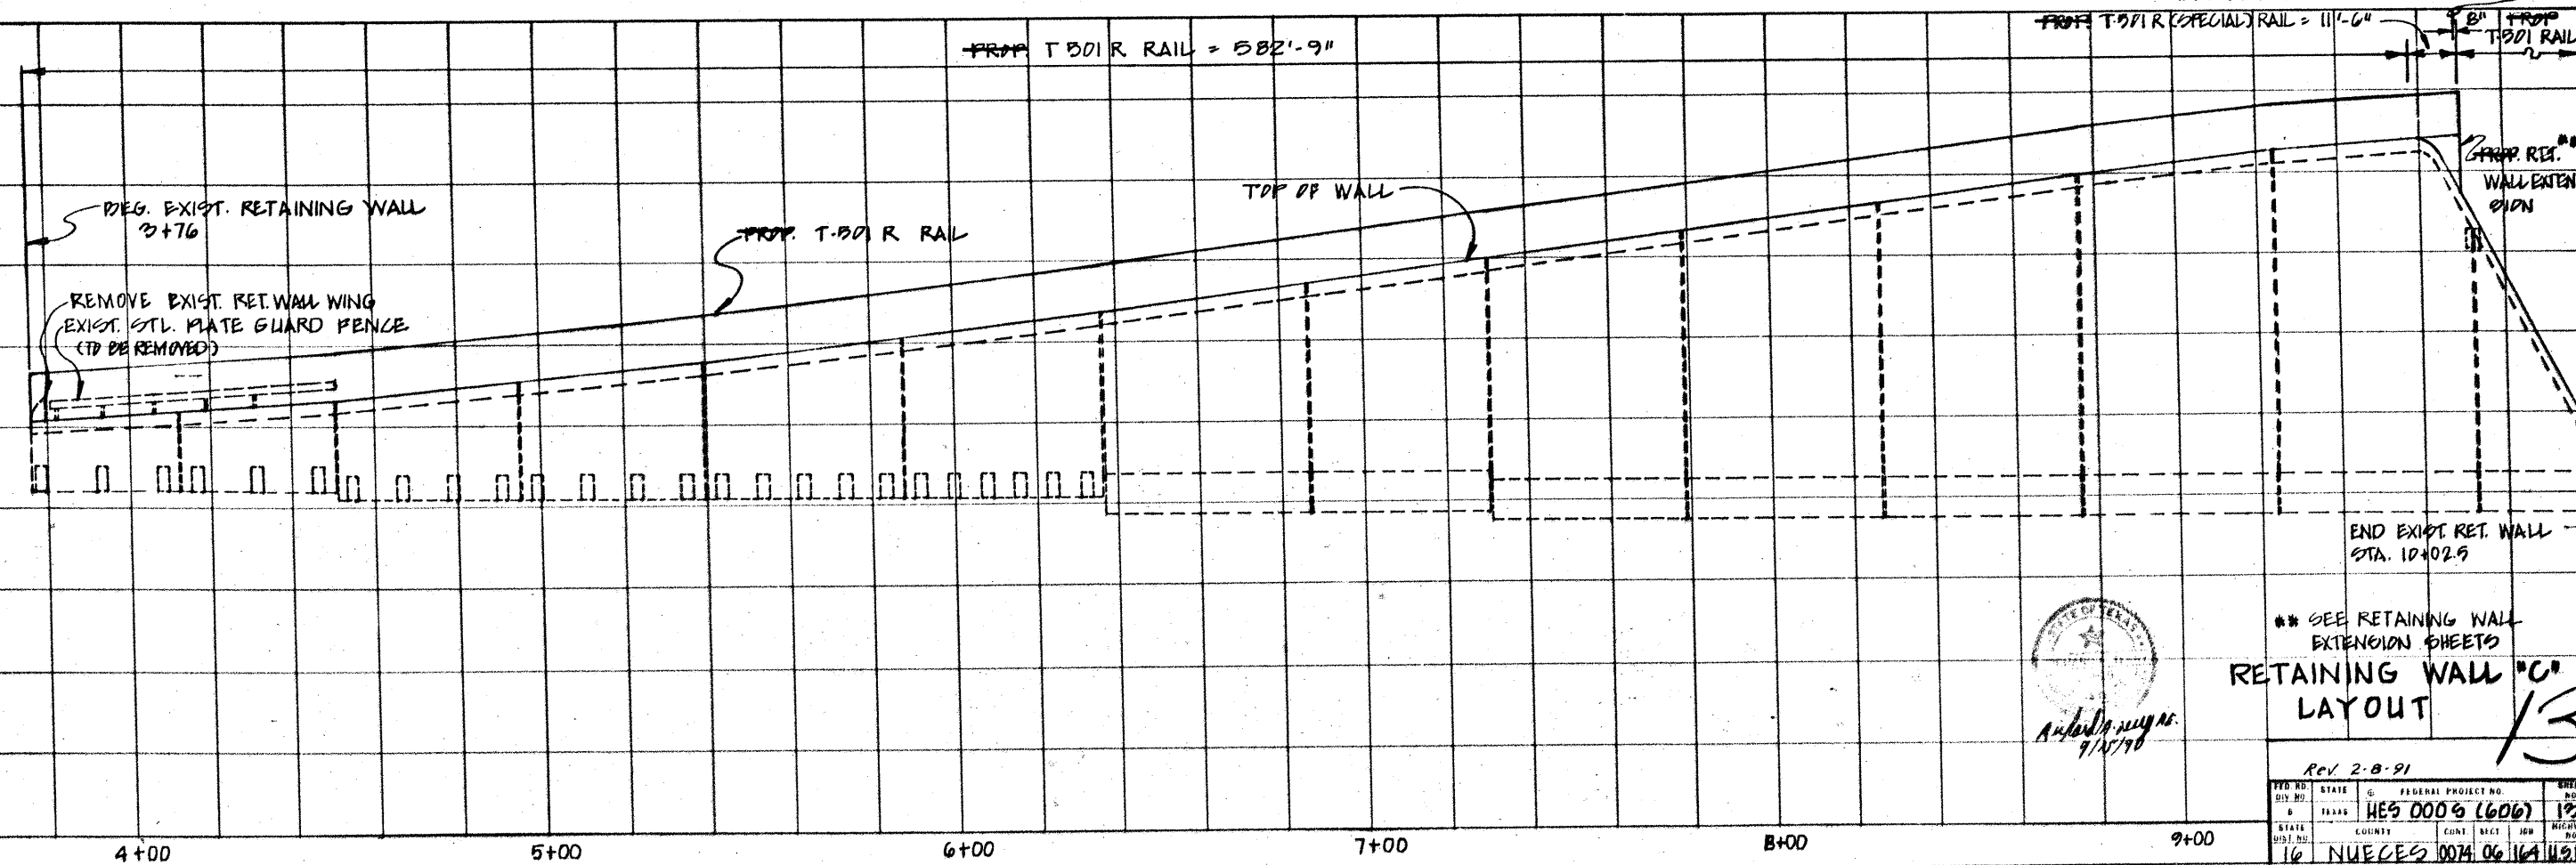


** SEE RETAINING WALL EXTENSION SHEETS
RETAINING WALL 'C' LAYOUT

Rev 2-8-91


DIST. NO.	STATE	FEDERAL PROJECT NO.	SHEET NO.
16	TEXAS	HE5 000 6 (606)	12
16	COUNTY	COM. SECT. 06	164 (1218)

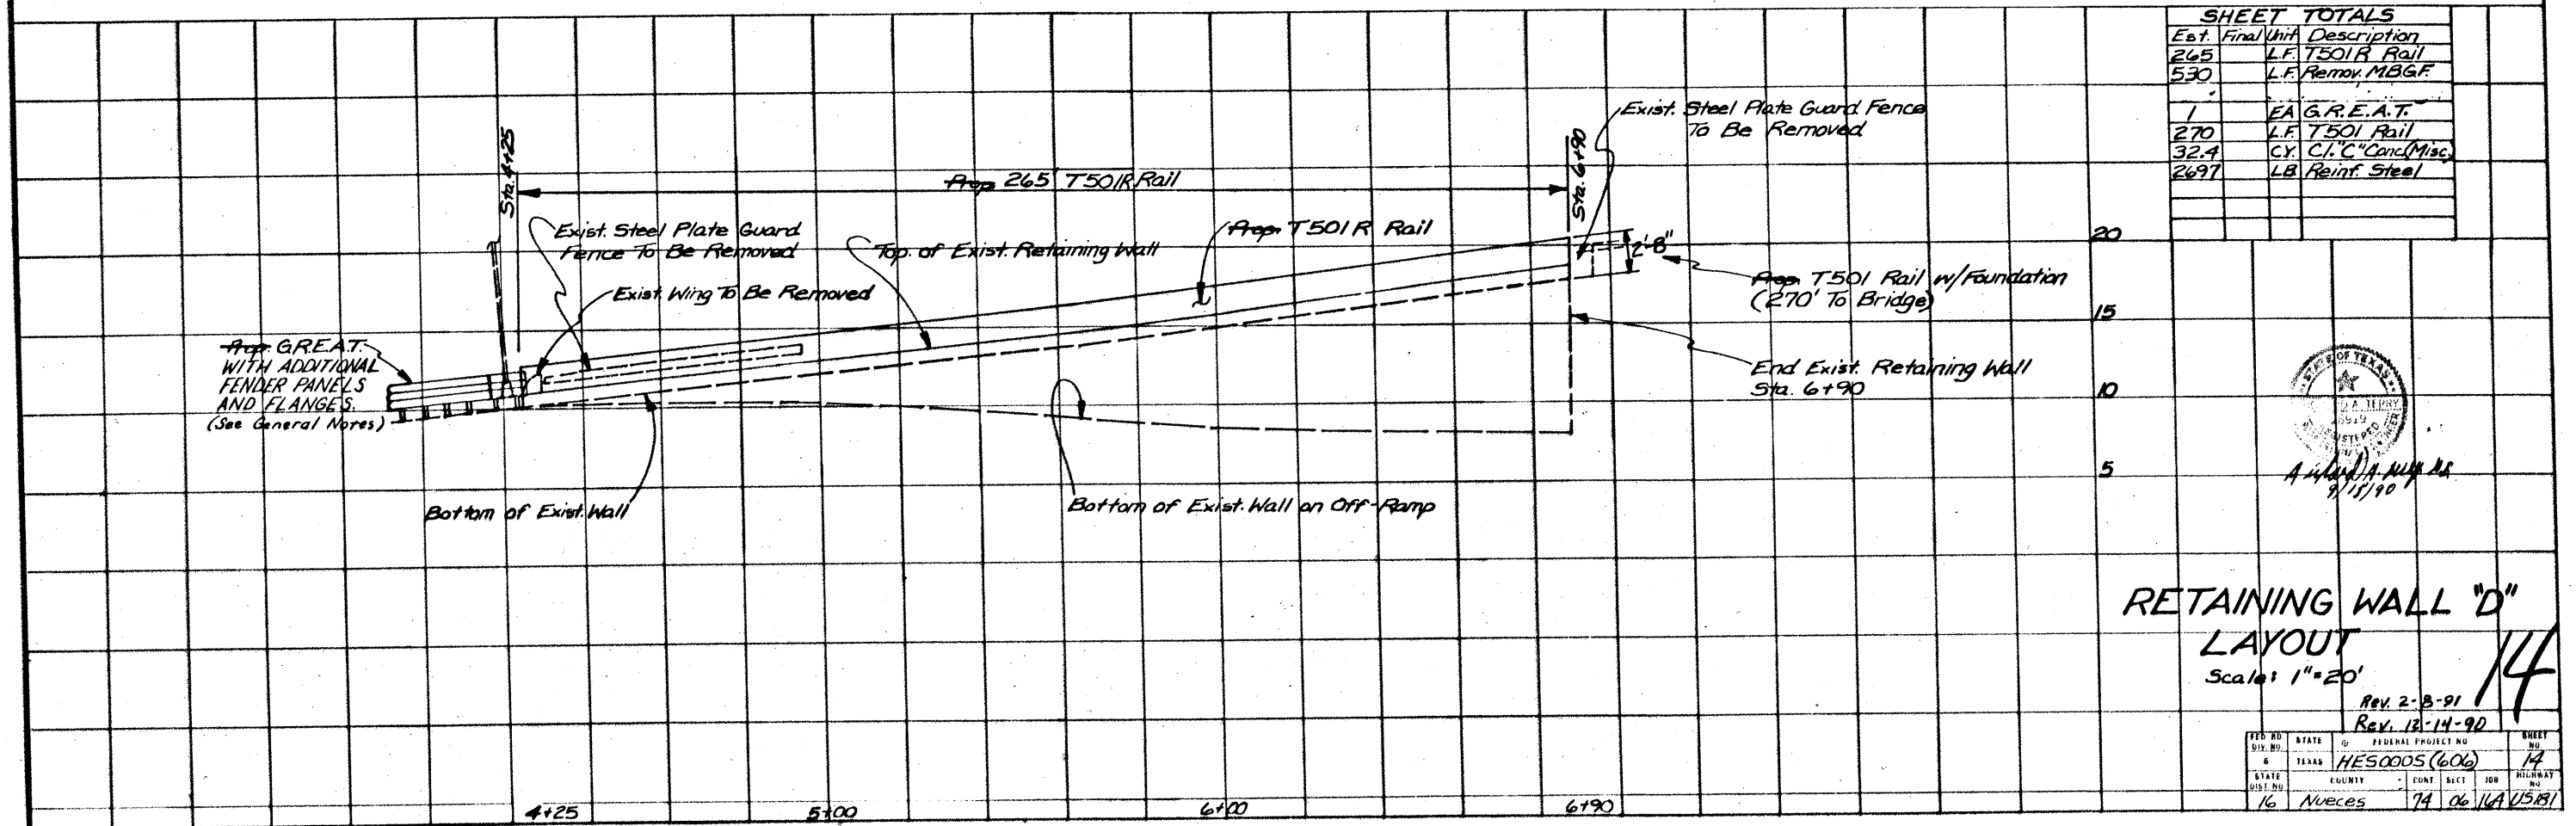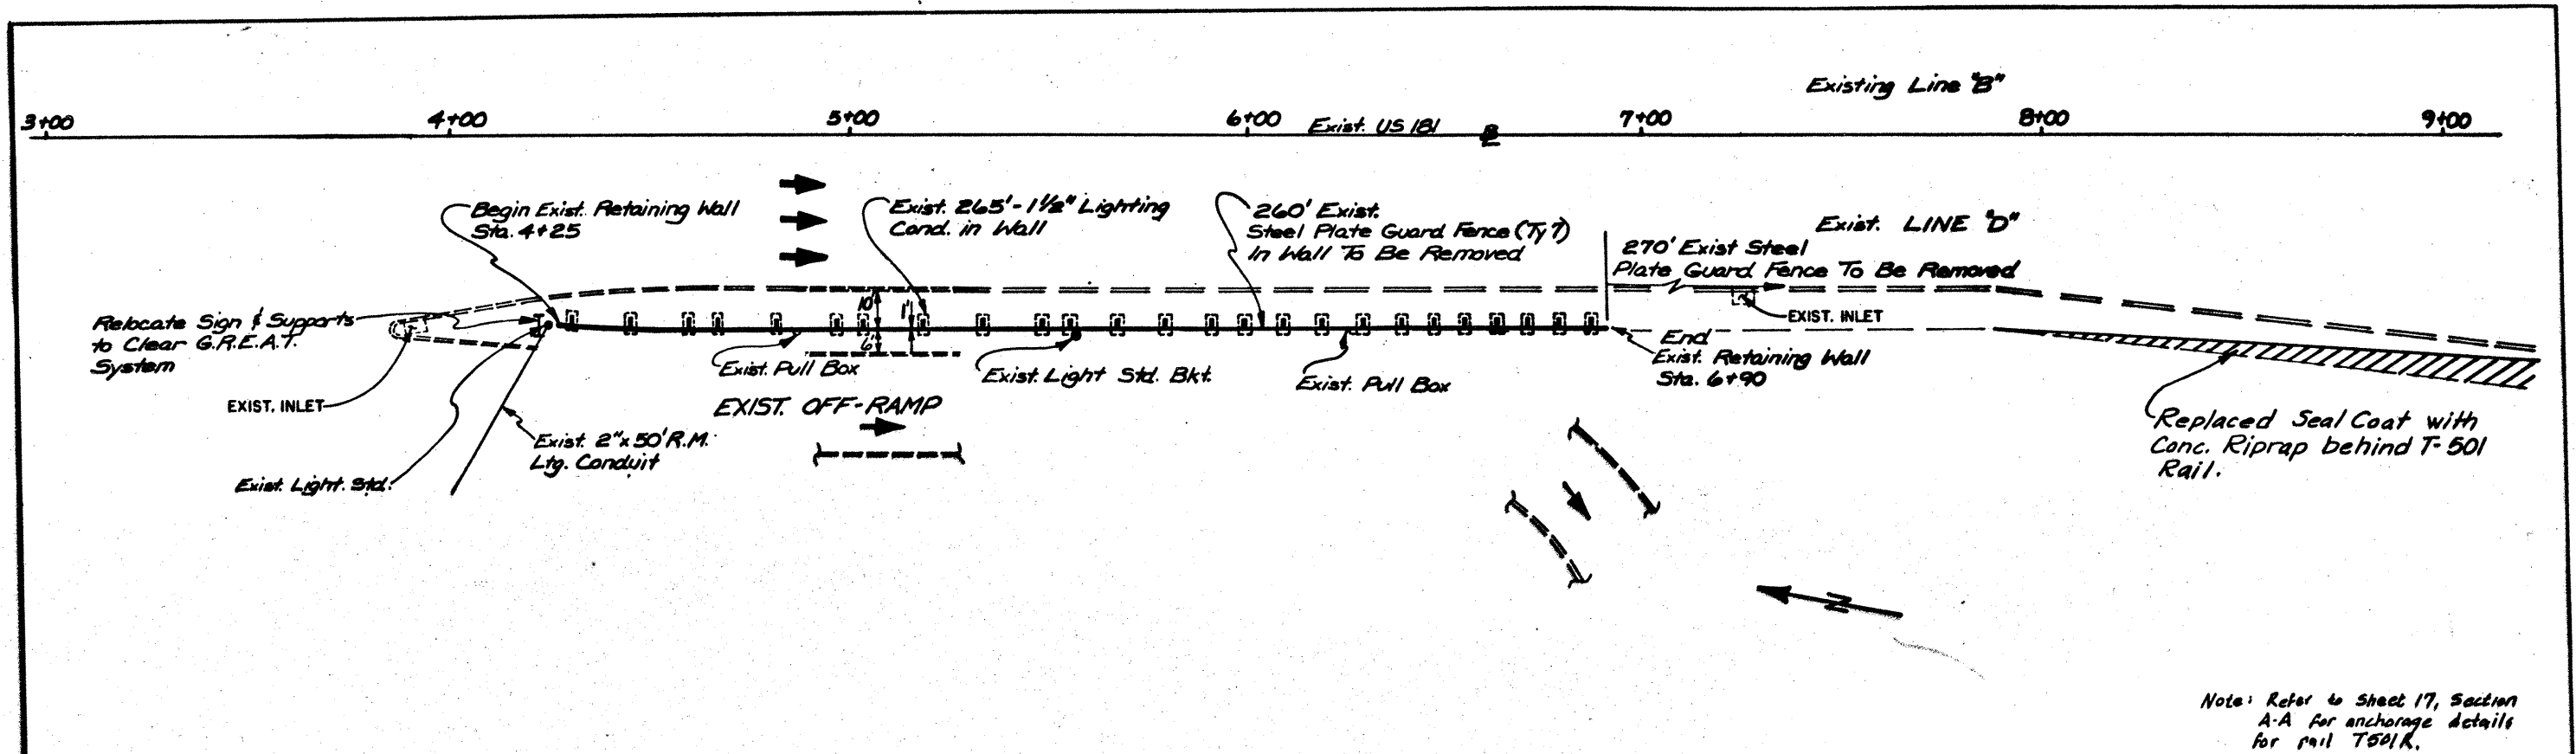

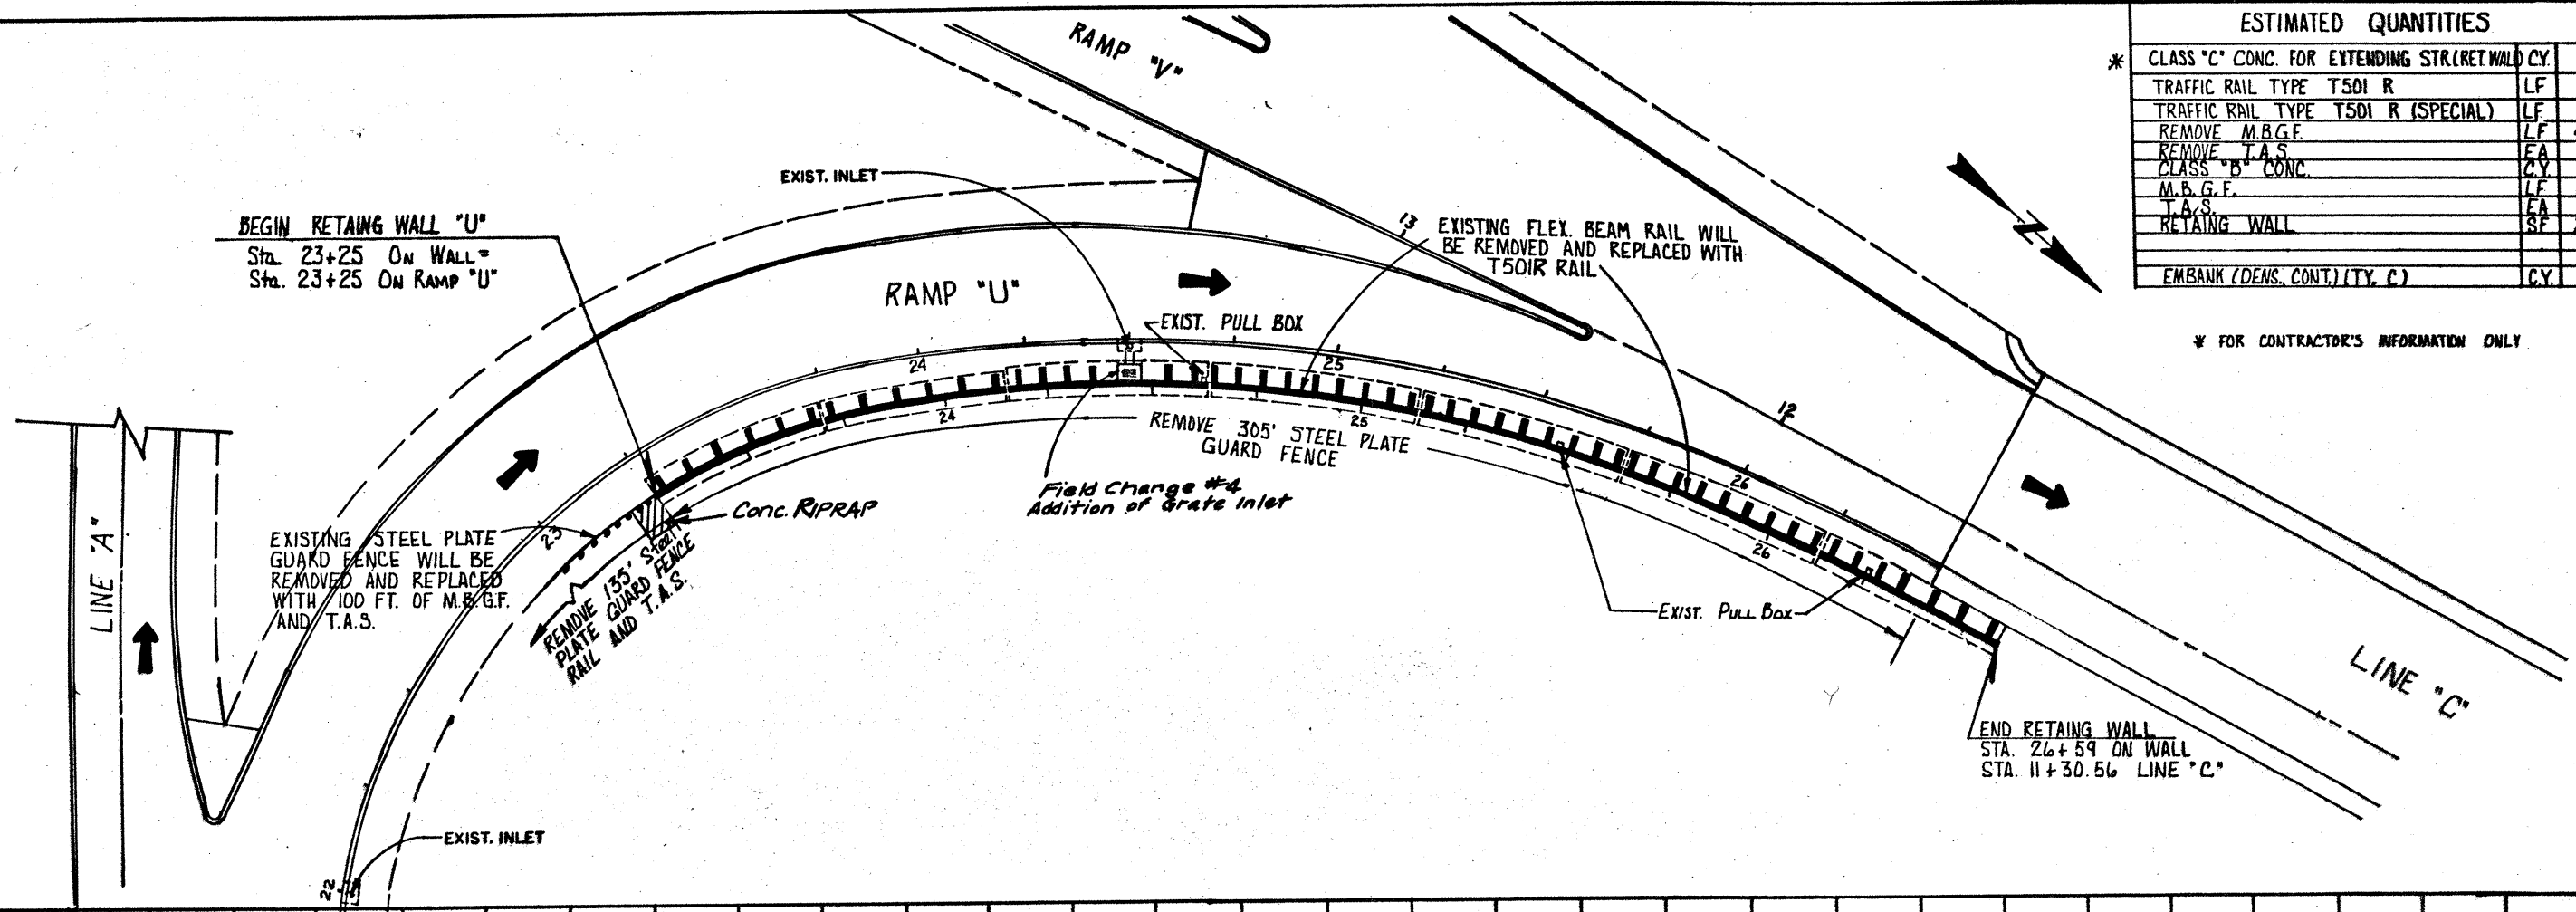

ESTIMATED QUANTITIES			
* CLASS "C" CONC. FOR EXTENDING STR.(RET.WALL)	CY.	8.9	
TRAFFIC RAIL TYPE T50I R	LF	293	
TRAFFIC RAIL TYPE T50I R (SPECIAL)	LF	227	
REMOVE M.B.G.F.	LF	440	
REMOVE T.A.S.	EA	3	
CLASS "B" CONC.	CY.	3	
M.B.G.F.	LF	100	
T.A.S.	EA	1	
RETAINING WALL	SF	210	
EMBANK (DENS. CONT.) (TY. C)	CY.	68	


* FOR CONTRACTOR'S INFORMATION ONLY

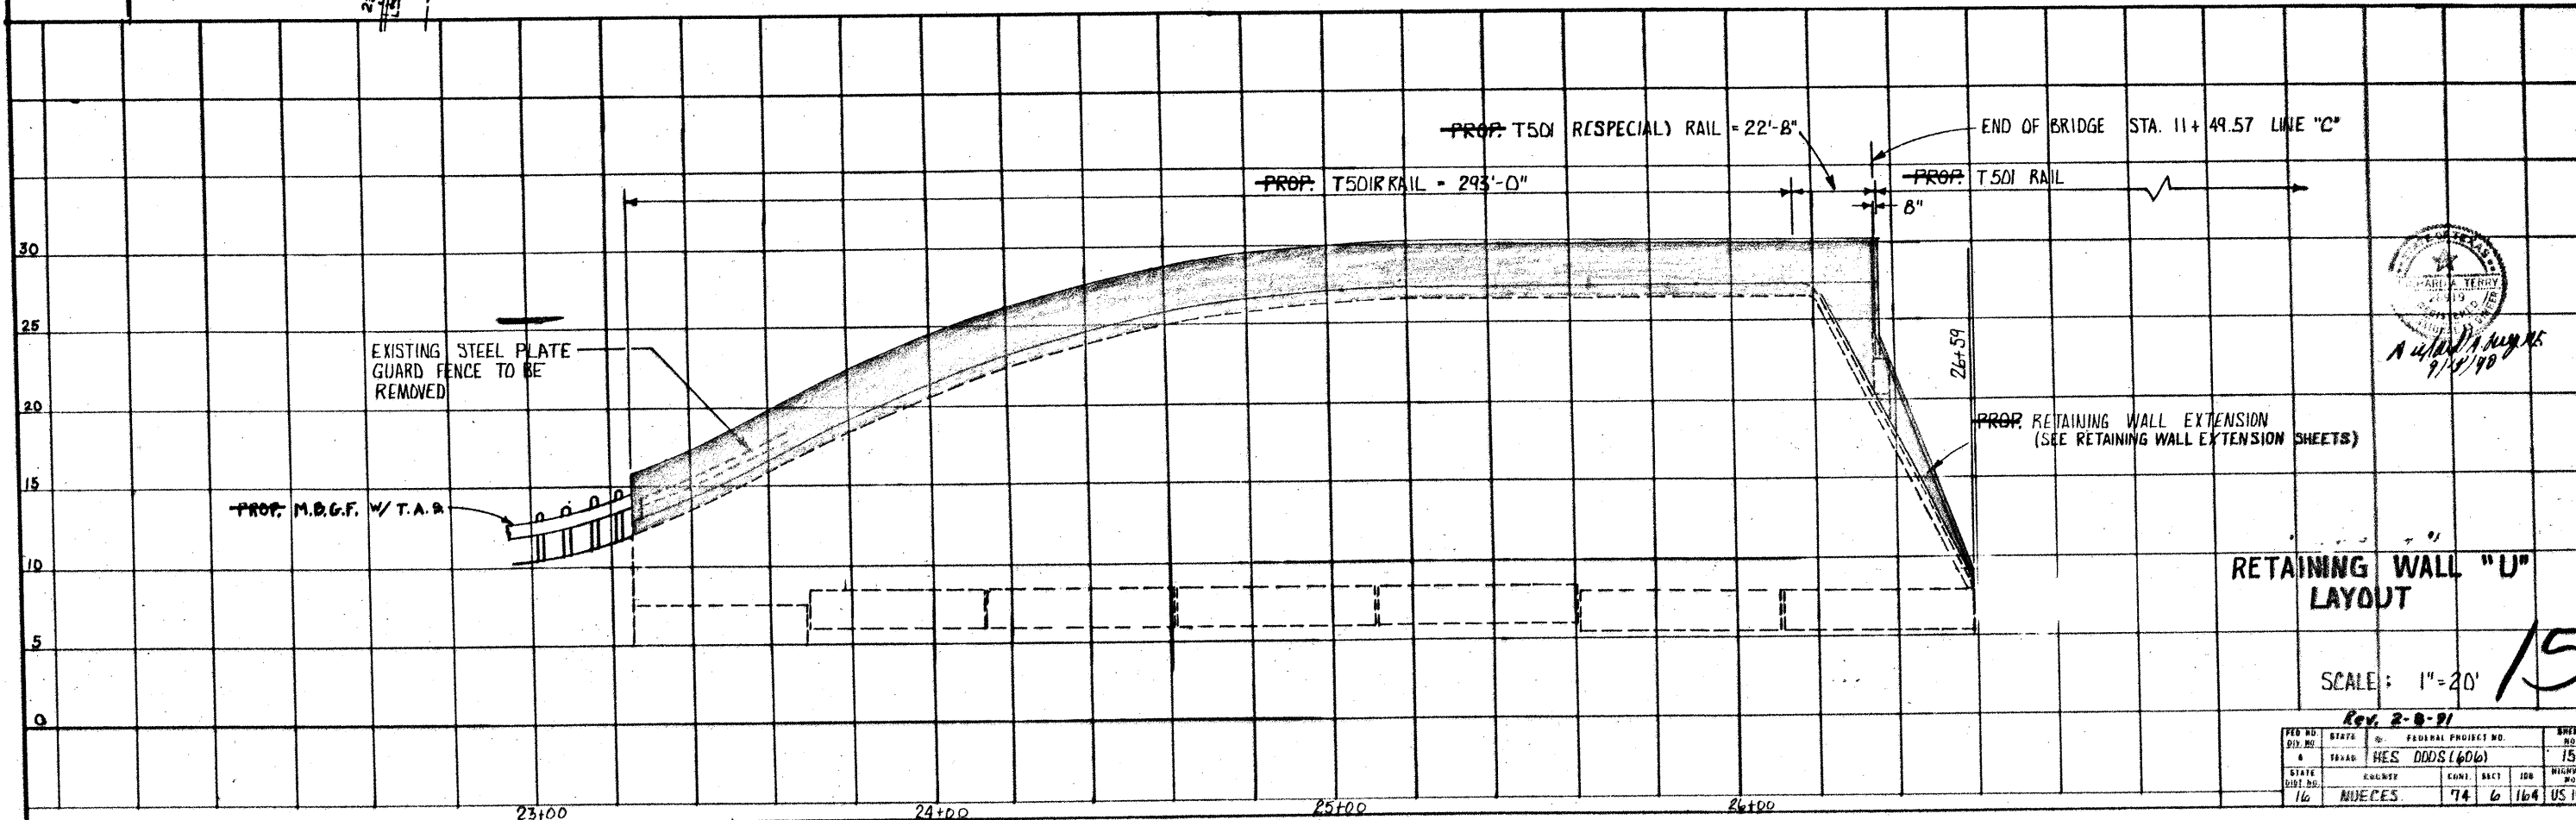


RETAINING WALL "U"
LAYOUT


SCALE: 1"=20'

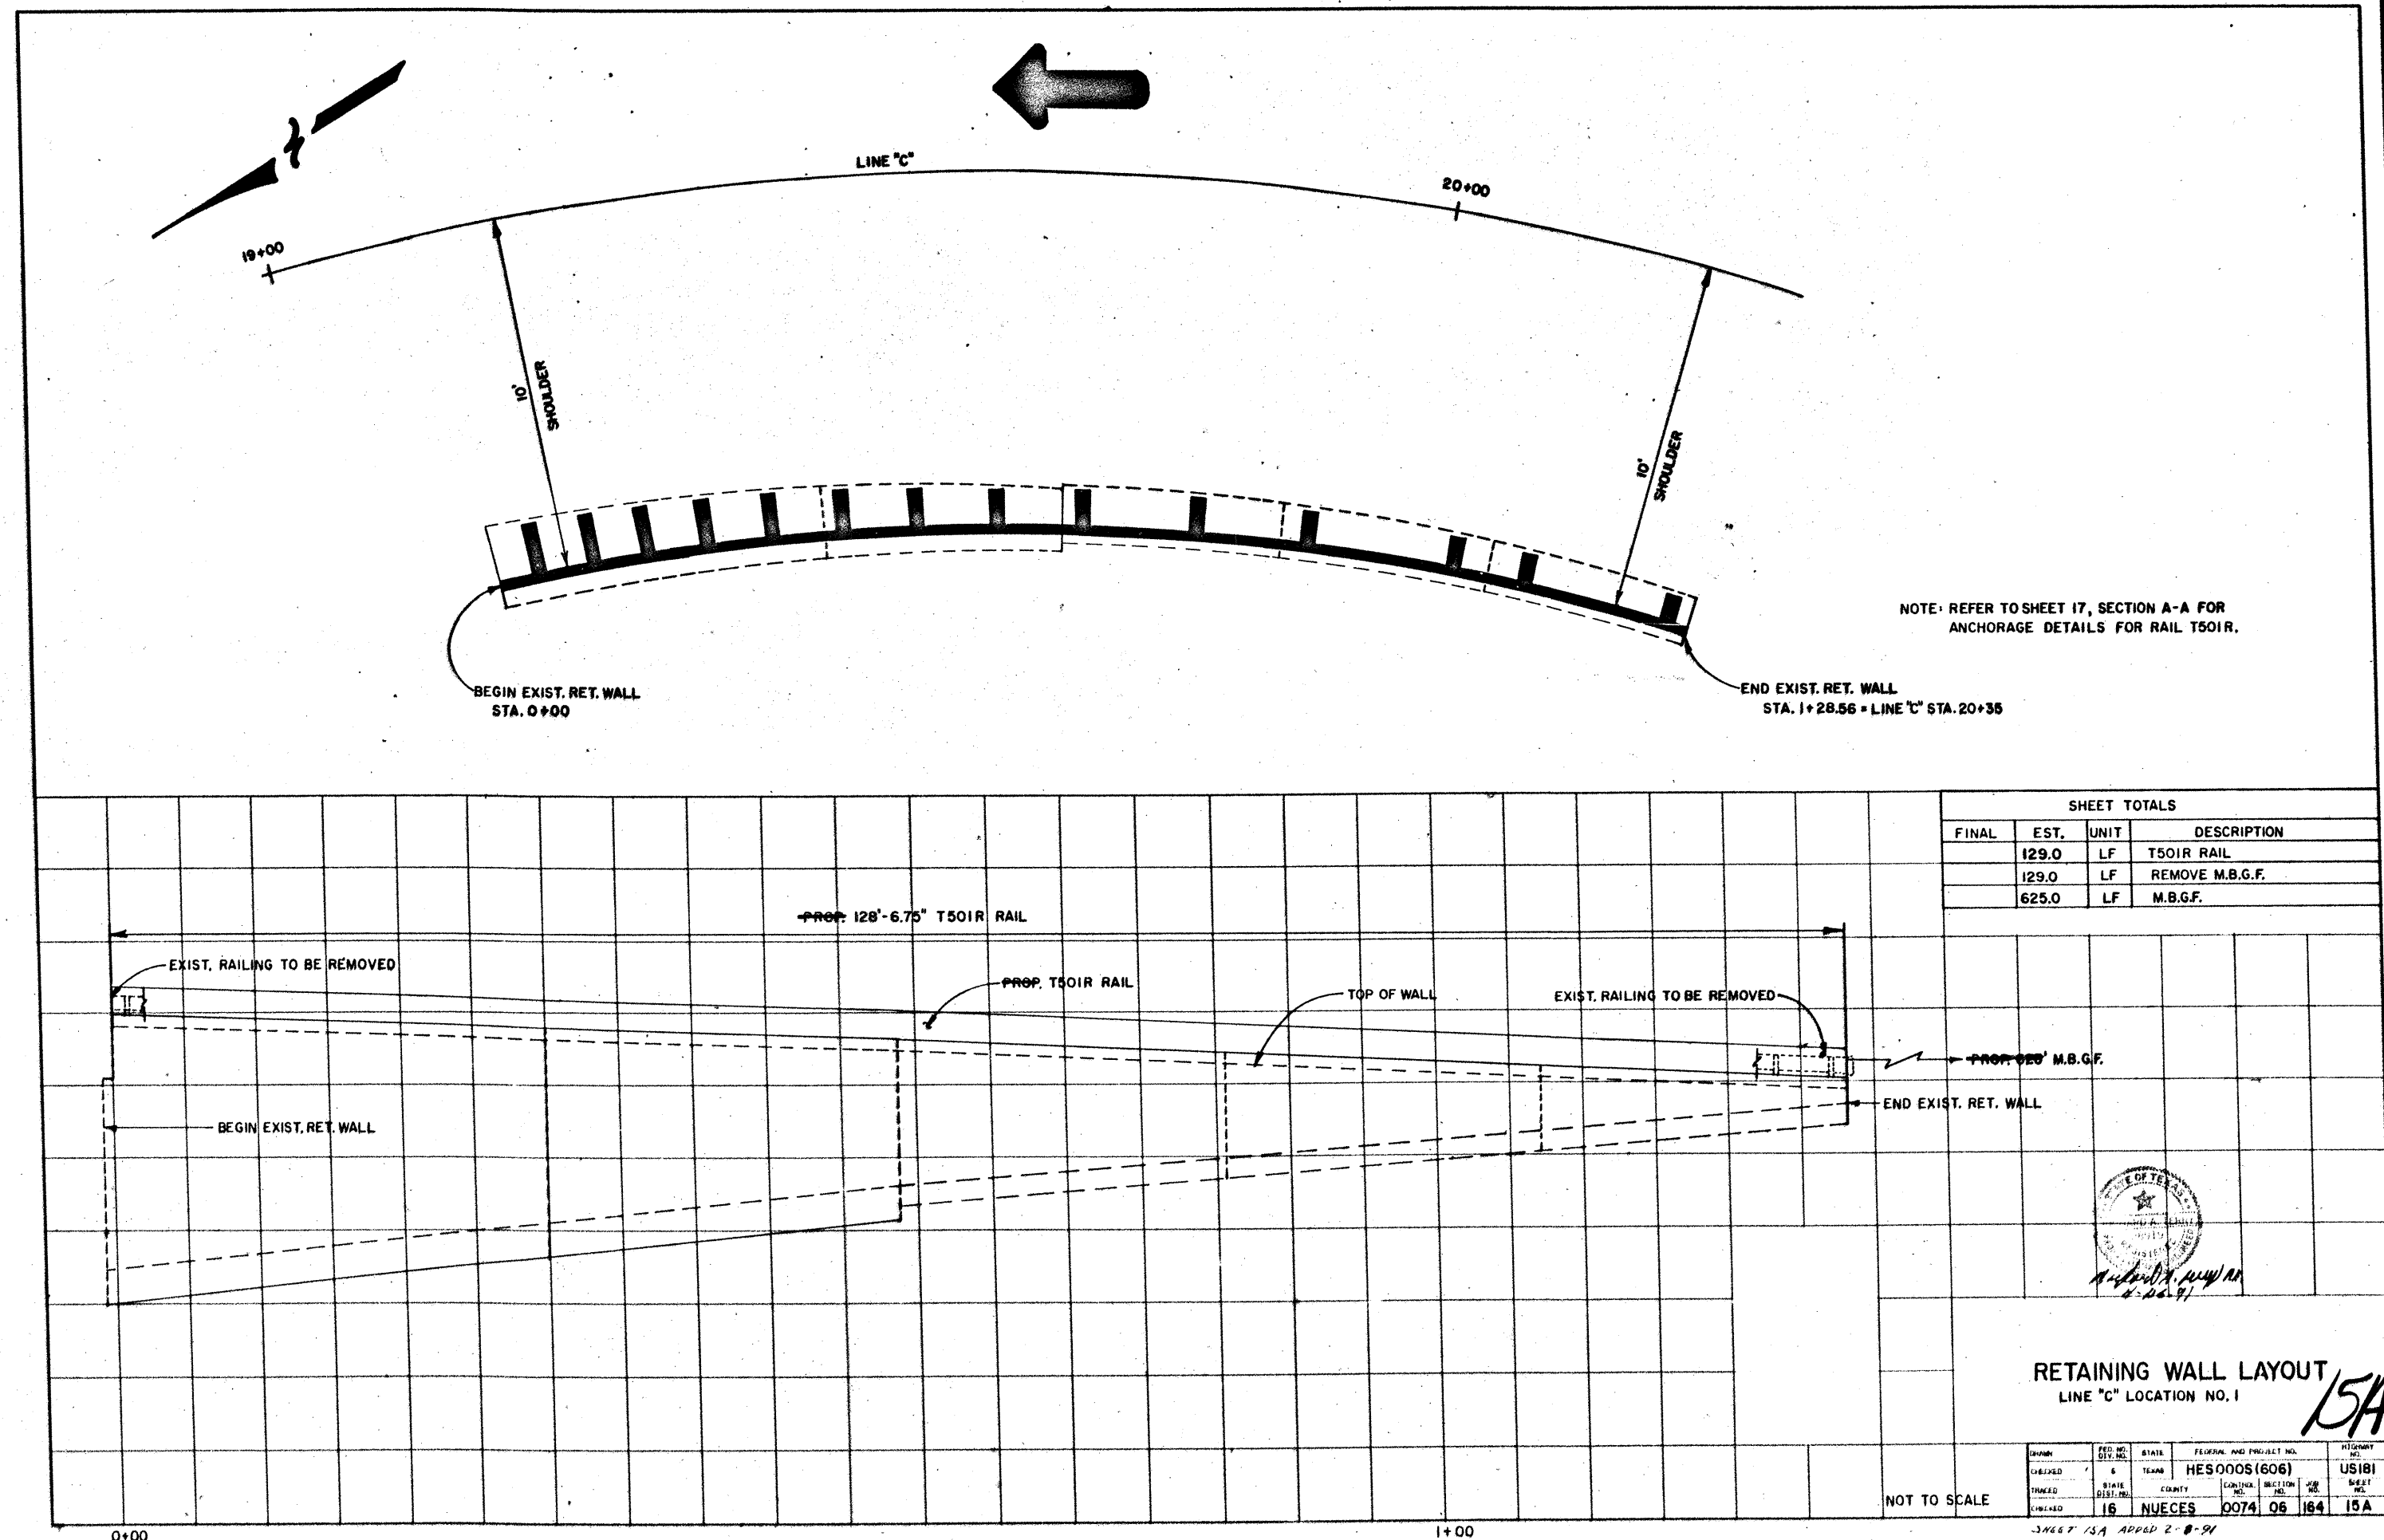


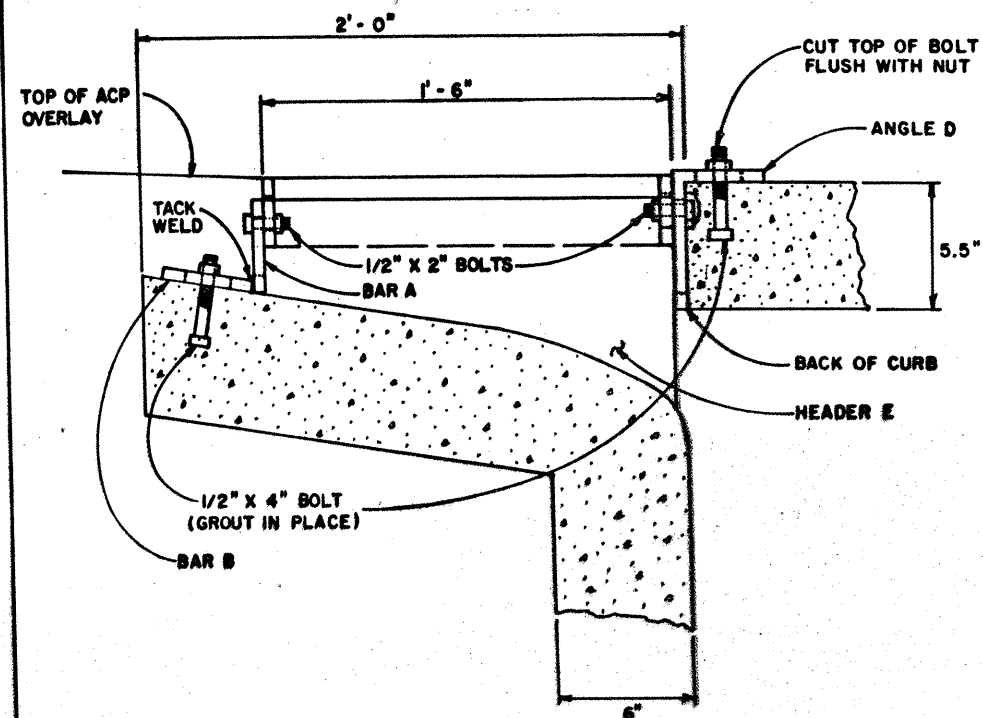


GRATE MOUNT DETAIL
(FOR EXIST. CURB INLET TYPE D & E)
(4" TO 5" OVERLAY THICKNESS)

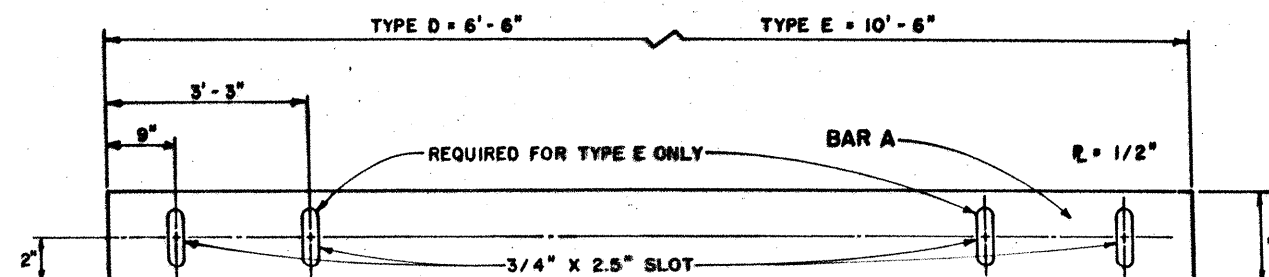


ALL SLOTS HAVE RADII EQUAL TO 0.375"
BAR IS SYMMETRIC ABOUT LATERAL CENTERLINE

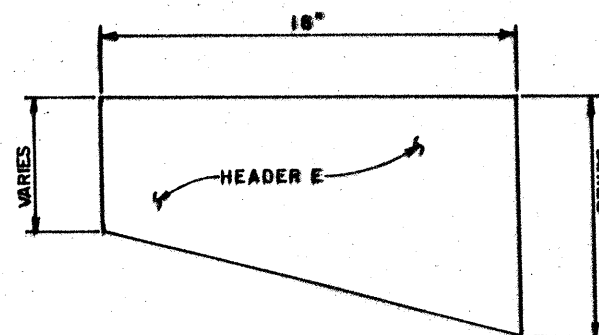


NOTE: PAYMENT FOR VARIABLE DEPTH METAL PLATE HEADERS AT EACH END OF GRATE, GROUTING OF BOLTS, SAWCUTTING AND RESTORING OF PAVEMENT SHALL NOT BE PAID FOR DIRECTLY, BUT SHALL BE CONSIDERED SUBSIDIARY TO THE UNIT BID ITEM.
BOLTS AND NUTS SHALL CONFORM TO ASTM A307. STEEL BARS SHALL CONFORM TO ASTM A36.
GRATES, BARS, AND HEADERS SHALL BE GIVEN ONE COAT OF A COMMERCIAL GRADE PRIMER AND TWO COATS OF COMMERCIAL GRADE ALUMINUM PAINT. PAINTED ELEMENTS DAMAGED DURING TRANSPORT OR CONSTRUCTION SHALL BE REPAIRED THROUGH THE APPLICATION OF PRIMER AND ALUMINUM PAINT.
COMMERCIAL GRADE GALVANIZED BOLTS AND NUTS SHALL BE USED.

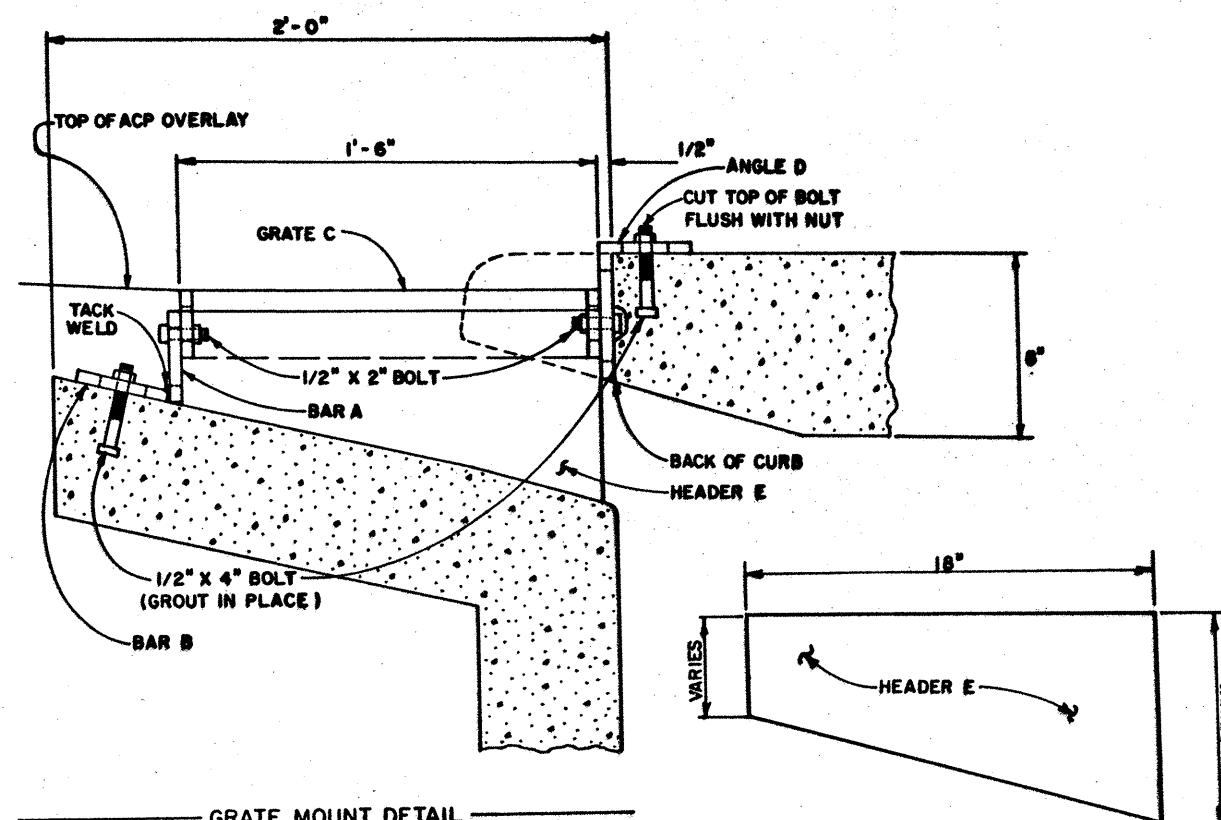

GRATE MOUNT DETAIL
(FOR EXIST. CURB INLET TYPE A & B)
(4" TO 5" OVERLAY THICKNESS)

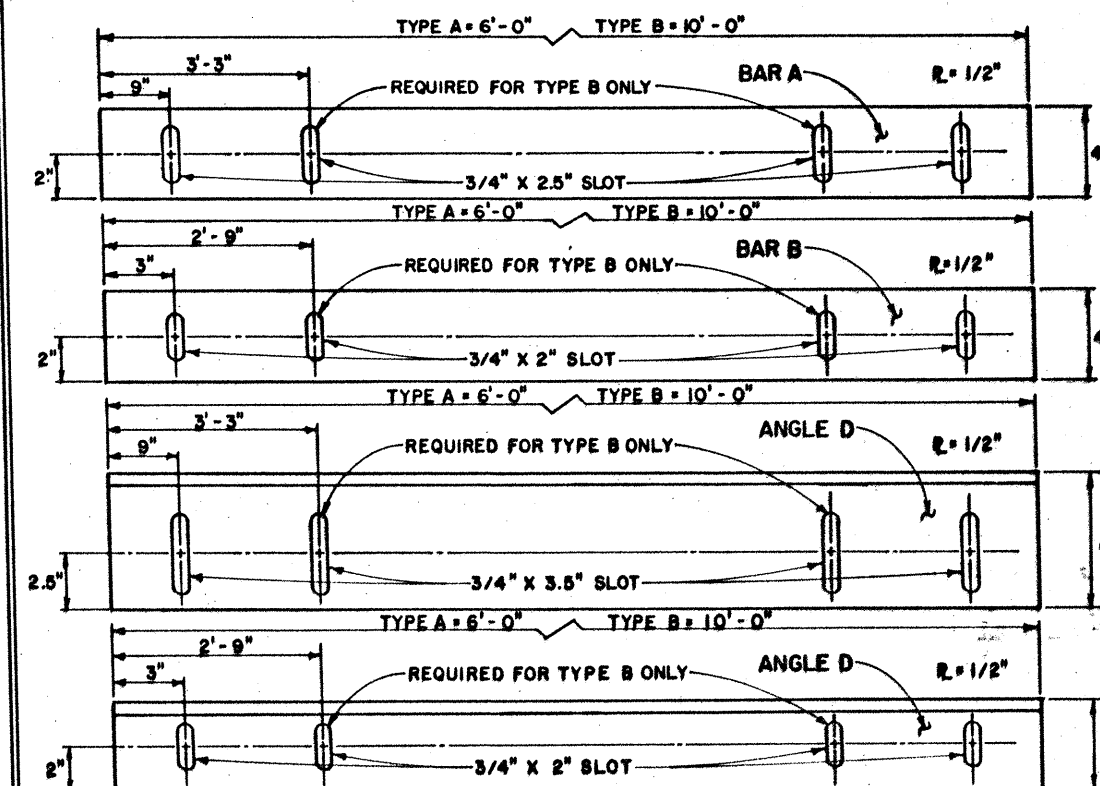


ALL SLOTS HAVE RADII EQUAL TO 0.375"
ALL BARS ARE SYMMETRIC ABOUT THEIR LATERAL CENTERLINES

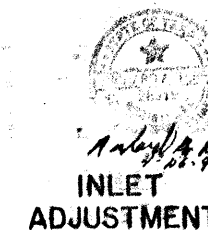


INLET
ADJUSTMENT


FIG. NO.	STATE	FEDERAL PROJECT NO.	SHEET NO.
16	TEXAS	HE50008(606)	18
COUNTY	CITY	CDCT	JOH
NUECES	0074	06	164

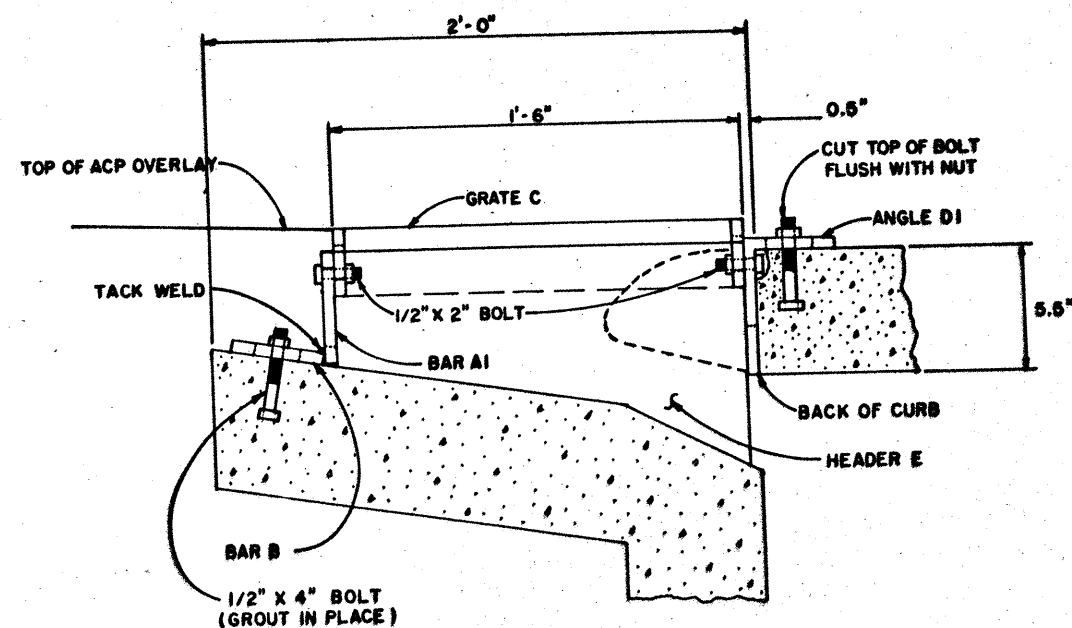


GRATE MOUNT DETAIL
(FOR EXIST. CURB INLET TYPE D & E)
(5" TO 6" OVERLAY THICKNESS)

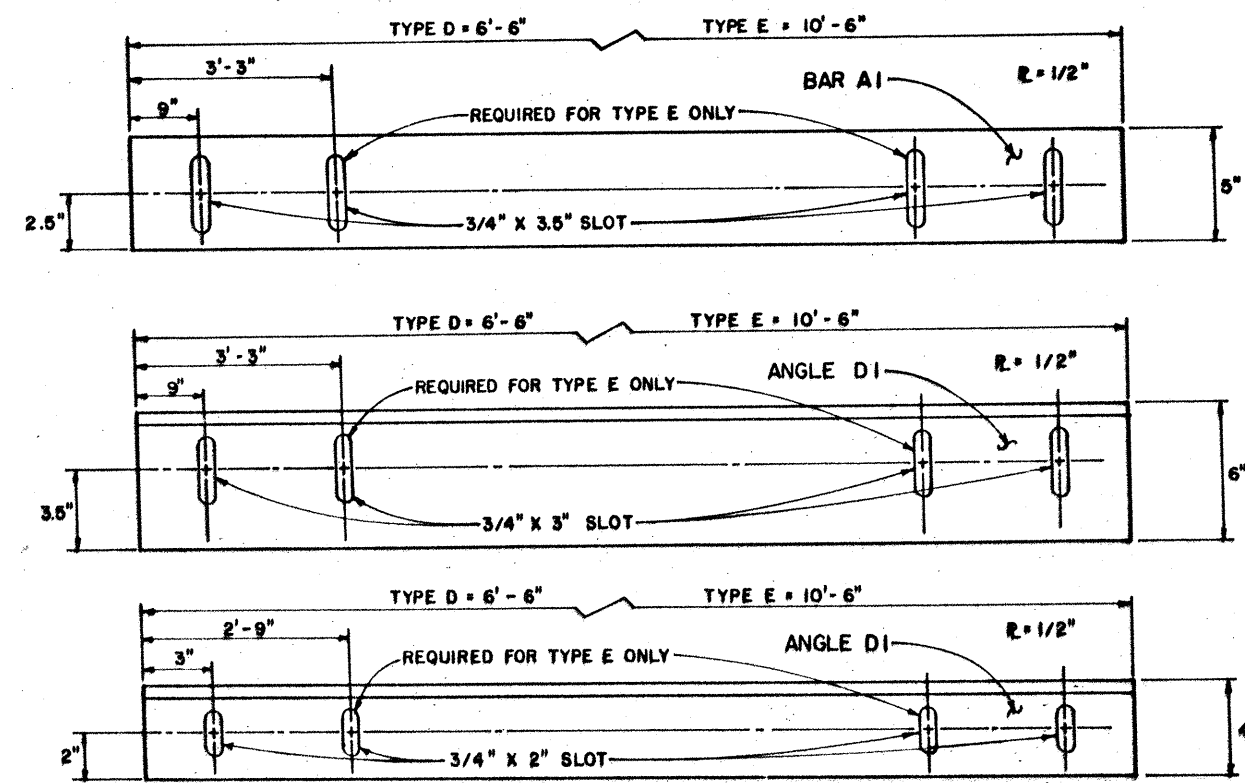

ALL SLOTS HAVE RADII EQUAL TO 0.375"
ALL BARS AND ANGLES ARE SYMMETRIC TO THEIR LATERAL CENTERLINES

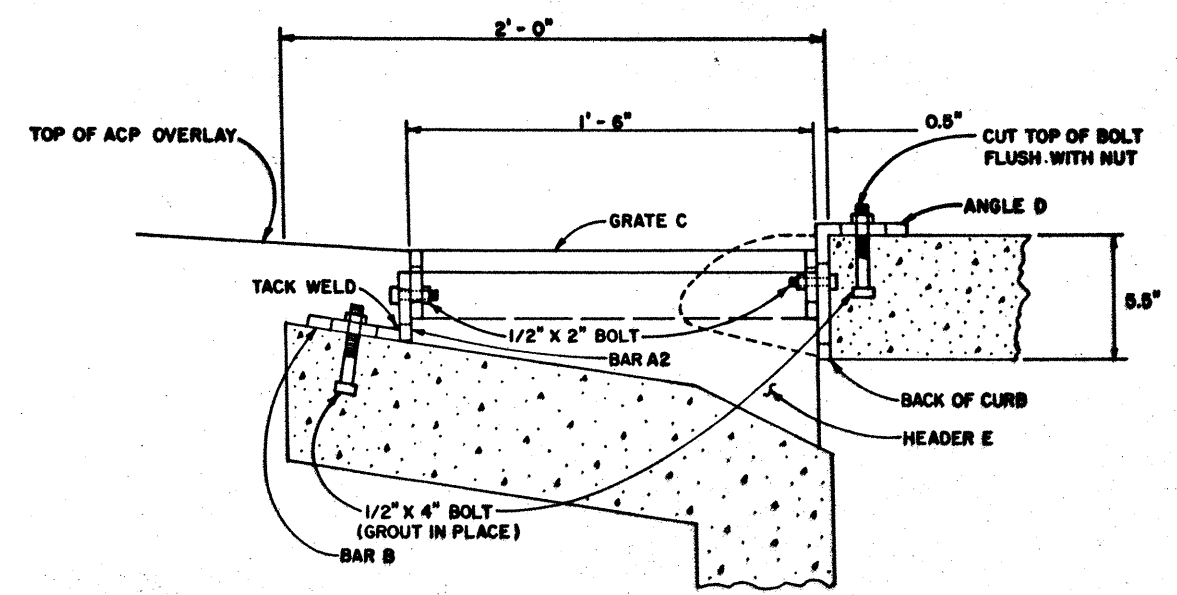

GRATE MOUNT DETAIL
(FOR EXIST. CURB INLET TYPE D & E)
(3" TO 4" OVERLAY THICKNESS)

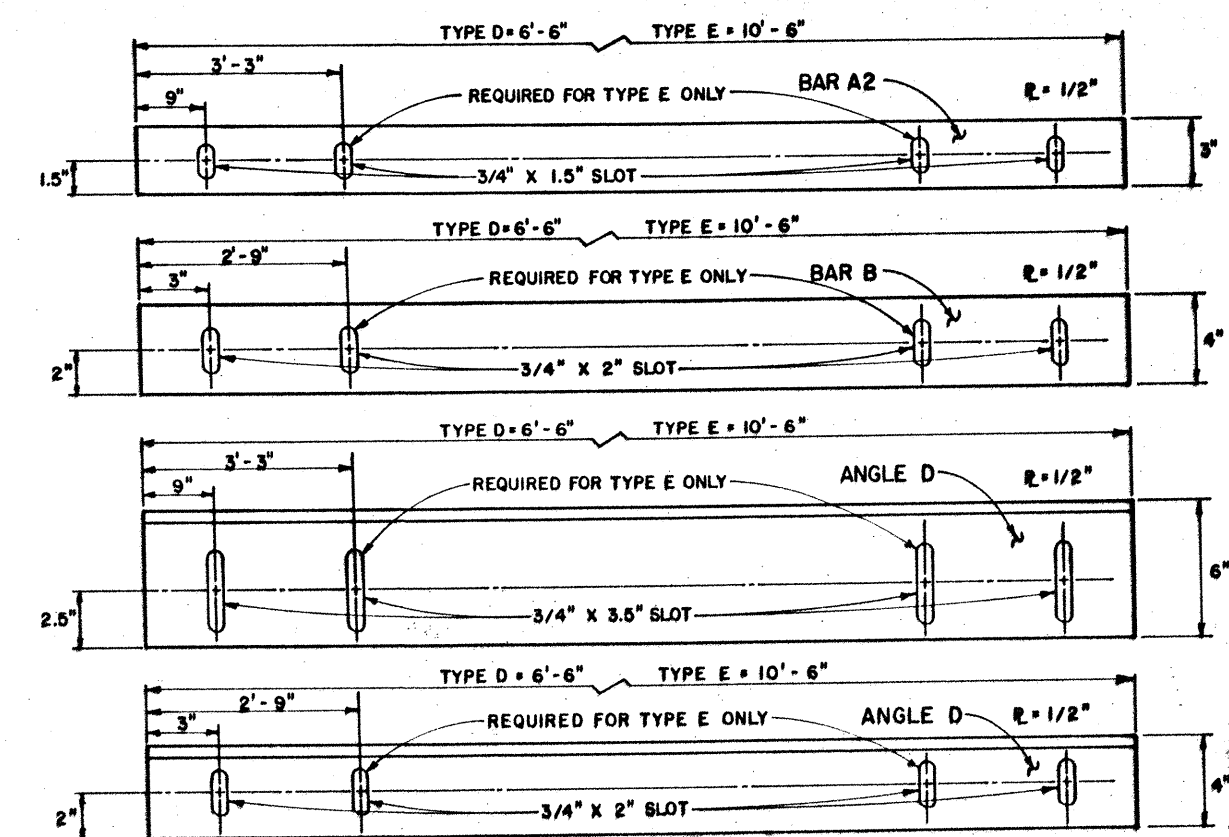



ALL SLOTS HAVE RADII EQUAL TO 0.375"
ALL BARS AND ANGLES ARE SYMMETRIC TO THEIR LATERAL CENTERLINES

INLET
ADJUSTMENT



Spec. Sheet 18 R-8-21

FED. RD. DIST. NO.	STATE	FEDERAL PROJECT NO.	SHEET NO.
4	TEXAS	HE5000S(606)	18A
STATE DIST. NO.	COUNTY	CONTRACT NO.	SECTION NO.
16	NUECES	0074 06	164 US181

* SEE SHEET FOR DETAILS ON

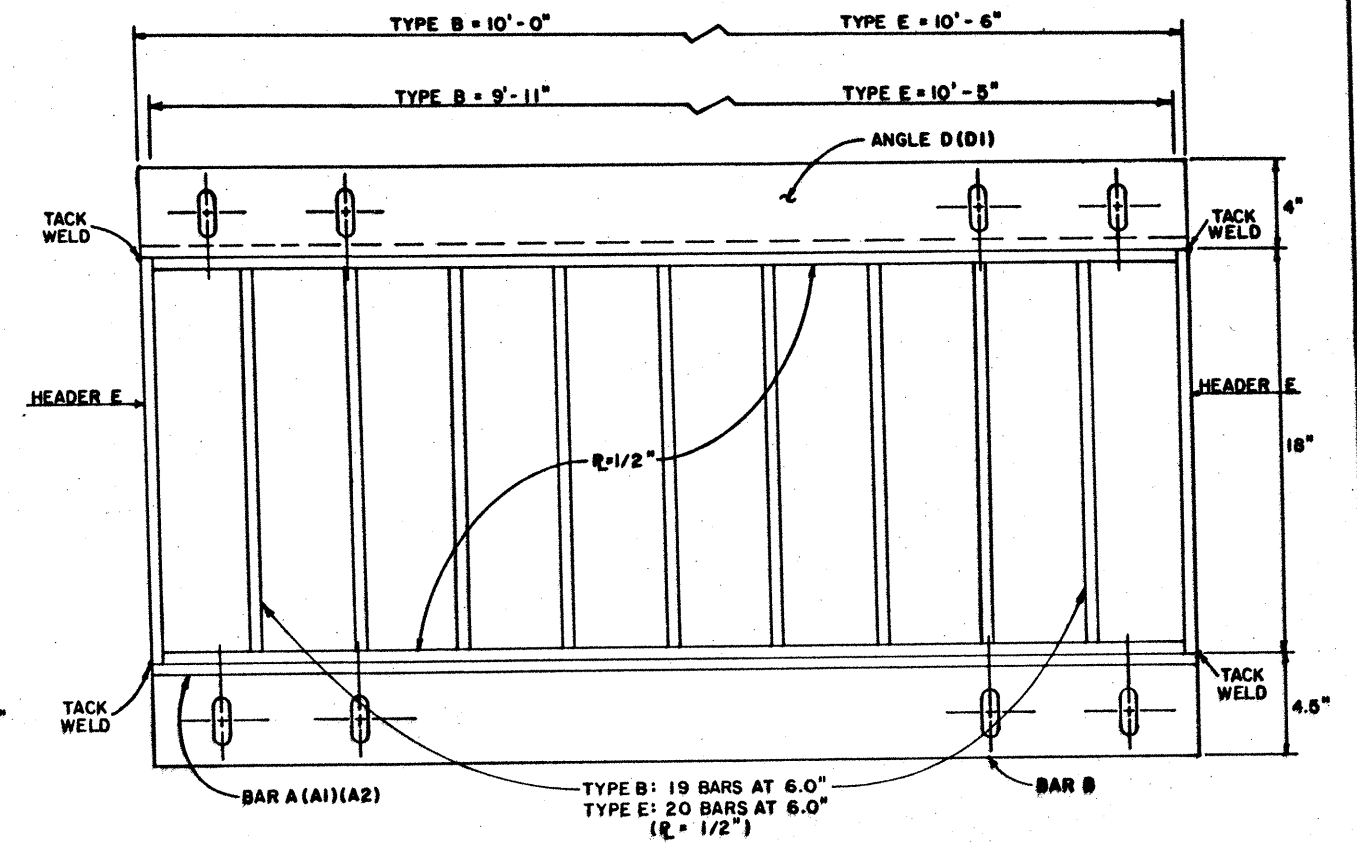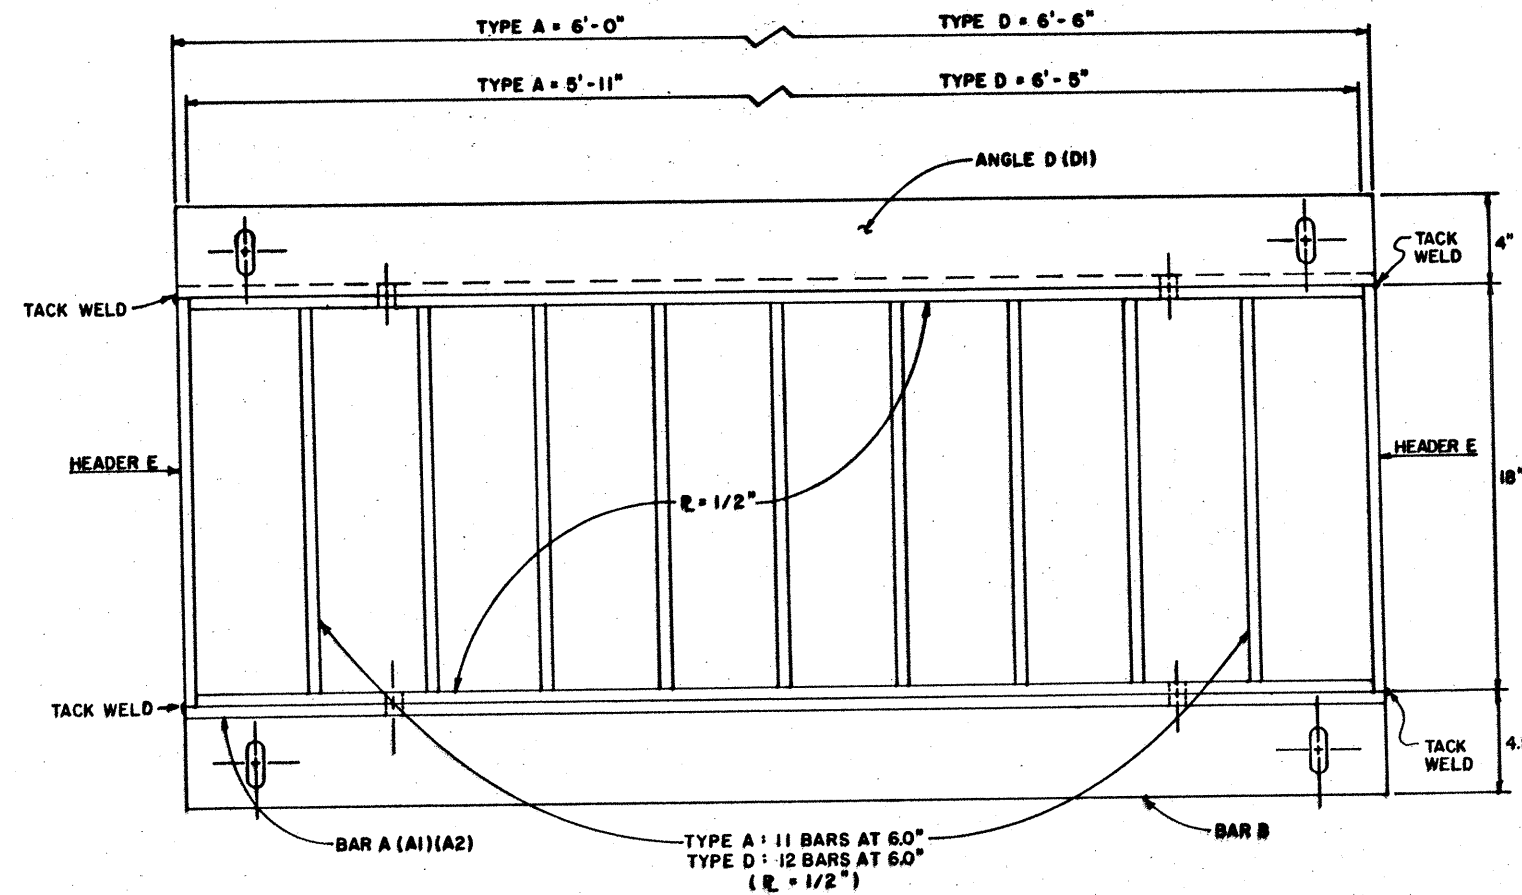

— SEE INLET ADJUSTMENT SHEET FOR DETAILS ON PLATE A, PLATE B, AND ANGLE D. —

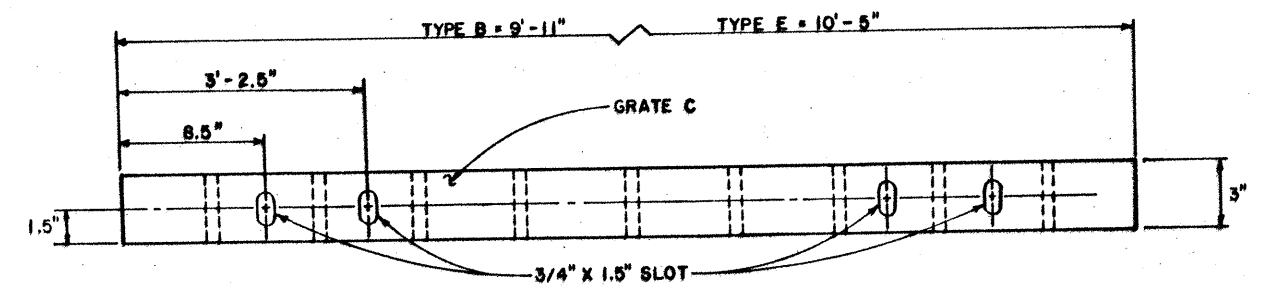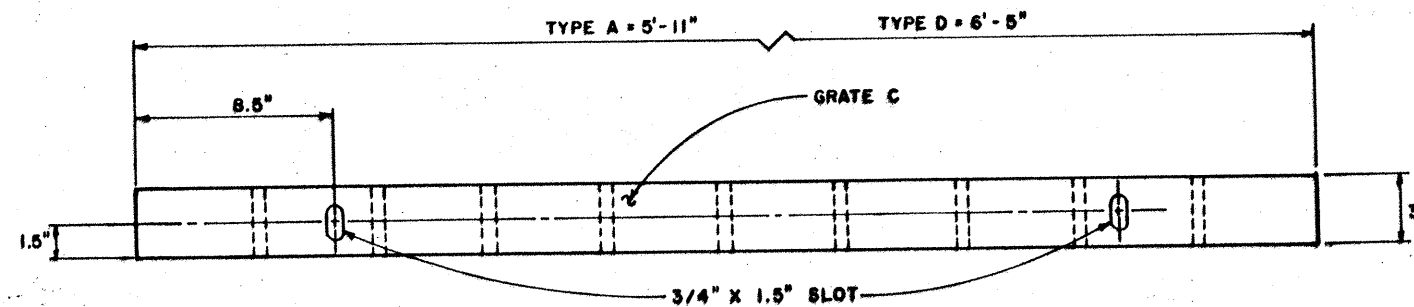

— ALL PLATES ARE SYMMETRIC TO THEIR RESPECTIVE CENTERLINES —

* SEE ALSO NOTES ON INLET ADJUSTMENT SHEET

GRATE DETAILS



David A. Jerny, P.E.
4-16-91

19










11L 547 19 2-B-91

FED. PROJ. NO.	STATE	FEDERAL PROJECT NO.	SHEET NO.
	TEXAS	HES000S (606)	19
STATE DIST. NO.	COUNTY	CONTRACT NO.	SECTION NO.
16	NUECES	0074 06	164 US181

SCALE: 1" = 1/3'


SLOPE	Y	Z	DIA. OF PIPE	TABLE OF DIMENSIONS	BILL OF REINFORCING STEEL FOR SLOPING INLET																																TOTAL QUANT.	
					BARS A					BARS B					BARS C					BARS D					BARS E					BARS G					BARS H AV.					BARS L					BARS L ₁ AV.					STEEL	CONC.	
					X	H	L	NO.	SIZE	SPA.	LGTH.	WT.	NO.	SIZE	SPA.	LGTH.	WT.	NO.	SIZE	SPA.	LGTH.	WT.	NO.	SIZE	SPA.	LGTH.	WT.	NO.	SIZE	SPA.	LGTH.	WT.	NO.	SIZE	SPA.	LGTH.	WT.	NO.	SIZE	SPA.	LGTH.	WT.	NO.	SIZE	SPA.	LGTH.	WT.	LBS.	C.Y.	
6.1	4 1/2"	2	18"	2'-6"	2'-1 1/2"	12'-9"	2	#4	~	2'-3"	3	2	#4	~	2'-5"	3	1	#4	~	2'-3"	2	3	#4	12"	13'-3"	27	6	#4	12"	2'-6"	10	2	#4	~	13'-5"	18	12	#4	12"	4'-5"	35	2	#4	12"	2'-0"	3	2	#4	12"	6'-10"	9	110	1.1	
6.1	5"	2	24"	3'-0"	2'-8"	16'-0"	2	#4	~	2'-10"	4	2	#4	~	3'-0"	4	1	#4	~	2'-9"	2	4	#4	12"	16'-6"	44	8	#4	12"	2'-6"	13	2	#4	~	16'-9"	22	15	#4	12"	5'-6"	55	2	#4	12"	2'-0"	3	2	#4	12"	9'-10"	13	160	1.7	
6.1	5 1/2"	3	30"	3'-6"	3'-2 1/2"	19'-3"	2	#4	~	3'-5"	5	2	#4	~	3'-9"	5	1	#4	~	3'-3"	2	4	#4	12"	19'-9"	53	8	#4	12"	2'-6"	13	2	#4	~	20'-0"	27	19	#4	12"	6'-6"	83	2	#4	12"	2'-0"	3	4	#4	12"	10'-1"	27	218	2.4	
6.1	6"	3	36"	4'-0"	3'-9"	22'-6"	2	#4	~	4'-0"	5	2	#4	~	4'-2"	5	1	#4	~	3'-9"	3	5	#4	12"	23'-0"	77	10	#4	12"	2'-6"	17	2	#4	~	23'-3"	31	22	#4	12"	7'-7"	111	2	#4	12"	2'-0"	3	6	#4	12"	13'-9"	55	307	3.3	
6.1	6 1/2"	3	42"	4'-6"	4'-3 1/2"	25'-9"	2	#4	~	4'-7"	6	2	#4	~	4'-9"	6	1	#4	~	4'-3"	3	5	#4	12"	26'-3"	88	10	#4	12"	2'-6"	17	2	#4	~	26'-8"	36	25	#4	12"	8'-7"	143	2	#4	12"	2'-0"	3	6	#4	12"	13'-10"	55	357	4.4	
6.1	4 1/2"	4	48"	5'-0"	4'-10"	29'-0"	2	#4	~	5'-2"	7	2	#4	~	5'-4"	7	1	#4	~	4'-9"	3	6	#4	12"	29'-6"	118	12	#4	12"	2'-6"	20	2	#4	~	29'-10"	40	29	#4	12"	9'-7"	186	2	#4	12"	2'-0"	3	8	#4	12"	14'-5"	77	461	5.7	

Note: For pipe sizes of 21", 27", and 33" use inlets for pipe sizes 24", 30", and 36" respectively.
 N = Number of grate units. (See Grate Standard.)

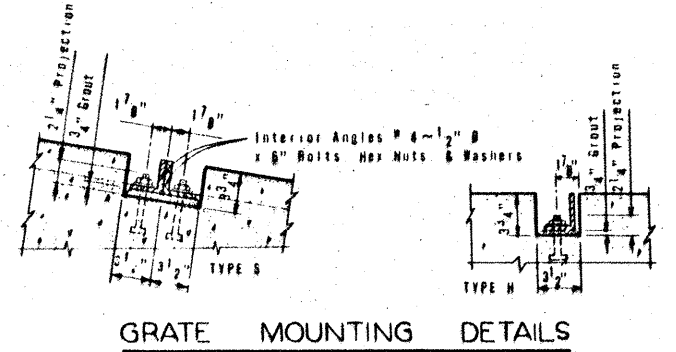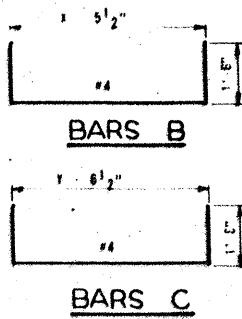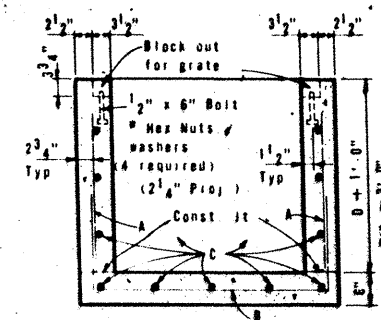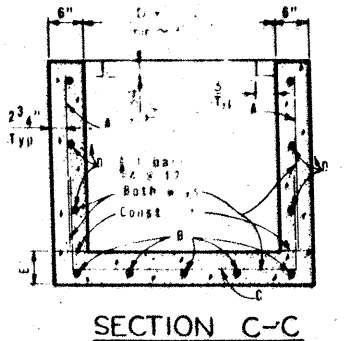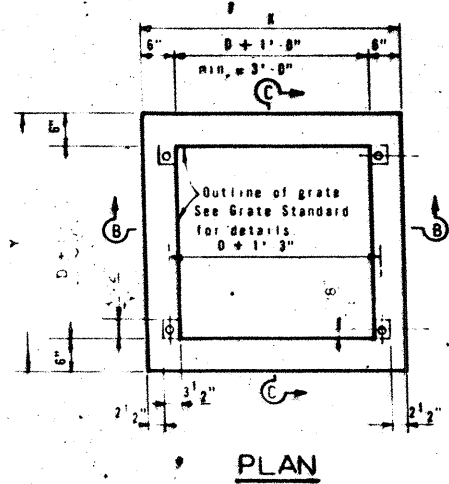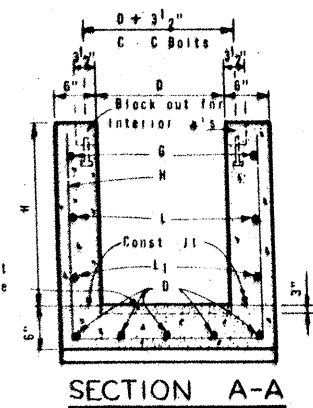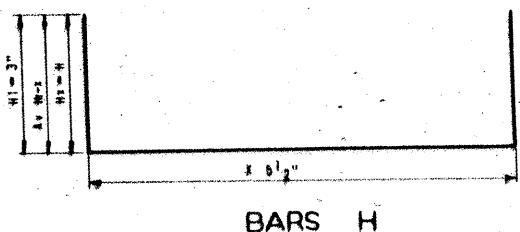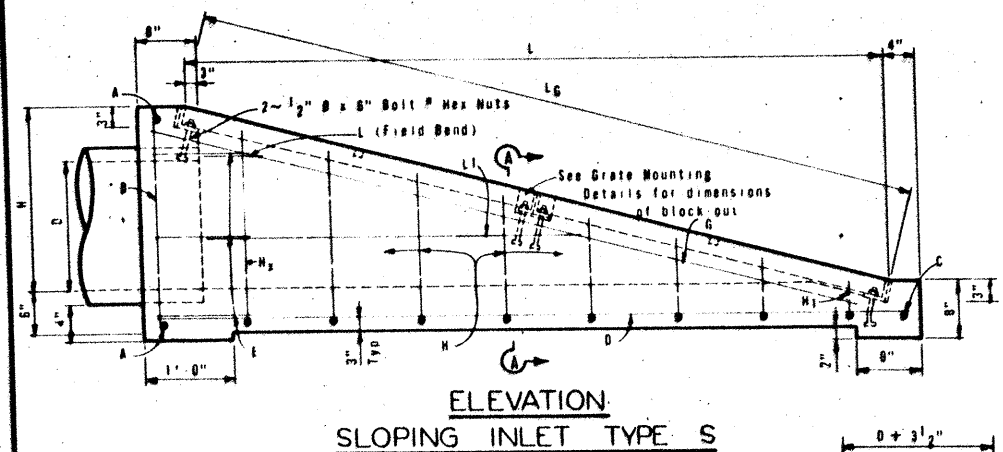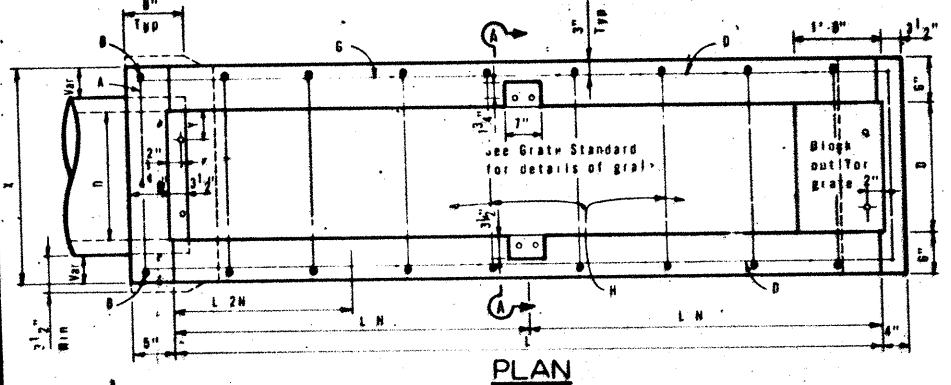

GENERAL NOTES

Quantities shown herein are for the Contractor's information only. Unless otherwise shown in the plans, payment will be made for each inlet of the type specified. Exposed edges shall be chamfered 3/4". Alternate design drawings bearing the seal of a registered professional engineer will be acceptable for precast construction of inlets. Shop drawings may not be required. The contractor may with the approval of the Engineer furnish inlets of equivalent structural design. In areas of conflict between reinforcing steel, blockouts, pipes, anchor bolts or other reinforcing steel, the reinforcement shall be bent or adjusted to clear as directed by the Engineer. Approximately 2 cy of 3/4" x 3/4" x 3/4" riprap will be used for shaping around perimeter of each inlet except inlets in paved medians.

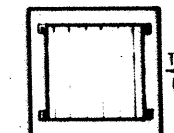

Connecting pipes should enter within 10" of normal to inlet wall. If necessary, pipe elbow or curved approach should be used to stay within this limit.



The pipe diameter "D" to be used in determining horizontal dimensions of Type "H" inlet shall be the largest pipe entering or exiting the inlet which would control that particular wall dimension. For vertical dimension, use largest "D" or 1'-0" above highest pipe soffit as a minimum dimension.

FIELD CHANGE No. 4

STATE DEPARTMENT OF HIGHWAYS AND PUBLIC TRANSPORTATION

SLOPING INLET TYPE S AND HORIZONTAL INLET TYPE H

IL-S IL-H (MOD) 19A

ORIGINAL DRAWING DATE DEC 1977	STATE FEDERAL PROJECT	SHEET
DN: ADC	16	6
CH: THD	REV B B6 GEN NOTES	HES 0005(104) 19A
DW: MGB	Rev. 4/79 Grate Placement	COUNT
CH: THD	Traffic Flow and General Notes	NUCES

- REMOVE AND REPLACE WITH NEW TYPE I UNDERPASS LUMINAIRE,
- REMOVE AND RELOCATE TO NEW BRACKET ON BELDEN BRIDGE,
- REMOVE AND RELOCATE LUMINAIRE.

[illegible][illegible]

NOTES:

- 1) LUMINAIRES LISTED UNDER THE "EXISTING ASSEMBLY SUMMARY" MAY BE AFFECTED BY PROJECT CONSTRUCTION.
- 2) ALL EXISTING ASSEMBLIES ARE T-BASE LUMINAIRES WITH DIMENSIONS AS SHOWN ON "LIGHTING ASSEMBLY SCHEDULE". SEE EXISTING LIGHTING DETAILS FOR LUMINAIRE ASSEMBLY DESCRIPTION.
- 3) ALL LUMINAIRES, CONDUIT AND CONDUCTOR LOCATIONS SHALL BE VERIFIED IN THE FIELD BY THE CONTRACTOR.
- 4) EXISTING LUMINAIRES THAT ARE TO BE REMOVED AND RELOCATED SHALL BE STORED IN AN APPROVED LOCATION UNTIL COMPLETION OF CONSTRUCTION.
- 5) REMOVAL OF EXISTING UNDERPASS LUMINAIRES B-59, B-60 WILL NOT BE PAID FOR DIRECTLY BUT SHALL BE SUBSIDIARY TO THE VARIOUS BID ITEMS.

STATE DEPARTMENT OF HIGHWAYS
AND PUBLIC TRANSPORTATION

ILLUMINATION
ASSEMBLY
SUMMARY

21


CIRCUIT SUMMARY						
SEE BRIDGE CONDUIT LAYOUT, BL (MOD) LIGHTING LAYOUTS, AND RID(7)-88.						
CKT NUMBER	GRND. LENGTH #6 BARE (FT.)	CONDUCTOR		CONDUIT		
		# & LENGTH (FT.) (XHHW)		1 1/4" RMC (FT.)	1 1/4" RMC (FT.)	1 1/2" PVC (FT.)
		#4	#6		(BORED)	(SCH 40)
1	50'	2-50'				50'
2	150'	2-150'				150'
3	180'	2-180'				180'
4	90'	2-90'				90'
5	90'	2-90'				90'
6	180'		2-180'		EXIST.	
7	70'	2-70'			EXIST.	
8	90'	2-90'				90'
9	90'	2-90'				90'
10	90'	2-90'				90'
11	90'	2-90'				90'
12	25'	2-25'				25'
13	90'	2-90'				90'
14	90'	2-90'				90'
15	90'	2-90'				90'
16	25'	2-25'				25'
17		2-50' EXIST.		EXIST.		
18		2-50' EXIST.		EXIST.		
19		2-50' EXIST.		EXIST.		
20		2-30' EXIST.		EXIST.		
21		2-25' EXIST.		EXIST.		
22		2-25' EXIST.		EXIST.		
23	200'		2-200'			90'
24	90'		2-90'			90'
25	90'		2-90'			90'
26	50'		2-50'			50'
27	125'		2-125'			
28	180'	2-180'				180'
29	100'		2-100'		EXIST.	
30	90'	2-90'				90'
31	90'	2-90'				90'
32	90'	2-90'				90'
33	90'	2-90'				90'
34	90'	2-90'				90'
35	90'	2-90'				180'
36	180'	2-180'				100'
37	100'	2-100'				
38	SUBSIDIARY TO U/P (CONDUIT & CONDUCTOR)					
39	50'	2-50'				50'
40	SUBSIDIARY TO U/P (CONDUIT & CONDUCTOR)					
41	100'	2-100'				100'
42	180'	2-180'				180'
43	100'	2-100'				100'
44	ABANDON THIS RUN					
45	150'	2-150'				150'
46	180'	2-180'				180'
47	50'	2-50'				50'
48	50'	4-50'				50'
49	100'	4-100'				100'
TOTALS	4105	6,840	1,670			3,430

Service Pole #1

[C4-C18] = 15-250W HPS
 [C1-C3] = 4-250W HPS
 [A1-A5] = 5-250W HPS
 [A52-A53] = 2-250W HPS
 [A34-A48] = 15-250W HPS
 [A49-A50] = 2-150W HPS

Service Pole #2

[D1-D18] = 19-250W HPS
 [B1-B4] = 4-250W HPS
 [B59-B60] = 2-150W HPS

Circuit #1: [B25-B37] = 13-250W HPS
 [B38-B39] = 2-250W HPS
 [B41-B44] = 4-250W HPS
 [B45-B51] = 7-250W HPS


Circuit #2: [A6-A18] = 13-250W HPS
 [A22-A33] = 12-250W HPS
 [B5-B21] = 16-250W HPS
 [B22-B24] = 3-250W HPS
 [B54-B58] = 5-250W HPS


Refer to Sheet 23 (Illumination Layout Sheet) for Circuit Runs.

CIRCUIT SUMMARY

STATE	FEDERAL AID PROJECT NO.	SHEET
6 TEXAS	HE5000S (E06)	US111
COUNTY	CONTRACT NO.	DATE
16 NUECES	074 06 164	22

FERRY, DUNN

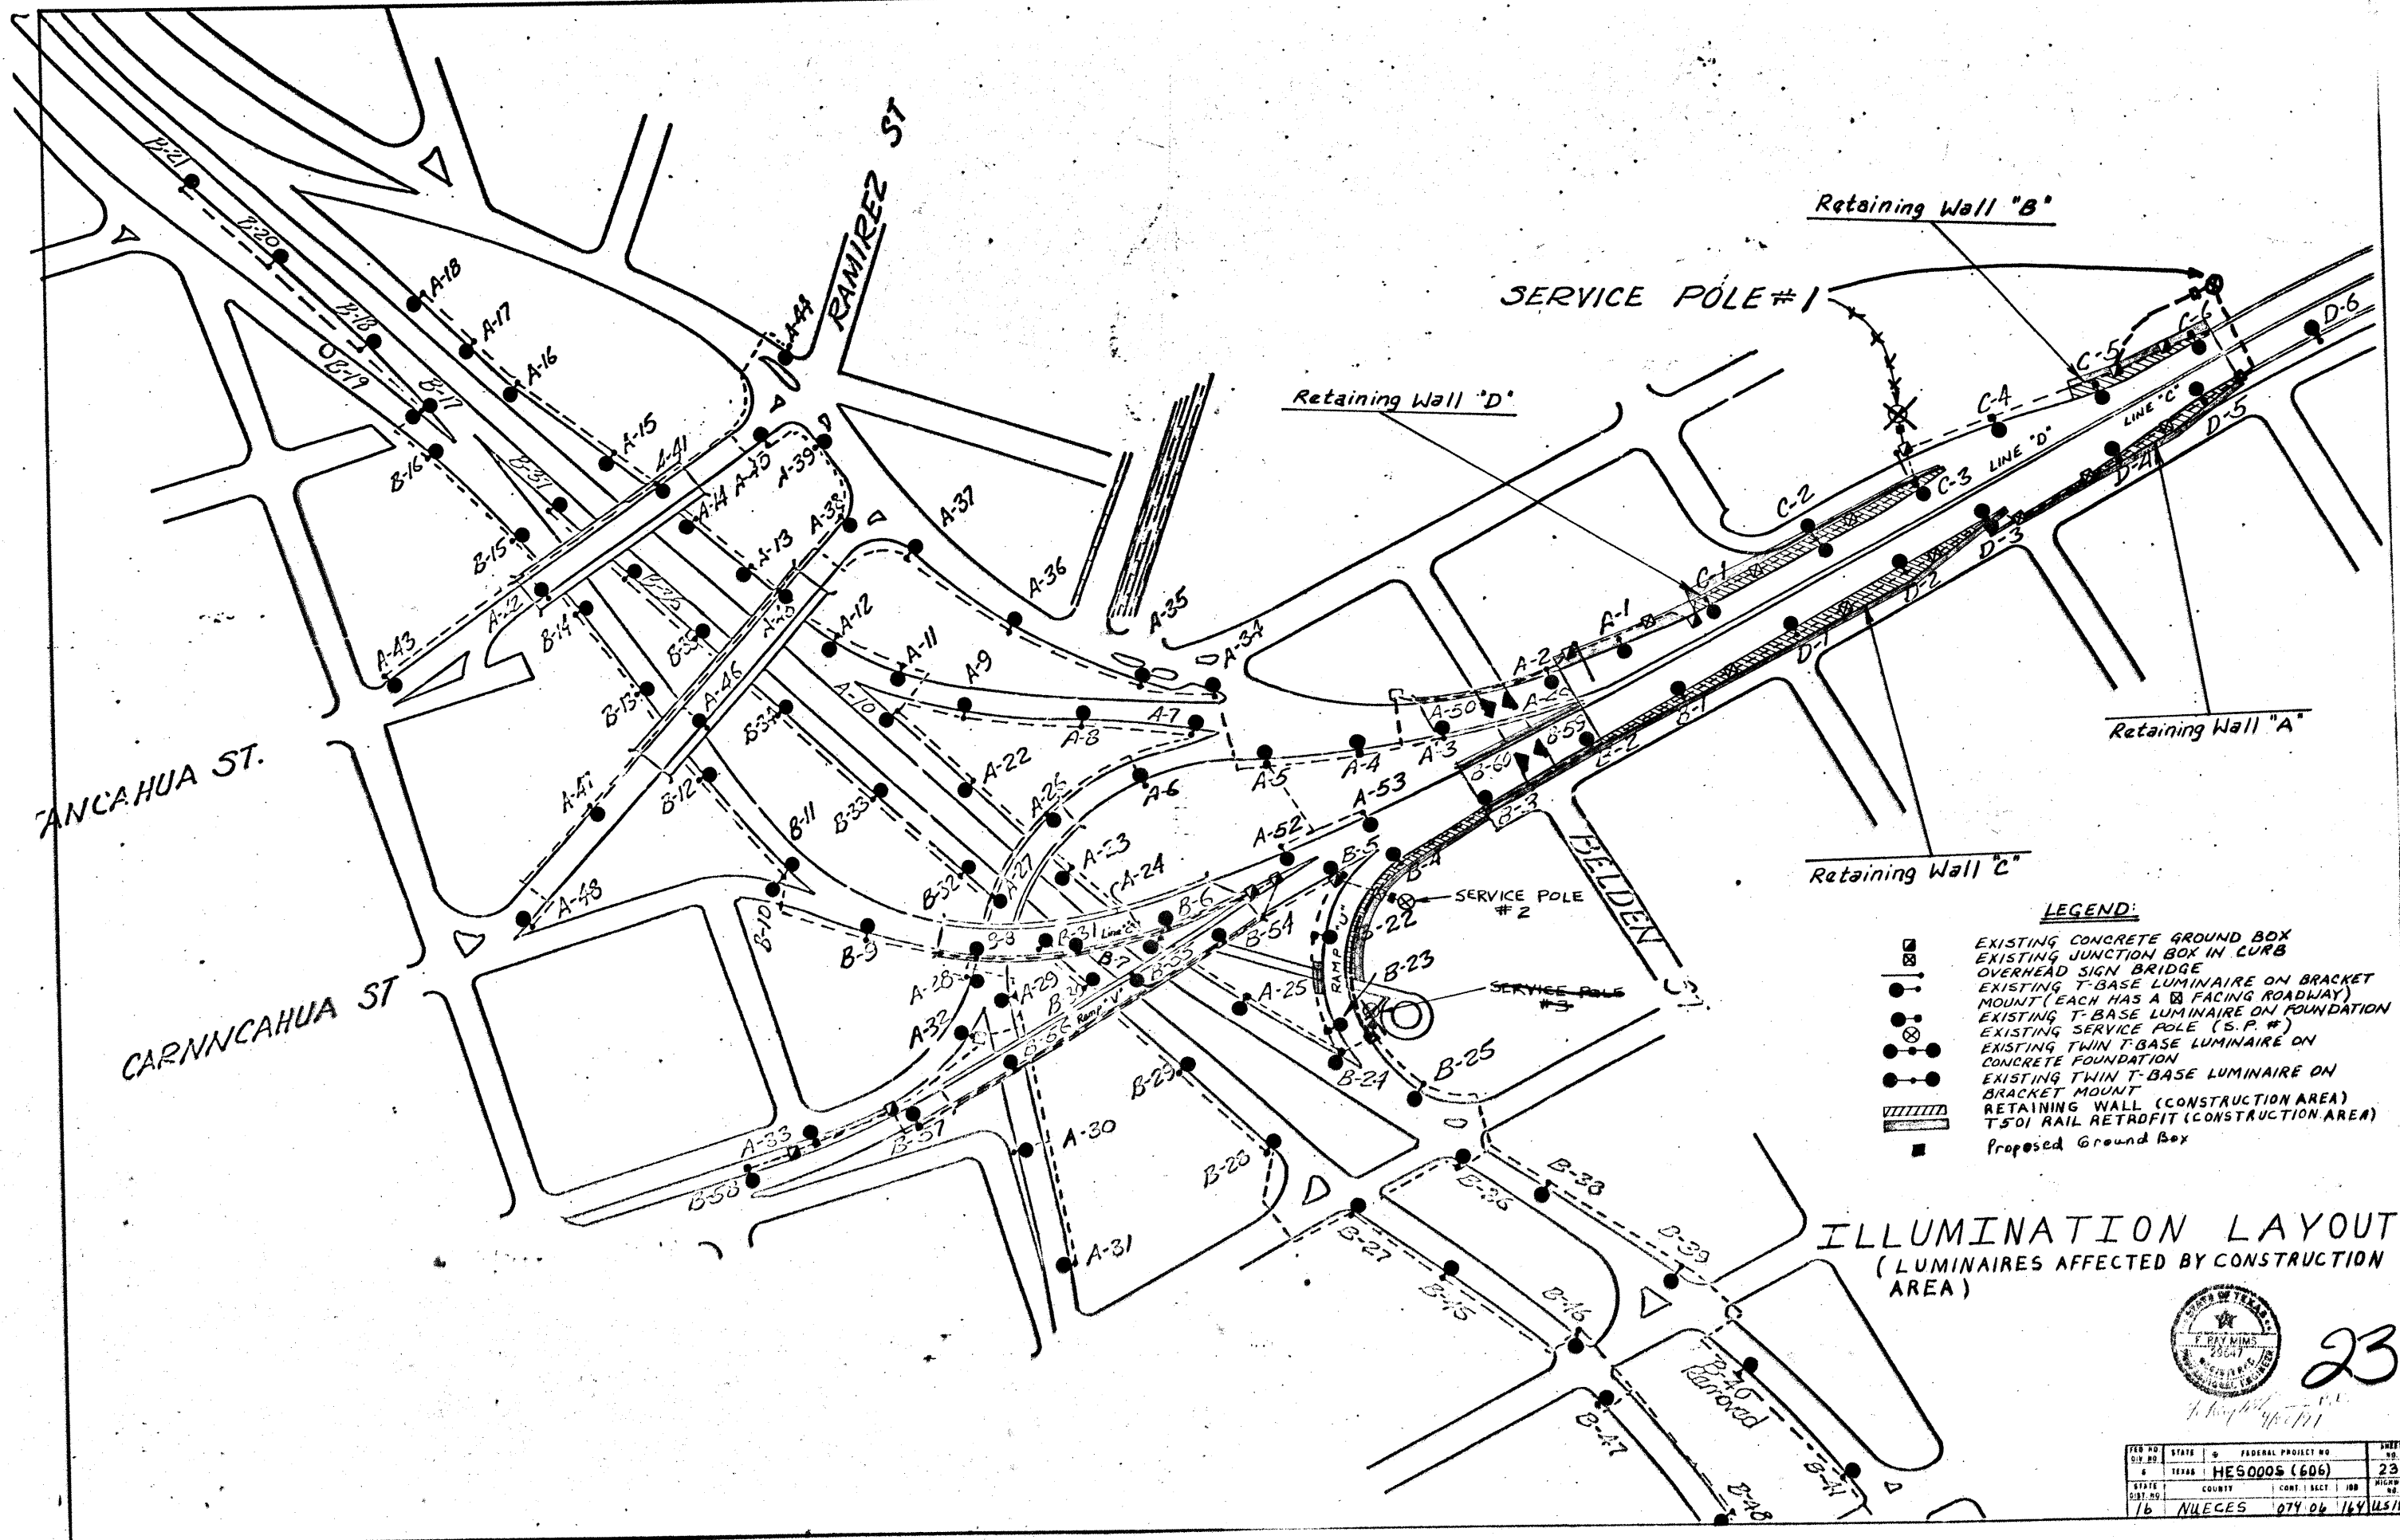

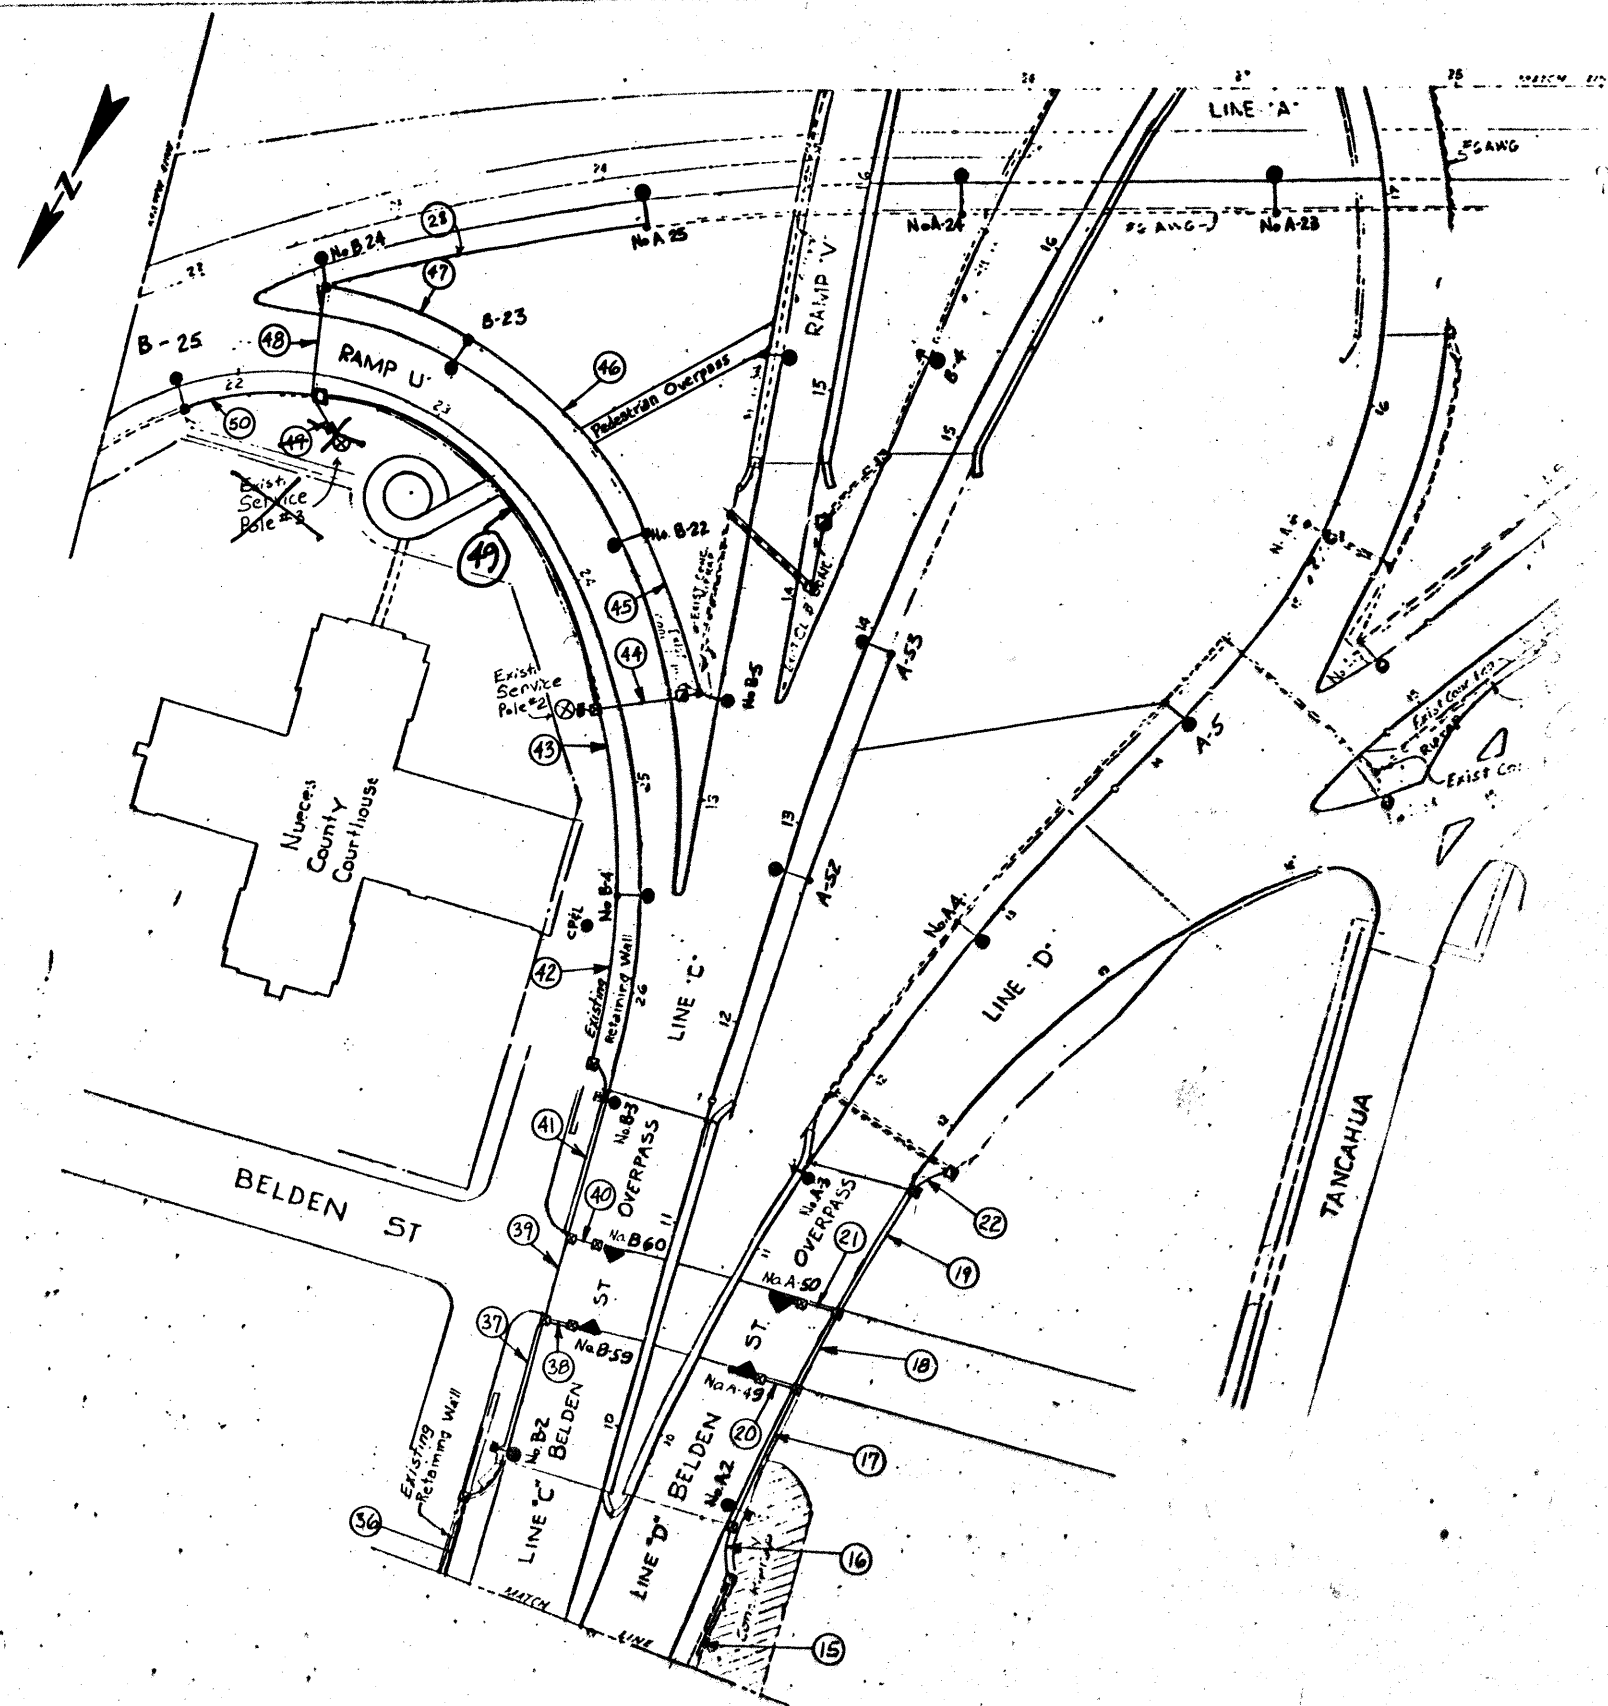

Notes:

- 1) Contractor shall verify the location of conduit, junction boxes, ground boxes, luminaires, service poles and electrical power lines before beginning work.
- 2) Duct cable to be abandoned shall be cut off 6" below ground. Duct cable abandonment and removal will not be paid for directly but shall be subsidiary to the various bid items.
- 3) Before beginning any work on existing circuits, the contractor shall ascertain a mutual understanding and agreement from the SDHPT before any circuit may remain de-energized during normal hours of operation. The contractor shall satisfy himself that the circuits are locked open when work is being done.
- 4) Removal or abandonment of existing RM conduit in wall will not be paid for directly but shall be subsidiary to the various bid items.
- 5) If GREAT system cannot be accommodated to clear luminaire C-3, then at the Engineer's discretion, the existing foundation will be removed and replaced with a new TYA foundation modified to fit existing luminaire.
- 6) All electrical fittings, connectors and grounding bushings necessary for the completion of this project will not be paid for directly but shall be subsidiary to the various bid items.




LIGHTING LAYOUT

24

HES0005(606)

24

NUECES 74 06 164 USIRI

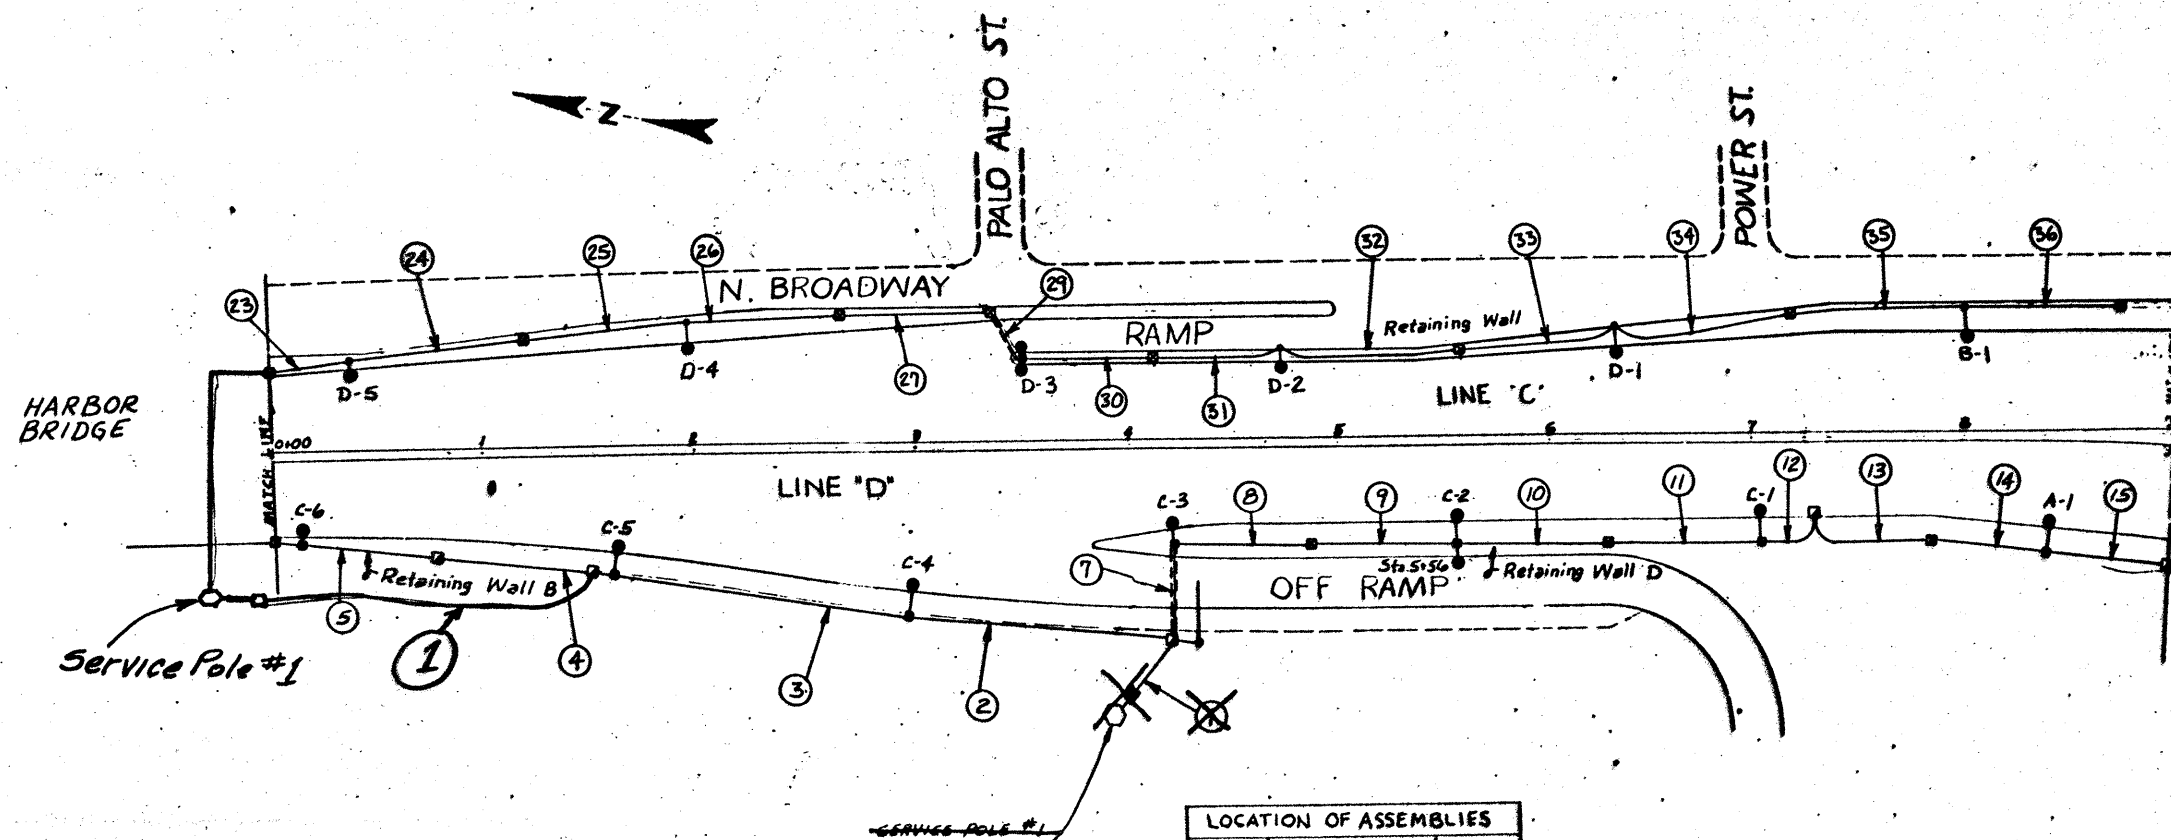

LEGEND


- SERVICE POLE (EXISTING)
- EXIST. T-BASE LUMINAIRE MOUNTED ON CONCRETE FOUNDATION
- EXIST. T-BASE LUMINAIRE MOUNTED ON BRIDGE BRACKET
- EXIST. T-BASE LUMINAIRE MOUNTED ON BRIDGE BRACKET
- EXIST. T-BASE LUMINAIRE MOUNTED ON CONCRETE FOUNDATION
- OVERHEAD SIGN BRIDGE
- CONDUIT & CONDUCTOR RUN (SEE CIRCUIT SUMMARY)
- CONDUIT & CONDUCTOR UNDER ROADWAY (SEE CIRCUIT SUMMARY)
- Proposed Ground Box

LOCATION OF ASSEMBLIES		
No.	Station	Type
C-6	0+15 Line D	A
C-5	1+65 " "	D
C-4	2+96 " "	D
C-3	4+27 " "	C
C-2	5+56 " "	I
C-1	7+00 " "	D
A-1	8+40 " "	D
D-5	0+40 Line C	A
D-4	1+97 " "	D
D-3	3+50 " "	H
D-2	4+75 " "	A
D-1	6+34 " "	B
B-1	8+03 " "	D



25
LIGHTING LAYOUTS

NO.	DATE	REVISION	BY	CHKD.
1				
2				
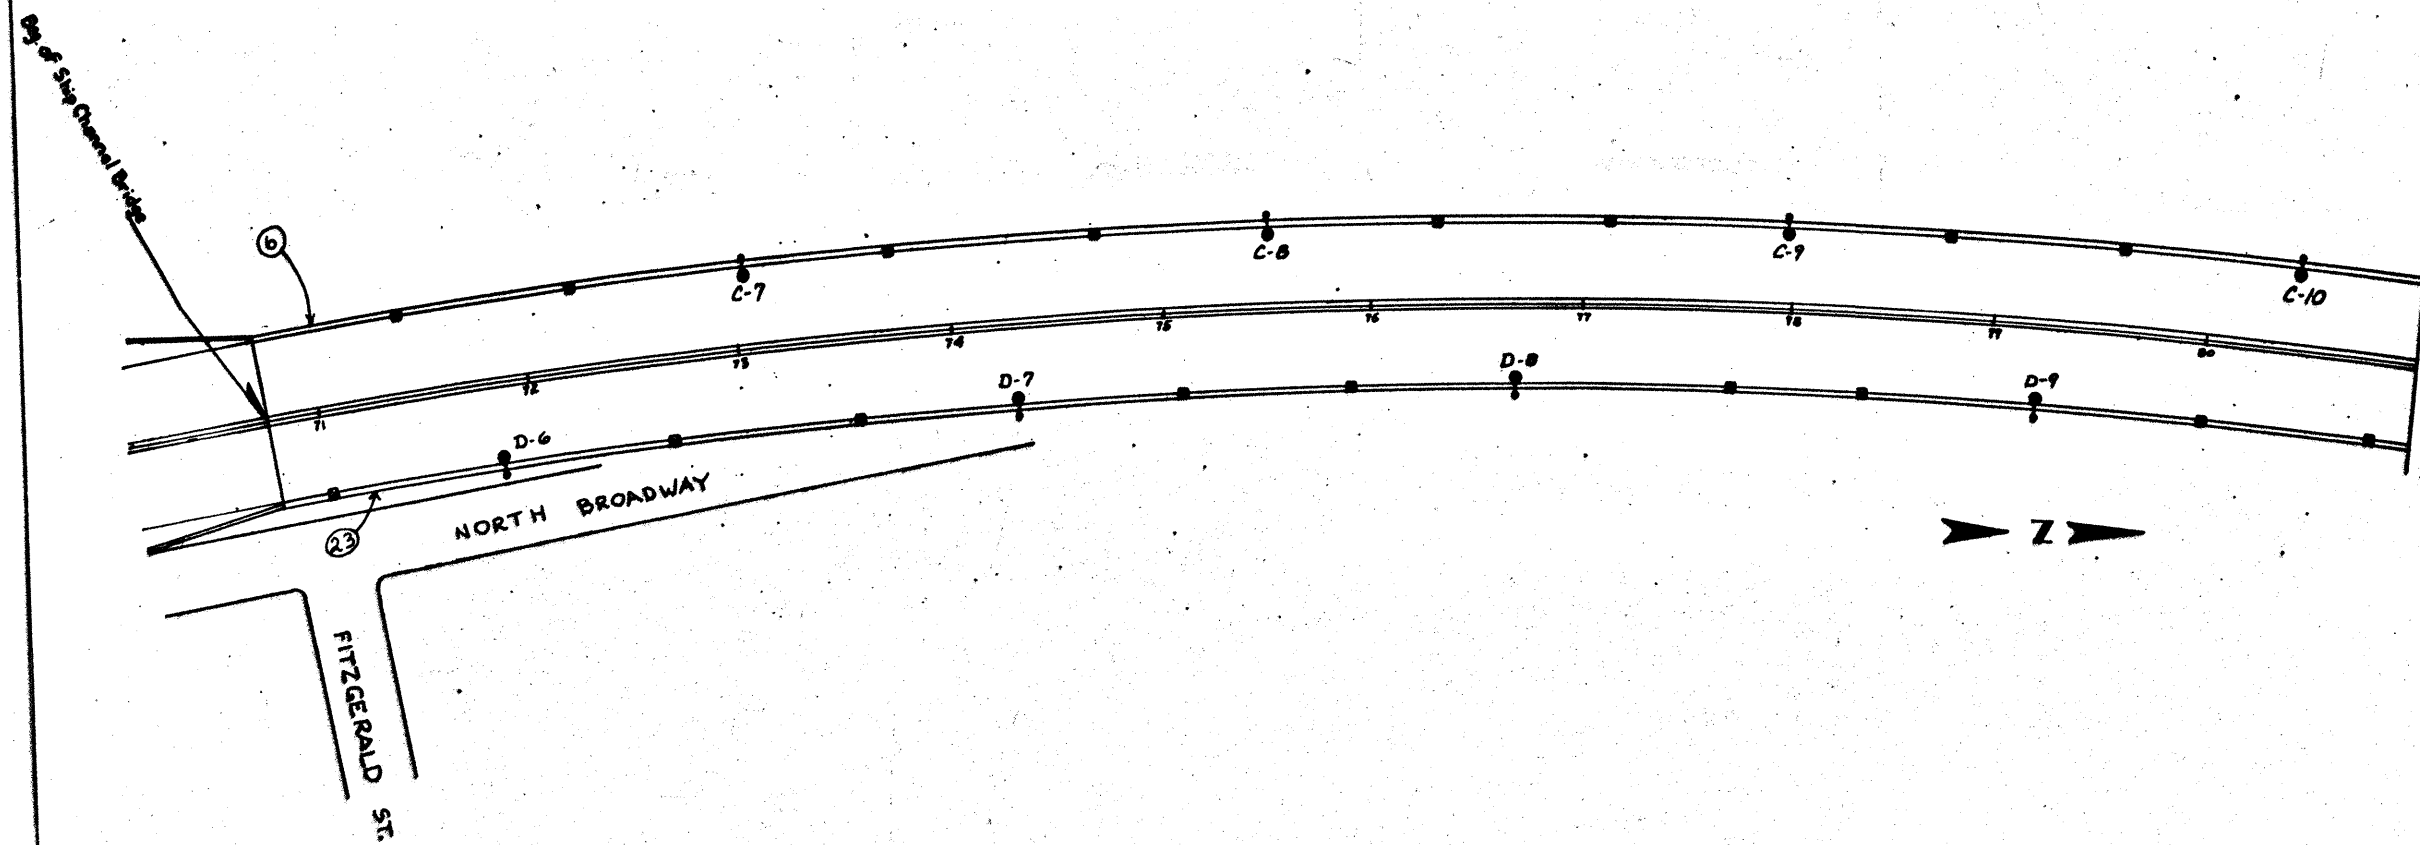


F. Ray Mims
7/22/91 P.E.

LIGHTING LAYOUTS

26


Scale 1"=40'			
NO.	DATE	REVISION	BY
1		HES 0005 (606)	26
12	10/22/91	74	6/64 US181



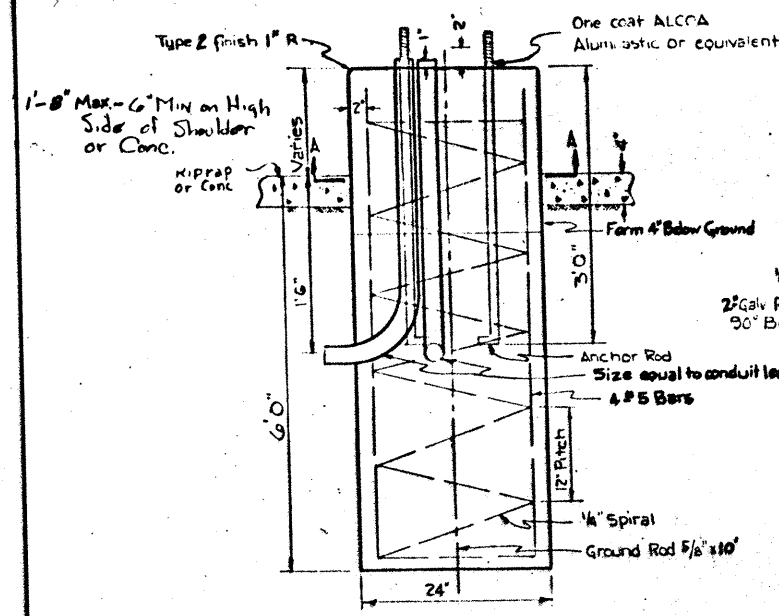


Detail of Exist. Conc. Foundation


EXIST. CONC. FOUNDATION FOR LIGHT STANDARD

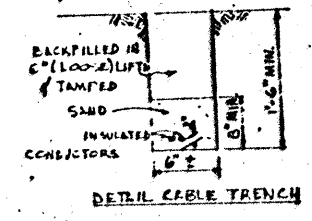


DETAIL CABLE TRENCH

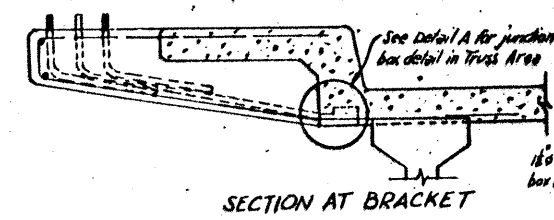


SECTION AT BRACKET

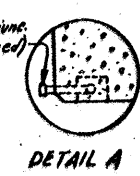


DETAIL A

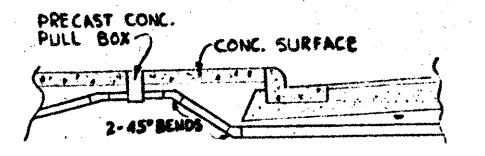


DETAIL OF EXISTING CONDUIT CONNECTION TO PULL BOX

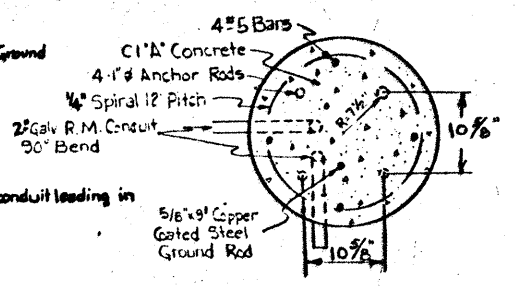

SECTION 'A-A'

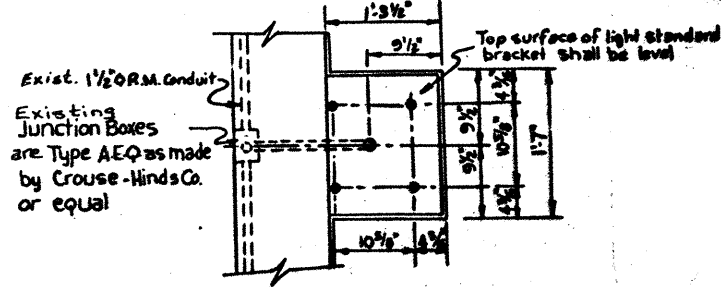


PLAN OF BRACKET ON EXISTING RETAINING WALL & BRIDGE STRUCTURE

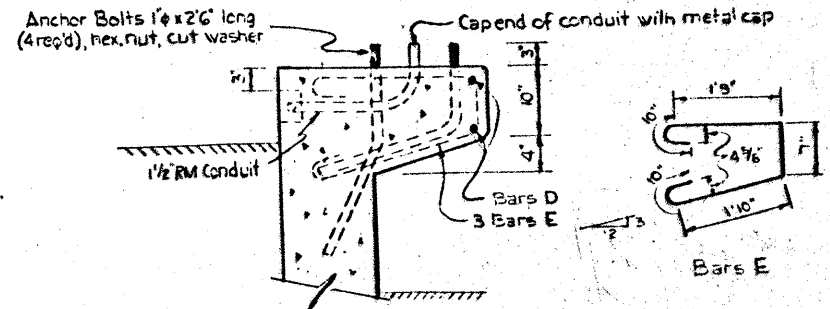

SECTION


Note: Anchor bolts, nuts & washers shall, after fabrication, be cadmium coated by the Udyrite Process in accordance with ASTM Spec. A-165 or galvanized in accordance with ASTM Spec A-153.

EXISTING RETAINING WALL BRACKET

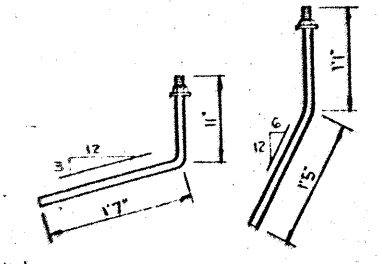

Note: Anchor bolts shall be measured and paid for as structural steel.

EXISTING RETAINING WALL ANCHOR BOLT DETAILS

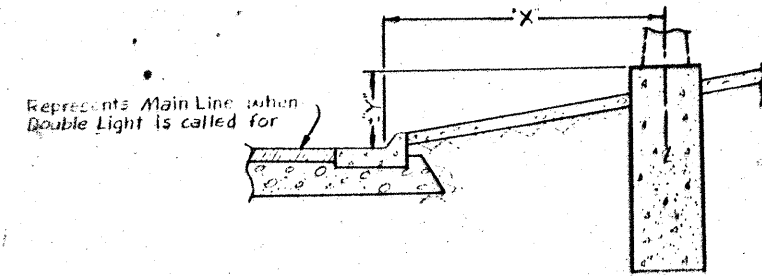

VARIABLE DIMENSIONS OF CONCRETE FOUNDATION FOR LIGHT STANDARD

GENERAL NOTES:

- 1) Existing Retaining Wall Brackets have been Poured Monolithically with Existing Retaining Walls.
- 2) Spacing of Existing Light Standard Brackets is Based on Design using 20,000 Lumen Luminaire.




EXISTING LIGHTING DETAILS

27


STATE	COUNTY	CITY	PROJECT	SHEET
TEXAS	HES	0003	1606	27
16	NUECES	007	06	164

GENERAL NOTES

GENERAL NOTES:
 1) Existing Wallpacks B-59 and B-60 shall be removed and replaced with new Type-I underpass luminaires. see RID(7)-88.

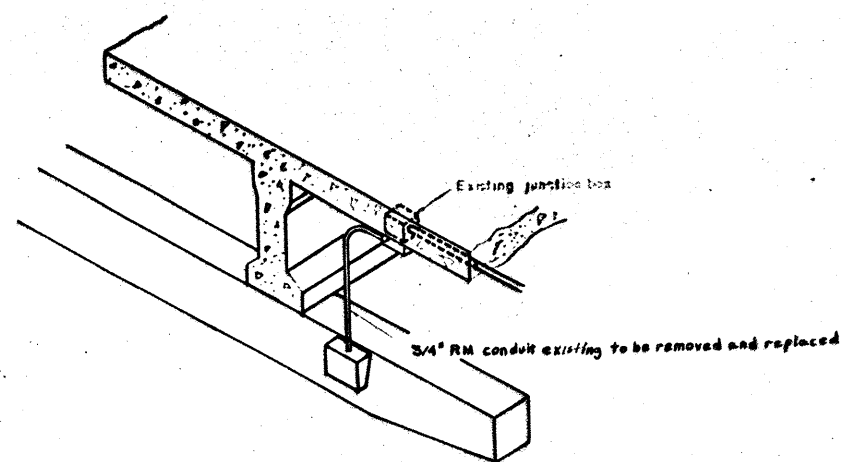

EXISTING WALL PACK ASSEMBLY (B-59, B-60)

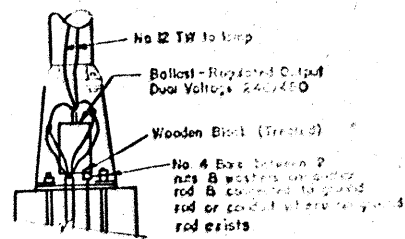

DETAIL OF TRANSFORMER BASE CONNECTIONS (EXISTING)

TYPE	NO REQ	1" DIM	2" DIM	3" DIM
A	4	25'	4'	
B	10	25'	6'	
C	41	25'	10'	
D	72	25'	12'	
E	32	25'	15'	
F	18	30'	4'	
G	54	30'	6'	
H	1	25'	4'	4'
I	1	25'	12'	6'
J	1	25'	6'	4'
K	1	25'	12'	12'
L	6	6" DIA. WALL MTS BRACKET		
M	2	17'	6'	

1/7

1/8

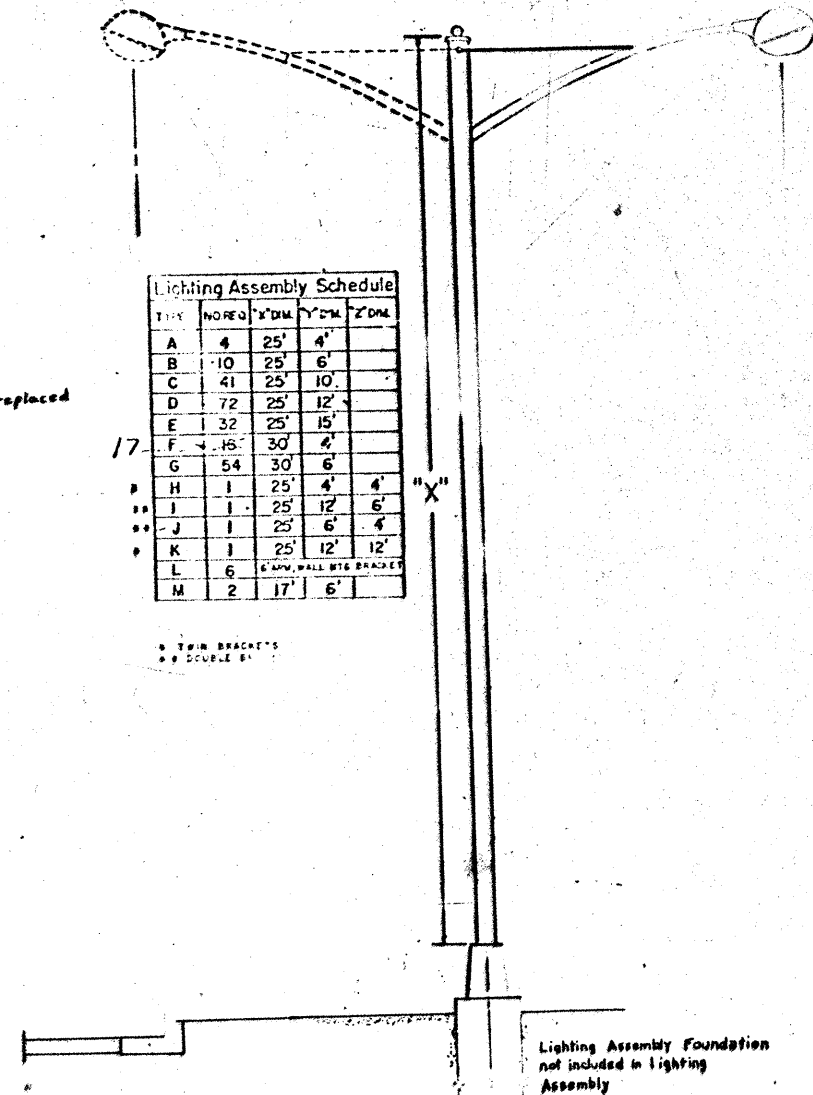

EXISTING LIGHTING ASSEMBLIES TYPE A,B,C,D,E,F,G,H,I,J & K




7/16/71 M.F. P.E.
 4/22/91



EXISTING LIGHTING DETAILS

28


STATE	FEDERAL PROJECT NO.	SHEET NO.
TEXAS	HE90005(606)	28
COUNTY	DATE	JOB NO.
NUECES	07/06/66	1/68/US/81

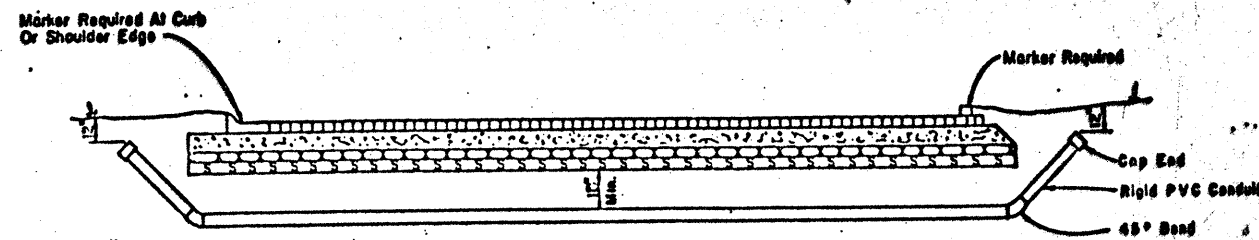

DETAIL OF CONDUIT UNDER ROADWAY

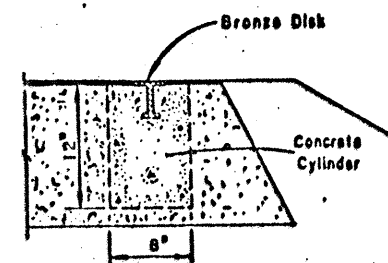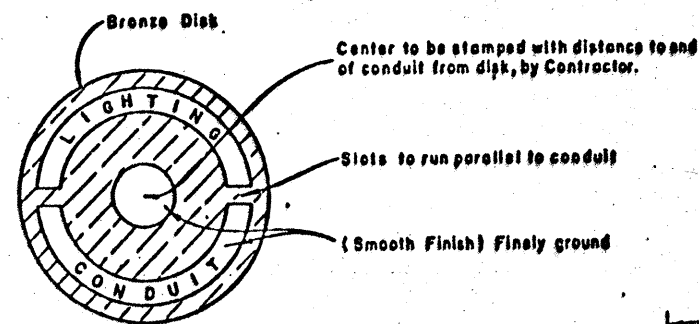

SECTION THRU SHOULDER

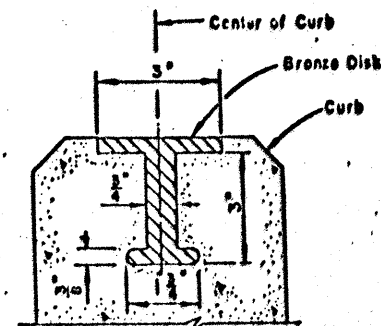

SECTION THRU TOP OF CURB

METHOD OF MARKING CONDUIT

NOTE: Conduit shall be marked as follows "Lighting Conduit," "Signal Conduit" or "Sprinkler Conduit." Markers will be placed in curb or in shoulder over the conduit on each side of street.




F. Ray Mims
1/22/91

MISC. DETAILS


CONDUIT UNDER ROADWAY & CONDUIT MARKERS

29


PUR. NO.	STATE	FEDERAL PROJECT NO.	NO.
0	TEXAS	HE50005 (606)	29
STATE	COUNTY	CONTRACT NO.	SECTION NO.
TX	NUECES	074 06	164 02/1

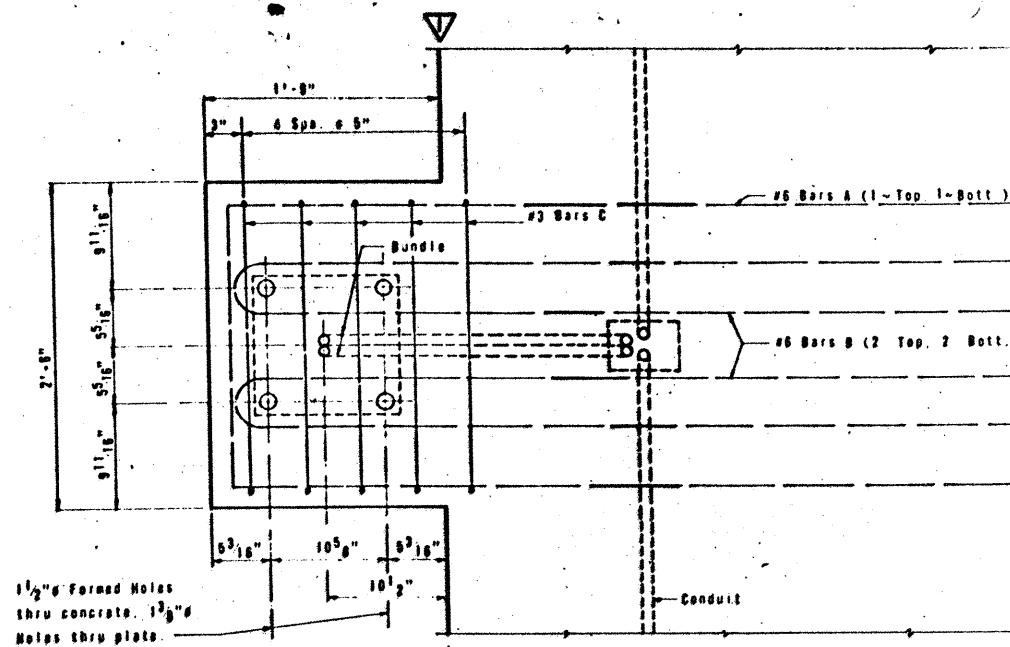


PLAN

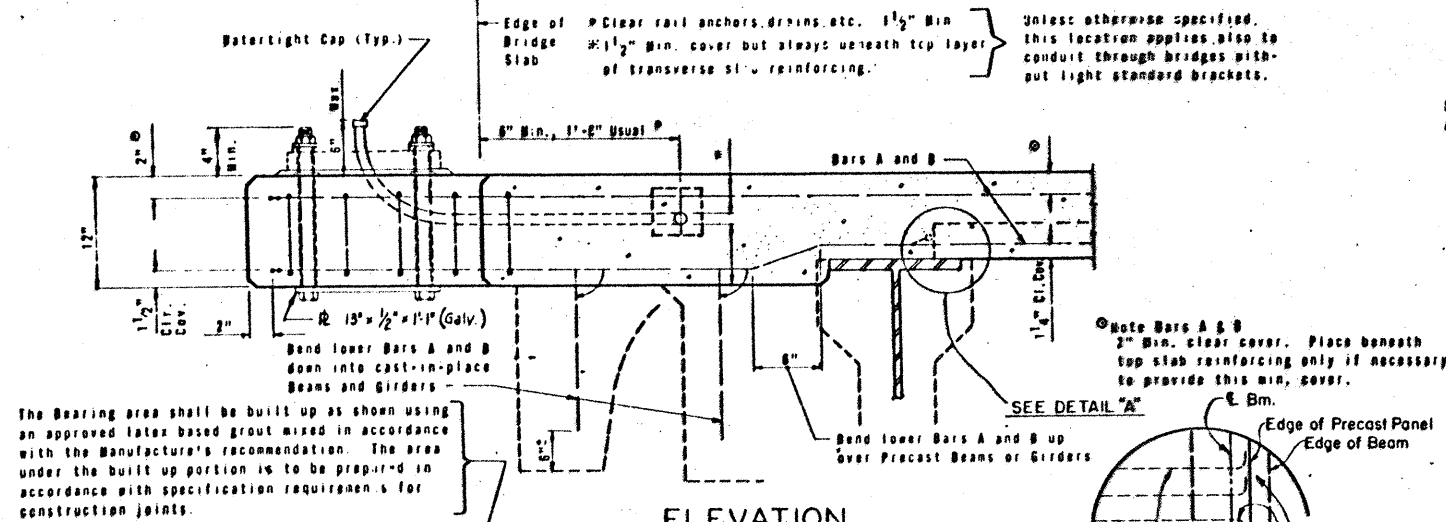


ELEVATION

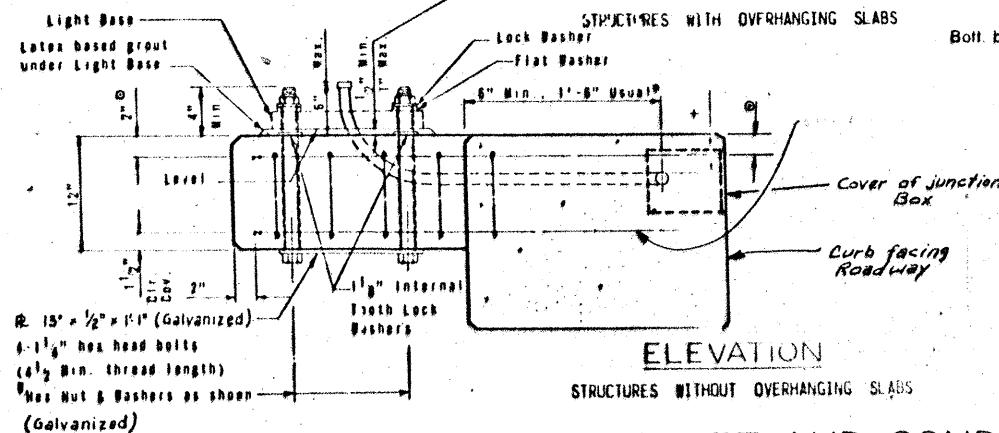

LIGHT STANDARD BRACKET AND CONDUIT LOCATION

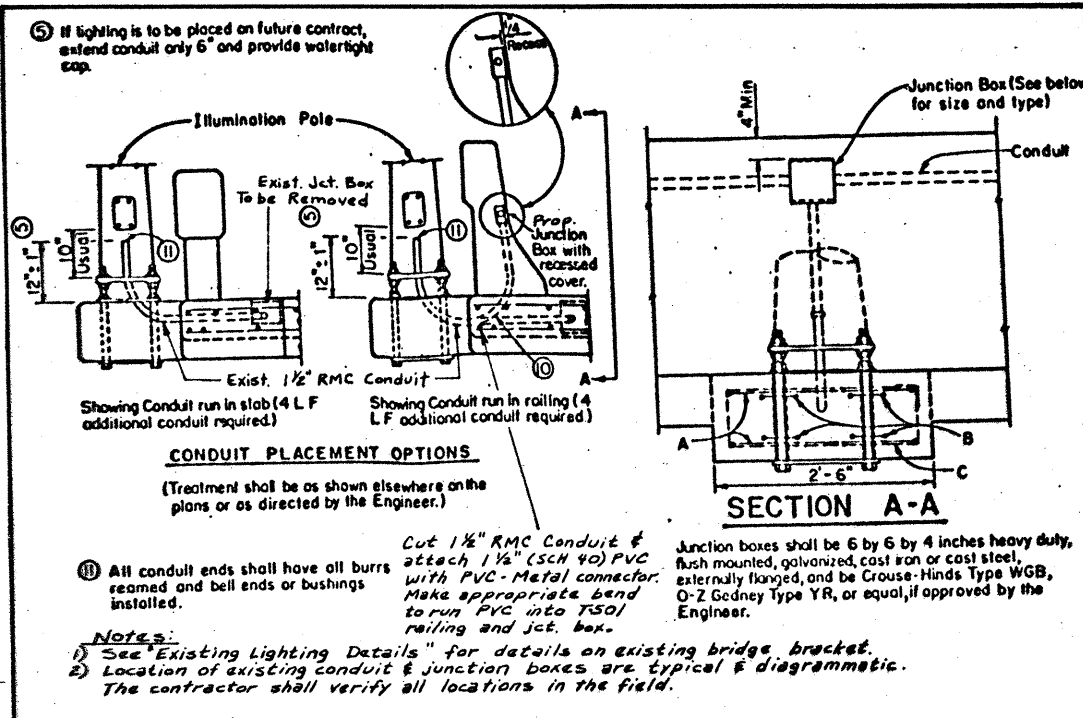


CONDUIT EXPANSION JOINT

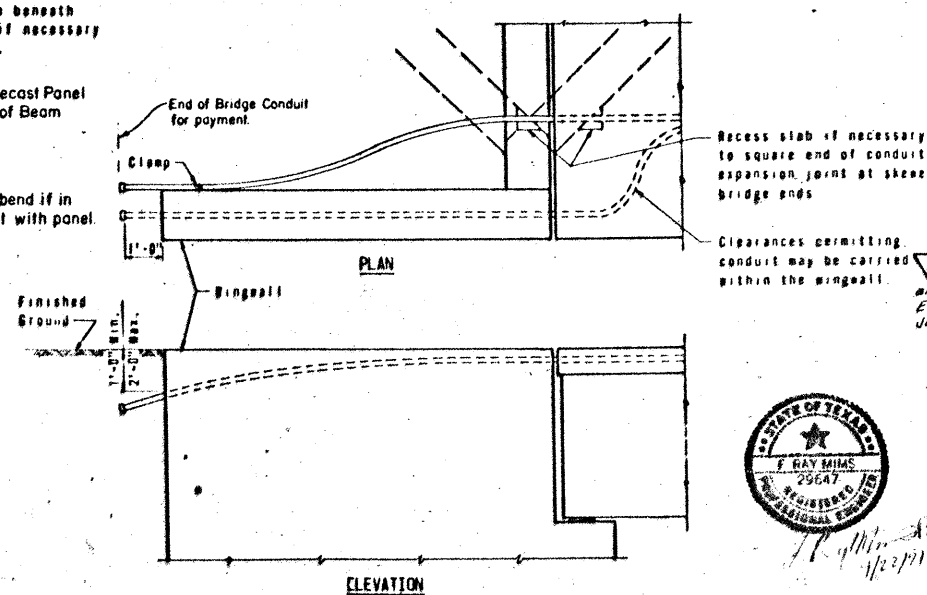

TREATMENT AT BRIDGE ENDS

ESTIMATED QUANTITIES - ONE BRACKET			
ITEM	UNIT	OUTSIDE	MEDIAN
1 CONCRETE	C. Y.	0.2	0.1
2 REINFORCING STEEL	LB.	146	134
3 STRUCTURAL STEEL	LB.	45	45
4 CONDUIT	L. F.	4	4

- ① Variation due to Slab thickness is insignificant.
- ② Anchor Bolts and Plate
- ③ Additional to main run

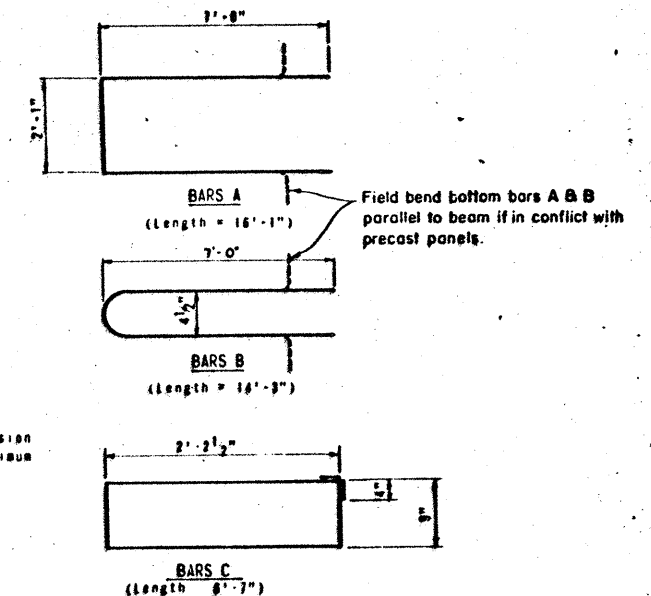

GENERAL NOTES:

Designed for 100 MPH wind, 50' standard, 15' brd, 2500 luminaire and 455 overstress.

Concrete for brackets shall be of the same type as placed monolithically with and paid for at the unit price bid for the bridge slab.

The type and size of conduit and the number and location of brackets shall be as shown elsewhere in the plans. Brackets found to conflict with other components of the bridge may be relocated to clear.

Unless otherwise specified, light standards are to be furnished and paid for under future contract.

Modifications include addition of V to show existing conduit to bracket and transition to proposed T-50 railing with existing bracket. Existing junction box is shown unbracketed in Plan View & Elevation View. Junction boxes are to be 6" x 6" x 6" PVC NEMA 4X and drainable. 4-18-91







STATE DEPARTMENT OF HIGHWAYS AND PUBLIC TRANSPORTATION

BRIDGE LIGHTING DETAILS

PREPARED BY: FOR THE
USE OF THE CONTRACTOR

ORIGINAL DRAWING DATE	DEC 1980	STATE PROJECT	16	FEDERAL AID PROJECT	30
DN - LEC		REVISIONS			
CR - BRN		Rev 3-85 (Bars A & B for panels)			
OW - FLR					
CR - LEC					

BL 30

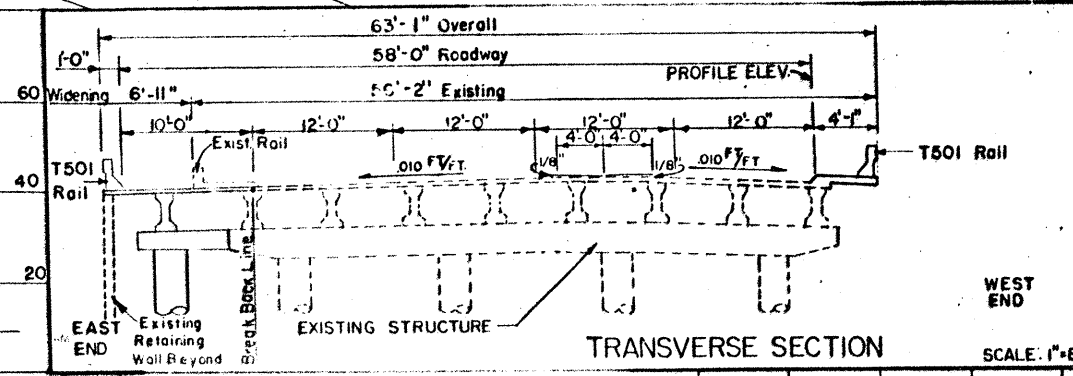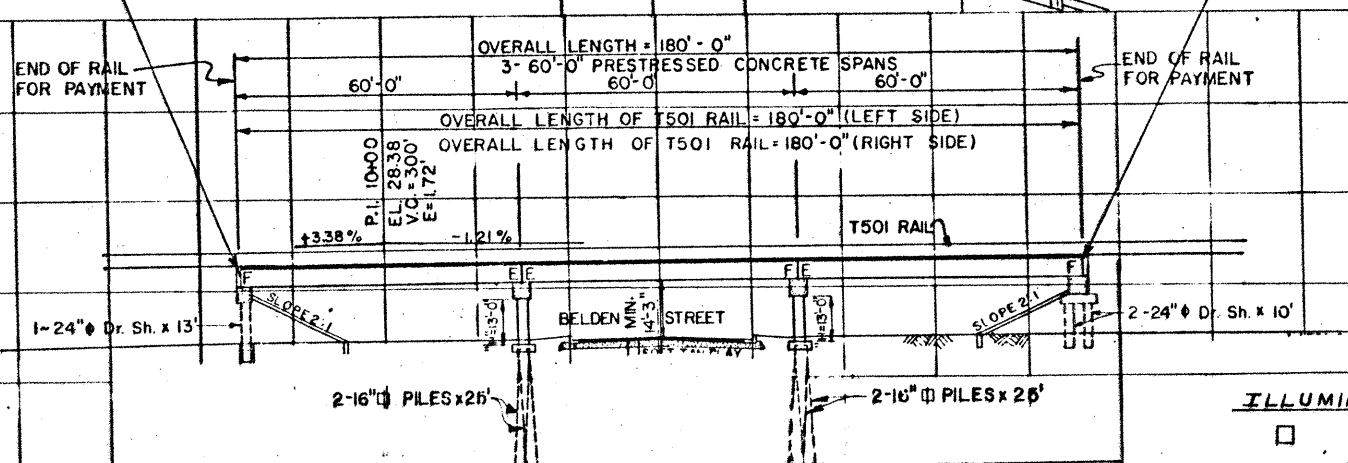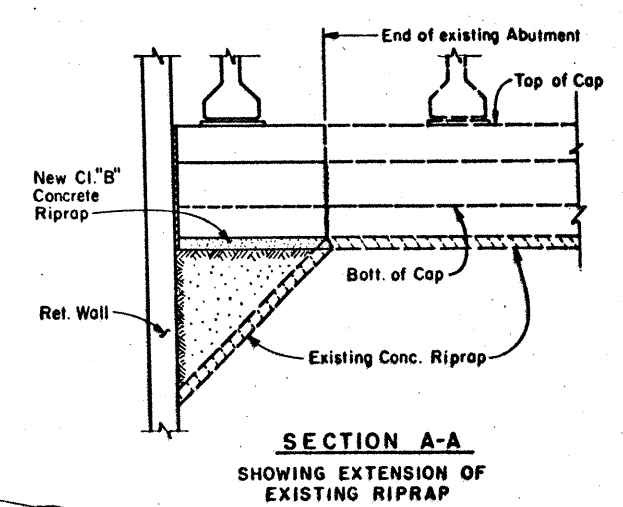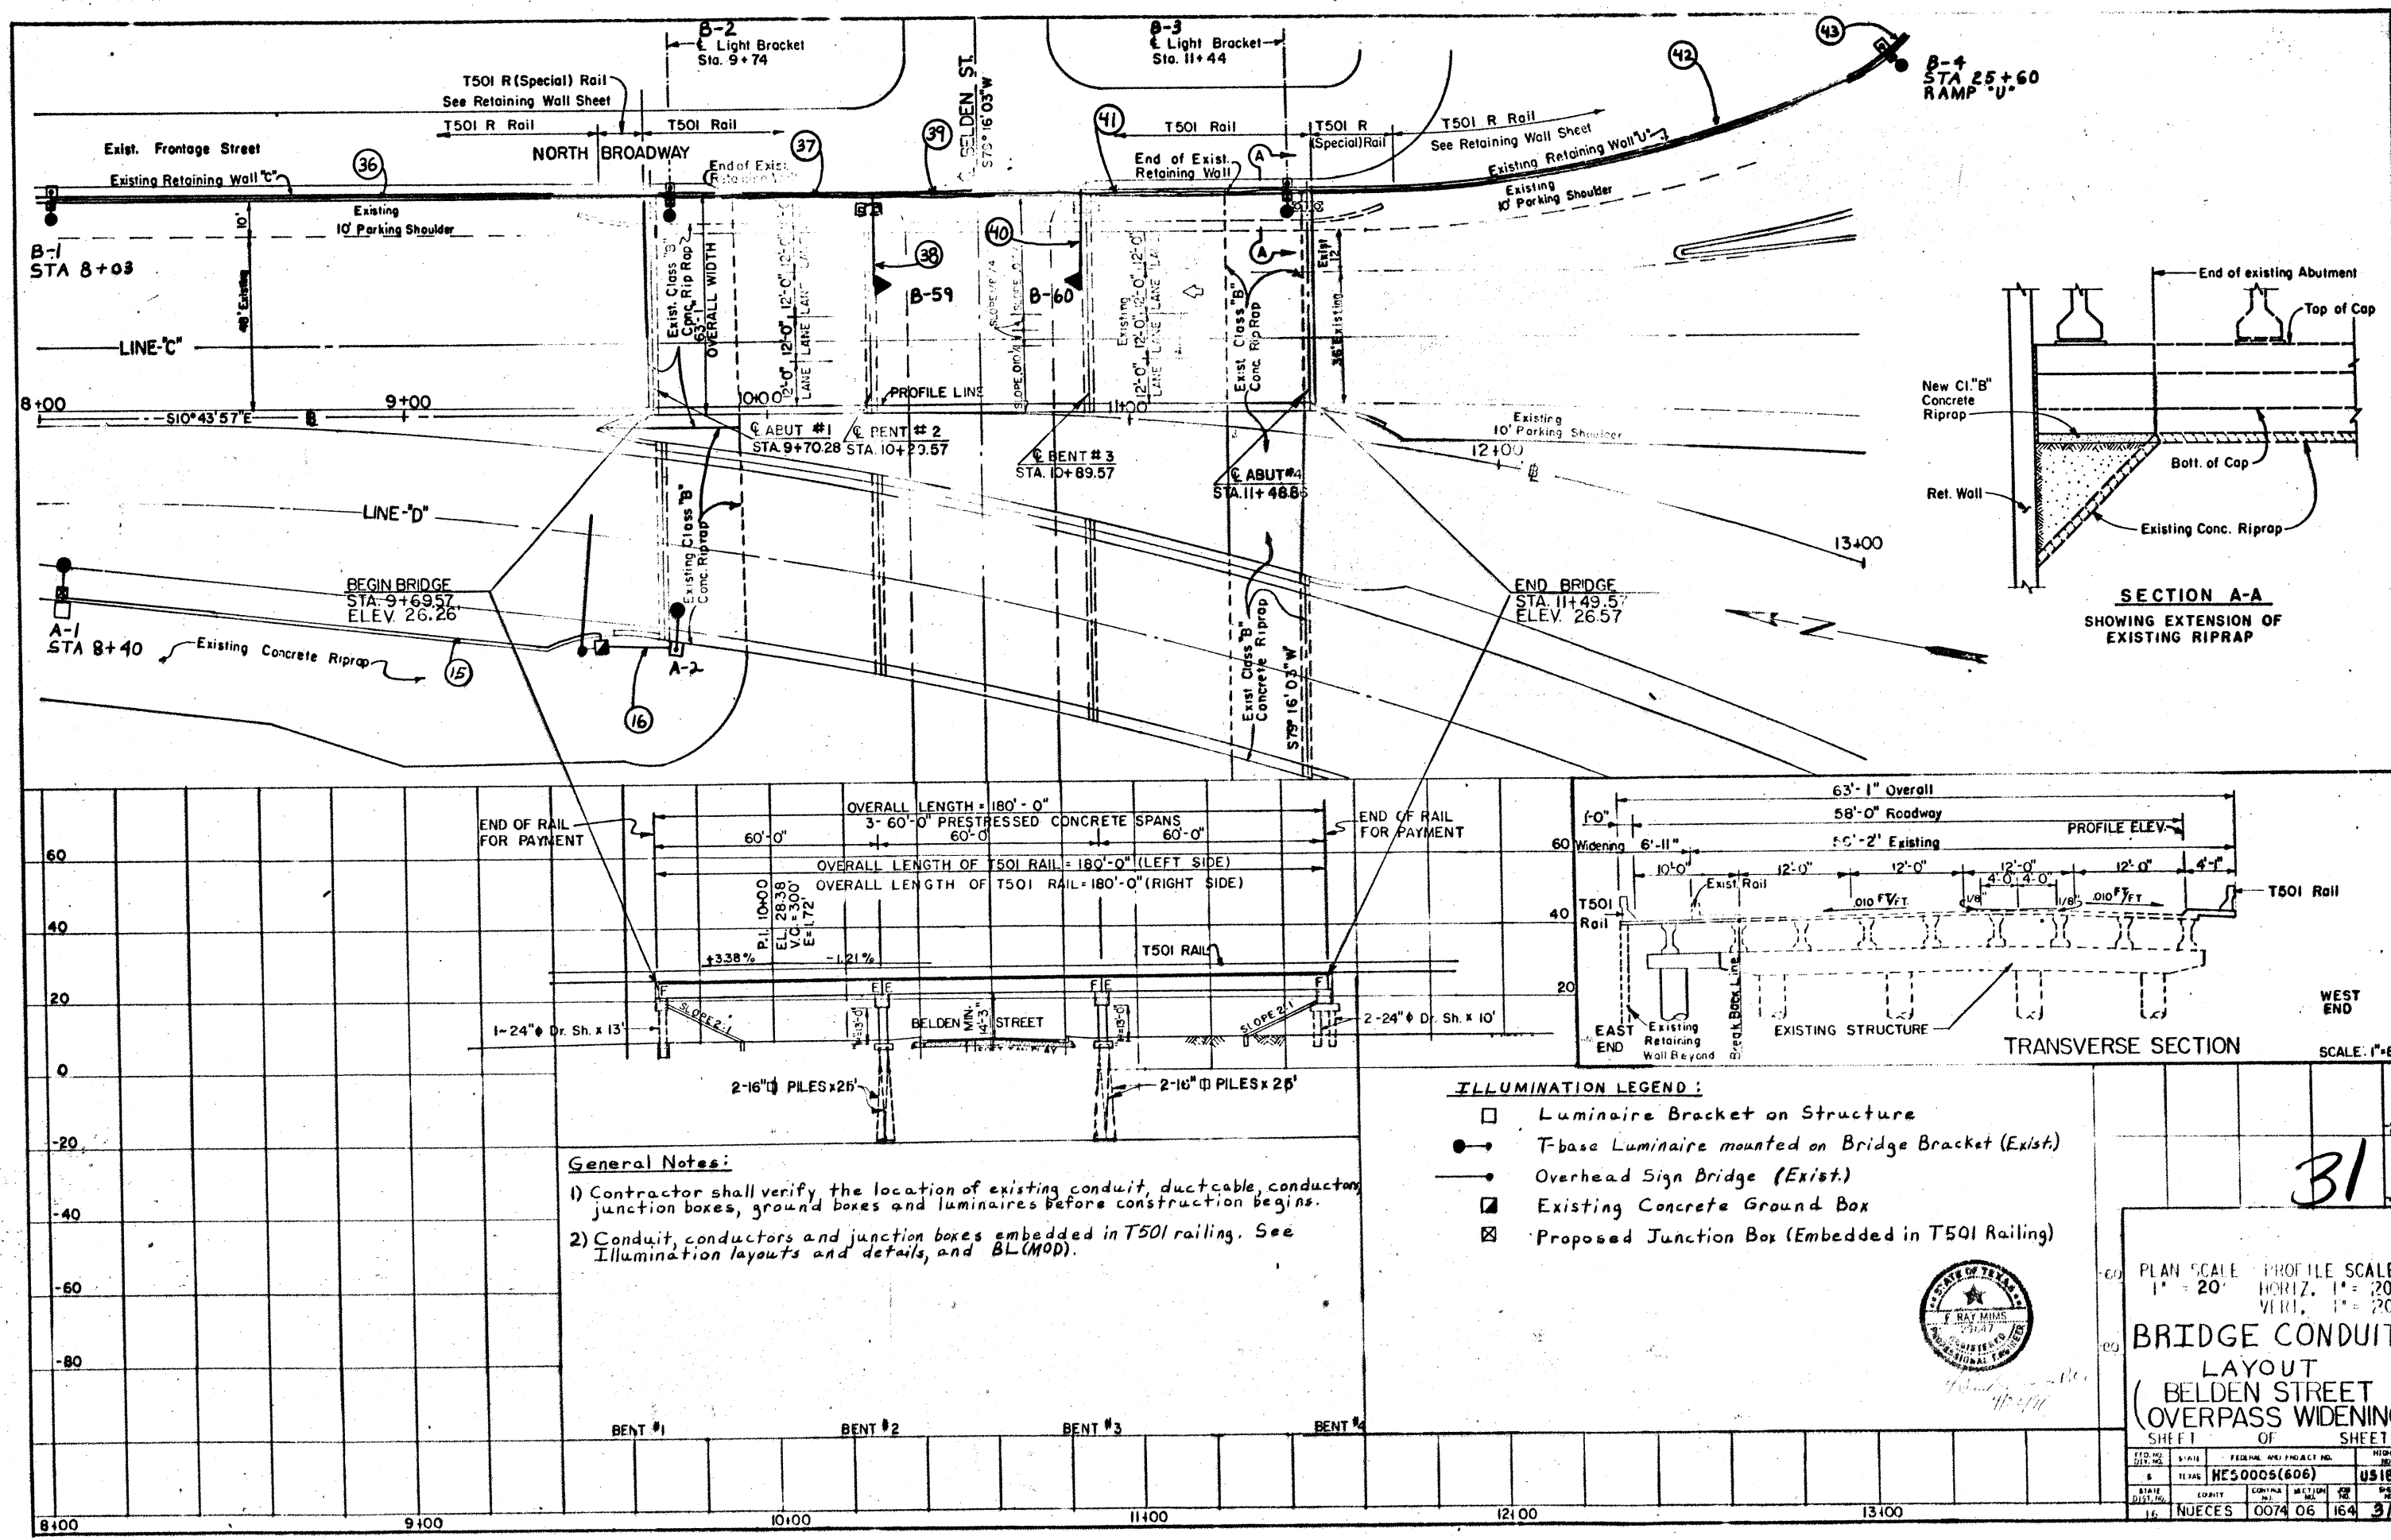

General Notes:

- 1) Contractor shall verify the location of existing conduit, duct cable, conductor junction boxes, ground boxes and luminaires before construction begins.
- 2) Conduit, conductors and junction boxes embedded in T501 railing. See Illumination layouts and details, and BL(MOD).

- ILLUMINATION LEGEND:**
- ☐ Luminaire Bracket on Structure
 - ☒ T-base Luminaire mounted on Bridge Bracket (Exist.)
 - ☒ Overhead Sign Bridge (Exist.)
 - ☒ Existing Concrete Ground Box
 - ☒ Proposed Junction Box (Embedded in T501 Railing)




31

PLAN SCALE: 1" = 20'
PROFILE SCALE: 1" = 20'
HORIZ. 1" = 20'
VERT. 1" = 20'

BRIDGE CONDUIT LAYOUT
(BELDEN STREET OVERPASS WIDENING)



SHEET 1 OF 3 SHEETS

PROJECT NO.	STATE	FEDERAL AID PROJECT NO.	SECTION	SHEET NO.
HE50005(606)	TEXAS			05161
STATE DIST. NO.	COUNTY	CONTRACT NO.	SECTION NO.	SHEET NO.
16	NUECES	0074	06	164

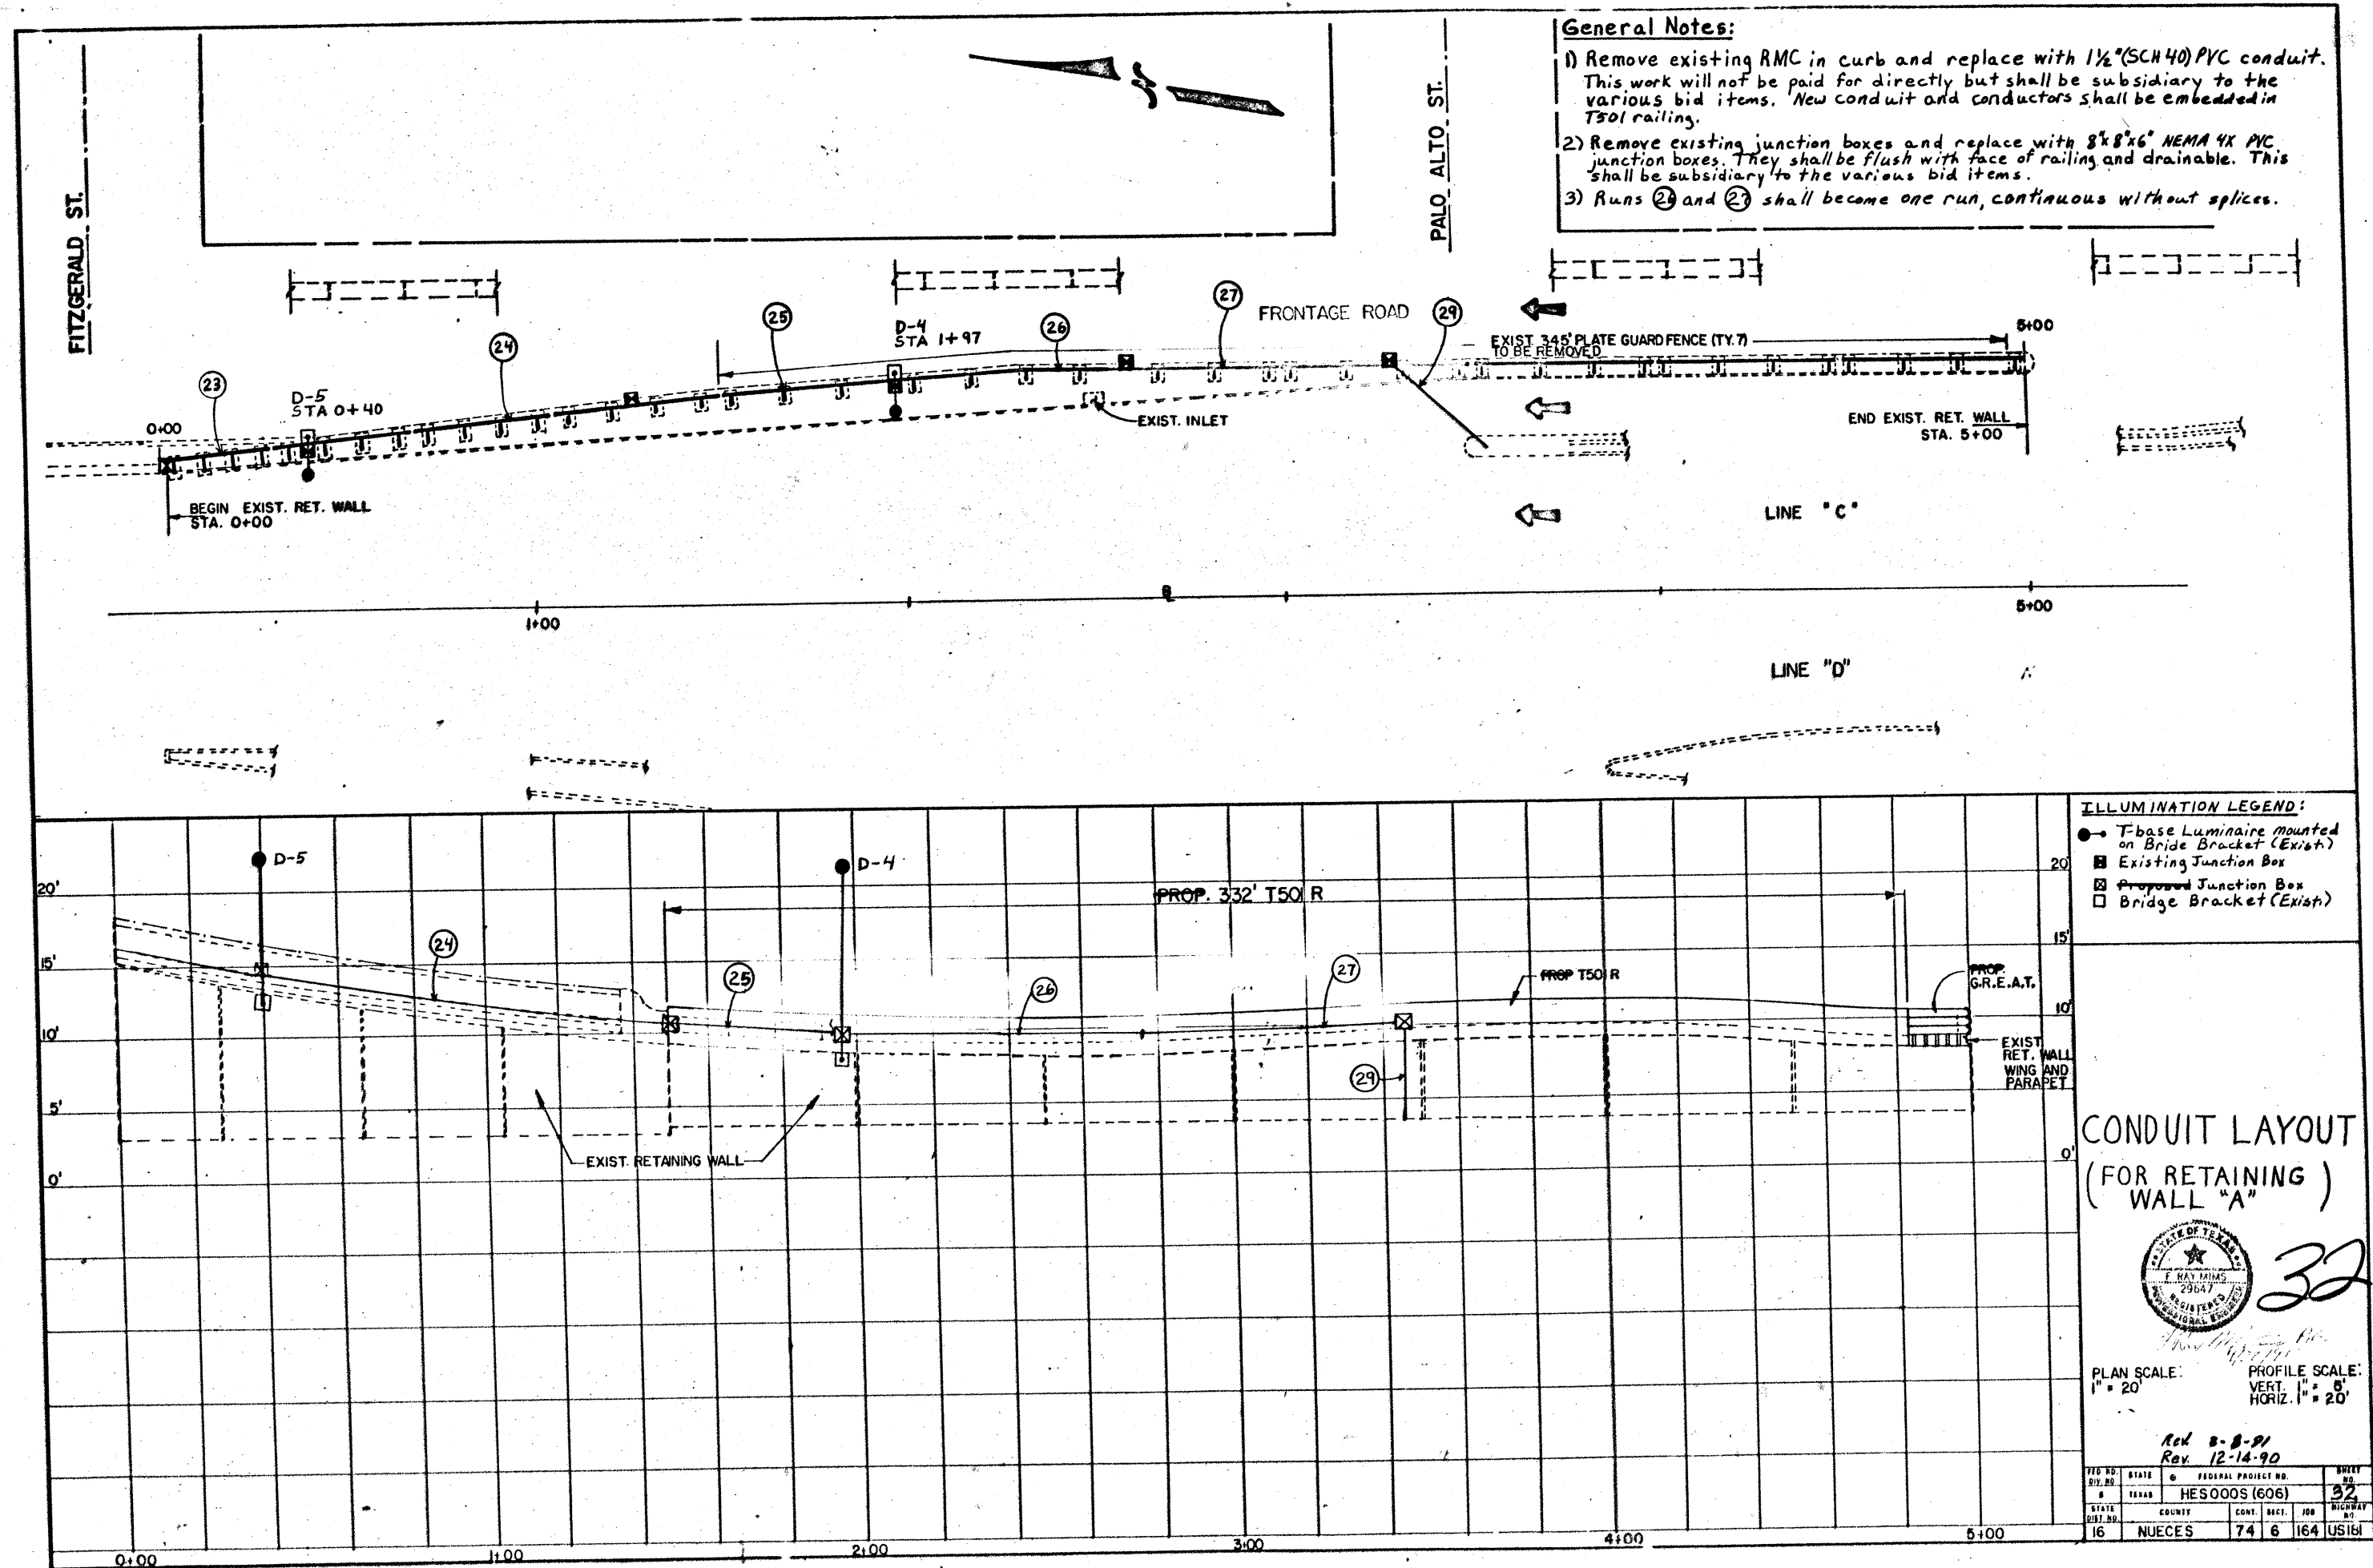

- Illumination Legend:
- ⊠ Existing Junction Box
 - ⊠ Prop. Junction Box
 - ⊠ Existing Bridge Bracket
 - Existing T-base on Bridge Bracket

Notes:
1) See Lighting layouts for details

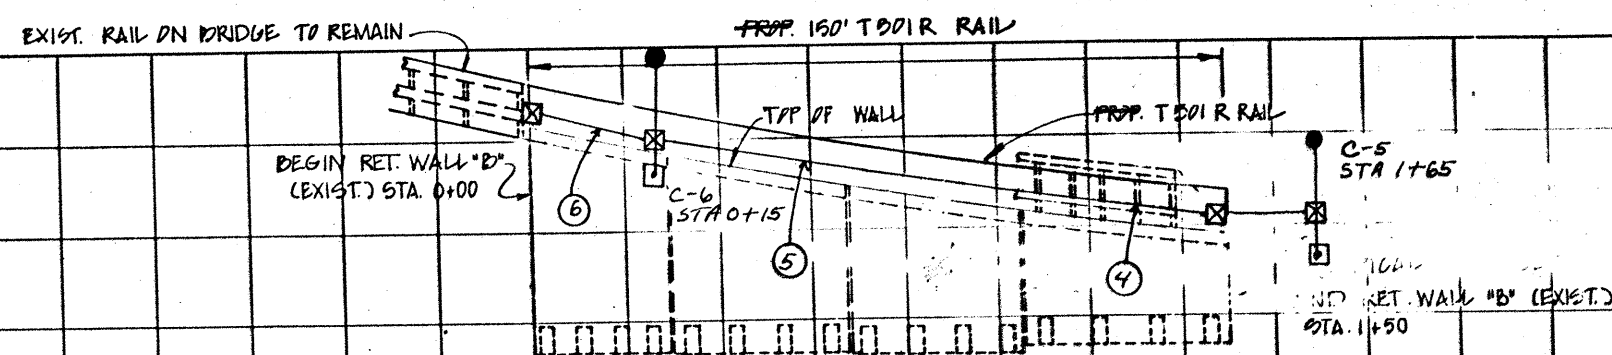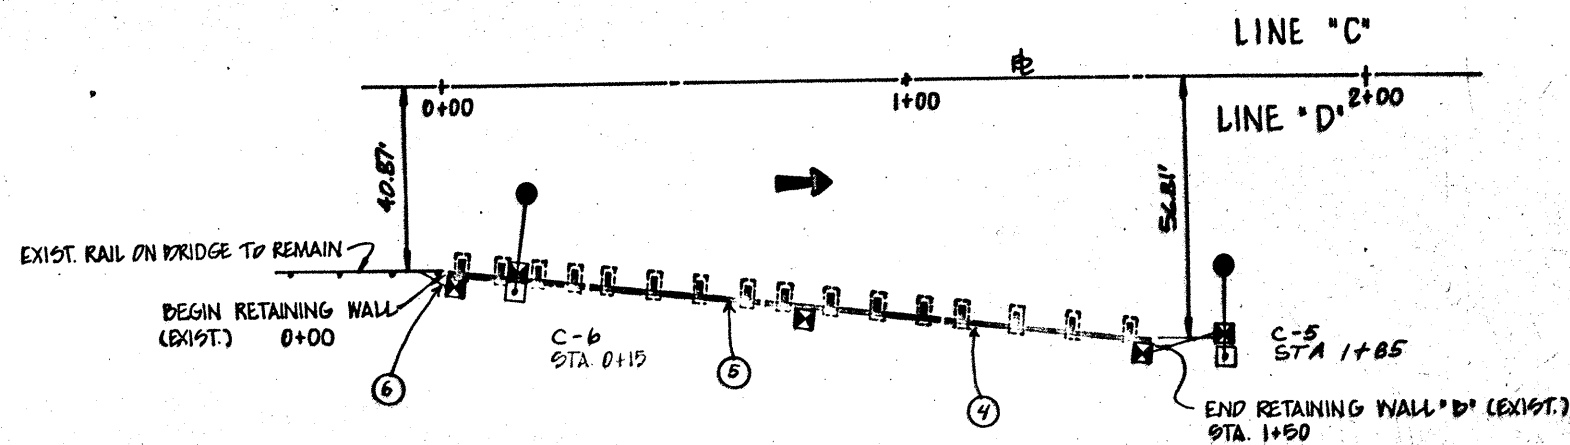



BRIDGE CONDUIT LAYOUT

(RETAINING WALL "B")

33


Rev. 12-14-90				
FED. NO.	STATE	FEDERAL PROJECT NO.	SHEET	
0	TEXAS	HE3 000 9 (606)	53	53
STATE DIST. NO.	COUNTY	CONTRACT NO.	JOB NO.	PROJECT NO.
16	NUECES	0074.06	164	161

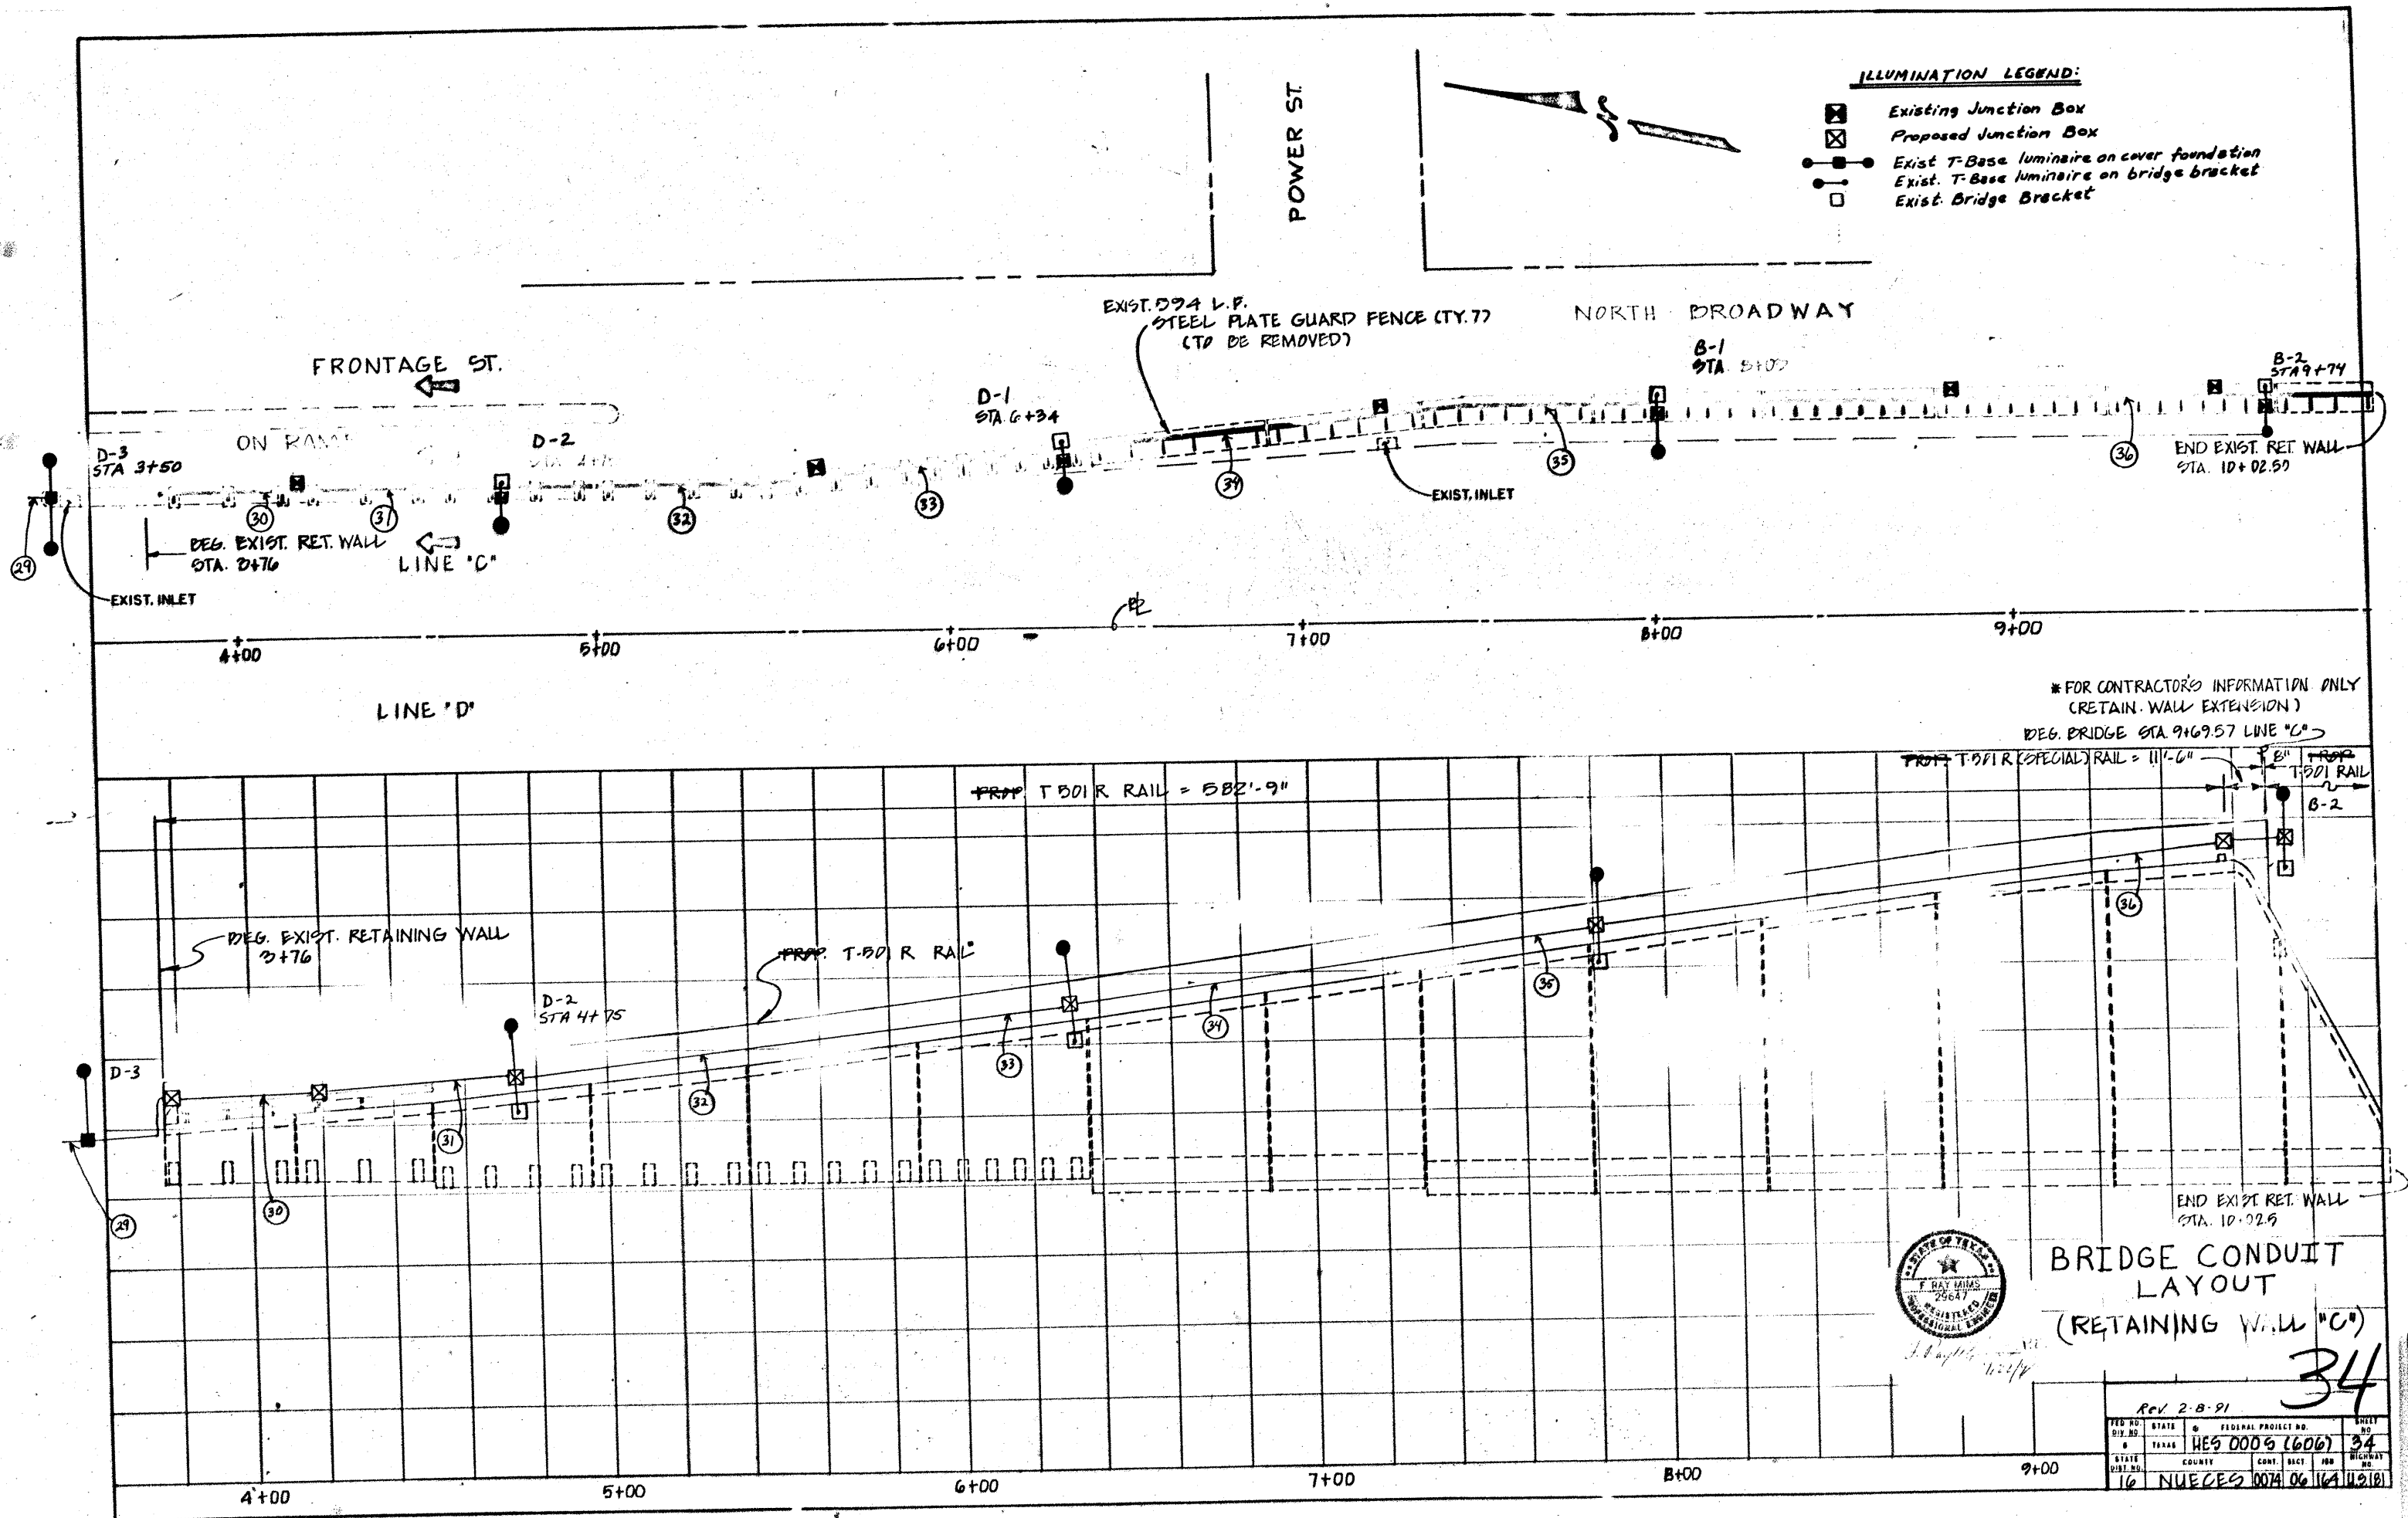

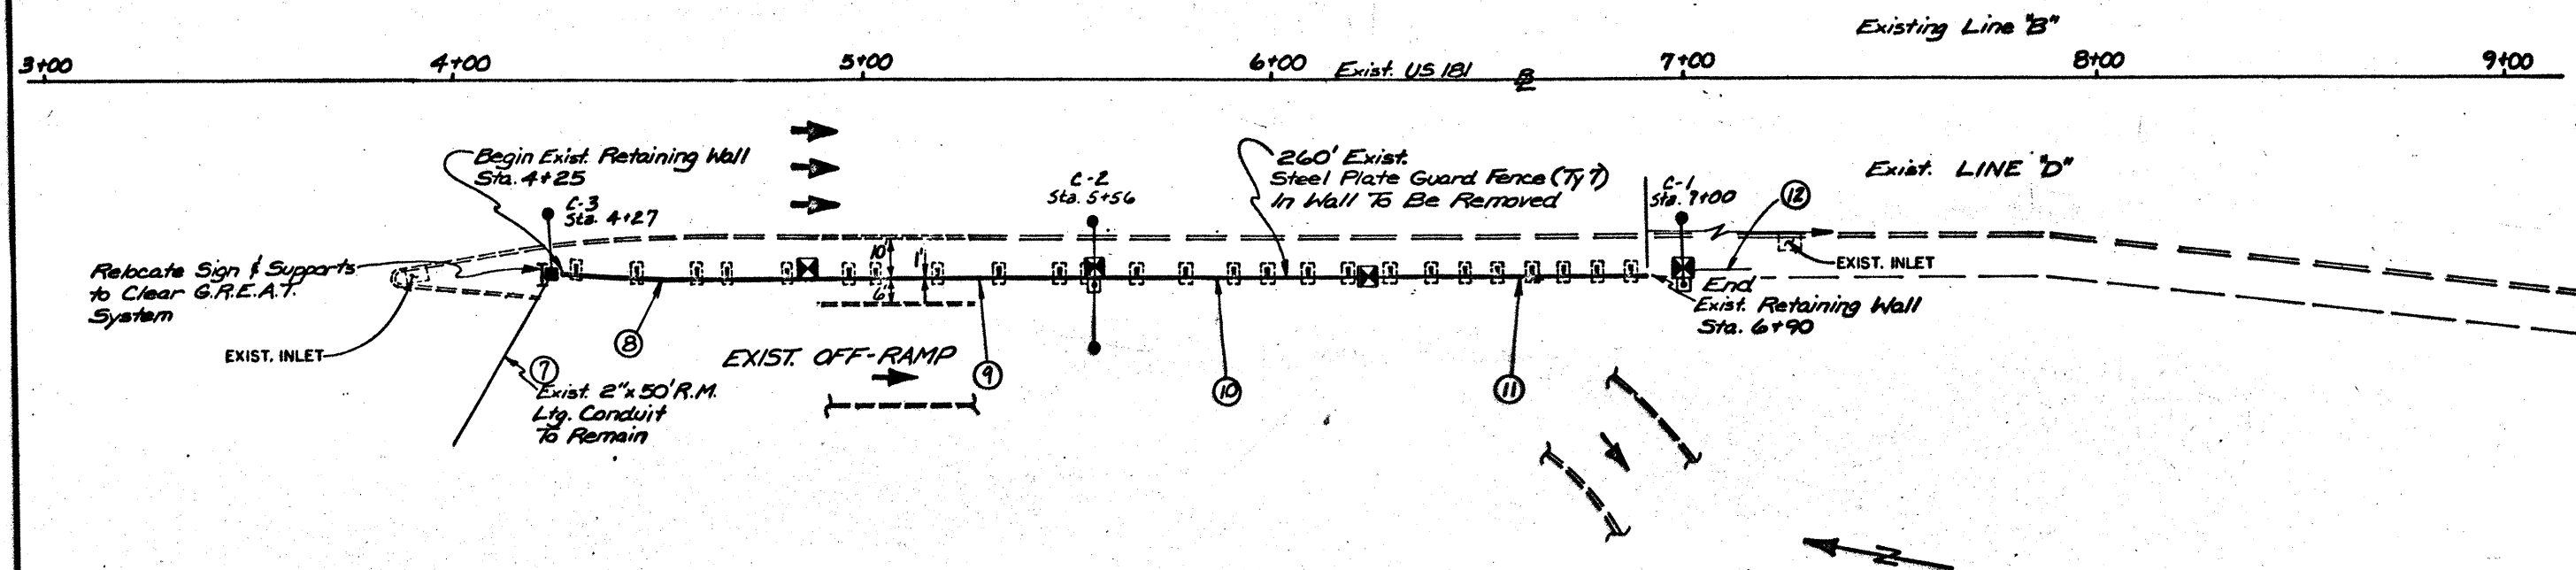

ILLUMINATION LEGEND:

- Existing Junction Box
- Proposed Junction Box
- Exist. T-Base luminaire on cover foundation
- Exist. T-Base luminaire on bridge bracket
- Exist. Bridge Bracket

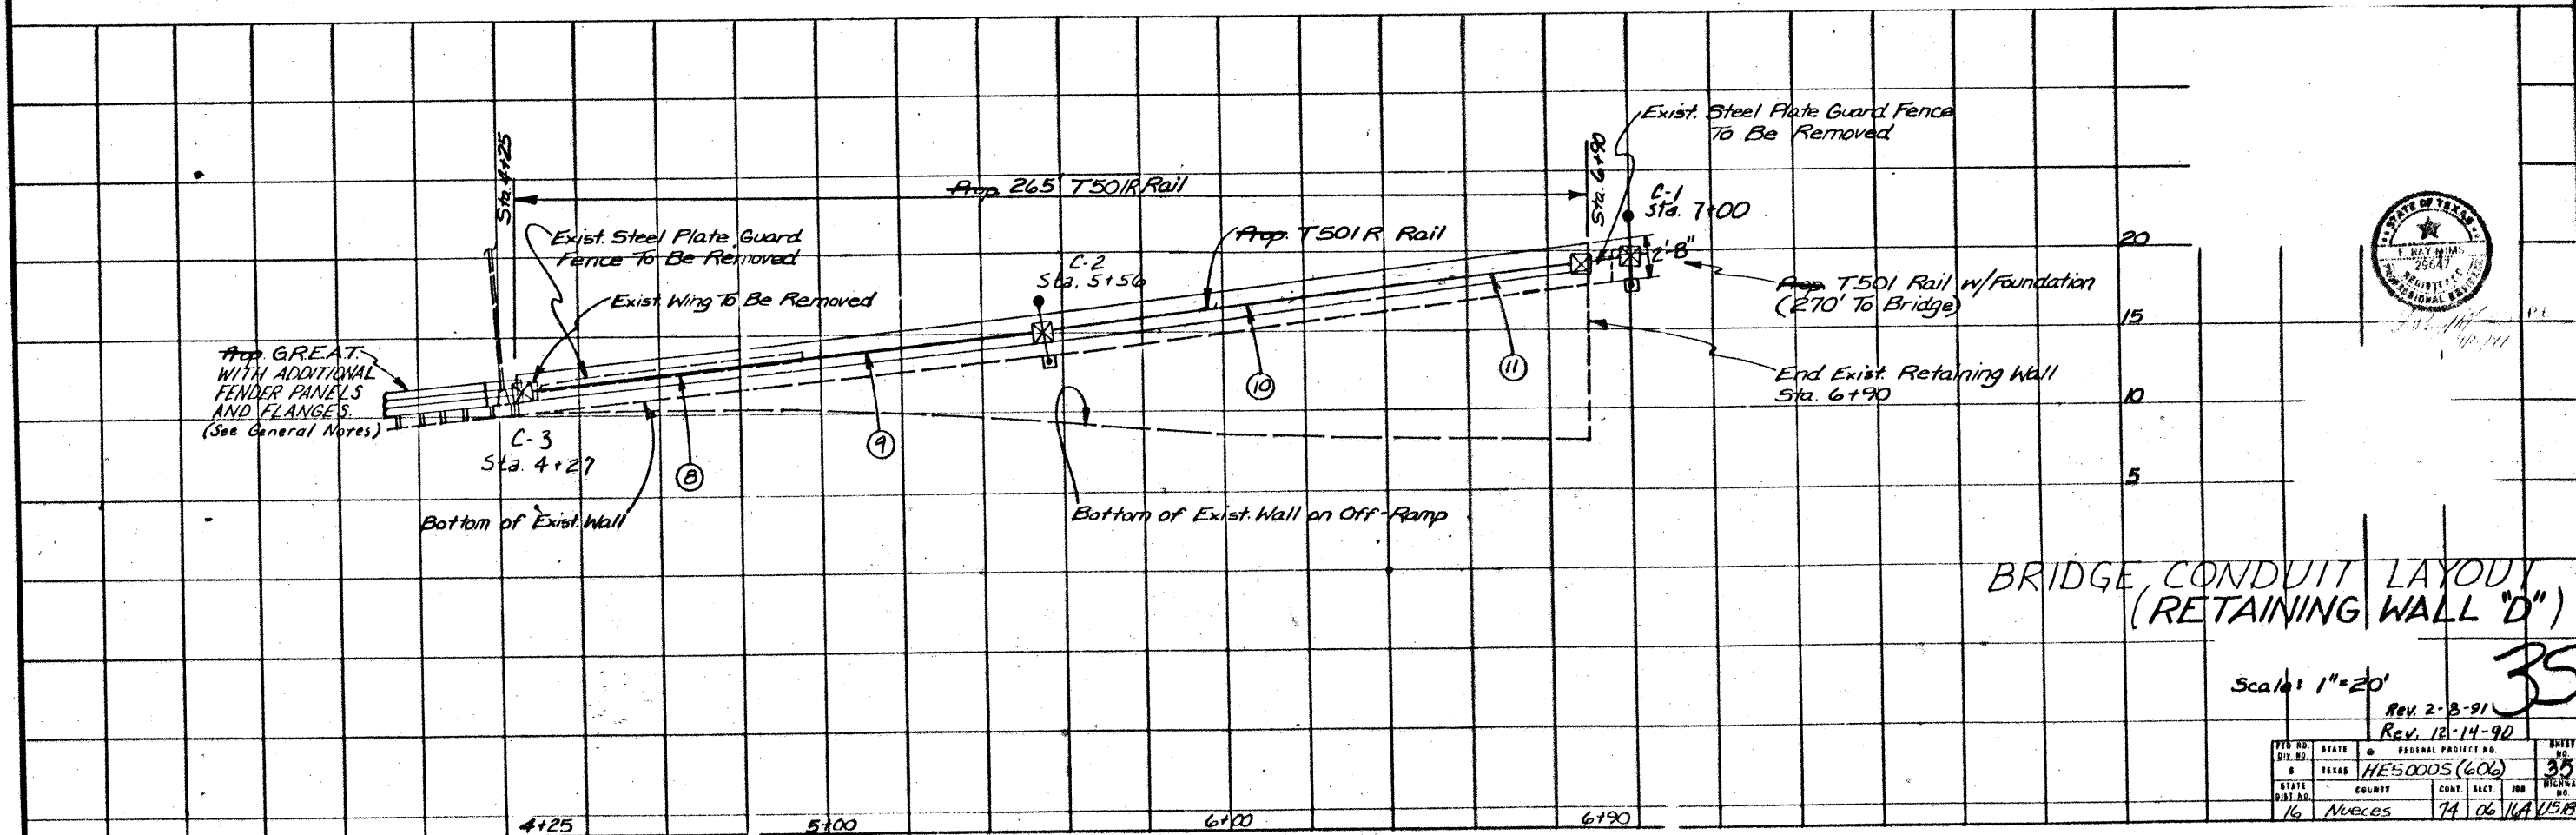

REV. 2-8-91		REV. 12-14-90	
STATE	COUNTY	FEDERAL PROJECT NO.	SHEET NO.
TEXAS	NOVACES	HE50005 (606)	35
DATE	BY	CHECK	DATE
16	NOVACES	74	06/16/91

EXIST.

BEGIN RETAINING WALL "U"
Sta. 23+25 ON WALL =
Sta. 23+25 ON RAMP "U"

RAMP "U"

RAMP "V"

EXIST. INLET

(45)

EXISTING FLEX. BEAM RAIL WILL
BE REMOVED AND REPLACED WITH
T50IR RAIL

EXIST. PULL BOX

REMOVE 305' STEEL PLATE
GUARD FENCE

ILLUMINATION LEGEND

- ☒ Exist. Jct. Box
- ☒ Prop. Jct. Box
- Exist. T-base on concrete foundation
- Exist. T-base on bridge bracket
- Exist. bridge bracket

EXISTING STEEL PLATE
GUARD FENCE WILL BE
REMOVED AND REPLACED
WITH 100 FT. OF M.B.G.F.
AND T.A.S.

REMOVE 135' Steel
Plate Guard Fence
Rail and T.A.S.

Exist. Service Pole #2

EXIST. INLET

Exist. Service Pole #2

B-3 Sta 11+44 Line C
END RETAINING WALL
Sta. 26+59 ON WALL
Sta. 11+30.56 LINE "C"

PROP.

PROP. T50I (SPECIAL) RAIL = 22'-8"

END OF BRIDGE STA. 11+49.57 LINE "C"

PROP. T50IR RAIL = 293'-0"

PROP. T50I RAIL

B-4
Sta. 25+60

EXISTING STEEL PLATE
GUARD FENCE TO BE
REMOVED

PROP. M.B.G.F. w/ T.A.S.

PROP. RETAINING WALL EXTENSION
(SEE RETAINING WALL EXTENSION SHEETS)

BRIDGE CONDUIT LAYOUT (RETAINING WALL "U")

SCALE: 1"=20'

Rev. 2-8-91		SHEET NO.	
FILE NO.	STATE	FEDERAL PROJECT NO.	36
0	TEXAS	HES 000S (606)	
STATE DIST. NO.	COUNTY	CON. SECT. JOB	HIGHWAY NO.
16	NUECES	74 6 16	US 161



36

GENERAL NOTES:

I. SCOPE

Details herein apply to roadway lighting installations bid under the following Specification Items: Roadway Illumination Assemblies, Relocate Roadway Illumination Assemblies, Roadway Illumination Assembly Foundations, Conduit, Electrical Conductor, Duct Cable, Ground Box, Circuit Protector Assembly, Service Poles, Transformer Stations and Special Specifications relating to lighting and electrical items. All work, materials and services not shown on plans which may be necessary for complete and proper construction shall be performed, furnished and installed by the Contractor. Faulty fabrication or poor workmanship in any material, equipment and installation will be considered justification for rejection. Materials and installation shall comply with the applicable provisions of the National Electrical Code and National Electrical Manufacturers Association standards. Where manufacturer's provide warranties or guarantees as a customary trade practice, Contractor shall furnish to the State such warranties or guarantees.

II. MATERIALS

A. General

All materials shall be new and unused. Alternate material equal to or better than those specified may be substituted with the approval of the Engineer.

B. Roadway Illumination Assembly

1. **Structural Support Design for Mast-Arm Mounted Luminaires.** Lighting standards shall be designed in accordance with the latest issue of the AASHTO "Standard Specifications for Structural Supports for Highway Signs, Luminaires and Traffic Signals." All poles shall be designed for 90 mph wind loads. An additional 1.3 gust factor shall be applied to the wind loads. For transformer base poles, fabricator shall include transformer base and connecting hardware in design calculations and shop drawing submittals. Manufacturer's shop drawings shall include the ASTM designations for all material to be used. See paragraph II D for additional requirements for the transformer base.
2. **Slip Joint Poles.** Poles may be fabricated in two sections and field-assembled by the lap-joint method. The two sections shall telescope together with a lap length of not less than 1-1/2 times the shaft diameter at the lap joint. The longitudinal seam weld within 13 inches of the slip joint shall be a full penetration weld.
3. **Mast Arm Attachments.** All poles and attachments shall be structurally designed to support two 12-foot mast arms and luminaires. Poles shall be supplied with mast arm combinations as shown in the plans. All mast arms shall be designed for a 55-pound luminaire having an effective projected area of 1.4 square feet.
4. **Minor Damage Repair.** The finished pole shall have a smooth, uniform finish free of pits, blisters, or other defects. Scratched, chipped, or damaged areas on galvanized poles and mast arms shall be thoroughly cleaned by wire brushing. The cleaned area shall be painted with two coats of zinc dust-zinc oxide paint conforming to the requirements of Federal Specifications TT-P-641b, or repaired by the application of repair compounds meeting Federal Specification 0-693 (stick only) in accordance with the manufacturer's recommendations.
5. **Pole Bonding Means.** All shoe base poles, including poles on concrete traffic barriers, shall have a grounding lug with 1/2-13 NC female threads inside the pole near the hand hole, minimum of 3 full threads.
6. **Hand Holes.** All shoe base poles shall have hand holes with reinforcing frames and covers. The openings on all poles shall be approximately 4 inches x 6-1/2 inches located approximately 10 inches from the bottom of the pole and except for poles mounted on concrete traffic barrier, shall be placed 90 degrees to mast arm unless otherwise noted on plans. See paragraph III.B.4 for CTB mounted poles.
7. **CTB Poles.** Poles installed on concrete traffic barrier shall also meet the requirements of CTB details.
8. **J-Hooks.** All mast arm type poles shall be equipped with a J-hook inside the pole, near the top for supporting vertical conductors.
9. **Base Plate Bolt Circle.** Bolt circle for poles (except CTB-mounted poles) less than 40 feet MH shall be 13 inches. For MH 40 feet or greater, bolt circle shall be 15 inches. For poles placed on existing bridge brackets or existing foundations, bolt circle shall be coordinated with anchor bolts in place.
10. **Steel Poles.**
 - a. Steel poles shall be fabricated in accordance with the item "Steel Structures." Longitudinal seam welds for pole sections shall have 60% minimum penetration. All welding shall be in accordance with Departmental Construction Bulletin C-5. Two-section poles joined by circumferential welds will not be permitted.
 - b. Pole components shall be constructed using the following materials:

Shafts: ASTM A-572 Grade 50 or ASTM A-595 Grade A (50 KSI min. yield) or ASTM A-36M50, in accordance with item 4146. Galvanized in accordance with ASTM A-123.

Base Plates: ASTM A-27 Grade 65-35 or ASTM A-36 - galvanized in accordance with ASTM A-123.

Mast Arm Connectors: ASTM A-27 Grade 65-35 - galvanized in accordance with ASTM A-153 Class A.


Mast Arms: Steel Pipe ASTM A-53 Grade A or B or ASTM A-501 or A-513 TY 1 with minimum 30 KSI yield and 20% elongation in 2 inches, galvanized in accordance with ASTM A-123.

Pole Caps: Pole cap shall be zinc die-coat, aluminum, or galvanized metal, secured by three stainless steel or galvanized screws.


Pole Hardware: All bolts except mast arm connection bolts shall be stainless steel or standard steel galvanized ASTM A-153 Class C or D, or B-695 Class 40. Mast arm connection bolts shall be ASTM A-325, ASTM A-321 or ASTM A-193 Grade B-7, galvanized as above. Nuts and washers shall be compatible with the bolts and shall be stainless steel or steel, galvanized as above. Lock washers shall be provided on all bolted connections.

11. Aluminum Poles.

- a. Aluminum poles shall be fabricated in accordance with "Structural Welding, Aluminum" ANSI/AWS D1.2.

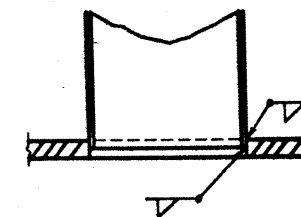


SECTION
POLE SHAFT TO BASE PLATE

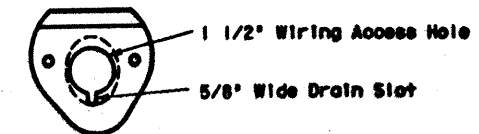

MAST ARM CONNECTOR


Steel Poles Only
Aluminum Pole Connector
Shall Be Clamp-on Type

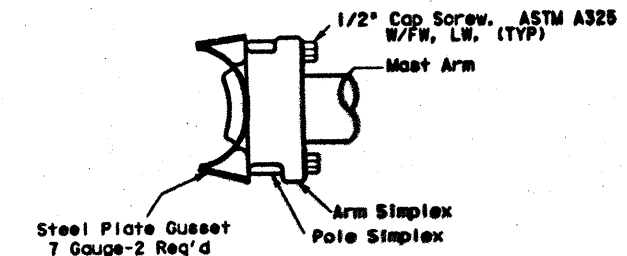

MAST ARM TO POLE SHAFT CONNECTION

EXPLANATION OF ROADWAY ILLUMINATION ASSEMBLY DESIGNATIONS

- TYPE *SA 58 T 8 8 .4KW 5
- SA: Pole assembly may be steel or aluminum.
ST: Pole assembly must be steel.
AL: Pole assembly must be aluminum.
- Two numerical digits denote mounting height in feet.
- Next letter denotes type of base, (S- Shoe Base, T-Transformer Base).
- First number denotes length of mast arm in feet.
- Use of second mast arm is indicated by second dashed number which denotes length in feet.
- Next three figures indicate luminaire rating (1 KW= 1000 watts, .4 KW= 400 watts, etc.)
- Last letter indicates the type of lamp (M- Mercury, S- High Pressure Sodium, L- Low Pressure Sodium).
- *SP denotes special (ovalized) steel pole for installing on CTB. See standard sheet CTB1 (4).
- MH = Mounting Height
SL = Shaft Length
S = Spread (Mast arm length)
MH = SL + 5' + 20' (T-Base)
MH = SL + 5' (Shoe Base)

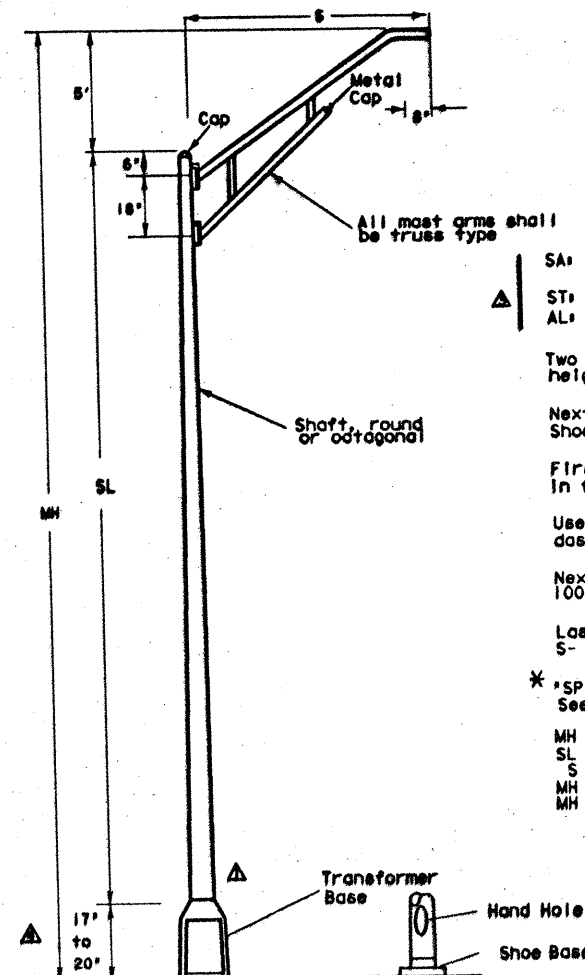

ROADWAY ILLUMINATION ASSEMBLY

- 11-90 Modified T-Base.
4-90 Changed pole material.
8-89 Reduced to 34" Sheet.
8-89 Removed hand hole for T-Base poles.

STATE DEPARTMENT OF HIGHWAYS AND PUBLIC TRANSPORTATION		ROADWAY ILLUMINATION DETAILS		RID (1)-88	
DRAWING	DATE	FED. NO.	STATE	FEDERAL AID PROJECT NO.	SHEET NO.
ORIGINAL	1-88	6	TEXAS	HES 0005 (406)	37
REVISIONS	8-89	STATE	COUNTY	CONT.	SECT.
REVISIONS	4-90	16	MURKES	74	6
REVISIONS	11-90	16	MURKES	74	6

ZFA3-1122, 106JRID181

b. Pole components shall be constructed using the following materials:

Shafts: ASTM B-221 or B-241 Alloy 6063-T6, ASTM B-209 Alloy 5086-H34, ASTM B-221 Alloy 6005-T5.

Base Flange: ASTM B-26 Alloy 356.0-T6 or ASTM B-108 Alloy A356.0-T6.

Mast Arm Fittings: ASTM B-209 Alloy 6061-T6 or ASTM B-221 Alloy 6005-T5.

Mast Arms: ASTM B-241 Alloy 6061-T6 or Alloy 6063-T6.

Pole Cap: ASTM B-209 Alloy 5086-H32 or ASTM B-108 or B-26 Alloy 356.0-T6.

Bolts: Stainless Steel AISI 300. Bolts threading into aluminum threads shall be treated with anti-seize compound, Never-Seez Compound, Permatex 133K or equal.

12. Alternate material equal to or better than material specified may be substituted with the approval of the Engineer.

13. Installation of High Strength Bolts. The tightening of nuts on high strength bolts shall be in accordance with the item "Structural Bolting."

C. Foundations

- Concrete and reinforcing steel for foundations will be included for payment under item "Roadway Illumination Assembly Foundations" only. Top 6 inches of foundation shall be formed and struck level.
- Anchor bolts for all poles except CTB-mounted poles shall be steel, ASTM A-36M55. Anchor bolts for CTB-mounted poles shall be steel, ASTM A-325 or A-321 threaded rod. Nuts for CTB anchor bolts shall be ASTM A-563 Grade D heavy hex, galvanized. The top 8 inches of all anchor bolts shall be galvanized per ASTM A-153. Anchor bolts in foundations shall be 1 1/4 in. x 48 in. and shall have top end threaded not less than 5 inches and furnished with galvanized hex nuts, flat and lock washers. The lower end of the bolt shall be bent at a right angle or threaded and furnished with nut and washer. When bolts with rolled threads are furnished, bolt body need not be full size. See CTB details for anchor bolts in CTB. Anchor bolts and nuts shall have Class 2A and 2B fit. Nuts shall be tapped or chased after galvanizing.
- Concrete shall be Class A or C in accordance with item "Concrete for Structures". Reinforcing steel shall meet the requirements of the item "Reinforcing Steel".
- The bolt circle in foundations for transformer base poles with a mounting height (MH) less than 40 feet shall be 14 inches. The bolt circle for shoe base poles less than 40 feet MH shall be 13 inches. For poles with MH 40 feet or greater, bolt circle in foundations shall be 17-1/4 inches in diameter if a transformer base is used and 15 inches if a shoe base mounting is used.
- A minimum of two conduits shall be installed in each foundation. See lighting layout sheets for locations of foundations with more than 2 conduits. Any unused conduits in foundations shall be capped on both ends.

D. Transformer Base


- Transformer base shall be cast from aluminum, ASTM B-108 or B-26 Alloy 356.0-T6, and shall be furnished with four washers or lugs as recommended by the manufacturer. Base for poles less than 40 feet MH shall have a bottom bolt circle to accommodate a 14 inch anchor bolt circle. Top bolt circle shall be 13 inches. Bases for poles with MH 40 feet or greater shall have a bottom bolt circle to accommodate a 17-1/4 inch anchor bolt circle, top bolt circle shall be 14 inches to 15 inches.
- Transformer base shall be approximately 20 inches high and shall have a door approximately 13 inches X 8 inches X 9-1/4 inches. Screw or bolts for attachment of door to base shall be stainless steel. Four machine bolts with four nuts, eight flat washers and four lock washers, galvanized ASTM A-153 Class C or D, or B-695 Class 40, shall be provided with each transformer base for connecting the pole. Bolts shall be ASTM A325 or approved equal. Nuts shall be ASTM A-563 Grade DH, galvanized. A 1/2-13 NC female threaded grounding lug shall be provided inside the transformer base. Leveling nuts shall not be used under transformer bases.
- Transformer bases shall meet the breakaway requirements of the AASHTO "Standard Specifications for Structural Supports for Highway Signs, Luminaires and Traffic Signals," 1985 edition, and shall have been tested by FHWA-approved methods.
- Transformer bases shall have been structurally tested to meet or exceed the full designed plastic moment capacity of the pole.
- Certification of the plastic moment load test and FHWA breakaway requirement test shall be submitted with shop drawings. Shop drawings shall show transformer base model number and logo.
- Aluminum transformer bases shall be stamped, incised or by other approved permanent means, marked to show fabricators name or logo, model number and maximum allowable pole weight. Such information shall be placed in a readily seen location, inside or outside the base, but shall not be placed on the door.
- Doors for transformer bases shall be made of plastic, fiberglass or other non-aluminum material approved by the Engineer.

E. All Luminaires

- The luminaire housing shall be cast or drawn from a non-ferrous alloy and shall be free of cracks and excessive porosity. All nuts, screws, clips, washers and attaching hardware shall be made of stainless steel or steel electro-zinc-plated, minimum thickness 0.0002 inch with olive green drab or yellow chromate conversion coating, or other approved conversion coatings except that brackets may be made from pre-galvanized steel. All threaded surfaces used in the housing shall be lubricated with a silicone grease.
- The slipfitter shall securely clamp the luminaire to the mast arm. A positive means of vertical adjustment shall be provided. The refractor shall be crystal-clear pressed glass. The optic assembly shall be provided with resilient gaskets and so constructed that a positive seal against weather and other contaminants will be maintained. The luminaire shall be designed to permit ready removal of the refractor from the luminaire but shall provide a positive means of preventing an unintentional separation. The latch shall provide a positive means of maintaining closure of the luminaire. The socket shall be rigidly attached to a high grade porcelain base which shall extend and enclose the metal shell. A locking means shall be incorporated in the shell of the socket to positively resist the removal of the lamp. Reflectors shall be aluminum and shall not be painted.
- Mast-arm mounted luminaires, except underpass luminaires, shall be provided with a leveling device which is clearly visible from the ground. Unless otherwise directed by the Engineer, mast-arm mounted luminaires will be tested and installed in the level position.
- Underpass luminaires shall be fused internally. Fuses shall be 5 amp time-delay type.

II. B. 13. Fabrication Tolerances

Part	Dimension	Tolerance
Pole Assembly	Shaft length	± 1 in.
	I.D. of outside piece of slip fitting pieces	+1/8 in., -1/16 in.
	O.D. of inside piece of slip fitting pieces	+1/32 in., -1/8 in.
	Shaft diameter, other	+ 3/16 in.
	Out of "round"	1/4 in.
	Straightness of shaft	± 1/4 in. in 10 ft.
	Twist in shaft	4° in 50 ft.
	Perpendicular to baseplate	1/8 in. in 24 in.
	Pole centered on baseplate	± 1/4 in.
Arm Assembly	Location of Attachments	± 1/4 in.
	Arm Length	± 3 in.
	Arm Rise	± 1 3/4 in. in 10 ft.
	Arm Diameter	± 3/16 in.
	Overall length or width	± 1/4 in.
	Thickness	+1/4 in., -1/16 in.
	Deviation from flat	1/8 in. in 12 in.
	Spacing between holes	± 3/32 in.
	Anchor bolt hole size	± 1/16 in.
Anchor Bolt	Length	+ 1 in., -1/4 in.
	Threaded length	+ 1 1/2 in., -1/8 in.
	Galvanized length (if required)	+ 8 in., -1/4 in.
Miscellaneous	Bolt hole spacing	± 1/16 in.
	Strut location in truss arms	± 1 1/2 in.

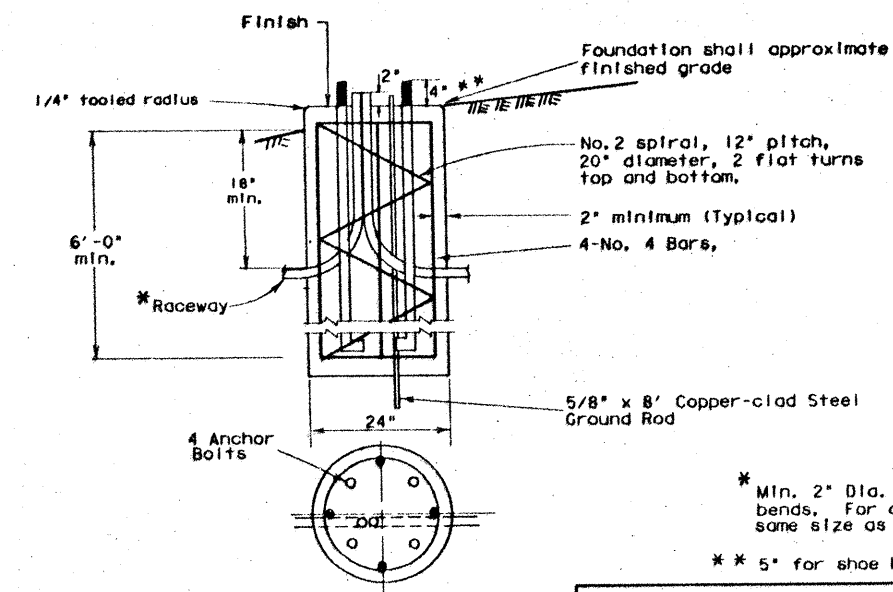

TYPE B FOUNDATION

TYPE A FOUNDATION

Same except without reinforcing steel

- 4-90 Changed to '85 AASHTO.
8-89 Non-Aluminum doors REQ'D.
8-89 Reduced to 34\"/>

		STATE DEPARTMENT OF HIGHWAYS AND PUBLIC TRANSPORTATION	
ROADWAY ILLUMINATION DETAILS			
RID (2)-88			
DRWING	DATE	FED. NO. DIV. NO.	STATE
ORIGINAL	1-88	6	TEXAS
REVISIONS	3-89	STATE DIST. NO.	COUNTY
REVISIONS	8-89	16	HUEFES
REVISIONS	4-90		
FEDERAL AID PROJECT NO.		SHEET NO.	
HES 0005(606)		98	
CONTRACT	SECTION	JOB	REMARKS
0074	06	164	US181

II. F. High Pressure Sodium Vapor Luminaires

1. Photometrics

- a. The (TY UP) (SPL-CO) (.15KW)S underpass luminaires shall be 150 watt high pressure sodium, IES TYPE M-C-III. The fixtures shall provide a minimum measured intensity of .2 footcandles in a rectangular area measuring 80 feet X 30 feet, when mounted 20 foot above the midpoint of either long side of the surface area.
- b. The 250-watt mast-arm mounted luminaire shall be IES Type M-S-III and, when mounted 40 feet above the midpoint of either long side of a rectangular area 200 feet by 50 feet, shall provide a measured minimum intensity of 0.1 footcandle at any point on the surface of this area. Light intensities measured in footcandles along a line parallel to and 20 feet in from the long side of the previously defined rectangular area above which the luminaire is mounted shall decrease at a rate not to exceed 0.8 footcandle in any ten-foot interval along the aforementioned line from 10 to 70 feet on both sides of the luminaire.

The uniformity factor "F" shall be not less than 7.0 when calculated from the equation:

$$F = \frac{L (I \text{ Min.})}{I \text{ Max.}}$$

Where:

F = the uniformity factor

L = 200

I Min. = minimum measured intensity within the rectangle

I Max. = maximum measured intensity within the rectangle

- c. The 400-watt mast-arm mounted luminaire shall be IES Type M-S-III and, when mounted 50 feet above the point of either long side of a rectangular area 250 feet by 80 feet, shall provide a measured minimum intensity of 0.1 footcandle at any point on the surface of this area. Lighting intensities measured in footcandles along a line parallel to and 30 feet in from the long side of the previously defined rectangle above which the luminaire is mounted shall decrease at a rate not to exceed 0.8 footcandle in any ten-foot interval along the aforementioned line from 10 to 70 feet on both sides of the luminaire.

The uniformity factor "F" shall be not less than 7.0 when calculated from the equation:

$$F = \frac{L (I \text{ Min.})}{I \text{ Max.}}$$

Where:

F = the uniformity factor

L = 250

I Min. = minimum measured intensity within the rectangle

I Max. = maximum measured intensity within the rectangle

- d. The luminaires shall meet the photometric requirements shown above, when energized at 90 percent of rated line voltage.

2. Ballasts

- a. All ballasts shall be isolated-winding lag-type magnetic regulator and shall be designed to operate high pressure sodium lamps.
- b. When the circuit voltage indicated in the plans is applied, the ballast input wattage during fluctuations of the test voltage of +10 and -10 percent shall not exceed the following:

Nominal Lamp Rating, Watts	Maximum Wattage Input
150	220
250	400
400	552

- c. During fluctuation of the test voltage of +10 and -10 percent, the lamp wattage fluctuation shall not exceed a total of 20 percent and ballast shall maintain lamp wattage within the following limits:

Nominal Lamp Watts	Minimum Lamp Watts	Maximum Lamp Watts
150	110	180
250	175	370
400	280	475

- d. The power factor of any ballast when tested at circuit voltage indicated in the plans shall be not less than 90 percent.
- e. The electronic starting aid shall provide a starting pulse with an amplitude of 2500 volts minimum, 4000 volts maximum. The pulse width shall be a minimum of 0.8 microseconds at 2250 volts. The pulse shall occur when the open-circuit voltage is equal to or greater than 90 percent of peak open-circuit voltage. Pulse repetition rate shall be a minimum of one per cycle and pulse current shall be a minimum of 0.18 amperes. Electronic starting aids for mast-arm mounted poles shall be replaceable without the use of tools.
- f. Luminaires will be tested for satisfactory operation of the starter board under open-circuit (lamp-out) condition for a minimum of 72 hours. Any failures of starter boards will be considered grounds for rejection of the model starter board being supplied.
- g. Ballasts shall permanently and clearly indicate the following: lamp type, catalog number, voltage rating, connection diagram, and manufacturer. Capacitors in all luminaires shall be non-PCB type.

3. Lamps

- a. All lamps shall be new and shall have been manufactured no earlier than six months prior to the date the project is awarded.
- b. High pressure sodium vapor lamps in the wattage range of 200 to 400 watts inclusive shall have a lamp voltage not greater than 108 volts when tested after thirty minutes' burn-in. 150 watt lamps shall be rated for 55 volts.

4. Testing

- a. Ballasts and luminaires will be tested using a lamp furnished for the same project.
- b. Luminaires, ballasts, and lamps will be sampled and tested in accordance with the SDHPT Materials and Test Division's Manual of Testing Procedures.

- G. Wood Poles. For projects requiring more than 10 transformer and/or service poles, poles shall be creosote-treated to eight pounds per cubic foot-retention in accordance with the item "Timber Preservative and Treatment." For projects requiring ten or fewer poles, treatment shall be as stated above and Contractor may purchase poles locally if source and treatment are documented. All poles shall meet the requirements of ANSI 05.1-1972.

H. Electrical Conductors

1. All conductors shall be of annealed copper meeting the requirements of ASTM B-3 or B-33 and the NEC.
2. Insulated conductors shall be NEC Type XHHW or Type USE (XLP). Conductors in circuits containing two or more insulated conductors shall be color-coded at each accessible point (i.e., ground boxes, pole bases, junction boxes). Color-coding will be required on pre-conduitized duct cable containing two or more insulated conductors. Color-coding of electrical conductors may be made using colored tape. Tape marker shall consist of half-lap layer of tape covering a six inch length of jacket. Tape markers shall be placed on all insulated conductors needing coding at all pole bases, ground boxes, junction boxes, service assembly enclosures and luminaires.
3. Insulated conductors shall be marked in accordance with Article 310 of the NEC, and shall meet the requirements of Underwriters Laboratories' Standards.
4. Neutral conductors shall be insulated and shall be white or black with white tape marking. White shall not be used for any other conductor. Grounding conductors shall be bare or if insulated shall have green jacket or green tape marking. Green shall not be used for any other conductor.

I. Conduit and Fittings

1. Conduit must be UL-approved for the intended use shown on plan sheets. Aluminum conduit will not be permitted, unless allowed by plan note.
2. Fittings for steel conduit shall be steel or malleable iron, threaded or threadless, rain-tight. Die cast, set screw, Indenter or push-on (socks) fittings will not be permitted.
3. Insulated grounding bushings shall be used on all metallic conduit entries into boxes or enclosures without bossed hubs and in ground boxes.
4. Expansion joints for metallic conduit shall be provided with a grounding strap. Expansion joints for metal conduit shall be Appleton UNYL 50 Series, OZ AX Series or equal.

J. Ground Boxes

1. Ground Boxes shall meet the following requirements.

- a. Boxes shall be manufactured from Reinforced Polymer Concrete (RPM) composed of borosilicate glass fiber, a catalyzed polyester resin and an aggregate.
- b. Minimum inside dimensions (WxLxH) shall be as follows:
Type A shall be 12 inches x 23 inches x 11 inches.
Type B shall be 12 inches x 23 inches x 22 inches.
Type C shall be 16 inches x 29 inches x 11 inches.
Type D shall be 16 inches x 29 inches x 22 inches.
- c. Bottom edge of box or extension shall be footed (2-1/2 inch flange).
- d. Ground boxes and covers shall be designed for heavy duty loading (15,000 lb load over 10 inches x 10 inches area). Ground boxes and covers shall have been tested to meet required loading. Contractor shall submit certification of such tests.
- e. All ground boxes and covers shall be permanently marked with manufacturer's name or logo and manufacturer's model number.
- f. Ground box covers shall be steel, hot dipped galvanized, and shall have "ELECTRIC" imprint. Covers shall be bolted down. A grounding lug with 1/2-13 NC female threads shall be placed on the underside of the cover. Cover shall be bonded to grounding conductor with 3 foot jumper, Blackburn TTC4 or Burndy KC22B2 connector and split bolt connector. Two wire branch systems shall have a ground rod installed in ground box and be bonded to underside of cover with green bonding jumper.

2. Where indicated on plans, ground box will be encased in concrete apron as detailed.
3. A minimum gravel fill of 9 inches shall be placed under each ground box.
4. The Contractor may cut the necessary conduit holes in box extensions only. Holes must be 18 inches or more below the cover.
5. The Contractor shall make brochure submittal (four copies) on ground boxes.
6. Conduit bodies, junction and pull boxes shall be so installed that the wiring contained in them can be rendered accessible without excavating sidewalks, paving, earth, or other substance that is to be used to establish the finished grade unless their location is effectively identified and accessible for excavation.



The seal appearing on this document was authorized by F. RAY MIMS, No. 29647, on 4/11/11

- T.L.C. 9-90 Accessible wiring in ground boxes
9-90 Changed to conform with NEC 250-61(b)
8-89 Removed note H-5.
8-89 Reduced to 34" Sheet.

STATE DEPARTMENT OF HIGHWAYS AND PUBLIC TRANSPORTATION									
ROADWAY ILLUMINATION DETAILS									
RID (3)-88 (MOD)									
DRAWING NO.	DATE	FED. NO.	STATE	FEDERAL AID PROJECT NO.	SHEET NO.				
001	1-88	6	TEXAS	HES00061606	29				
CA.	REVISED	3-88				DATE	BY	CHKD	APP'D
001	REVISED	4-89				8-89	16	NUJCES	074 06 164 05/11

II. K. Junction Boxes

1. Junction boxes shall be cast iron or cast steel, hot-dipped galvanized, or cast aluminum (surface-mounted only) unless otherwise noted on plans.
2. Surface-mounted junction boxes for conduit 1-1/4 inches and larger shall be Crouse Hinds Type WAB, OZ Type YS, or Adolet Type 3R, with mounting lugs, minimum size 6 inches x 6 inches x 4 inches, or approved equal. For conduit 1 inch or smaller, surface-mounted boxes may be 4-1/2 inches round and approximately 3 inches deep, Crouse Hinds Type GRFX, Appleton Type JBDX, three-gang FD, or approved equal.
3. Flush-mounted junction boxes installed in concrete structures shall be Crouse Hinds, OZ, or approved equal similar to boxes described above but for flush mounting.

III. CONSTRUCTION METHODS

A. General


1. The location of poles, conductors, conduits, junction boxes, transformer stations and service poles are diagrammatic only and may be shifted by the Engineer to accommodate local conditions.
2. Erection and/or removal of poles and luminaires located near any overhead electrical lines shall be accomplished using established industry and utility safety practices. The Contractor shall consult with the appropriate utility company prior to beginning such work.

B. Roadway Illumination Assemblies

1. Roadway Illumination Assembly poles shall be erected plumb and true. Top of foundation shall be struck level and shims used to plumb pole, except that for shoe base poles only leveling nuts may be used. Leveling nuts shall not be used under transformer bases. Grout will not be placed between base flange and the foundation.
2. In each pole, continuous color-coded stranded No. 12 AWG copper Type XHHW or other approved XLP conductors shall be connected to the line side of each ballast. Color coding shall be accomplished as described in paragraph II.H.
3. A fused connector assembly or fuse-holder as specified shall be connected in each hot wire on the line side of each ballast. Luminaires on poles will be fused using quick-disconnect fuse-holders as shown in details. Fuses shall be 5 ampere time-delay type.
4. For median-mounted poles placed on concrete median barrier, all hand holes shall be on same side of the median.
5. Acorn nuts will not be allowed for attaching pole to transformer base or foundation. Nut covers will not be allowed.


C. Conduit

1. Continuous runs of conduit in excess of 150 feet attached to structures shall have expansion joints at mid-span or 150-foot intervals and at structure expansion joints or as shown in plans.
2. Conduit hangers or straps shall be spaced at maximum intervals of 5 feet. Hangers shall be Unistrut Series J1200, Globe Series 450, or equal, unless otherwise indicated in the plans. Conduit spacers shall be used on Rigid Metal conduit placed on vertical surface of concrete structures (see conduit detail).
3. Conduit hangers shall not be attached directly to prestressed concrete girders except as shown in the plans and approved by the Engineer.
4. Conduit placement beneath existing paved surfaces shall be accomplished by jacking or boring in accordance with the pertinent provisions of Article 476.3 "Construction" of the Item "Jacking, Boring or Tunneling Pipe," unless otherwise noted on plans. Jacking, boring, or tunneling will not be paid for directly but will be subsidiary to the item "Conduit." Duct cable shall be extended through the conduit in one continuous length or conductors shall be encased in a continuous length of conduit where passing under an existing roadway. Direct burial of conductor will not be allowed.
5. For all conduit placed by trenching, trenching and backfilling shall be in accordance with the item, "Excavation and Backfill for Sewers," except for measurement and payment. Trenching depth shall provide a minimum of 18 inch cover over conduit, unless noted otherwise on the plans.
6. With approval of the Engineer conduit placed under new roadways may be trenched in subgrade and backfilled with excavated material. When approved by the Engineer, conduit may be trenched in sub-base but must be backfilled with cement-stabilized base. Conduit placed after base or surfacing operation has begun must be jacked or bored. Conduit placed under existing roadways, driveways or sidewalks shall be placed as directed by the Engineer or as shown on plans.
7. Open ends of all conduit and raceways shall be fitted with temporary caps or plugs to prevent entry of dirt, debris and rodents during construction.
8. Conduit entry into junction boxes shall be made weathertight using threaded fittings or hubs, or with sealing locknuts inside and out.
9. The ends of all metallic conduit terminating in a ground box, junction box, enclosure, or light pole base carrying individual conductors shall be fitted with insulated grounding bushings. A bonding jumper shall be installed from bushings to nearest ground rod, grounding lug, or grounded conductor. At service poles, bonding jumper shall be AWG Size no. 6. All other jumpers shall be minimum size AWG No. 8. Metallic conduit run underground and not exposed or accessible at any point need not be grounded.
10. Conduits shall be sealed with heat shrink boots or tubes, with sealant, or shall be sealed by other methods approved by Engineer. Sealing shall be done after completion of the pull test described in paragraph III.D.3.

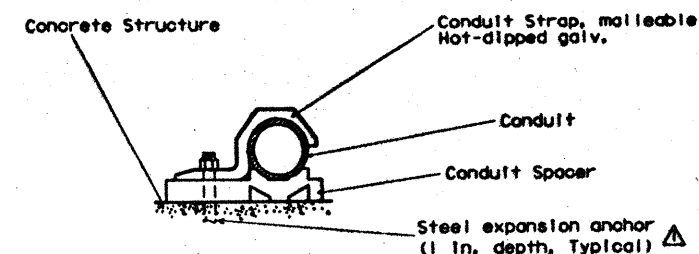


CONDUIT DETAIL
(Attachment to vertical surfaces)
(See para. III.C.2)

Proposed class A concrete apron reinforced with No. 3 reinforcing steel. Subsidiary to Item 624

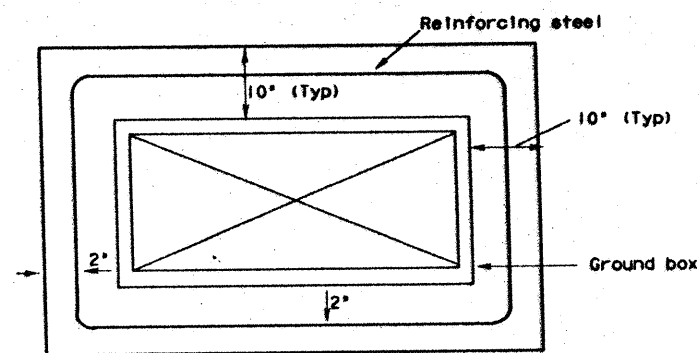

PLAN VIEW

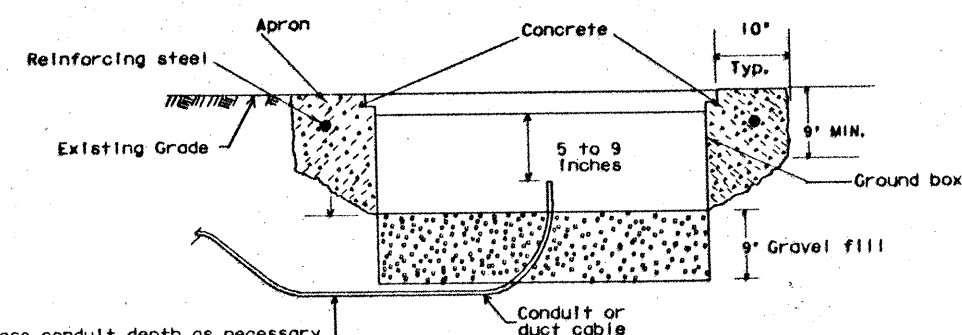

SECTION

APRON FOR GROUND BOXES
(Where required by plan note)

		STATE DEPARTMENT OF HIGHWAYS AND PUBLIC TRANSPORTATION			
		ROADWAY ILLUMINATION DETAILS			
		RID (4)-88			
DRAWING	DATE	FED. RD. DIST. NO.	STATE	FEDERAL AID PROJECT NO.	SHEET NO.
ORIGINAL	1-88	6	TEXAS	HE5 0005 (606)	40
REVISED	3-88				
REVISED	4-89				
REVISED	8-89	16	NUECES	0074 06 164	US181

- 8-89 Reduced to 34" Sheet.
- 8-89 Clarified note K-1.
- 8-89 Modified apron, specified anchor.

40

III C.

- All conduit entering ground boxes and pole bases and used to carry individual conductors shall be furnished with bell end fittings or bushings. Metallic conduit shall be fitted with grounding strap and bonding jumper. Jumper shall be tied to nearest ground rod or grounding conductor.
- Where called for on plans, the conduit shall be placed on a 2-inch sand cushion and backfilled with a minimum of 6-inch sand fill.
- Conduits entering ground boxes shall be placed so that the conduit ends shall be not less than 5 inches nor more than 9 inches from the box cover (see ground box detail).

D. Electrical Conductor

- A non-metallic pull rope shall be used in pulling conductor in non-metallic conduit.
- After installation and prior to connecting ends, each continuous run of insulated conductor shall have a minimum D.C. insulation resistance of one megohm when tested at 1000 volts D.C. All or part of conductor system may be tested by the Engineer. Conductors exhibiting an insulation resistance of less than one megohm shall be replaced by the Contractor at his own expense.
- After conductor is placed in conduit, a pull test will be made on conductors. Any length of conductor that cannot be pulled easily will be replaced by the Contractor at his expense.
- Conductors shall be supported by a J-hook in top of illumination poles.
- A minimum length of 3 feet of conductor shall be left in ground boxes and pole bases for making up connections.

E. Duct Cable


- Duct cable shall be placed by the open trench method, except where otherwise noted, at a depth of 18 inches unless otherwise indicated. Bends in duct cable shall be made in the manner recommended by the manufacturer. Minimum bending radii shall be as follows:
1-inch duct : 15 inches R.
1-1/4 inch duct : 18 inches R.

Handling of duct cable reels and installation of duct shall be as recommended by the manufacturer. Duct entering ground boxes shall be placed so that the duct ends shall be not less than 5 inches nor more than 9 inches from the box cover.

- All ducts entering ground boxes shall be securely lashed together in vertical position. After duct cable has been installed, a pull test will be made on conductors. If conductors cannot be easily pulled, Contractor shall replace or otherwise adjust installation to free up the conductors. Duct cable ends shall be sealed with approved compound after pull test is completed.
- Where noted on plans duct cable shall be placed on a 2-inch sand cushion and backfilled with a minimum 6 inches of sand.

F. Bonding and Grounding

- The Contractor shall insure that all exposed metal containing electrical conductors is banded and grounded, using ground rods, grounding bushings, locknuts, and other fittings as necessary.
- Metallic conduit, lighting poles, and luminaires on bridge structures shall be grounded. Each structure shall have at least one 5/8-inch x 8 foot copper-clad ground rod driven in the ground and a No. 8 AWG copper bonding jumper shall be installed from the ground rod to the grounding conductor of the lighting circuit.
- The bonding jumper shall be bare or, if insulated, shall be green. Ground rods, connectors, and bonding jumpers will not be paid for separately, but will be subsidiary to the various bid items.

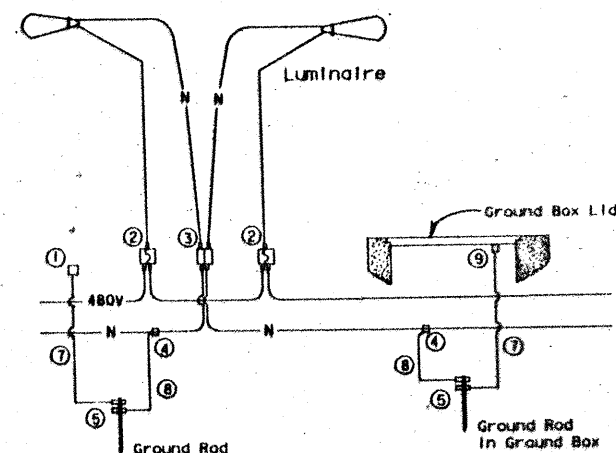

△ TWO WIRE CIRCUIT-OUTSIDE GROUNDED
LUMINAIRES SERVED AT 480V
TYPE B (MOD) SERVICE


NOTES:

- Pole Bonding Connector-Blackburn #TTC3 or Weaver #TGC3 or equal.
- Fused Connector-Homac, Bussman HEB, HEX, or equal.
- Un-fused Connector-Homac, Bussman HEB, HEX, or equal.
- Split Bolt Connector.
- Ground Rod Clamp - 2 Required - Blackburn GG58H Burndy GKP635 or equal.
- All fuses shall be time-delay types, 10 Amp (Littelfuse FLO, Bussman FNQ or equal)
- Bonding Jumper (Insulated, Green, XHHW)
- Grounding Conductor (Insulated, White, XHHW)
- Grounding Lug

*For Transformer Base Poles. On Shoe Base Poles, omit un-fused connector for neutral conductor.

G. Connectors and Splices


- Splices, in locations permitted by the Engineer, shall be made with approved compression sleeves or split bolt connectors insulated with heavy-wall heat shrink tubing containing factory-applied sealant or approved waterproof mechanical splice kit (Homac "Flood Seal"). Heat shrink sleeves shall lap conductor insulation a minimum of 2 inches on both sides of the splice. If split bolt connectors are used, connectors shall be covered with two half-lap layers of rubber tape before insulation is applied.
- When approved by the Engineer, wire nuts may be used for No. 8 and smaller conductors in above ground junction boxes but not in pole bases or ground boxes. Wire nuts shall be positioned upright to prevent the accumulation of water.

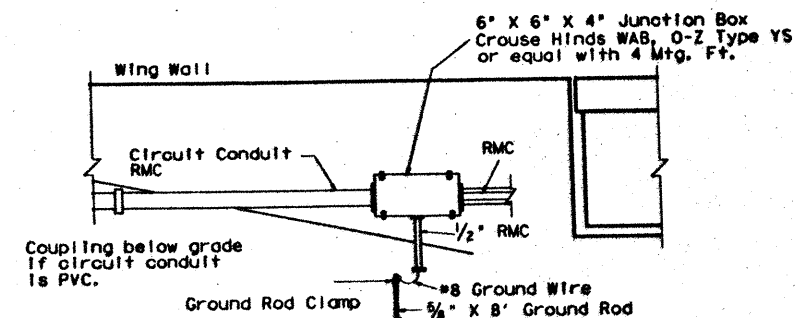

NOTES

- Conduit shall be 2" RMC for duct cable entry to junction box.
- Ground rod clamp to be Blackburn GG 5/8H, Weaver W5/8 or equal.
- All conduit entering junction box shall have locknuts and bushings. Conduit for ground wire shall have grounding type bushing.
- For conduit to be placed in structure use flush-mounted box, Crouse Hinds WEB, O-Z Type YU or equal.

CONDUIT ENTRY TO BRIDGE STRUCTURE DETAIL

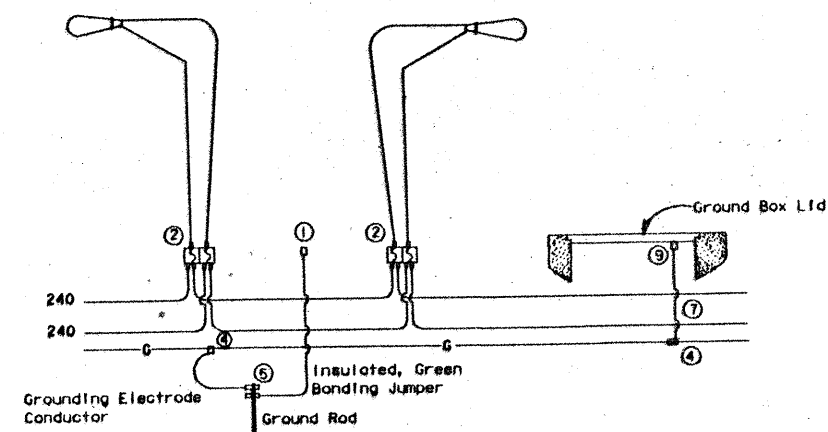

△ FOR THREE-WIRE CIRCUIT-CENTER GROUNDED
LUMINAIRES SERVED AT 480V
TYPE A 240V/480V SERVICE




The seal appearing on this document was authorized by F. Ray Mink, P.E. 29647, on 4/12/89.


F. Ray Mink, P.E.

- △ 11-90 Ground Box Diagram Added to Show Bonding and Grounding of 480V Two Wire Branches with Ground Rod Installed
- △ 8-89 Reduced to 34" Sheet.


STATE DEPARTMENT OF HIGHWAYS AND PUBLIC TRANSPORTATION		ROADWAY ILLUMINATION DETAILS		RID (5)-88 (MOD)	
DRAWING	DATE	FED. RD. DIST. NO.	STATE	FEDERAL AID PROJECT NO.	SHEET NO.
ORIGINAL	1-88	6	TEXAS	HES0005(606)	41
REVISED	3-89				
REVISED	8-89				
REVISED		16	NUECES	0074 006 164	US181

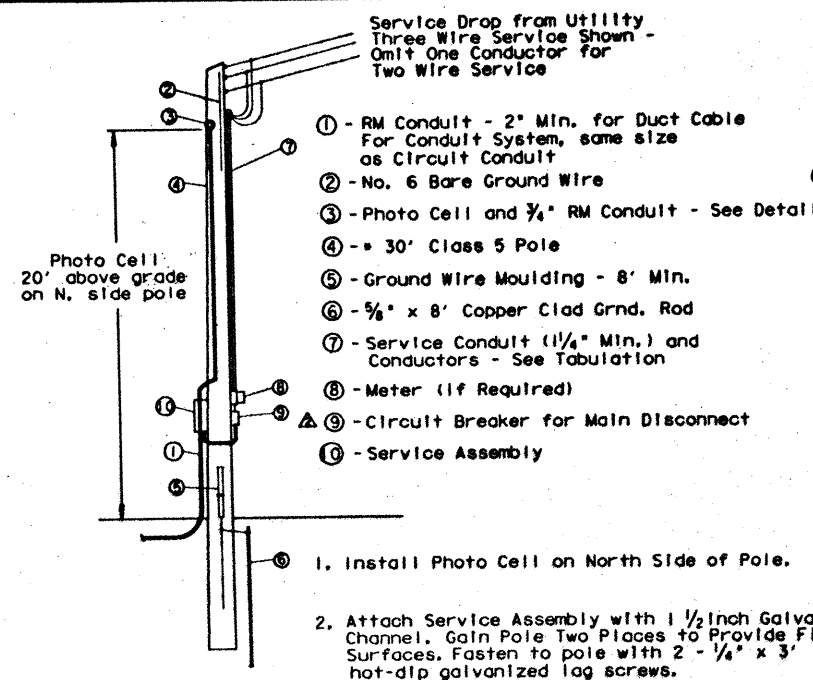


TYPICAL SERVICE POLE
See Service Pole Schematic For Types.
See SL(1)MOD

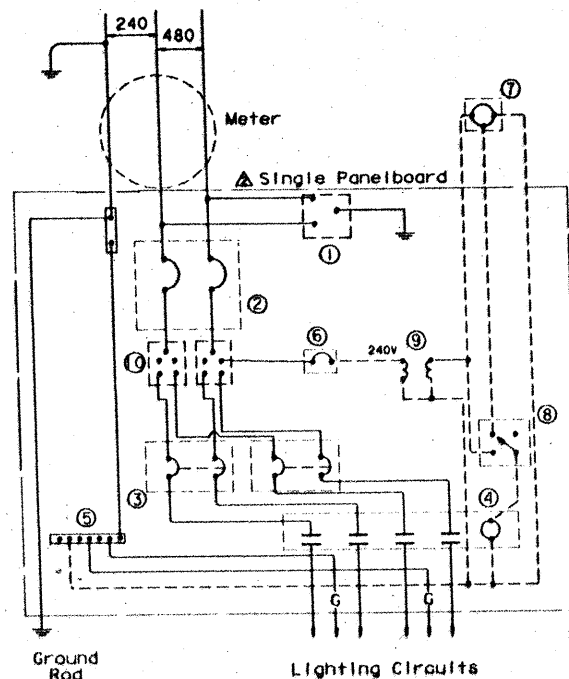

SERVICE POLE TYPE A
240 / 480 VOLTS - THREE WIRE BRANCHES

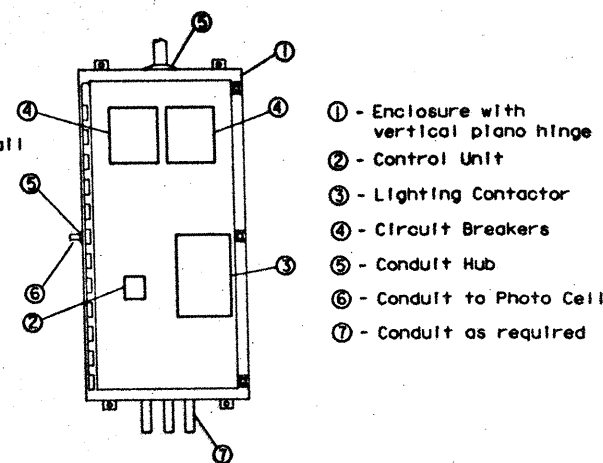


SERVICE ASSEMBLY DETAIL

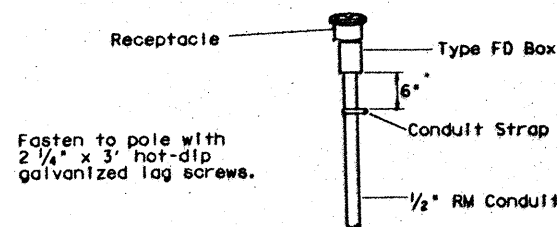

**DETAIL
PHOTO CELL MOUNTING**

- 1 Lightning Arrestor - In Enclosure
- 2 Circuit Breaker - Main Disconnect
- 3 Circuit Breaker - For Individual Circuits
- 4 Lighting Contactor
- 5 Factory-made Neutral Bus
- 6 Circuit Breaker - 15A for Control Circuit
- 7 Photo-Electric Control - 100 to 285V
- 8 Control Unit - "Manual-Off-Automatic"
- 9 Control Transformer - 480V:120V, 0.5KVA For Type B(MOD).
240V:120V, 0.5KVA For Type A Service.
- 10 Distribution Block

Power Wiring
Control Wiring

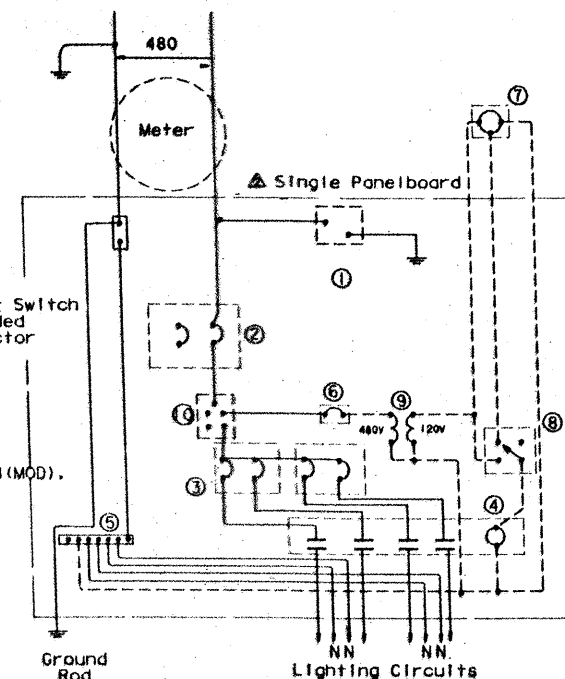

SERVICE POLE TYPE B (MOD)
480 VOLTS - TWO WIRE BRANCHES

GENERAL NOTES:

SERVICE POLE AND CIRCUIT PROTECTOR ASSEMBLY

1. **Service Assembly Enclosure.** NEMA 4X enclosure consisting of enclosure with drip shield and conversion hardware, constructed of fiberglass with piano hinge and resilient gasket. Door held with clamps with provisions for padlock. Equipment-mounting panelboard shall be 12-gauge stainless steel. Each enclosure shall be supplied with one rigid vinyl or plastic accident prevention tag with the message, "DO NOT THROW SWITCH MEN AT WORK ON CIRCUIT".
2. **Lighting Contactor.** NEMA 4X, electrically-held, of type designed to control tungsten, mercury vapor and other lighting loads, Square D Class 8903 Type S, Allen Bradley 702L or approved equal.
3. **Control Unit.** Standard duty 3-position (Auto-Manual-Off) control station in NEMA 1 enclosure.
4. **Photo-Electric Control.** Dry-type hermetically sealed cadmium sulfide cell, expulsion arrester and electro-mechanical relay, mounted in weatherproof plastic housing having twist-lock base. Turn-on range of 0.5 to 5 footcandles, factory-set at 1 1/2 footcandle. Turn-off 2 footcandles higher than turn-on. Voltage range 100 to 285. Control circuit to be protected by a 15A circuit breaker. Breakers for a two-wire 480V system shall be rated 480V, for a three-wire center-grounded 240/480V system shall be rated 277/480 volts.
5. **Lightning Arrestor.** Valve-type, 0-650 volt with bracket for enclosure mounting.
6. **Circuit Breakers** for a three-wire center-grounded 240/480 service shall be rated 277/480 volts. Circuit breakers for a two-wire 480 volt system shall be rated 480 volts, and shall control only one circuit. Circuit breakers for 120/240 volt systems shall be rated 240 volts.
7. **Circuit Breaker for Main Disconnect** shall be heavy-duty type, two-pole, rated 480 volts with a solid neutral assembly mounted in the NEMA 4X enclosure. Circuit breakers for 240 volt systems shall be the same except rated 120/240 volts.
8. **Metering.** Where metering is required, utility company will provide the meter base. Contractor shall install the base. Some utility companies require the meter base to be installed on the load side of the safety switch. Contractor shall consult with the utility company before making up the service poles.
9. **Circuit Protector Assemblies** shall be similar to Service Pole Assemblies except that SDHPT wood pole is existing at the designated locations shown on plan sheet. Circuit Protector Assemblies for service poles shall consist of disconnecting & removing existing equipment and replacing with the specified equipment. All salvagable electrical equipment will become the property of the Texas Department of Highways and Public Transportation.
10. The Contractor shall be responsible for paying all costs involved in obtaining power, except that the costs incurred in extending primary line to service pole location will be paid for separately.

SERVICE POLES & CIRCUIT PROTECTOR ASSEMBLIES

Circuit Protector Designation	Service Pole Designation	Type	Service Conduit Size	Service Conductors No./Size	Main Circuit Breaker Amps	Contactor Poles/Amps	Circuit No.	Circuit Breakers	KVA Load
EXIST.	1	A							
EXIST.	2	A							
EXIST.	3	A							




The seal appearing on
this document was
authorized by
F. Ray Mine,
P.E. 29647, on
4/22, 1976.
F. Ray Mine, P.E.

STATE DEPARTMENT OF HIGHWAYS
AND PUBLIC TRANSPORTATION
ROADWAY ILLUMINATION DETAILS
RID (6)-88
DIST.-16 STANDARD


NO.	DRAWING	DATE	FED. ROAD DIST. NO.	STATE	FEDERAL AID PROJECT NO.	SHEET NO.
CK DN	ORIGINAL	1-88	6	TEXAS	HES0005(606)	42
CV	REVISED	8-88				
TR	REVISED	4-89				
TR	REVISED	8-89				
TR	DIST. 16	9-90	16	MUJES	0074 006 164	US181

- △ 8-90 Modifications for existing 480V
2-wire branch system.
- △ 8-90 District-16 Standards
- △ 8-89 Reduced to 34" Sheet.

42

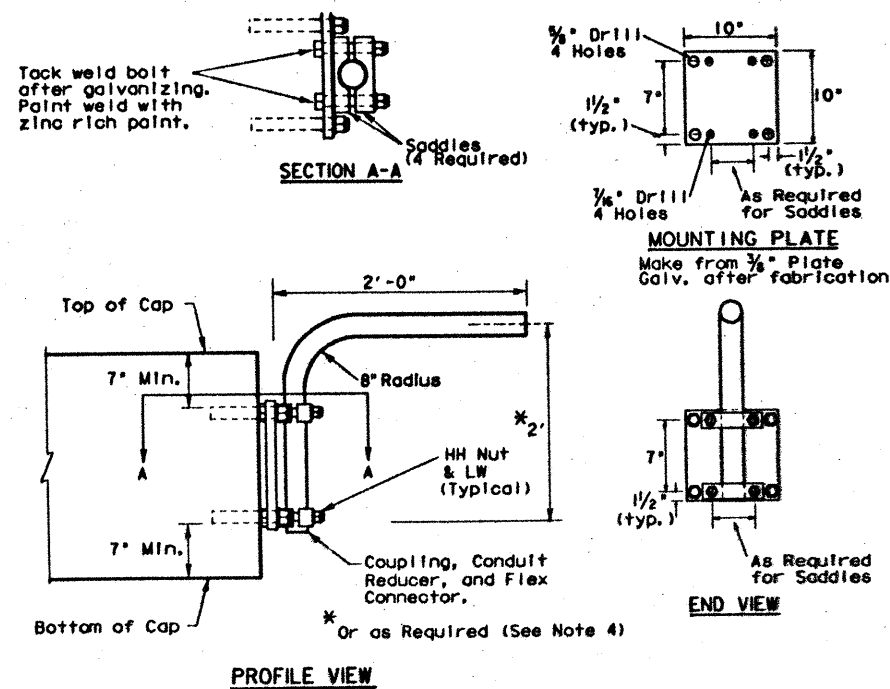

UNDERPASS LIGHTING ARM TYPE 1

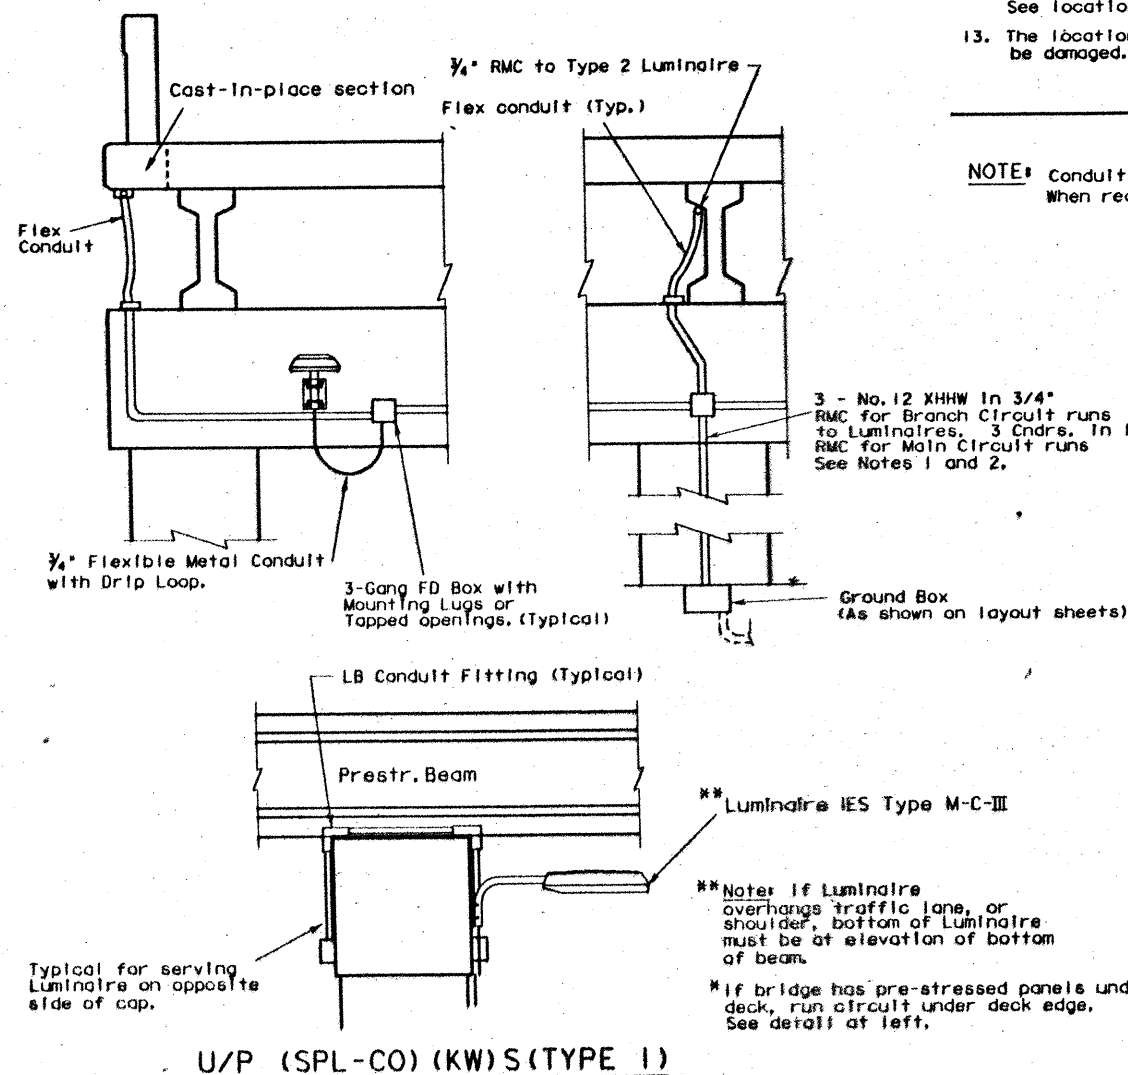

U/P (SPL-CO) (KW) S (TYPE 1)

NOTES:

ALL LUMINAIRES

1. Luminaire locations, conduit and conductor sizes and routing are typical and diagrammatic only. See project layout sheets for specific details.
2. All No. 12 Conductors and 3/4" conduit necessary for installation of U/P lights shall not be paid for directly but shall be considered subsidiary to the various bid items. All larger conductors and conduit will be paid for under the items "Conduit" and "Electrical Conductor." See lighting layout sheets.
3. A ground rod shall be installed and attached to the equipment grounding conductor in all ground boxes containing conduit that extends above ground. All RMC in these boxes shall have grounding bushings and shall be properly bonded.
4. Adjust conduit in saddles to place fixture height and orientation as required. See fixture orientation detail and layout sheet. Where traffic is likely to pass under luminaires, place luminaires so that bottom of luminaire is above bottom of beam, maximum of 3 inches.
5. All bolts, nuts and washers shall be galvanized.
6. Fabrication of brackets will not be paid for directly but shall be subsidiary to Item 610, Rwy Illum Assemblies.


TYPE 1

7. Type 1 arm shaft - 1-1/2" rigid metal conduit (1.90" O.D., .145" wall).
8. Anchor bolts for Type 1 luminaire shall be 3/8 in. bolt or stud expansion anchors with min. pull out of 3000 lb pull out each, with 4 in. min. embedment. Provide lock washers.
9. Attach conduit to plate with 4 saddles, 4-3/8" bolts, HHN & LW.

TYPE 2

10. Reduce conduit length for Type C concrete beams. Field cutting and threading will be permitted.
11. Connecting conduit may be strapped to tapered section only of precast beams as shown. Anchor as approved by the Engineer. Maximum anchor depth is 1 inch.
12. Indiscriminate drilling into precast concrete beams may result in reduced beam strength. Drilling location shall be only as directed by Engineer. See location of underpass lighting mounting bracket detail.
13. The locations given in the table are such that reinforcing strands will not be damaged.

NOTE: Conduit on Columns, Caps, and Slab is shown surface mounted. When required by the Engineer, Contractor shall embed conduit.

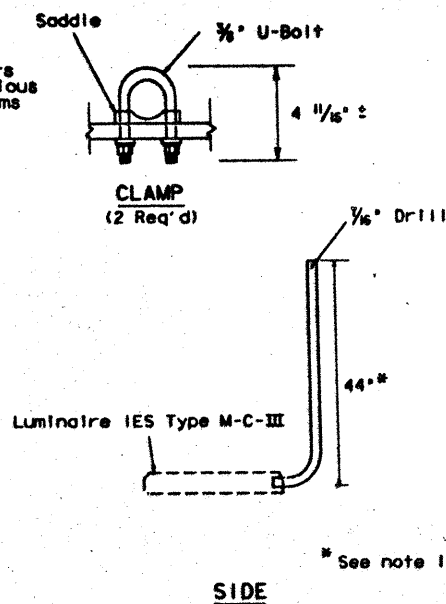


SIDE


UNDERPASS LIGHTING ARM TYPE 2

Bridge Span Length	Minimum Distance From Bent Cap to Fixture Mounting Arm
<50'	10'
50'-70'	15'
70'-90'	20'
>90'	25'


See detail below.

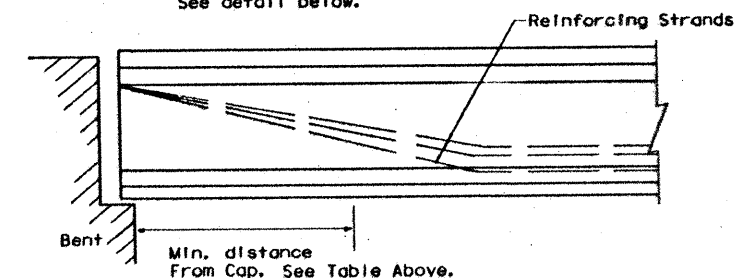


LOCATION OF UNDERPASS LIGHT MOUNTING BRACKET

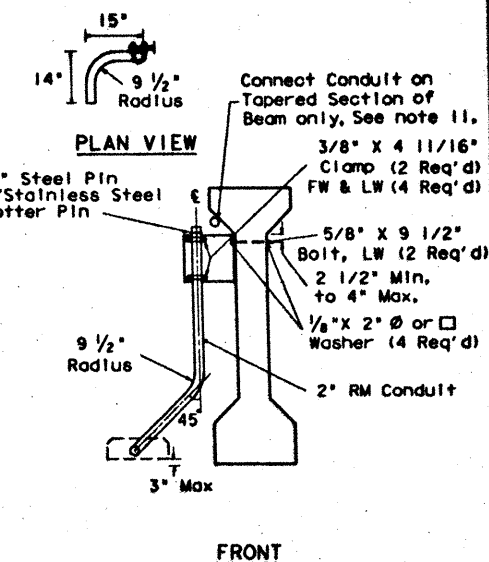


FRONT

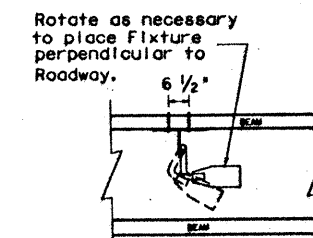


FIXTURE ORIENTATION

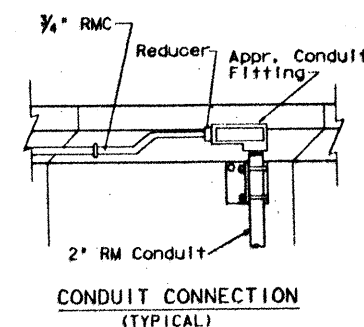


CONDUIT CONNECTION (TYPICAL)

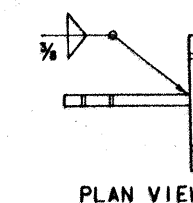

PLAN VIEW

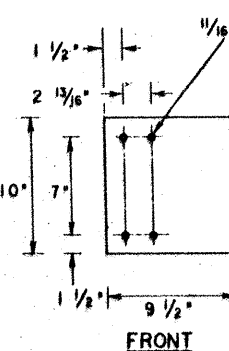

FRONT

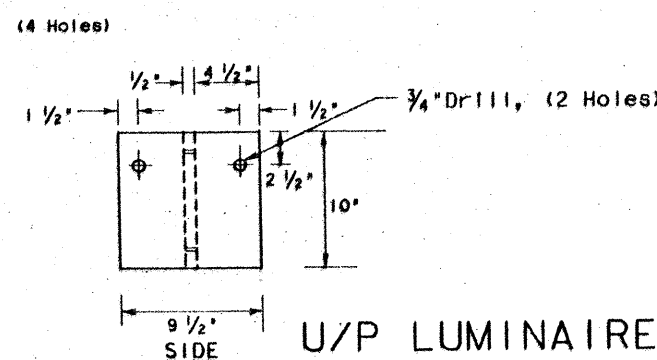

SIDE

BRACKET DETAIL

Make From 1/2" Plate (ASTM A-36) Galv. after fabrication

U/P (SPL-CO) (KW) (TYPE 2)

U/P LUMINAIRE DETAILS


STATE DEPARTMENT OF HIGHWAYS AND PUBLIC TRANSPORTATION
ROADWAY ILLUMINATION DETAIL
RID (7)-88

DRW. NO.	DATE	REV. NO.	STATE	FEDERAL AID PROJECT NO.	SHEET NO.


43

8-89 Reduced to 34" Sheet.


281RID7.016

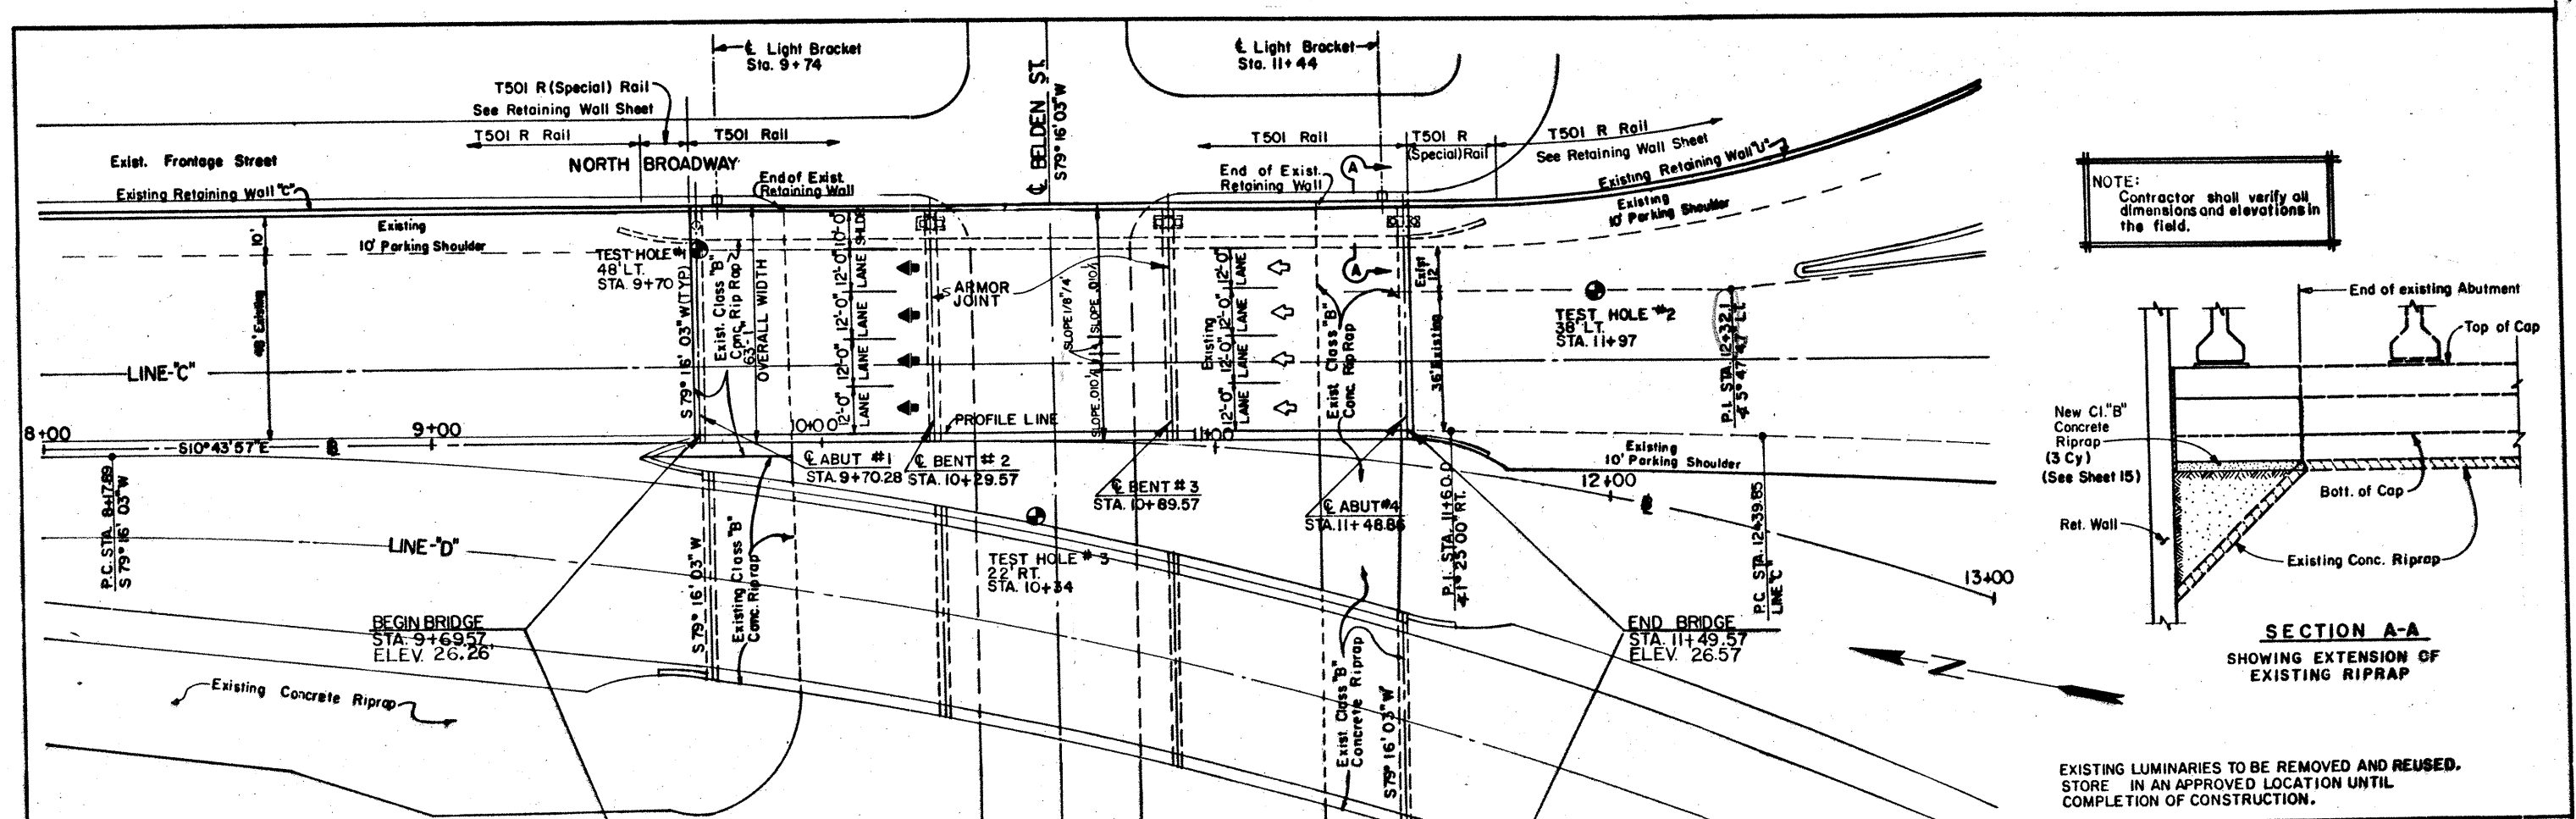

NOTE:
Contractor shall verify all dimensions and elevations in the field.

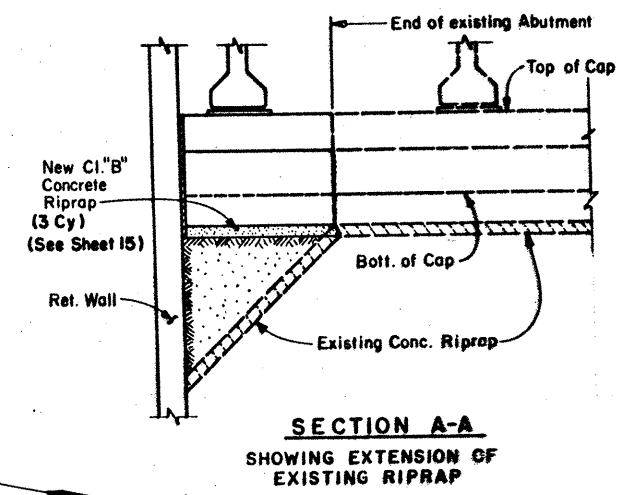

EXISTING LUMINARIES TO BE REMOVED AND REUSED.
STORE IN AN APPROVED LOCATION UNTIL COMPLETION OF CONSTRUCTION.

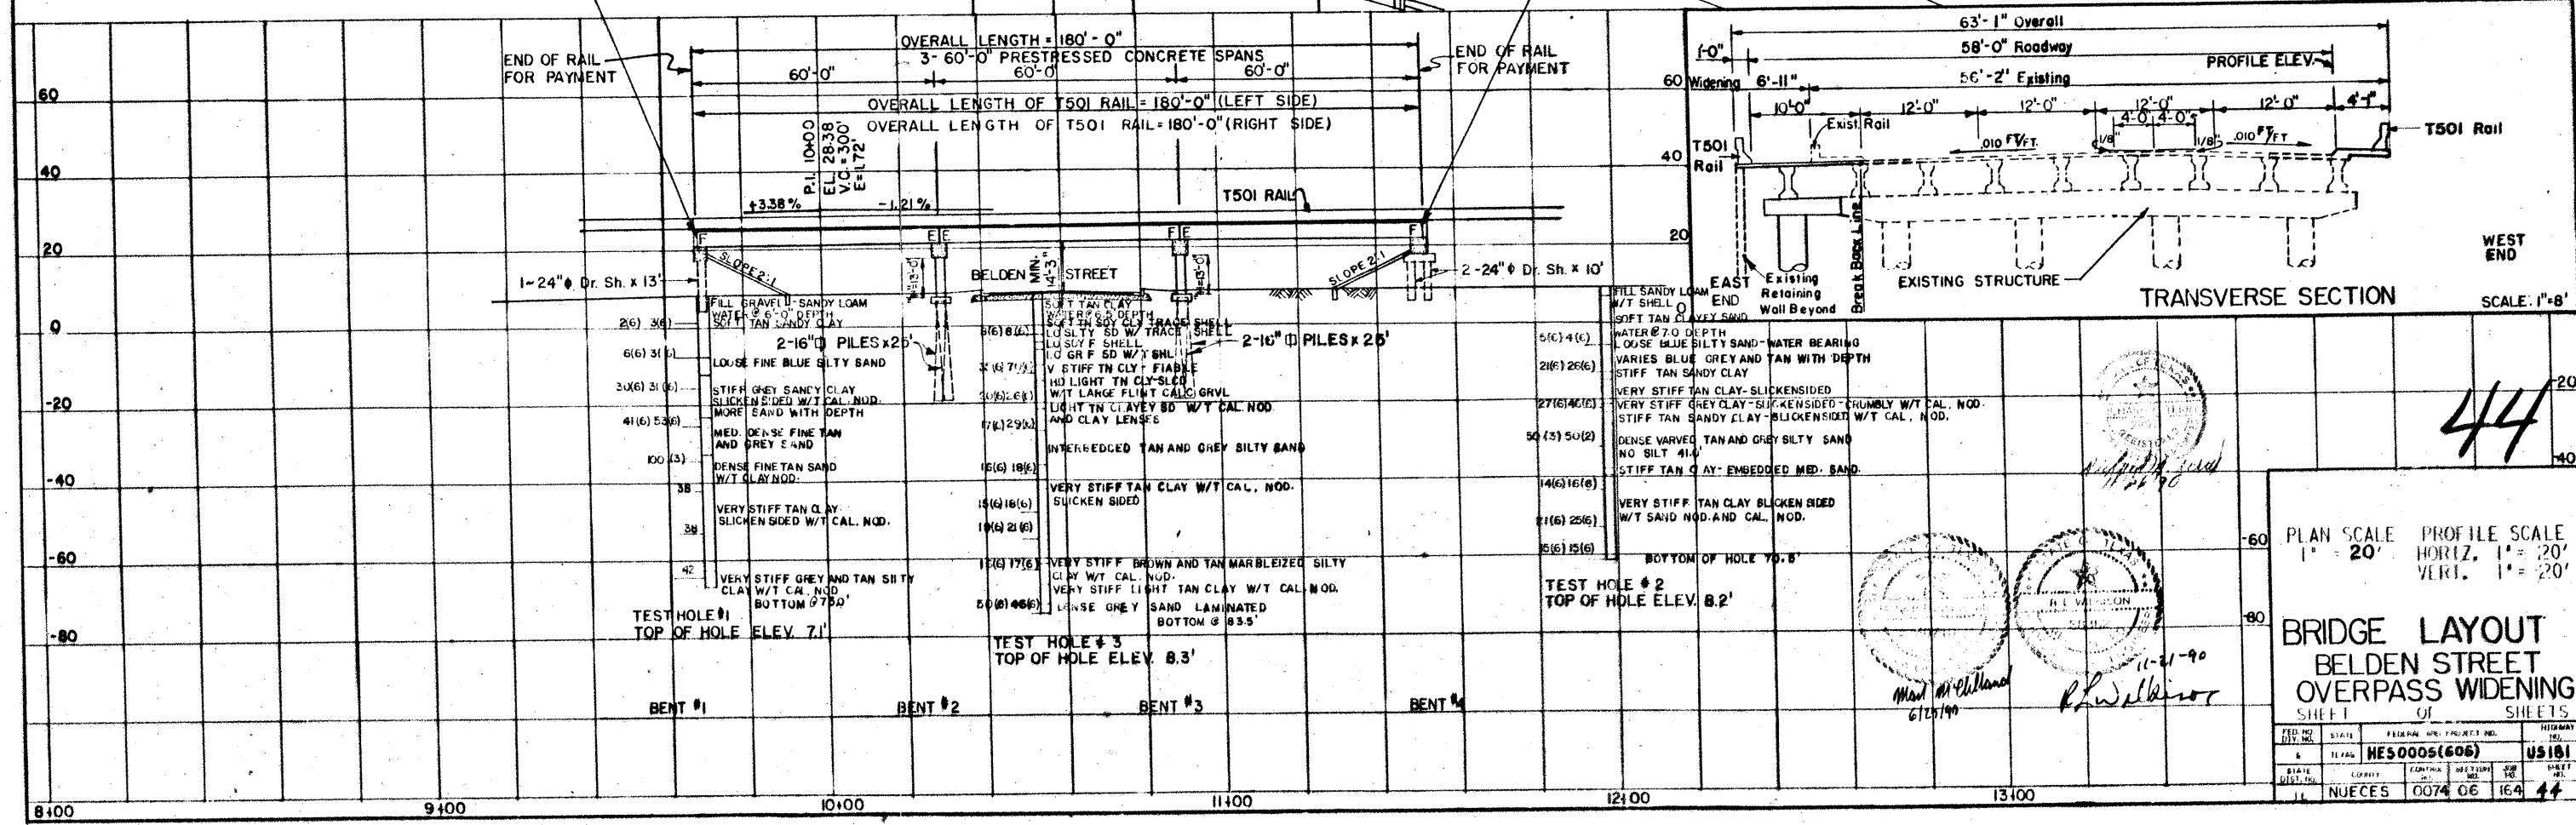

PLAN SCALE 1"=20'
PROFILE SCALE HORIZ. 1"=20' VERT. 1"=20'

BRIDGE LAYOUT
BELDEN STREET
OVERPASS WIDENING


PROJ. NO. 11-21-90
STATE OF TEXAS
COUNTY OF NUECES
PROJECT NO. 0074 06
SHEET NO. 44

SUMMARY OF ESTIMATED QUANTITIES

ITEM DESCRIPTION	Concrete Piling	Slurry Displacement Drilled Shafts	Class "C" Concrete (for Extending Struct.)		Reinf. Conc. Slab (for Ext. Struct.)	Prestr. Conc. Beam		Structural Steel	Structural Steel	Railing	Conduit PVC Sch 40 1 1/2" φ	RDW. ILL. ASM. (U/P TY I) (0.15 KW) S (SPL CO)	RELOC. RDWY. ILL. ASM. TRANS. BASE	ELEC. CONDR. (#6 BARE)	ELEC. CONDR. (#4)(TY-XHHW)
	16" Sq. L.F.	24" φ L.F.	Abutment C.Y.	Bent C.Y.	S.F.	(Type C) L.F.		(Arm. Jt.) Lbs.	(HYC) Lbs.	(Type T501) L.F.	L.F.	EA.	EA.	LF.	LF.
2 ~ Abutments		33	4.1												
2 ~ Interior Bents	100			14.0								2			
3 ~ 60'-0" Prestr. Conc. Bm. Spans					2592	178.43		940		360.0	242			242	494
2 ~ Bridge Lighting Brackets									90		8		2	8	16
TOTAL	100	33	4.1	14.0	2592	178.43		940	90	360.0	250	2	2	250	500

BEARING SEAT ELEVATIONS

	BEAM 1
BENT 1 (FWD)	22.0860
	BEAM 1
BENT 2 (BK)	22.7210
BENT 2 (FWD)	22.7299
	BEAM 1
BENT 3 (BK)	22.8316
BENT 3 (FWD)	22.8276
	BEAM 1
BENT 4 (BK)	22.3949


45
H 20 LOADING



R.E. Wilkison

REV. 2-8-91
REV. 12-31-90

STATE DEPARTMENT OF HIGHWAYS AND PUBLIC TRANSPORTATION	
ESTIMATED QUANTITIES AND BEARING SEAT ELEVATIONS	
BELDEN STREET OVERPASS WIDENING	
D45350A1 ZFA21355156142031AB01.DGN PREPARED BY AND FOR USE OF TEXAS SDH&PT	
DATE: APRIL 1990	REVISIONS
DR: RAC	16 6 HES0005(606)
CR: JIM	COUNTY: COUNTY
BY: JAC	NOTES: 0674 06 164 05181

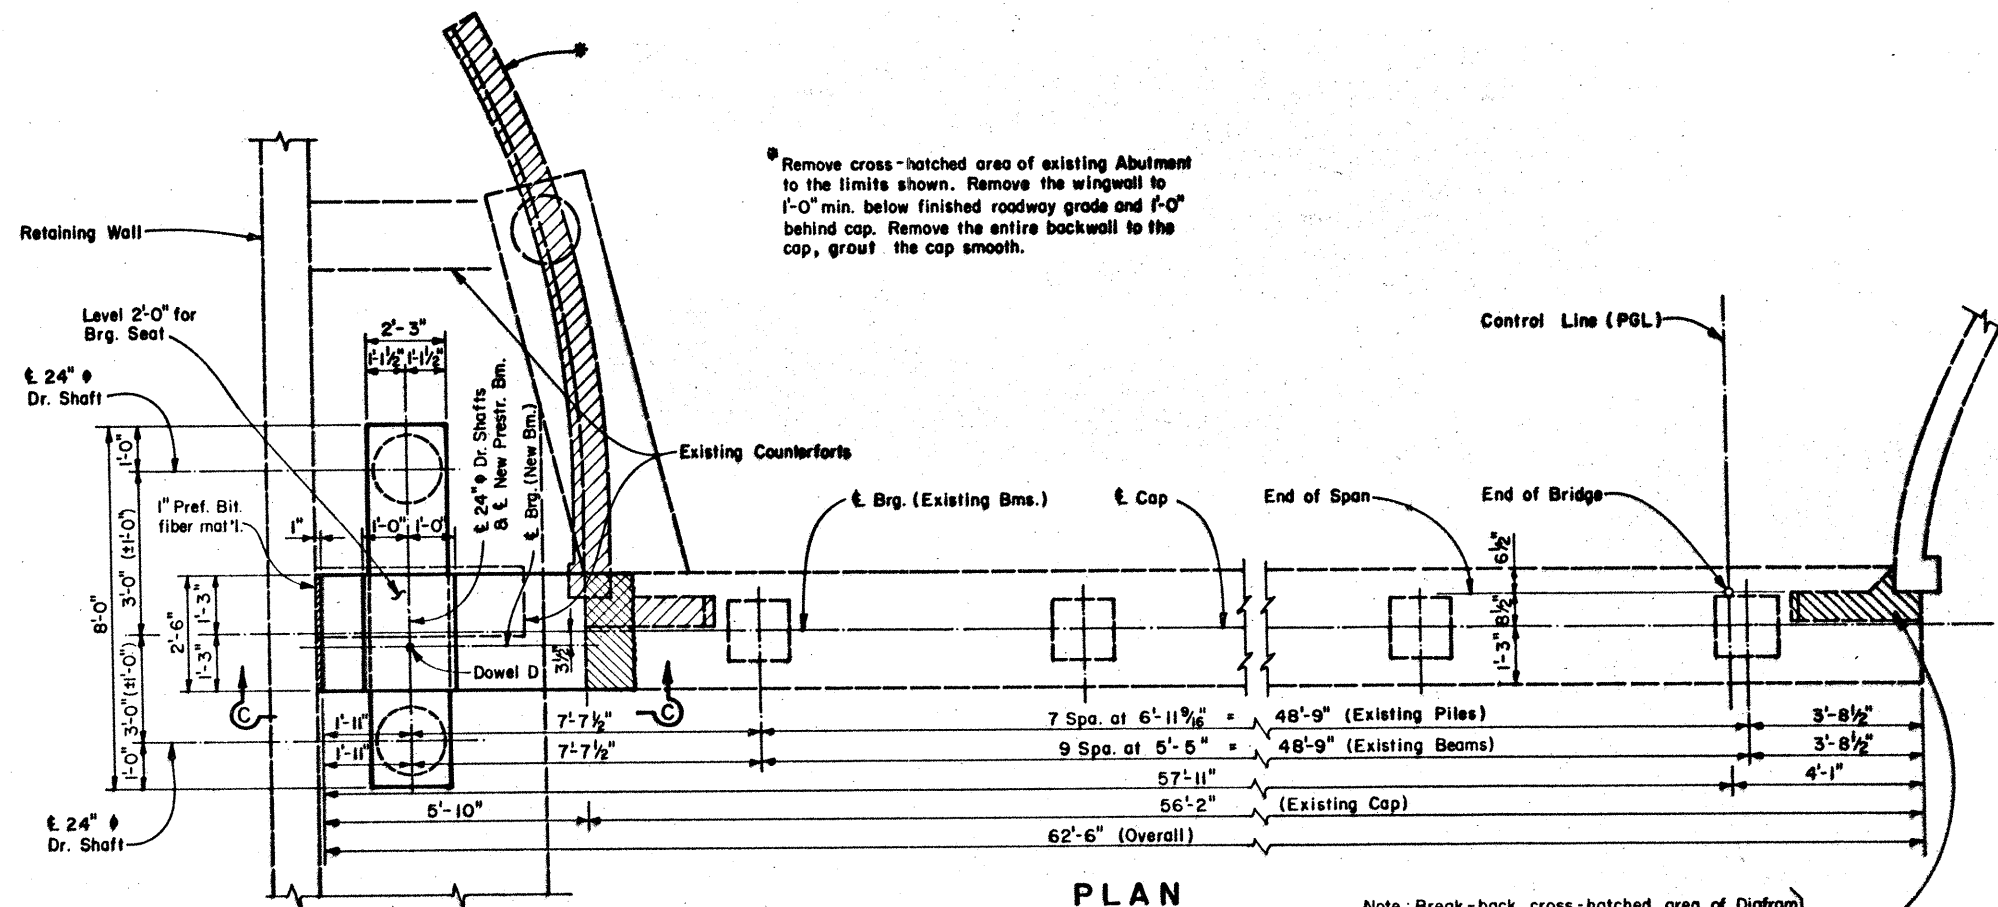

Note: Break-back cross-hatched area of Diaphragm Wall. Clean and bend existing reinf. steel down into new construction. Recast 2" of concrete. Place 1/4" Expansion Jt. Mat'l. between Diaphragm and Slab.






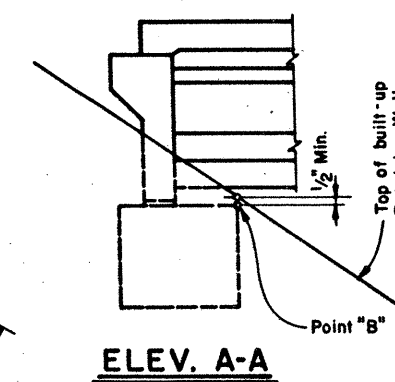


TABLE OF ESTIMATED QUANTITIES				
Bar	No.	Size	Length	Weight
A1	3	#10	5'-10"	75
A2	2	#11	5'-10"	62
A3	1	#10	6'-6"	28
B	6	#11	7'-8"	244
D	1	1 1/2"	1'-6"	6
J	4	#9	4'-10"	66
S1	14	#5	6'-8"	97
S2	7	#4	9'-0"	42
Reinforcing Steel			Lb.	620
Cl. "C" Conc. for Ext. Strs.			C.Y.	2.7

For Contractor's information only.

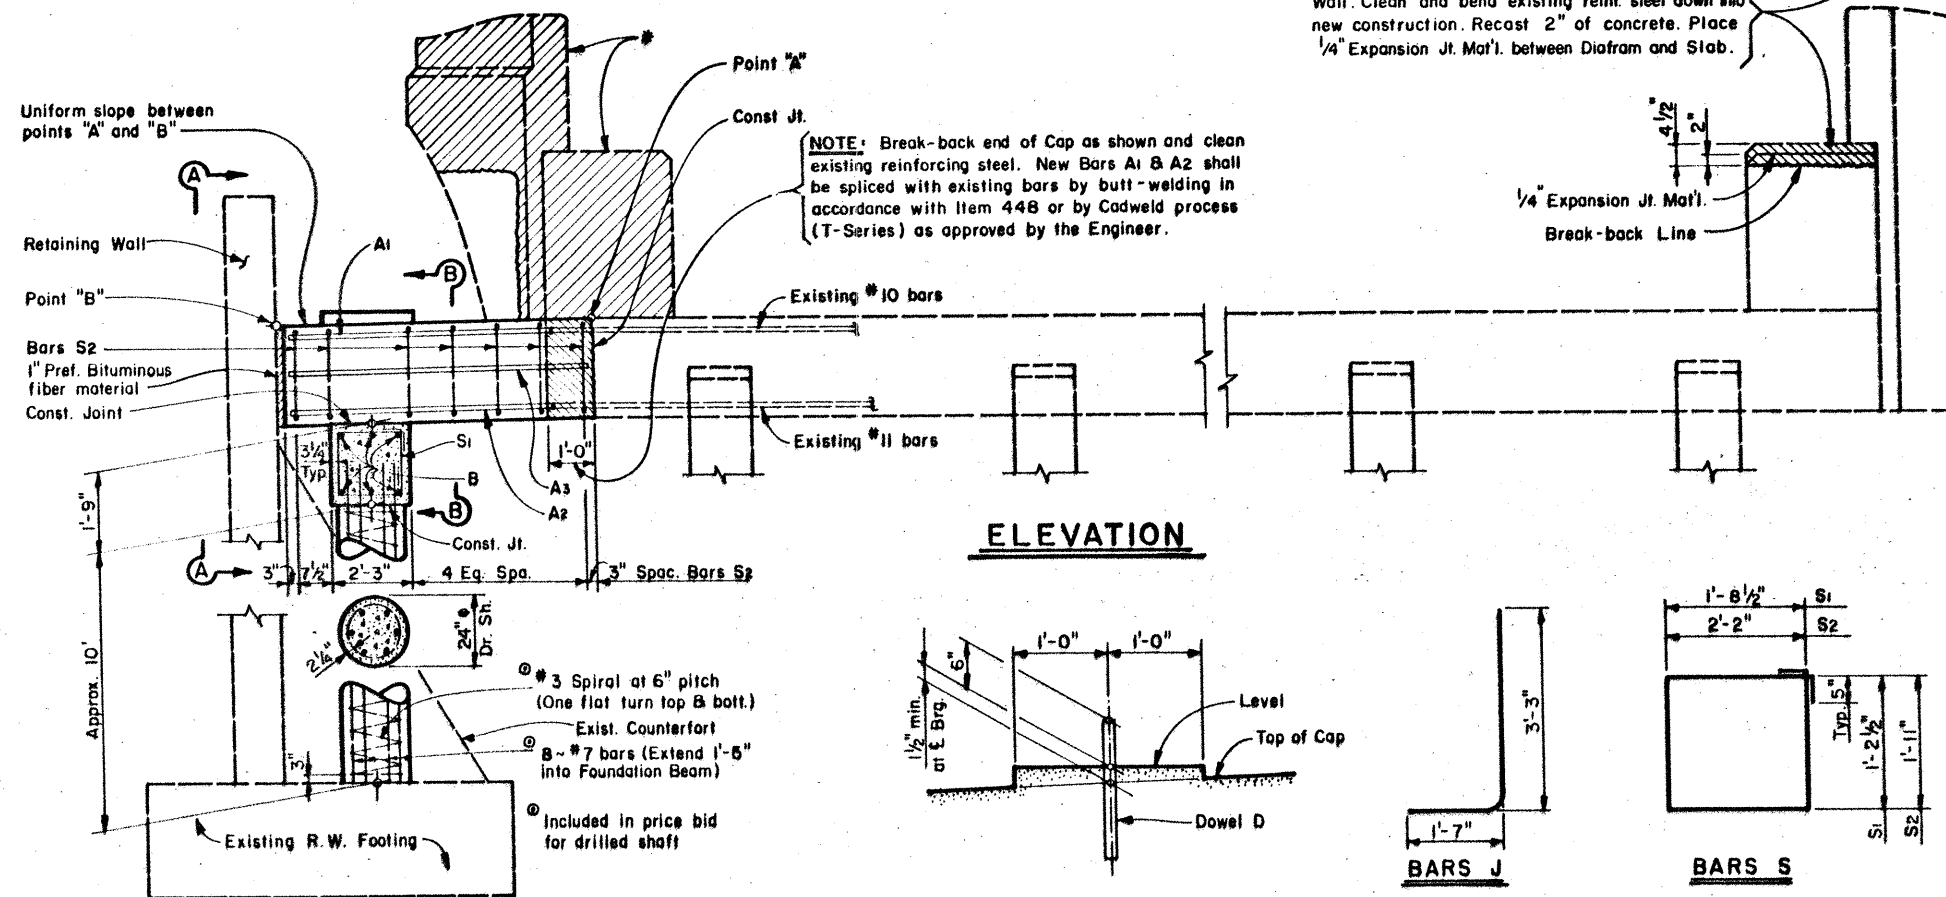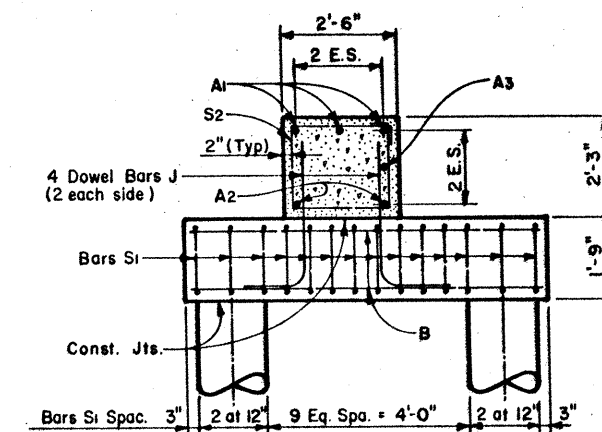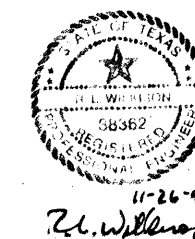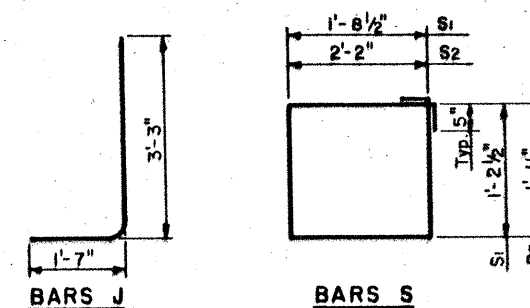

GENERAL NOTES:
 Designed in accordance with A.A.S.H.T.O. 1989 Standard Specifications.
 Calculated Shaft Load = 25 Tons/shaft.
 Care shall be taken to prevent damage to existing footing while drilling shafts. Shafts may require casing. Top of footing shall be cleared of loose particles in order to assure good contact with new shaft concrete.

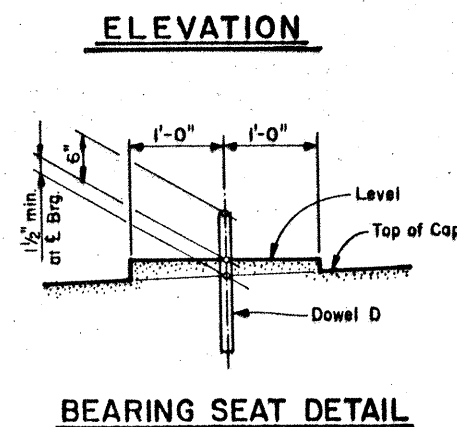

H2O LOADING











STATE DEPARTMENT OF HIGHWAYS AND PUBLIC TRANSPORTATION

ABUTMENT NO. 4

BELDEN STREET OVERPASS WIDENING


47

ORIGINAL DRAWING DATE	APRIL 1990	STATE	Texas	FEDERAL AID PROJECT	HE50005(606)	SHEET	47
DR	RAC	DATE	16	SECTION	74	FOR	164

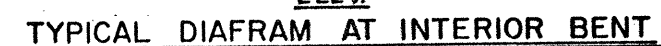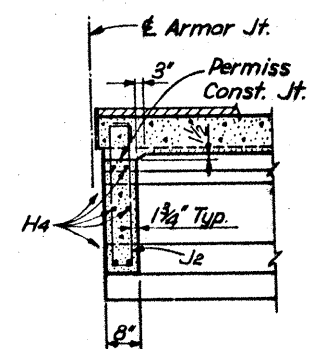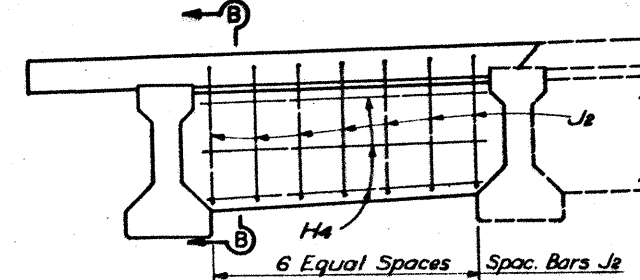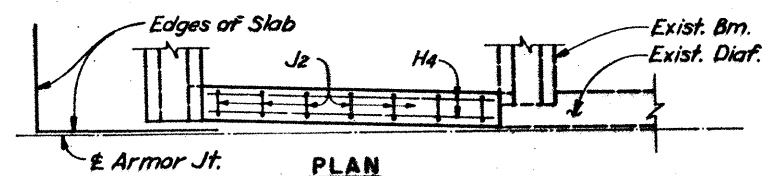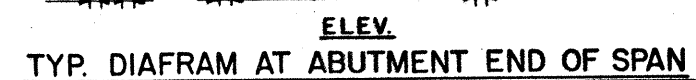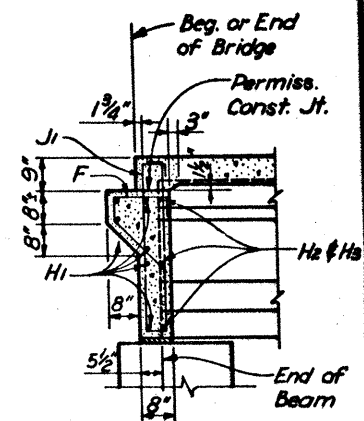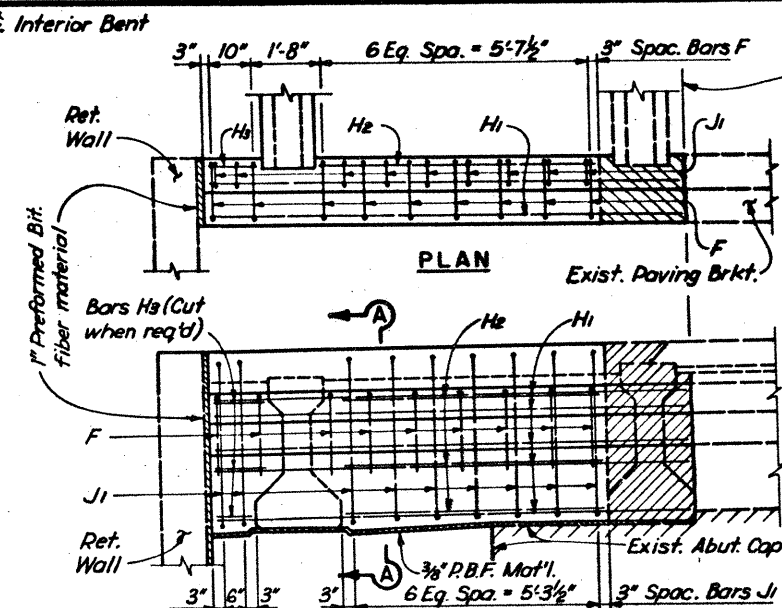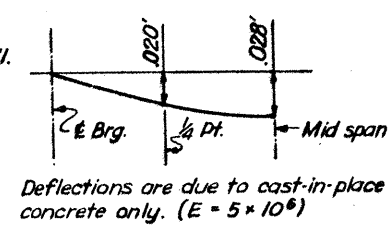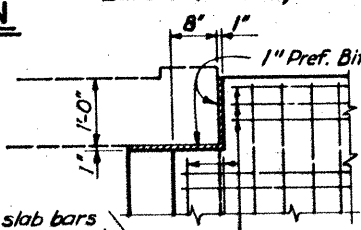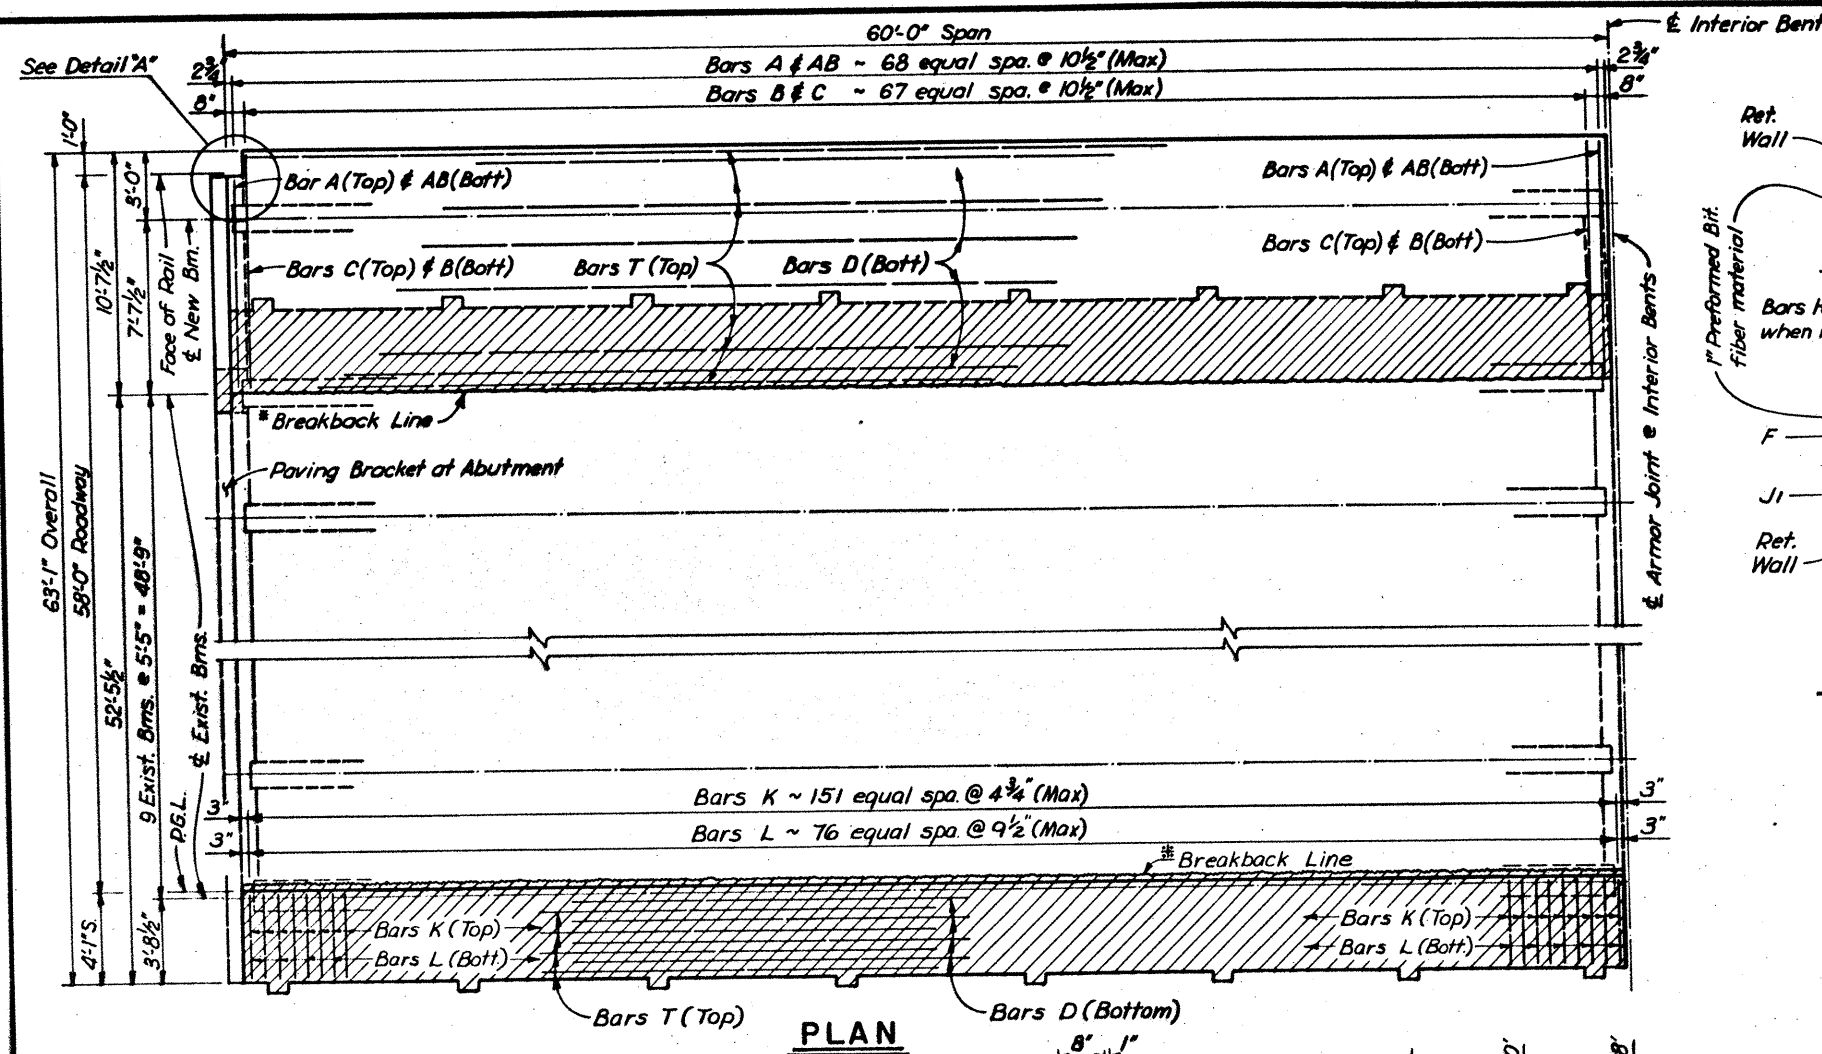

* Breakback existing concrete to & of existing outside beam. Clean and extend existing reinforcing steel 1'-6" Min. into new construction.

See Sheet 49-A (F.C.#1)

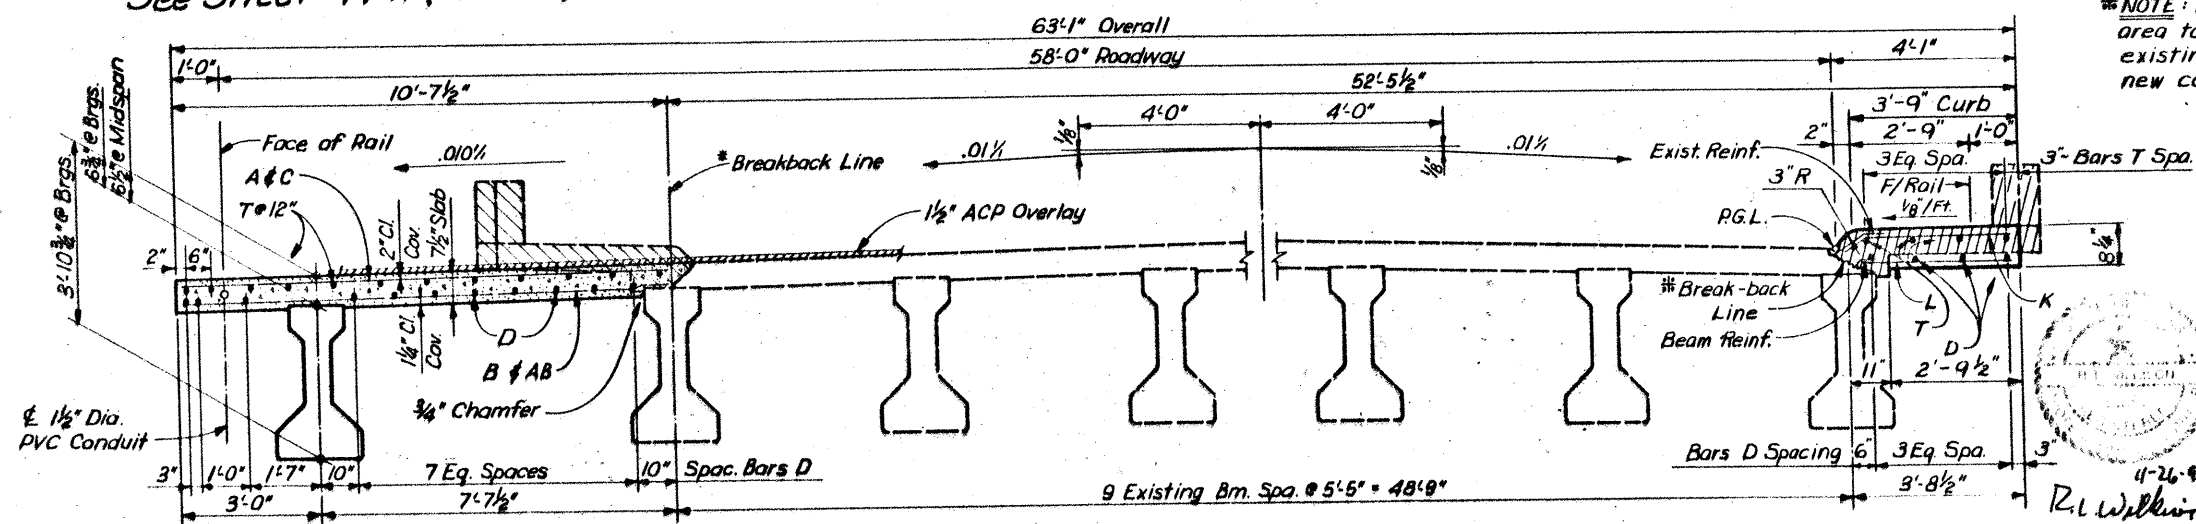

NOTE: Breakback existing cross-hatched area to breakback line. Clean and bend existing reinforcing steel 1'-6" min. into new construction.


49

H2O LOADING SHEET 1 OF 2

**STATE DEPARTMENT OF HIGHWAYS
AND PUBLIC TRANSPORTATION**

60'-0" PRESTRESSED
CONC. BEAM SPAN
BELDEN STREET OVERPASS
WIDENING



ORIGINAL DRAWING DATE		MARCH 1990.	STATE DISTRICT		FEDERAL REGION	FEDMAP AID PROJECT		SHEET NO.
REVISED			16		6	HE5000AS(806)		49
DRAWN BY		RAC /JCW			COUNTY	CONTRACT	SECTION	ROW
CHECKED BY		CEQ			NUECES	74	6	164
DATE		RNS						US18
SCALE		1"=1"						

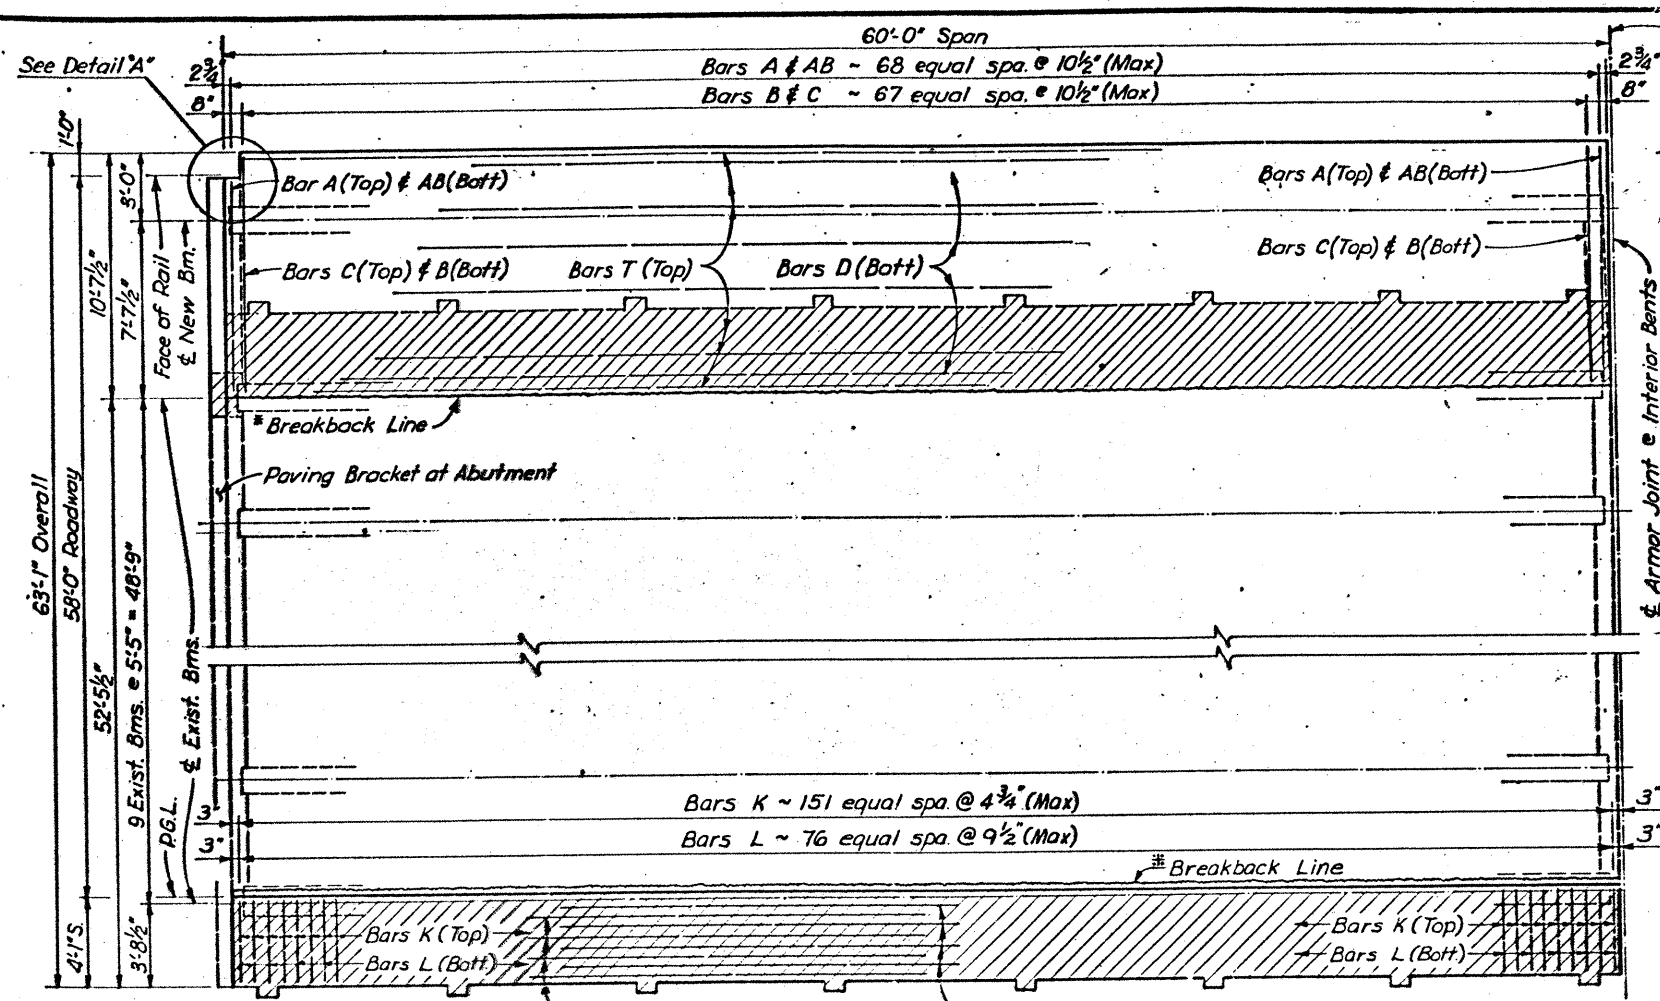





FIELD CHANGE No. 1 NOTES:

1. Reversed cross-slope of proposed slab widening.
2. Lap-weld bars A & C to existing bars A & B resulting in 13" bar spacing.
3. Bars A & C changed to Gr. 60 instead of Gr. 40 due to increased bar spacing.

* Breakback existing concrete to & of existing outside beam. Clean and extend existing reinforcing steel 1'-6" Min. into new construction.

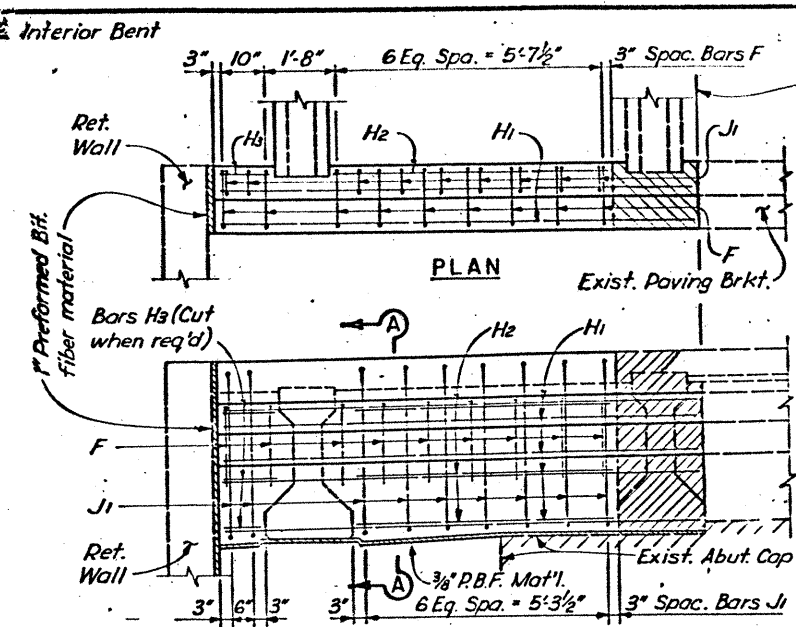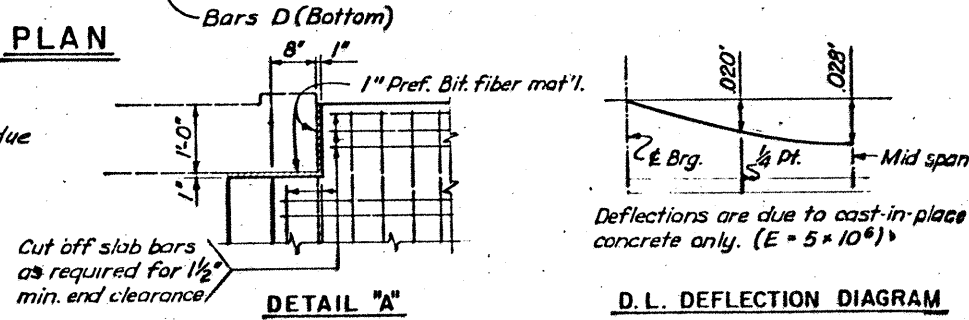

Breakback existing Diagram and Paving Bracket even with bottom flange of existing beam. Clean and extend reinforcing steel 1'-6" Min. into new construction.

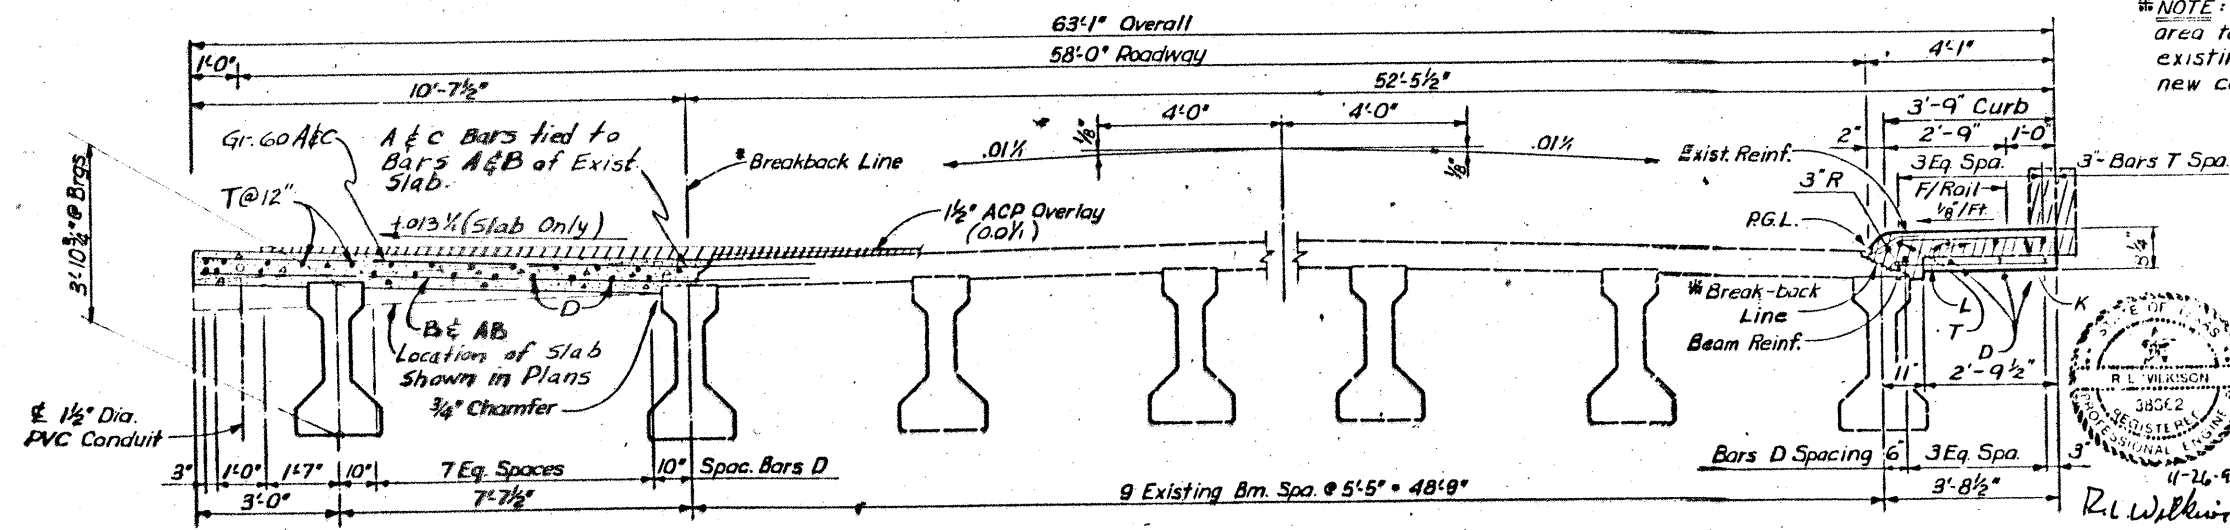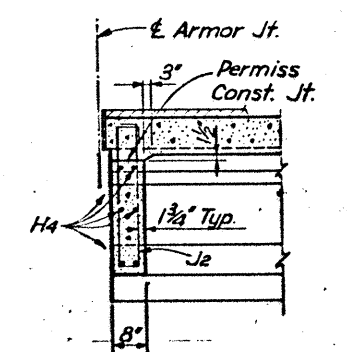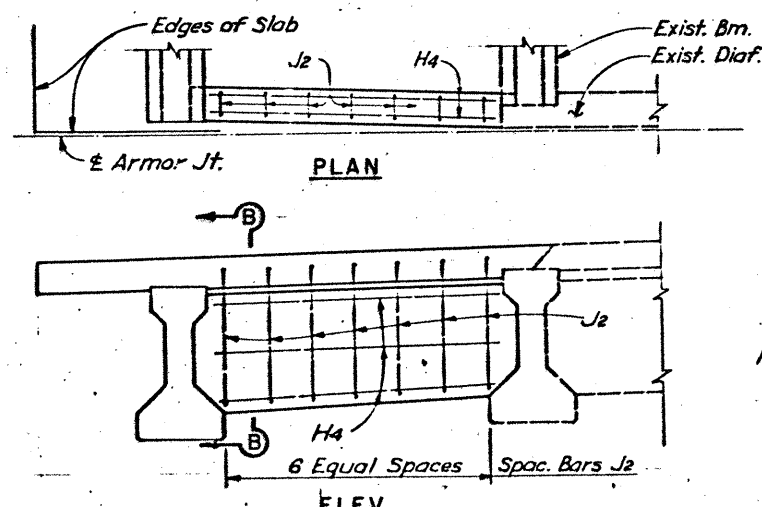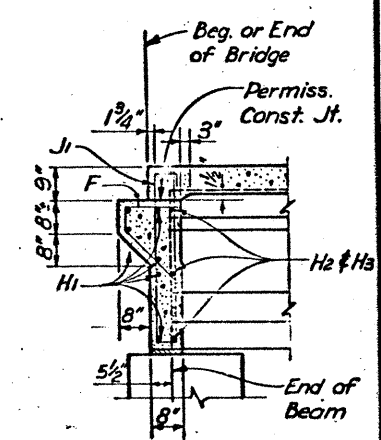

* NOTE: Breakback existing cross-hatched area to breakback line. Clean and bend existing reinforcing steel 1'-6" min into new construction.

TRANSVERSE SECTION

H2O LOADING SHEET 1 OF 2

STATE DEPARTMENT OF HIGHWAYS AND PUBLIC TRANSPORTATION

60'-0" PRESTRESSED CONC. BEAM SPAN


BELDEN STREET OVERPASS WIDENING

FIELD CHANGE No. 1


DATE: MARCH 1990



49A

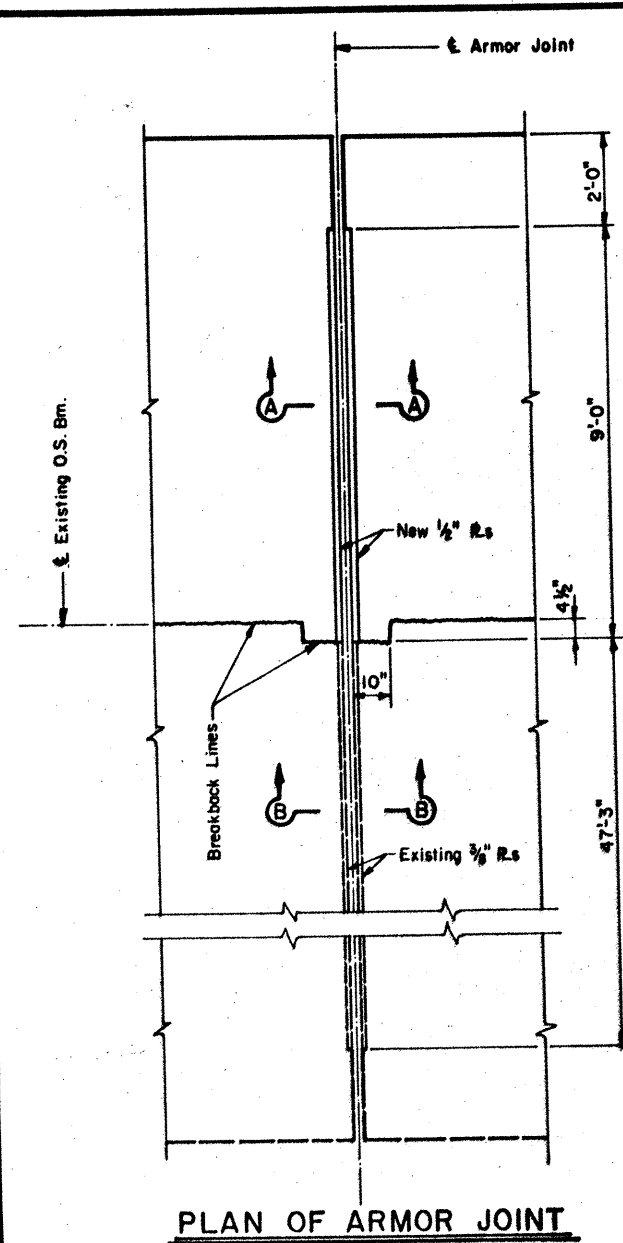


PLAN OF ARMOR JOINT

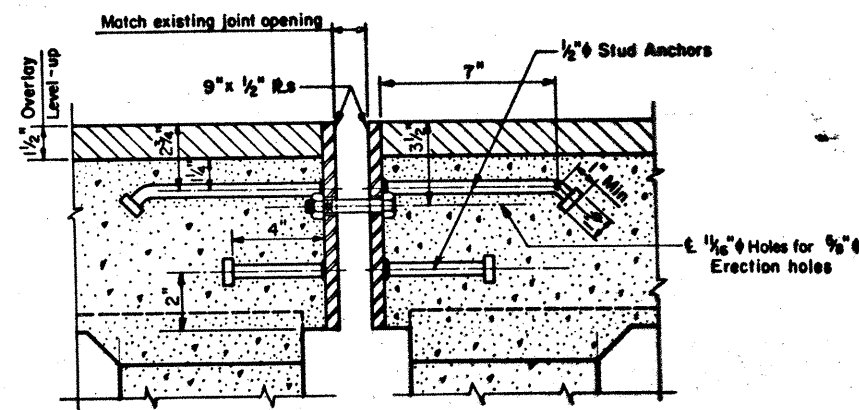


SEC. A-A

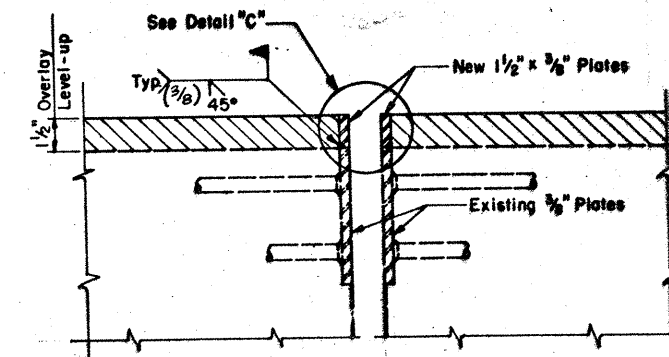

SEC. B-B

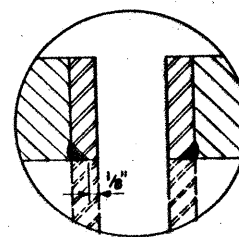


DETAIL "C"

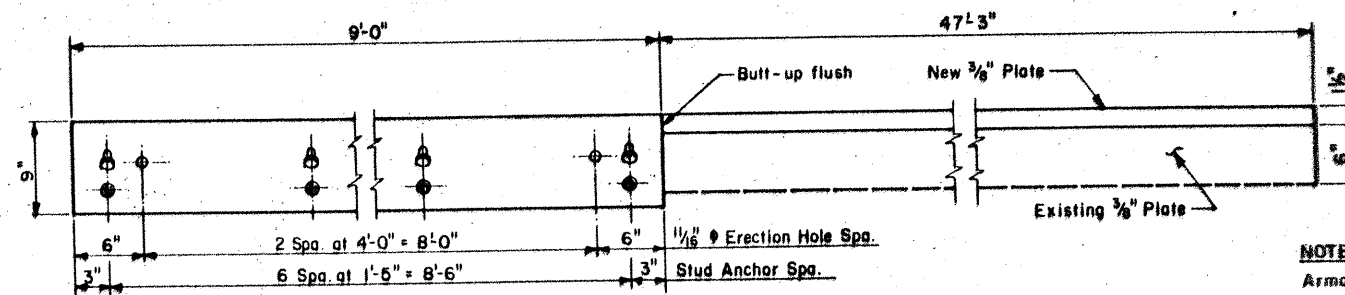


ELEVATION OF ARMOR PLATES

NOTE:


Armor Joints shall be provided at all locations shown on Layout.
Stud Anchors shall be electric arc and welded to plates with complete fusion.
Erection holes shall be punched to line up in final position of Armor Joint.
Corresponding plate sections shall be match marked and bolted together for shipment.
Erection bolts shall be cut off flush with armor plates promptly after the concrete in the latter of the two placements has taken initial set.

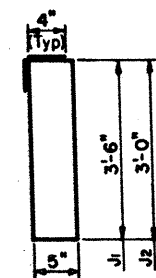


BARS J

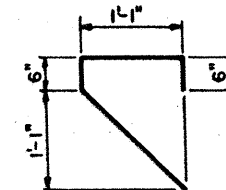


BARS F

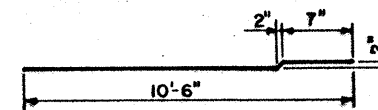

BARS B & AB

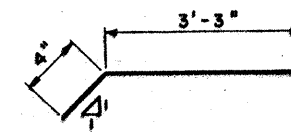

BARS K

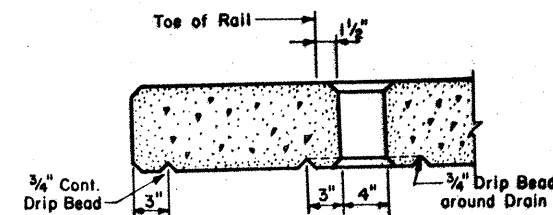

4" x 6" Formed Drain. Bend reinforcing steel to clear drain 1". Drains shall be located as directed by the Engineer. No drains shall be located over roadway.


DRAIN DETAILS

TABLE OF ESTIMATED QUANTITIES FOR 1 SPAN									
FOR SPANS 1 OR 3					FOR SPAN 2				
BAR	NO.	SIZE	LENGTH	WEIGHT	BAR	NO.	SIZE	LENGTH	WEIGHT
A	69	#5	10'-6"	756	A	69	#5	10'-6"	756
AB	69	#5	10'-7"	762	AB	69	#5	10'-7"	762
B	68	#4	10'-7"	481	B	68	#4	10'-7"	481
C	68	#5	10'-6"	744	C	68	#5	10'-6"	744
D	15	#5	59'-9"	935	D	15	#5	59'-9"	935
F	9	#4	3'-7"	22	H4	12	#5	6'-2"	77
H1	6	#5	10'-2"	64	J2	14	#4	7'-6"	70
H2	3	#5	5'-7"	17	T	16	#4	59'-9"	638
H3	3	#5	1'-2"	4	K	152	#5	3'-7"	568
H4	6	#5	6'-2"	39	L	77	#5	3'-4"	267
J1	9	#4	8'-6"	51					
J2	7	#4	7'-6"	35					
T	16	#4	59'-9"	639					
K	152	#5	3'-7"	568					
L	77	#5	3'-4"	267					
Reinforcing Steel					Reinforcing Steel				
Reinf. Conc. Slab for Ext. Strs.					Reinf. Conc. Slab for Ext. Strs.				
Prestr. Conc. Beams (Type C)					Prestr. Conc. Beams (Type C)				
Struct. Steel (Armor Joint)					Struct. Steel (Armor Joint)				
Class "S" Conc. (Slab)					Class "S" Conc. (Slab)				
Class "S" Conc. (Diagrams)					Class "S" Conc. (Diagrams)				
Lb. 5384					Lb. 5298				
S.F. 264					S.F. 264				
L.F. 59.38					L.F. 59.67				
Lb. 235					Lb. 470				
C.Y. 20.2					C.Y. 20.2				
C.Y. 1.3					C.Y. 0.9				

For Contractor's information only

GENERAL NOTES:


Designed in accordance with AASHTO 1989 Standard Specifications.
Design $f_c = 1200$ p.s.i.
The use of PCP's or PMDF's will not be permitted.

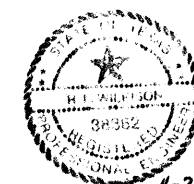


STATE DEPARTMENT OF HIGHWAYS
AND PUBLIC TRANSPORTATION
**60'-0" PRESTRESSED
CONC. BEAM SPAN**
**BELDEN STREET OVERPASS
WIDENING**

ORIGINAL DRAWING DATE	MARCH 1990	STATE	REGION	FEDERAL AID PROJECT	NO.	SHEET
DR - RAC	REVISIONS	16	6	HE50005(506)		50
DR - CEQ						
DR - RNS						
DR - RAC						
COUNTY	NUECES	SECTION	74	6	164	US181


50
H2O LOADING SHEET 2 OF 2

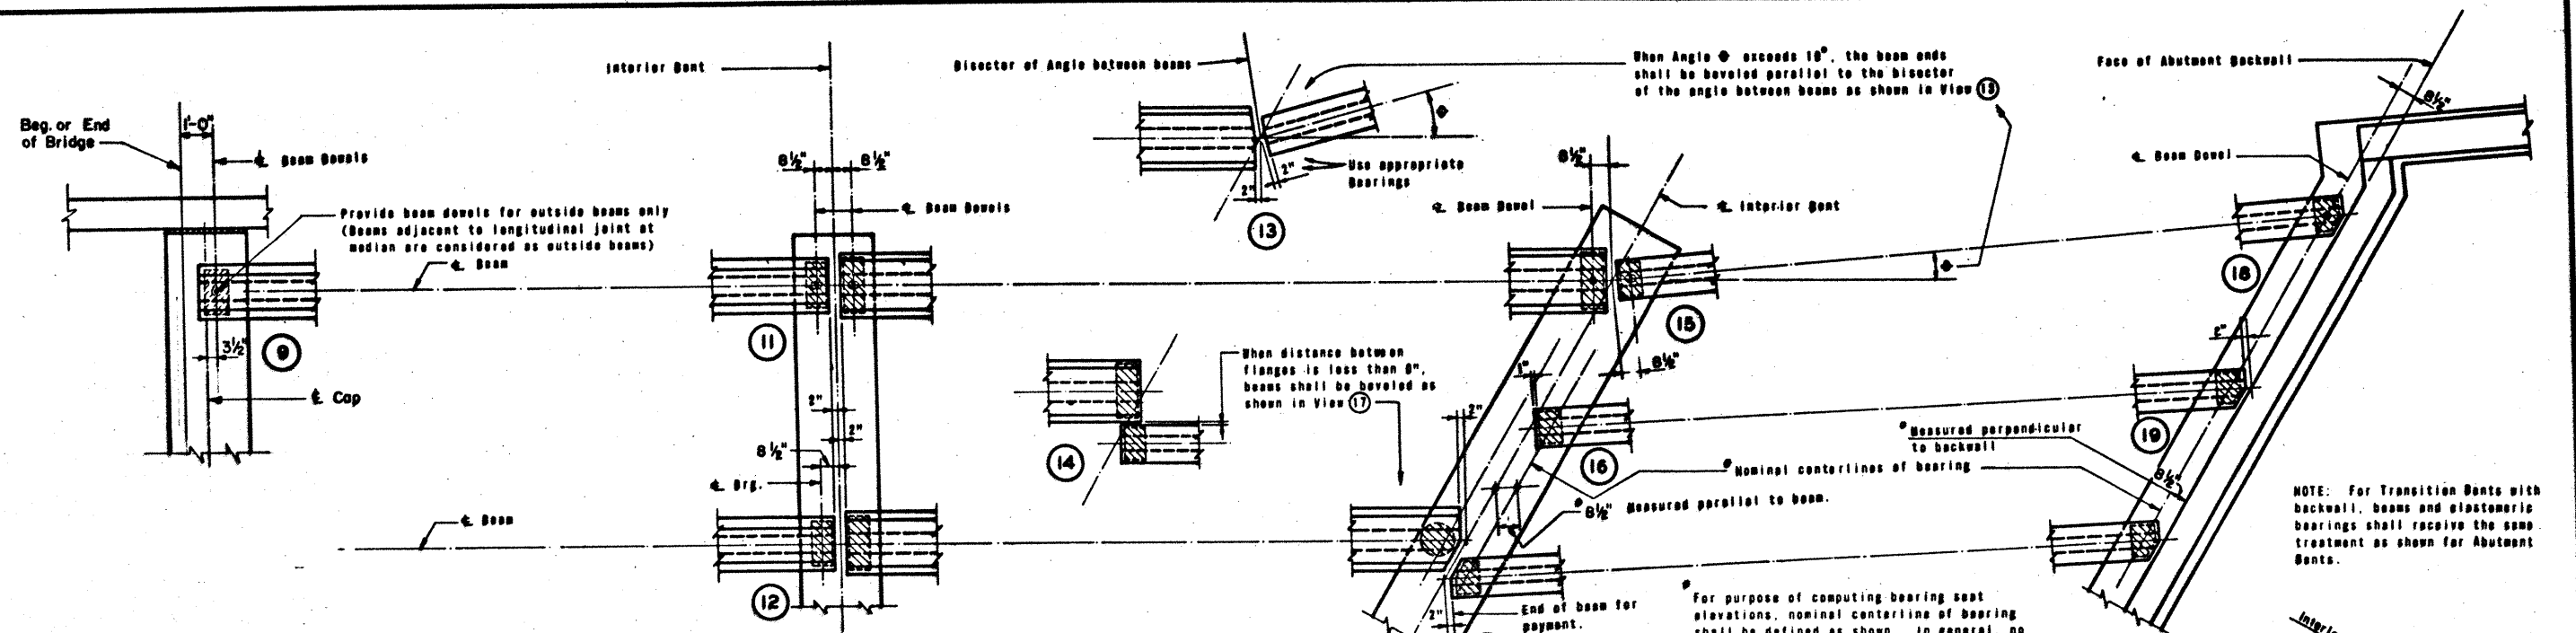

DETAILS OF BEAM ENDS

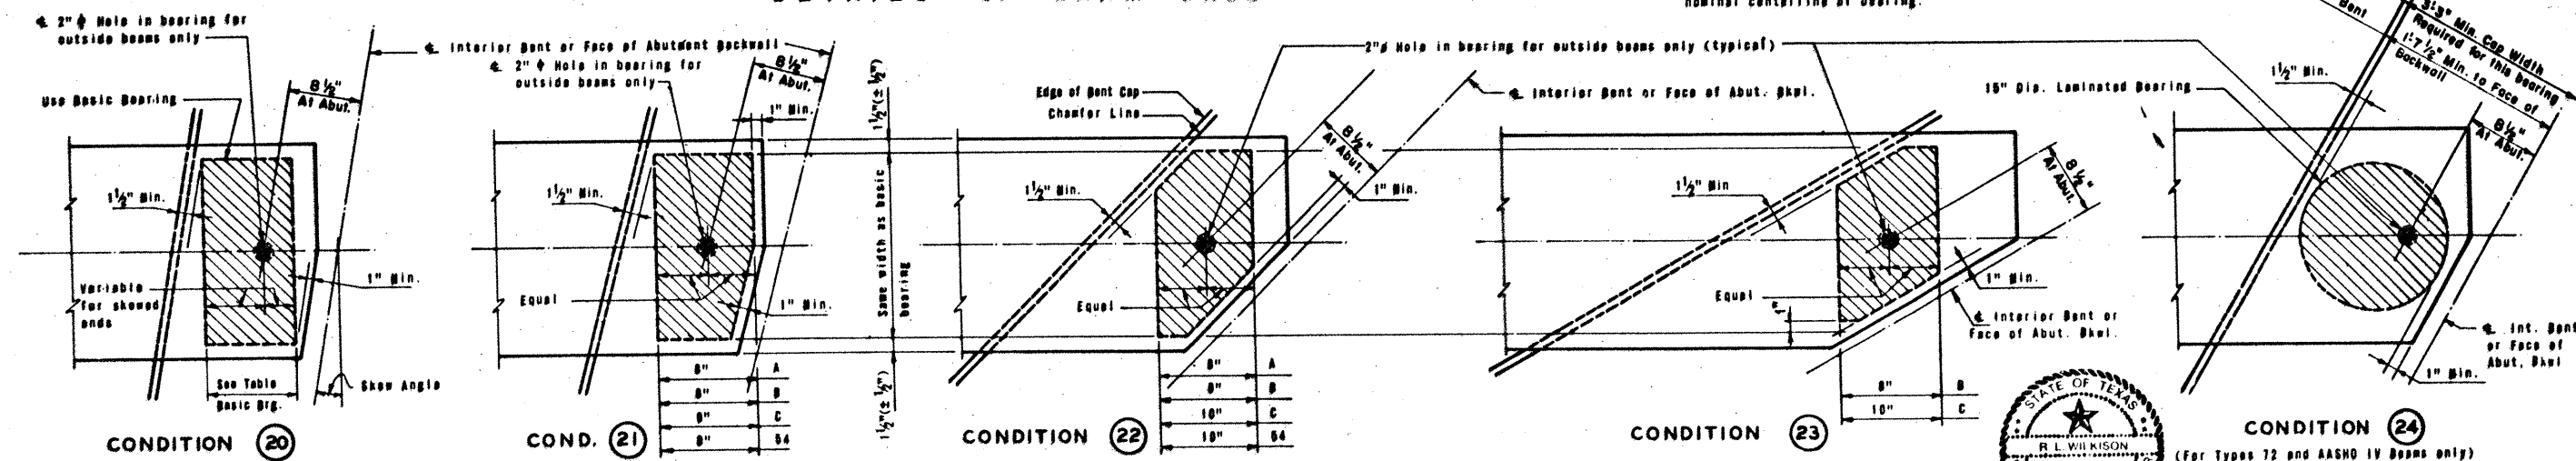

DETAILS OF ELASTOMERIC BEARINGS

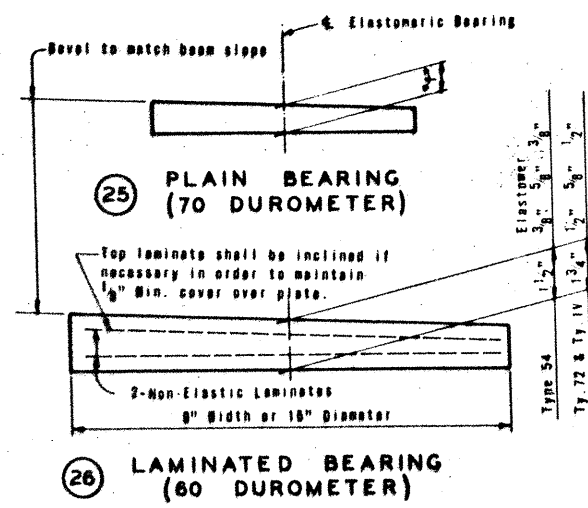

BASIC BEARINGS			
BM. TYPE	SIZE	THICKNESS "H" & DESCRIPTION	
A	8" X 14" X 3/4"	PLAIN	
B	8" X 16" X 3/4"	PLAIN	
C	9" X 19" X 1"	PLAIN	
54	9" X 14" X 1 1/2"	LAMINATED	
72	9" X 20" X 1 3/4"	LAMINATED	
IV	9" X 22" X 1 3/4"	LAMINATED	

BEARINGS FOR BEVELED BEAM ENDS					
BM. TYPE	CONDITION 20	CONDITION 21	CONDITION 22	CONDITION 23	CONDITION 24
A	0° THRU 20°	20° THRU 30°	OVER 30°	NOT APPLICABLE	NOT APPLICABLE
B	0° THRU 15°	15° THRU 30°	30° THRU 55°	OVER 55°	NOT APPLICABLE
C	0° THRU 10°	10° THRU 20°	20° THRU 50°	OVER 50°	NOT APPLICABLE
54	0° THRU 10°	10° THRU 25°	OVER 25°	NOT APPLICABLE	NOT APPLICABLE
72	0° THRU 10°	NOT APPLICABLE	NOT APPLICABLE	NOT APPLICABLE	OVER 10°
IV	0° THRU 8°	NOT APPLICABLE	NOT APPLICABLE	NOT APPLICABLE	OVER 8°

GENERAL NOTES:

Beams shall be seated on elastomeric bearings of the dimensions shown.

Bearings shall be furnished with their thickness varying in one direction depending on the slope of the erected beam.

Constant thickness bearings may be used for moderate beam slopes if the variation is within the allowable dimensional tolerances given in the specifications.

Cost of furnishing and installing elastomeric bearing shall be included in unit price bid for "Prestressed Concrete Beams".



11-26-90
R. L. Wilkison


52

TEXAS HIGHWAY DEPARTMENT
BRIDGE DIVISION

**PRESTRESSED
CONCRETE BEAMS**
BEAM ENDS & BEARINGS
(MOD) Gp B-2


ORIGINAL DRAWING DATE	JUNE 1985	STATE PROJECT	16	FEDERAL AID PROJECT	HE50005(606)	SHEET	32
BY	HJD	DESIGNED		CHECKED		DATE	
CHK	TND	Mod. 5-90	View 9, Bm end at end of bridge	RNS / RAC			
APP	RNS						
CA	TND						

Place #5 bar in plane of bottom slab reinforcement for conventional or PMD Forming. #5 bars to rest on Panels and bent down to beam reinforcement when Prestressed Panels are used.

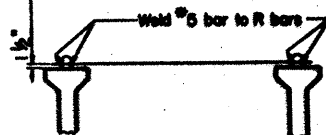


PERMANENT TOP BRACING

⑤

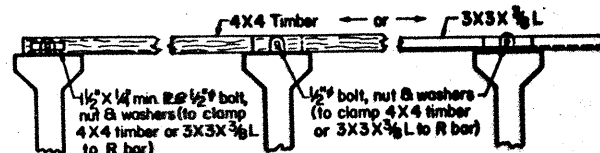


ELEVATION

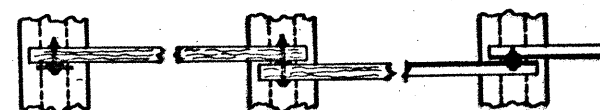


PLAN
TEMPORARY TOP BRACING

④

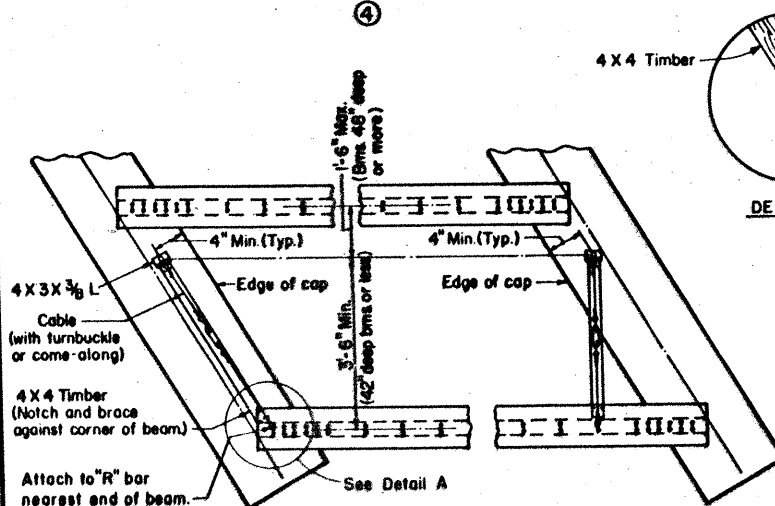

PLAN

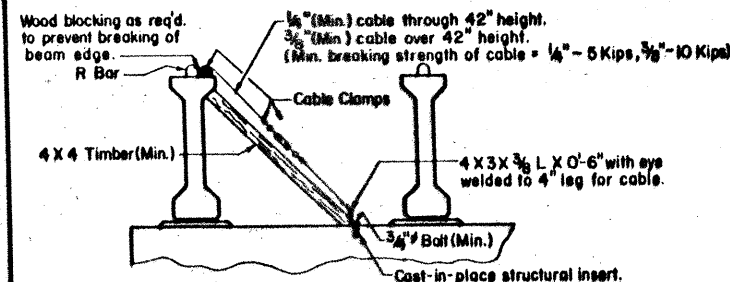


END VIEW

DIAGONAL BRACING DETAILS

(To be used on both ends of the first beam erected in the span.)


①

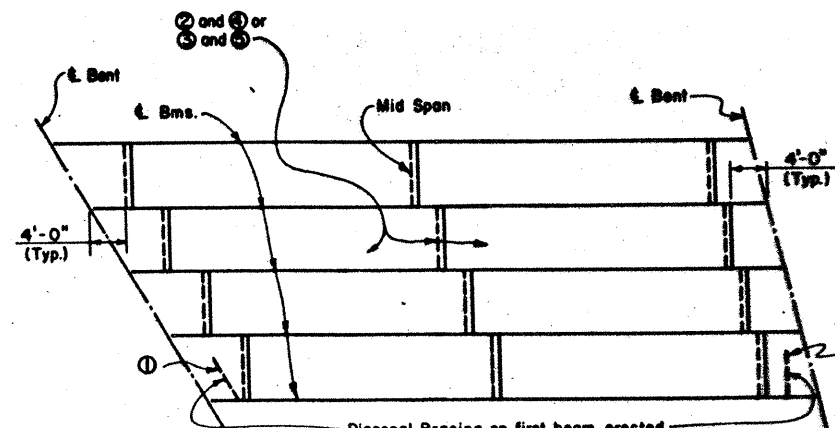


Diagonal Bracing on first beam erected

NORMAL SPANS AND ALL SKEWS

ERECTION BRACING

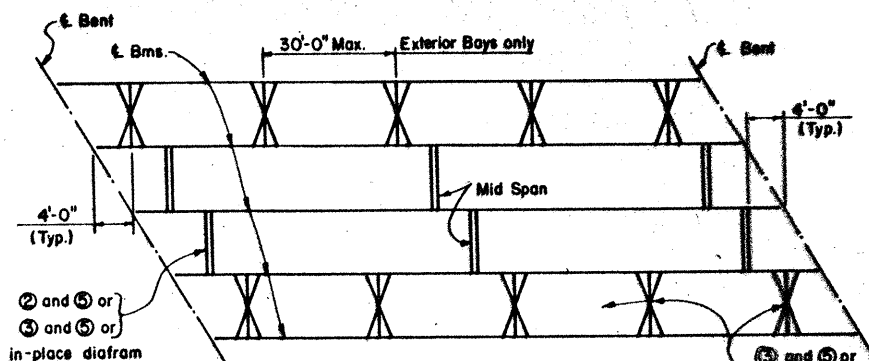


NORMAL SPANS AND ALL SKEWS
SLAB PLACEMENT BRACING

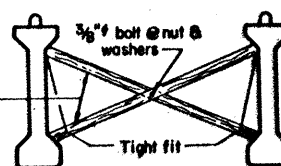

"X" BRACING

③

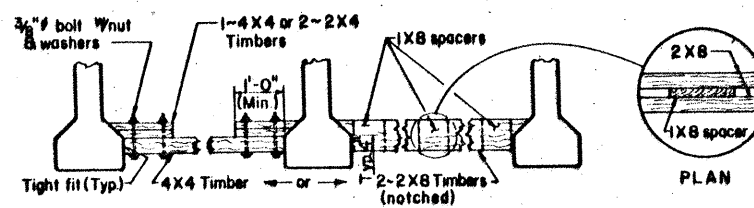

ELEVATION

BOTTOM FLANGE BRACING DETAILS

②

- ① Indicates Diagonal Bracing
- ② Indicates Bottom Bracing with Temporary Top Bracing ④ or "X" Bracing ③ with Permanent Top Bracing ⑤.
- ③ Indicates Permanent Top Bracing
- ④ Indicates Bottom Bracing ② or "X" Bracing ③, either one with Permanent Top Bracing ⑤ or an in-place diafram only.
- ⑤ Indicates "X" Bracing ③ & Permanent Top Bracing ⑤ or an in-place diafram only.

GENERAL NOTES:

ERECTION BRACING:

Erection bracing details are considered minimum for fulfilling the requirements of Specification Item 425 (Article 425.5), and Special Provisions thereto, for bracing Types A, B, C, III, IV and V prestressed concrete beams erected in the span over a traveled way or railroad, and in those spans generally parallel to a traveled way or railroad and within a distance equal to the difference in elevation between the top of cap upon which the beams are being erected and the traveled way, or 30 feet, whichever is greater.

Required erection bracing shall be placed immediately after erection of each beam and remain in place until diafram bars DN are tightened or additional bracing as required for slab placement is in place.

SLAB PLACEMENT BRACING:

The details for slab placement bracing are considered minimum for fulfilling the requirements of Specification Item 420, Article 420.9(4) and special provisions thereto.

Required slab placement bracing shall remain in place until the slab concrete has attained a flexural strength of 500 p.s.i.

GENERAL:

Bracing details for closely spaced beams (as on ramps or railroad structures) are not included herein. The Contractor shall submit his proposed bracing details for such conditions to the Engineer for approval prior to erection.

Systems equal to or better than those shown may be used provided details of such systems are submitted to and approved by the Engineer prior to erection.

Use of these systems and/or details does not relieve the Contractor of the responsibility for the adequacy of the bracing and the safety of the structure.

Removal of bracing for short periods of time to align beams is permissible.

Bottom flange bracing at beam ends may be omitted when all beams are fixed with dowel bars or when erection is on steel caps or floor beams containing bearing seats which restrict lateral movement.

All turn-buckles, come-alongs and other connections shall be capable of developing the full strength of the cable shown hereon.





STATE DEPARTMENT OF HIGHWAYS
AND PUBLIC TRANSPORTATION

PRESTRESSED CONCRETE BEAMS

TYPES A, B, C, III, IV & V
MINIMUM ERECTION AND
BRACING REQUIREMENTS

PCB-MEBR (1)


ORIGINAL DRAWING DATE	DEC 1980	STATE	FEDERAL	FEDERAL AID PROJECT	SHEET
DN - THD	REVISIONS	16	6	HE50005(606)	54
CM - THD					
OW - EDS					
CP - THD					
		COUNTY	CONTRACT	SECTION	JOB
		NUECES	74	6	164 US181

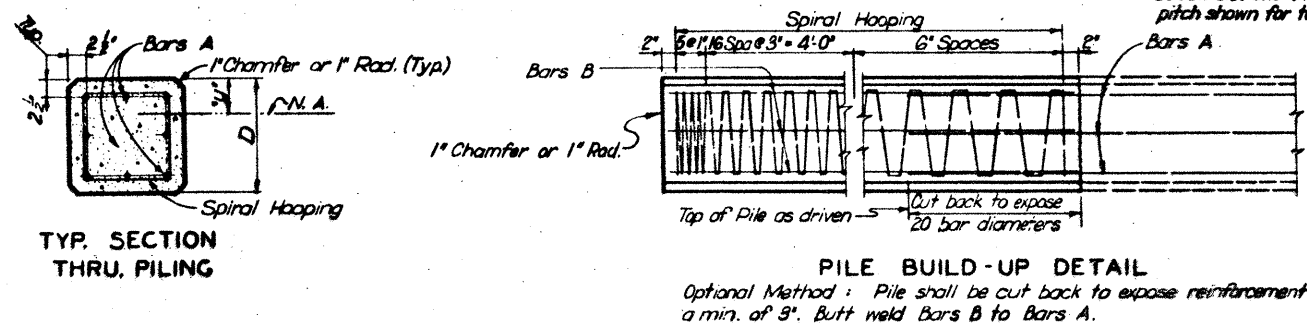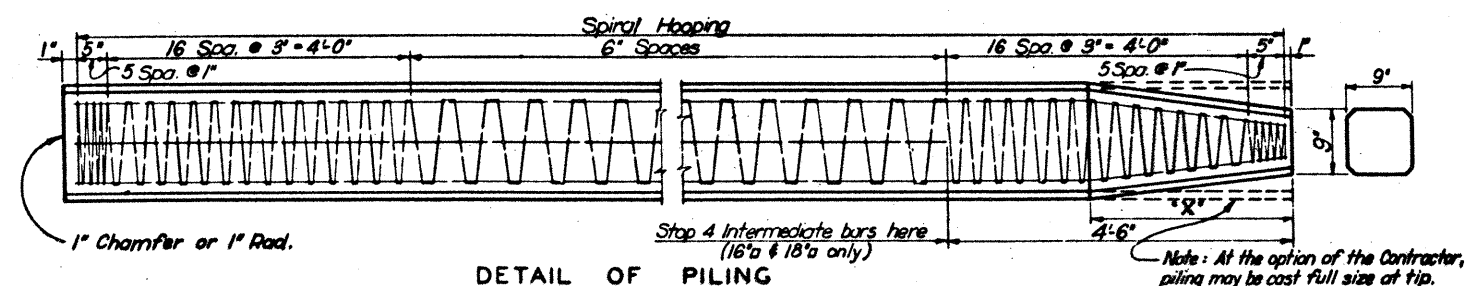

PRECAST CONCRETE PILING (TYPE "A" DISPLACEMENT PILING)



Pile Size	Area	'y'	Ic	Bars A & Bars B	Dim. 'X'	Weight Lb./ft.
"D"	Sq. In.	In.	In ⁴			
14" a	194	3.86	1200	4 ~ #8	1'-8"	202
15" a	223	4.27	1787	4 ~ #9	2'-0"	232
16" a	254	4.99	2624	8 ~ #8	2'-4"	265
18" a	322	5.62	4463	8 ~ #9	3'-0"	336

When 14" a piling are specified on the plans, Contractor has the option of furnishing either 14" a, 15" a or 16" a piling.
When 15" a piling are specified on the plans, Contractor has the option of furnishing either 15" a or 16" a piling.

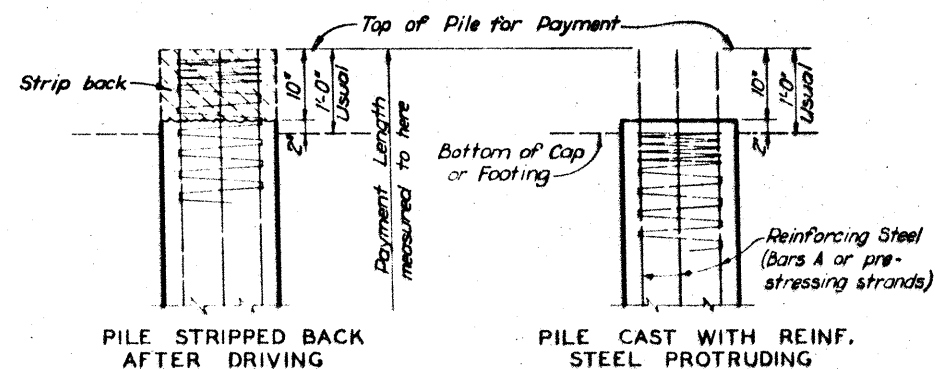

Note: Payment for piling shall be made in accordance with detail shown above. Reinforcing steel shall protrude into substructure only where shown in substructure details, in which case piles may be cast 10" short of payment length with reinforcing steel protruding from the top of piles; or they may be cast to full payment length (or slightly more for Precast Concrete Piling if desired by Contractor), and cut back after driving to expose reinforcing steel 10".
Piles shall be stripped back 10" when the side cover from the edge of pile to the edge of cap or footing is less than 4" after driving.

Note: Piling shall be held firmly in this position @ (horiz) throughout all lifting and handling operations.

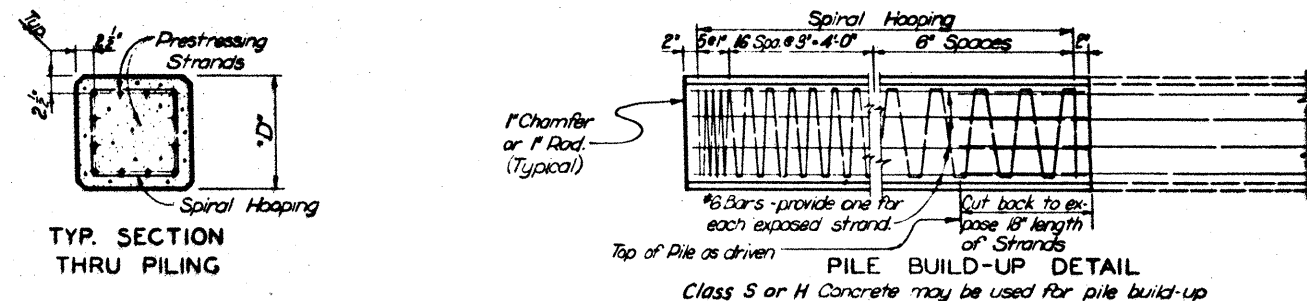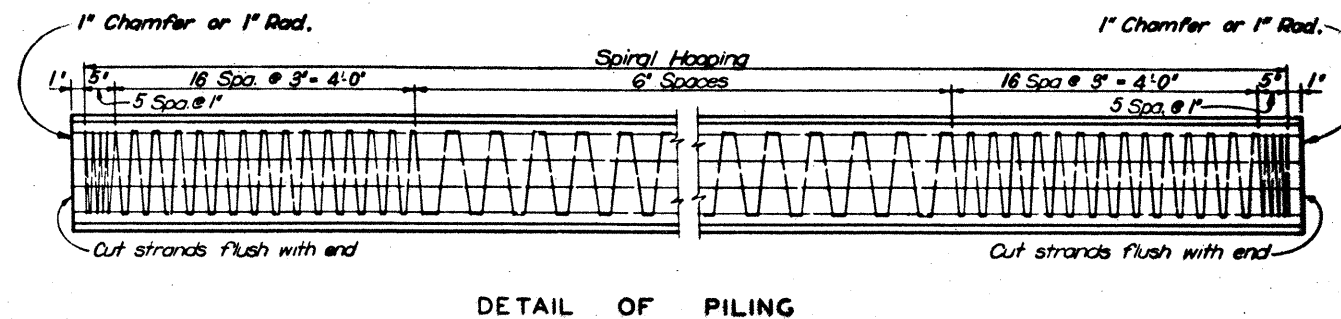

PRESTRESSED CONCRETE PILING (TYPE "A" DISPLACEMENT PILING)

Pile Size "D"	Area of Pile Section	I	Weight	1/4"- 250 K Strands			1/4"- 250 K Strands			1/4"- 270 K Strands			1/4"- 250 K Strands			1/4"- 270 K Strands		
				No.	Initial Prestress Force Kips	Final Prestress (20% Loss) p.s.i.	No.	Initial Prestress Force Kips	Final Prestress (20% Loss) p.s.i.	No.	Initial Prestress Force Kips	Final Prestress (20% Loss) p.s.i.	No.	Initial Prestress Force Kips	Final Prestress (20% Loss) p.s.i.	No.	Initial Prestress Force Kips	Final Prestress (20% Loss) p.s.i.
14"o	194	3110	202	14	196	808	10	189	778	8	174	718	8	202	833	6	173	714
15"o	223	4116	232	14	196	703	12	227	814	10	217	780	8	202	725	8	231	825
16"o	254	5340	265	16	224	706	12	227	713	12	260	819	10	252	794	8	231	725
18"o	322	8600	336	22	308	765	16	302	750	14	304	757	12	302	750	10	289	716
20"o	398	13150	415	26	384	732	20	378	759	18	391	786	14	353	713	14	405	815

GENERAL NOTES FOR CONCRETE PILING:










All concrete for Precast Piling shall be Class S or H. Design $f_c = 1200$ psi. Concrete for Prestressed Piling shall be Class H except as noted.
All corners shall be chamfered as shown or noted.
All dimensions relating to reinf. or prestressing steel are to centers of bars or strands.
Size, number, and length of piling shall be as shown on Layout Sheets.
Spiral Hooping shall have a minimum diameter of .207".
All piling to be cast with concrete using Type II cement.

NOTE: These details are generally to be used for piling which will be subject to sulfate attack or other adverse conditions. Standard CP-2 covers piling to be used under normal conditions.

Release strength for Class H Concrete = 4000 psi.
Minimum compressive strength 28 day (f_c) = 5000 psi.


STATE DEPARTMENT OF HIGHWAYS
AND PUBLIC TRANSPORTATION
CONCRETE PILING
PRECAST CONCRETE &
PRESTRESSED CONCRETE
CP-1

DR. R. R.	DATE	DEC 1980	REV. NO.	1	STATE	TEXAS	FEDERAL AID PROJECT NO.	HE50005(608)
EX. DR. R. R.	DATE	DEC 1980	REV. NO.	1	COUNTY	NUECES	CONTRACT NO.	74164

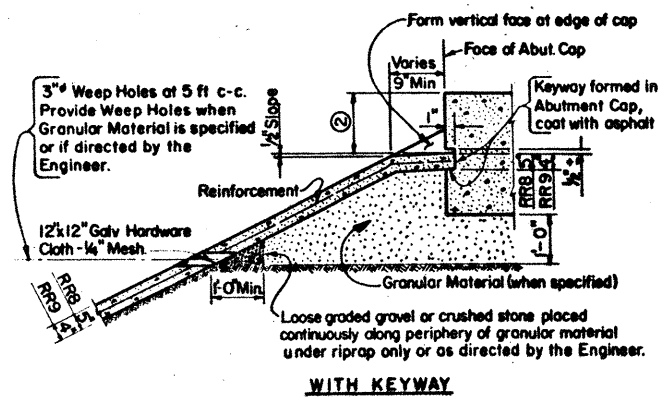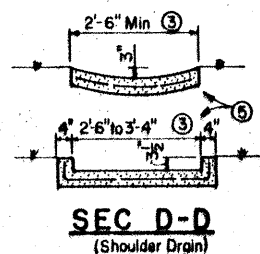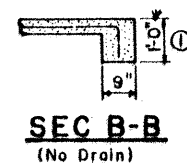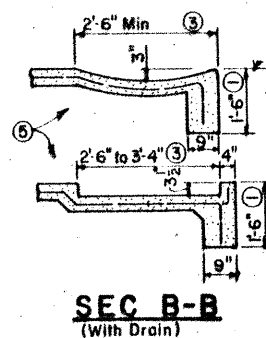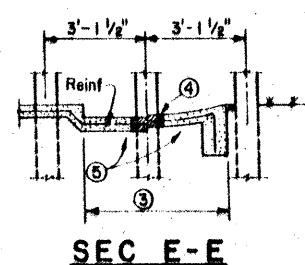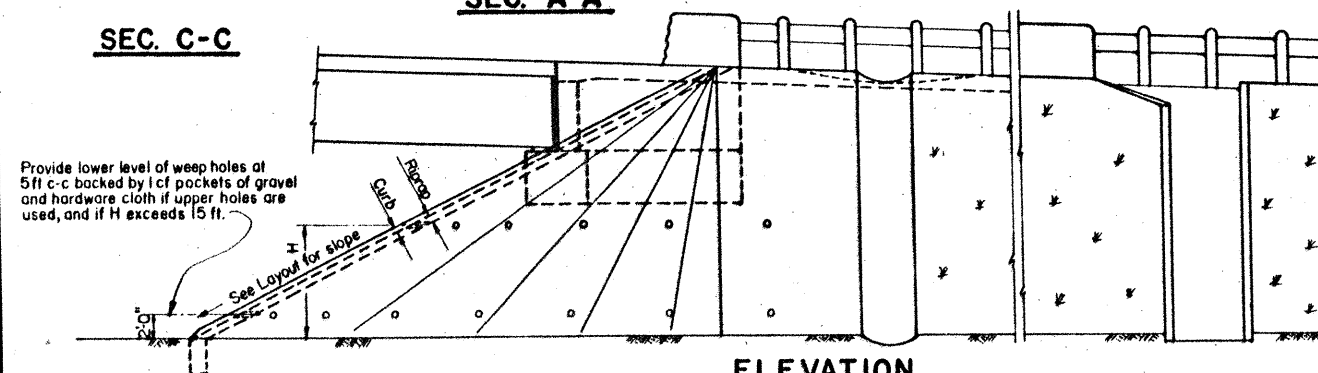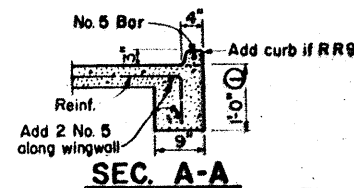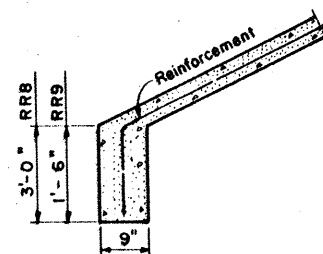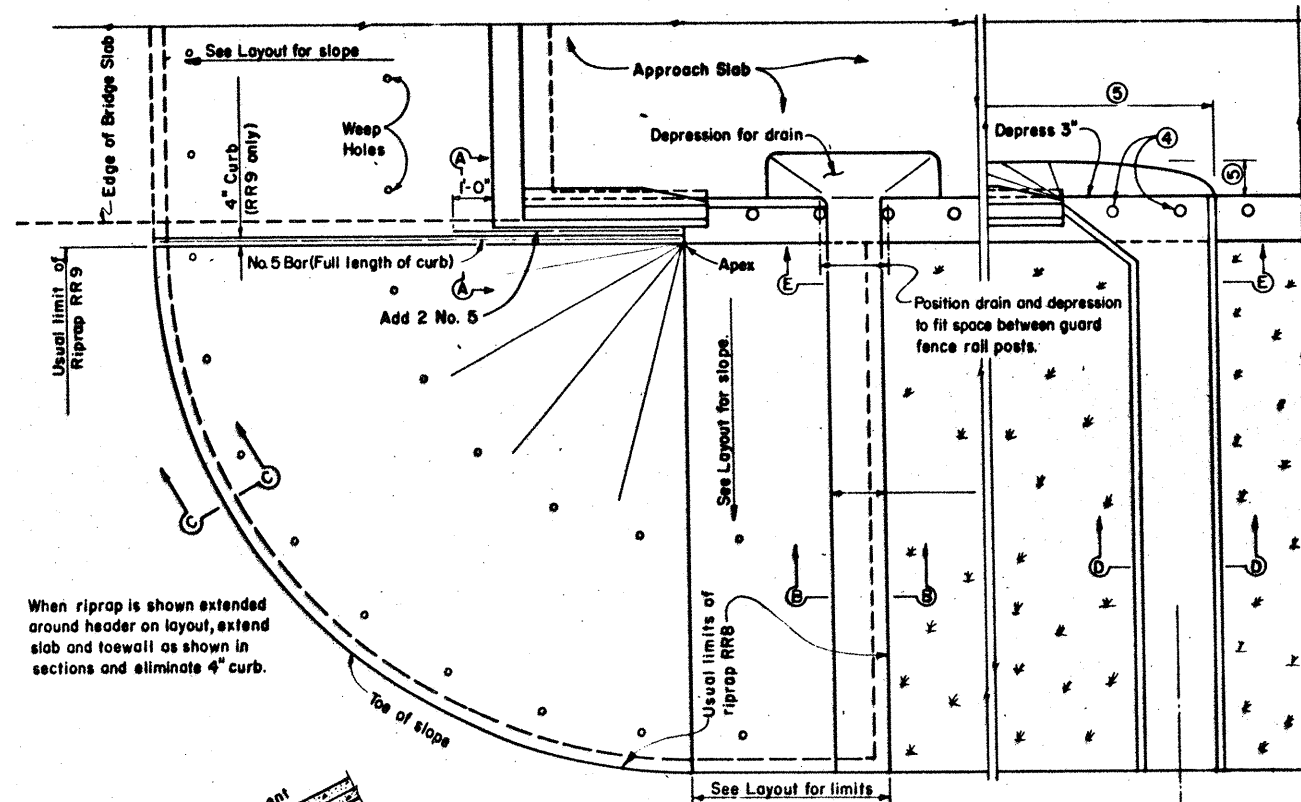





The sealing option of the joint between the face of cap and riprap shall be as designated by the Engineer. Options A or C may be used at wingwalls in all cases.

SECTIONS THRU RIPRAP AT CAP

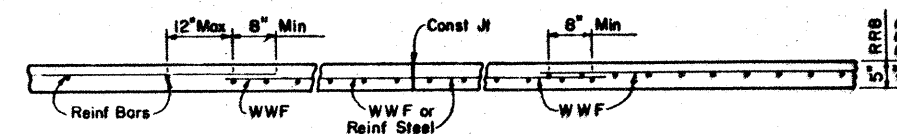

Reinforcing bars shall be No. 3 at 18 in. spac c-c. Welded wire fabric shall be 6 x 6 - W2.9 x W2.9. Combinations of WWF and reinforcing bars may be used if both are permitted. Lap splices shall be a minimum of 8 inches, measured from the transverse wire of WWF.

- ① Wall extension may be reduced or modified if approved by the Engineer.
- ② Dimension varies as directed by the Engineer. Should be 9" Min for stringer type bridges and 1'-6" for slab type bridges.
- ③ Wider or other drain configurations shall be used if shown elsewhere in plans or if directed by the Engineer.
- ④ A 12 in. diameter leave out should be provided in the riprap at the guard fence location. Backfill with 4 in. of ACP if directed by the Engineer.
- ⑤ Limits and configuration of drains and depressions shall be as shown elsewhere in plans or as directed by the Engineer.

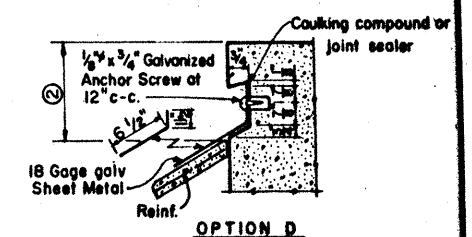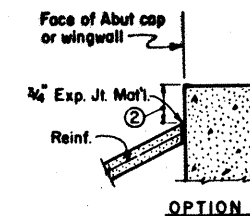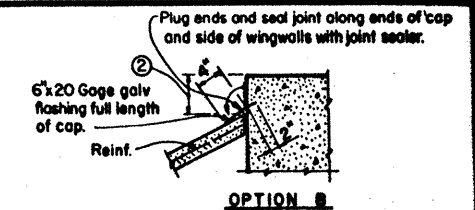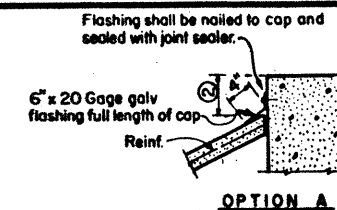

GENERAL NOTES:

Concrete shall be Class B unless noted elsewhere in plans. Reinforcing other than that shown may be used by substituting reinforcement of equal or greater unit cross-sectional area. The maximum reinforcement spacing shall be 18 inches.


Construction joints or grooved joints extending the full slant slope height shall be at intervals of approximately 20 feet unless otherwise directed by the Engineer.


Porus Concrete Filter Blanket and Gravel Backfill shall be placed if shown elsewhere in the plans or if directed by the Engineer.

Hardware cloth, loose graded stone behind weep holes, flashing, or other sealing material shall not be paid for directly but shall be subsidiary to the bid item, Riprap.

Unless specified elsewhere in the plans to be only reinforcing bars, the riprap reinforcing may be composed of reinforcing bars, welded wire fabric, or any suitable combination of both types.

RR 8 is to be used on stream crossings.
RR 9 is to be used on other embankments.

	STATE DEPARTMENT OF HIGHWAYS AND PUBLIC TRANSPORTATION																	
<h1 style="margin: 0;">CONCRETE RIPRAP</h1> <h2 style="margin: 0;">FOR EMBANKMENT SLOPES UNDER BRIDGE ENDS</h2> <h3 style="margin: 0;">RR8 & RR9</h3>																		
 <tr> <td colspan="2" style="text-align: center;">COUNTY</td> <td style="text-align: center;">COUNTY</td> <td style="text-align: center;">SECTION</td> </tr> <tr> <td colspan="2" style="text-align: center;">NUCES</td> <td style="text-align: center;">74</td> <td style="text-align: center;">6</td> </tr> <tr> <td colspan="2"></td> <td style="text-align: center;">164</td> <td style="text-align: center;">U5191</td> </tr>

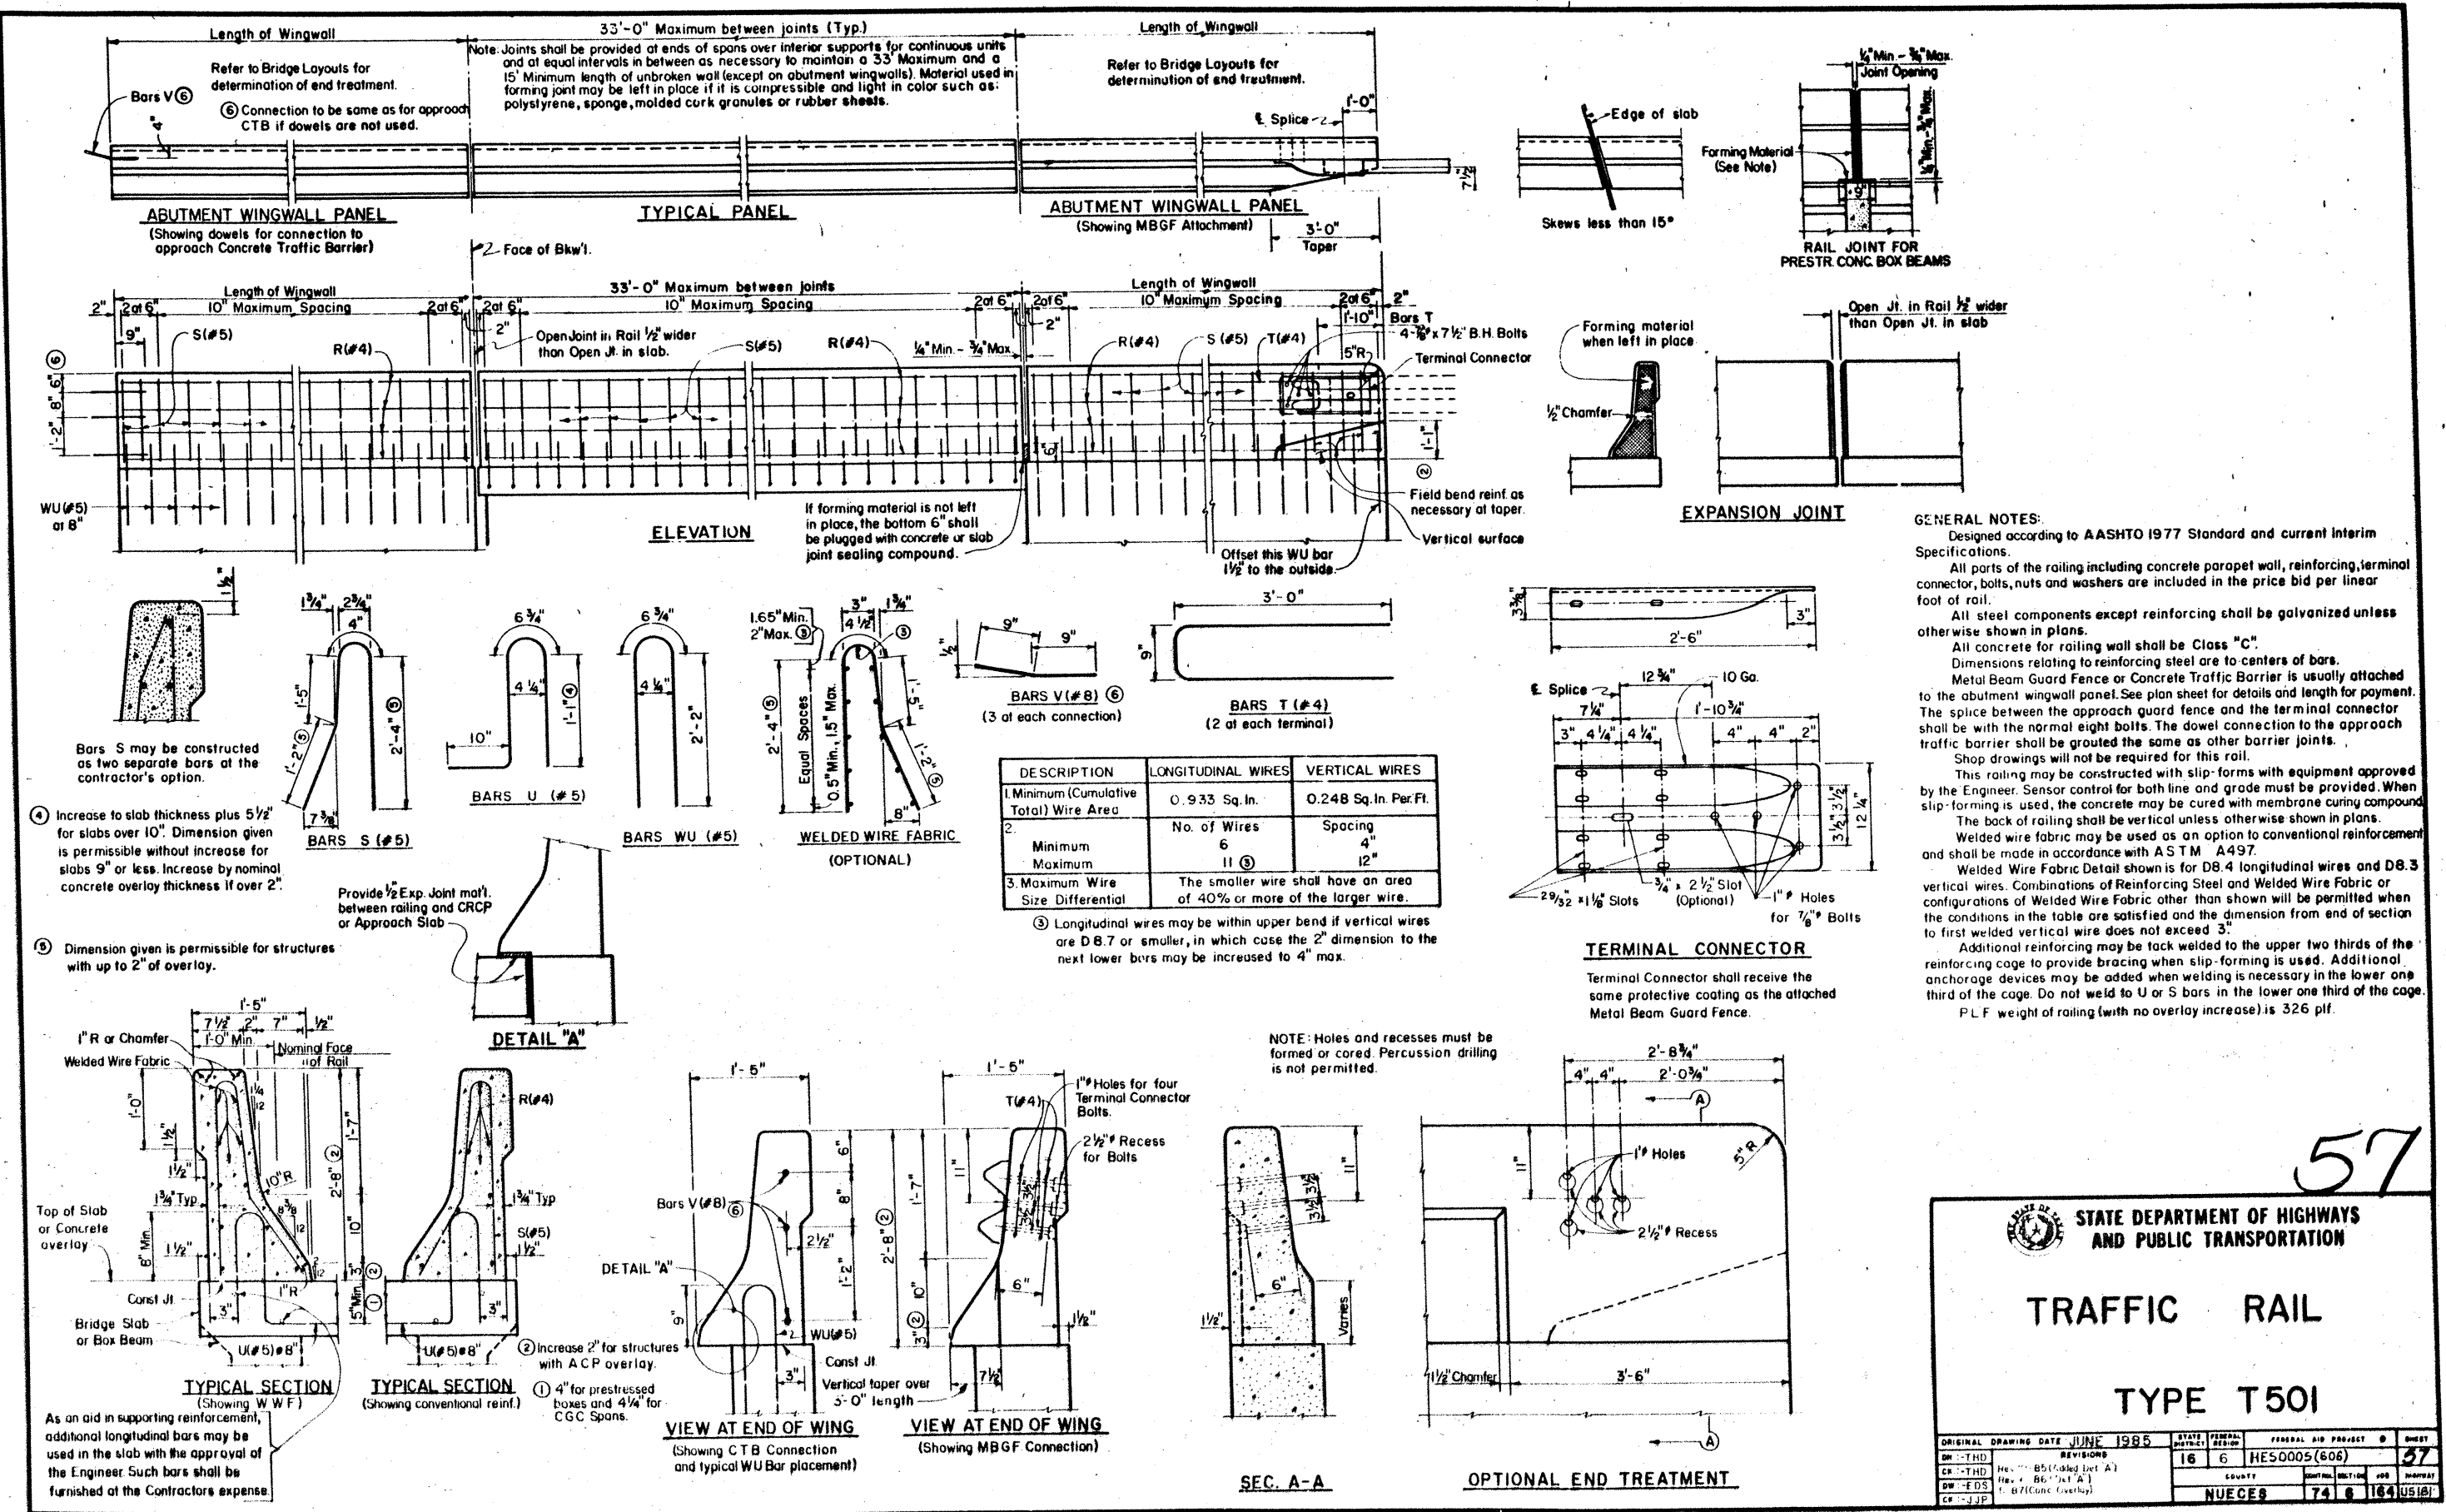


57

**STATE DEPARTMENT OF HIGHWAYS
AND PUBLIC TRANSPORTATION**

TRAFFIC RAIL


TYPE T501

ORIGINAL DRAWING DATE JUNE 1985		STATE FUNDING	FEDERAL AID PROJECT	SHEET
COUNTY		COUNTY	COUNTY	COUNTY
NUECES		74	6	164 (US16)

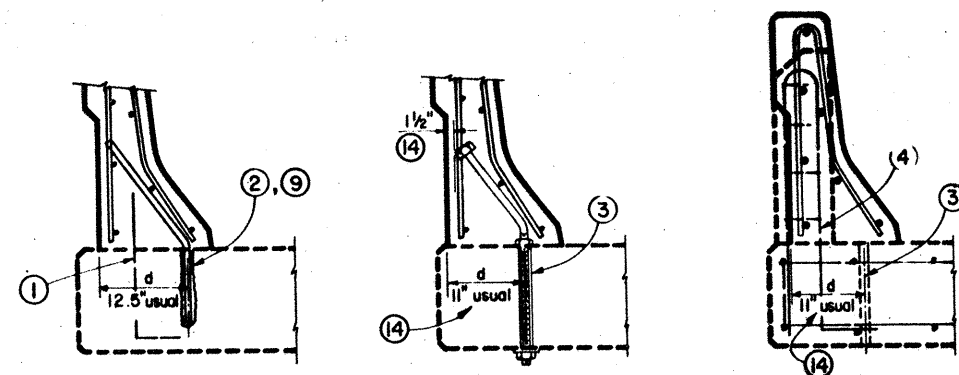

SLABS OVER 12" THICK

SLABS OVER 6 1/2" THICK

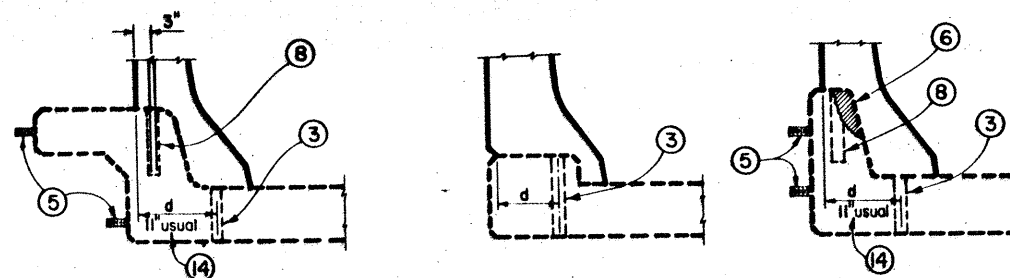


TYPICAL WINGWALL T50IR RETROFIT DETAILS


TABLE S

d Inches	Maximum Spacing (Inches)	
	Dowels (2)	Anchor Bolts (3, 4)
5	8.2	25.6
7	11.8	36.9
10	17.4	54.0
12	21.1	65.3

Other spacings may be interpolated

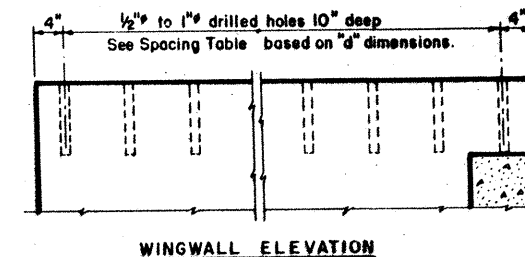


WINGWALL ELEVATION

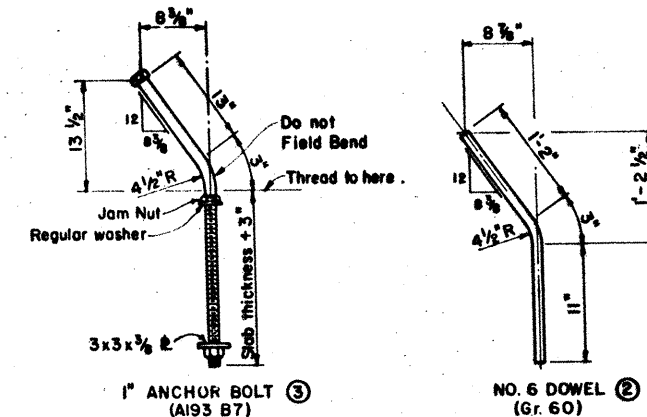

1" ANCHOR BOLT (3)
(A193 B7)

NO. 6 DOWEL (2)
(Gr. 60)

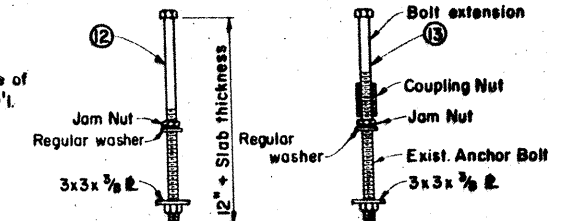


3/8" ANCHOR BOLT (12, 13)
(A321, A325 or A193 B7)

GENERAL NOTES:
Designed in accordance with AASHTO 1977 Standard and Interim Specifications. Pullout tests have been performed on the epoxied No. 6 dowel anchorage system which have demonstrated that over 60 ksi can be developed in the dowel. See Traffic Rail Type T50I standard for details not shown herein.

Not all possible combinations of existing railing, curbs, parapets, etc. have been shown on this sheet. Other combinations and reinforcement arrangements are permissible if they meet the same strength requirements as indicated on this sheet.

Additional reinforcing may be tack welded to the upper two thirds of the reinforcing cage to provide bracing when slip forming is used. Additional dowels or anchorages may be added when welding is necessary in the lower one third of the cage. Do not weld to the anchor bolts or required dowels.

This sheet is intended to be used as a guide for retrofitting existing structures with the T50I type of railing. Details with appropriate notes taken from this guide should be prepared for the specific application.

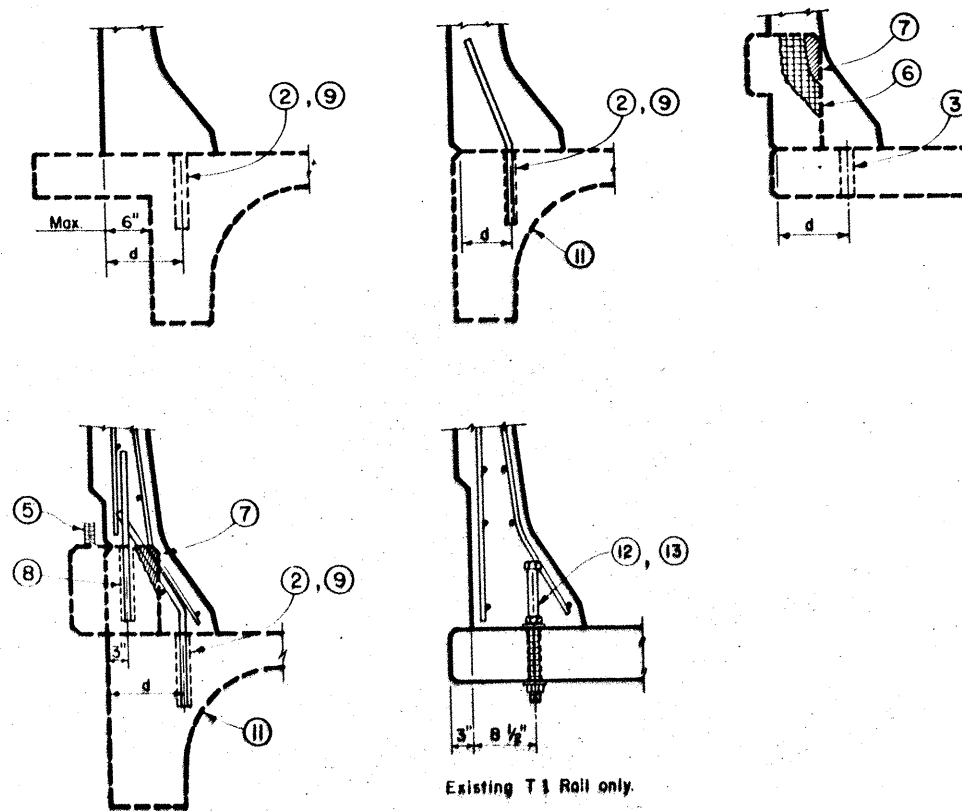

TYPICAL T50IR RETROFIT DETAILS

Existing T 1 Rail only.

- On the bridge deck, remove existing rail posts, leaving at least 12 inches of the four No. 5 front face reinforcing bars intact which must be incorporated into the new rail. The existing four post bars may be considered to be equivalent to 1.5 of the No. 6 dowels.
- No. 6 dowels are to be epoxy grouted into the existing bridge slab as shown at a spacing not to exceed that given in Table S.
The holes for the dowels shall be 10 inches deep which are 0.875 to 1.0 inch in diameter. The holes shall be clean and dry. Compressed air, if used to clean the holes, shall have no oil in suspension. The holes may be drilled with impact, rotary, or percussion type drilling equipment.
The dowels shall be set into the holes with epoxy binder which conforms to the requirements of SDHPT Epoxy Type VIII (formerly B-102). They shall not be disturbed for a minimum of 72 hours in which the air temperature is more than 40 degrees Fahrenheit. Temperatures below 40 degrees shall not be considered as part of the epoxy curing time.
- Drill 1.125 to 1.25 inch diameter holes through the existing bridge deck at a spacing not to exceed that given in Table S.
The holes through the bridge deck must be drilled with rotary or coring type equipment. Percussion or impact drilling shall not be used. Spalls in the bottom of the slab exceeding 0.5 inch from the edge of the holes shall be patched.
The bolts, nuts, and bottom plate washers shall be galvanized. Bolts and nuts shall have Class 2A and 2B fit tolerances. The nuts shall be tapped after galvanizing.
- On the bridge deck, remove existing rail posts, leaving at least 12 inches of the four No. 5 front face reinforcing bars intact, which must be incorporated into the new rail. The existing four post bars may be considered to be equivalent to 0.35 anchor bolts.
- Remove existing rail, cut and grind anchor bolts flush, and paint ends with two coats of zinc dust-zinc rich oxide paint as described under Item 450.
- Notch the existing curb at the bolt locations to provide 0.5 in minimum clearance behind the bolts.
- Break back upper face of existing parapet to provide 0.5 inch minimum clearance behind the S and R bars.
- No. 6 dowels must be epoxy grouted into the existing curb or parapet as shown at a spacing not to exceed 5 feet, using the same procedures as described for note (2).
- An approved resin type binder in capsules may be used for the No. 6 dowels in lieu of the epoxy binder. Depth of holes and installation shall be in accordance with manufacturer's recommendations such that the full pullout strength of the dowel may be obtained.
- Drill holes through existing wingwall for terminal anchorage bolts.
- Patch if spall occurs while drilling.
- Remove old Anchor Bolts and replace with 7/8" Bolts in the two existing interior holes. Also add one of these bolts at the midpoint between old posts. Drill holes 1" in diameter for the additional bolt using procedure described for Note (3). Secure bolts with a Jam Nut and washer. Galvanize Nut, washers and lower 12" of bolt (Min.) Existing bottom plates may be used at old post locations in place of the 3x3x 3/8" plates.
- At existing posts, two interior bolts may optionally be left in place with an additional length of bolt joined by a rod coupling nut. Rod Coupling Nut shall be grade 5 or better with a proof load capacity at least equivalent to A325 Nuts. Do not galvanize. Class 2B thread fit tolerance. The two exterior bolts may be used for the bolt extensions. In either case, the length of bolt and head protruding from slab shall be approximately 11 1/2" to insure adequate development length and cover over the bolt head. Bolts may be slightly field bent to maintain cover.
- If d dimension is less than the usual 11 inches, use reduced spacing as given in Table S and turn bolt as required to maintain 1/2" cover to back of rail.

STATE DEPARTMENT OF HIGHWAYS AND PUBLIC TRANSPORTATION

RETROFIT TRAFFIC RAIL DETAILS

T 50I R

ORIGINAL DRAWING DATE	JUNE 1985	STATE DISTRICT	FEDERAL REGION	FEDERAL AID PROJECT	SHEET
BY	JJP	REVISIONS	16	6	HE50005(606) 38
CH		COUNTY	NUECES	SECTION	14 6 184 USH
DATE	FDS				

58

STRUCTURAL INFORMATION

TYPE A TENSION STRUT: CONSISTS OF DIAGONAL STRUTS, CONNECTIONS, AND ACCESSORIES, AS DETAILED BY THE MANUFACTURER, LOCATED AT REAR OF G.R.E.A.T. UNIT. WHEN USED, A 4' x 4' x 2'-6" CONCRETE TOE ANCHOR BLOCK SHALL BE PROVIDED BENEATH THE FRONT PORTION OF THE CONCRETE PAD EXCEPT WHERE THE G.R.E.A.T. UNIT IS TO BE PLACED ON CONTINUOUSLY REINFORCED CONCRETE PAVEMENT.

TYPE B CAST-IN-PLACE CONCRETE WALL BACKUP: WHEN A TYPE B BACKUP IS SPECIFIED, THE BACKUP WALL SHALL BE DETAILED ELSEWHERE IN THE PLANS. IF CAST-IN-PLACE STRUCTURES SUCH AS CONCRETE TRAFFIC BARRIER, BRIDGE PARAPETS, COLUMNS, OR SPECIAL WALLS ARE USED AS BACKUP STRUCTURES, THEN INTERMEDIATE WALLS AS DETAILED ELSEWHERE IN THE PLANS SHALL BE PROVIDED BETWEEN THESE STRUCTURES AND THE G.R.E.A.T. UNIT. THE INTERMEDIATE WALLS SHALL BE EQUAL IN HEIGHT AND WIDTH TO THAT OF THE G.R.E.A.T. UNIT. THE INTERMEDIATE WALLS SHALL BE REINFORCED WITH A STEEL CAGE. PRECAST CONCRETE MEDIAN BARRIER SHALL NOT BE USED AS A BACKUP STRUCTURE FOR THE G.R.E.A.T. UNIT.


TYPE C WIDE FLANGE BACK-UP: CONSISTS OF TWO 6WF25 x 6'-2" STEEL POSTS ERECTED VERTICALLY AT REAR OF G.R.E.A.T. UNIT. POSTS ARE SET IN A CAST-IN-PLACE, REINFORCED FOUNDATION WHICH IS 4'-0" x 2'-0" x 3'-0", WITH THE 3'-0" DEPTH MEASURED FROM THE TOP OF CONCRETE PAD. DETAILS FOR CONNECTIONS AND ACCESSORIES FOR THE WIDE FLANGE BACK-UP PROVIDED BY THE MANUFACTURER.

TYPE CZ CONSTRUCTION ZONE BACK-UP: CONSISTS OF A STEEL BASE AND BACK-UP AS INTEGRAL PARTS OF THE G.R.E.A.T. UNIT. ANCHORAGE PROVIDED BY ANCHOR BOLTS WHERE THE UNIT IS PLACED ON CONCRETE OR BY DRIVEN, STEEL ANGLE ANCHOR PINS FOR PLACEMENT ON OTHER THAN CONCRETE. THE TYPE CZ UNIT IS ONLY AVAILABLE IN 2' OR 2.5' WIDTHS WITH 3 OR 6 BAYS.


NOTES: TYPE OF BACK-UP STRUCTURE FOR EACH LOCATION SPECIFIED ELSEWHERE IN THE PLANS.

DETAILS OF COMPONENTS TO THE GUARD RAIL ENERGY ABSORBING TERMINAL WILL BE SHOWN ON SHOP DRAWINGS FURNISHED TO THE ENGINEER BY THE MANUFACTURER.

EACH FRONT AND REAR ANCHOR TO BE SECURED TO CONCRETE PAD USING SIX 3/4" DIA. x 6 1/4" CONC. ANCHOR BOLTS, 3/4" HEX HEAD NUTS AND 3/4" FLAT WASHERS

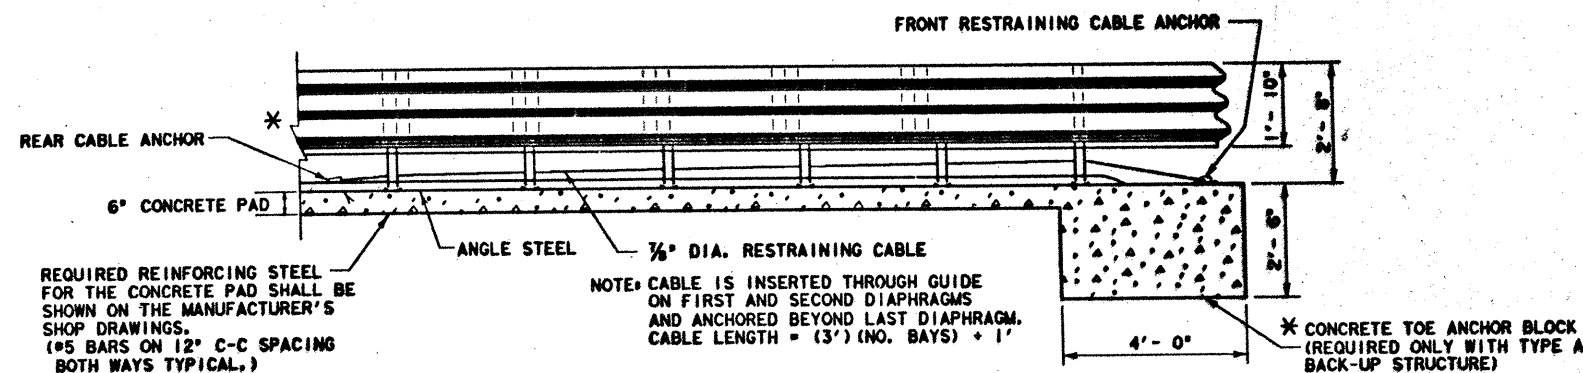

ELEVATION

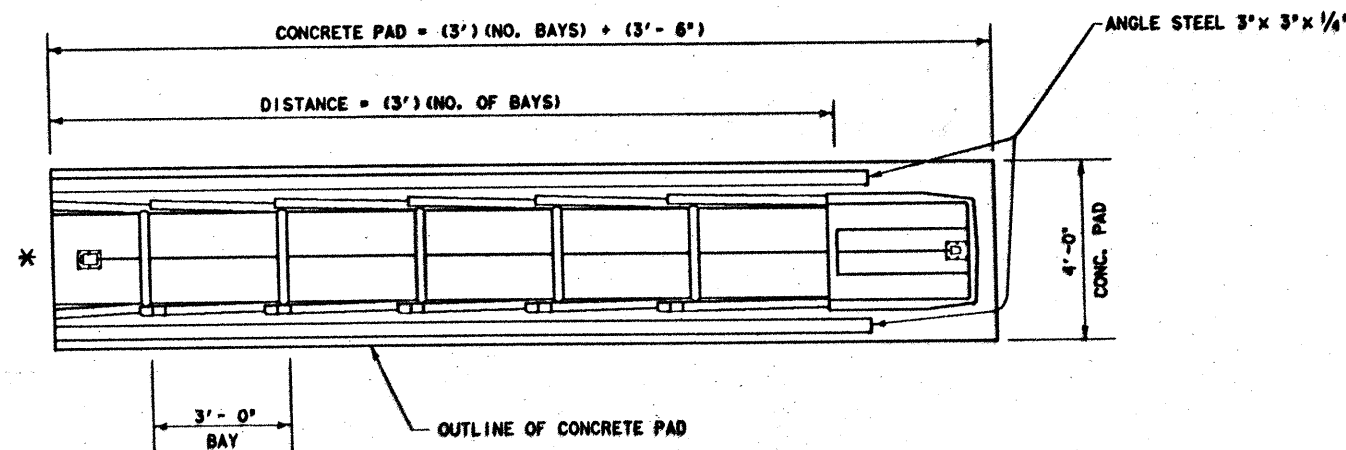

PLAN

* SEE NOTE FOR BACK-UP STRUCTURE INFORMATION

DESIGN SPEED (MPH)	NO. OF BAYS ①
40 OR LESS	3
45	4
50	5
55	6
60	8
65	10

① BASED ON MAXIMUM DECELERATION FORCE OF 6 G's

IF TYPE CZ UNIT IS USED, REFER TO STRUCTURAL INFORMATION FOR WIDTHS AND NUMBER OF BAYS.




STATE DEPARTMENT OF HIGHWAYS AND PUBLIC TRANSPORTATION

GUARD RAIL ENERGY ABSORBING TERMINAL


GREAT-89

REVISIONS	FED. NO.	STATE	FEDERAL AID PROJECT NO.	SHEET NO.
	6	TEXAS	HE30003(606)	59
	16	NUECES	74-6-164-13181	

59

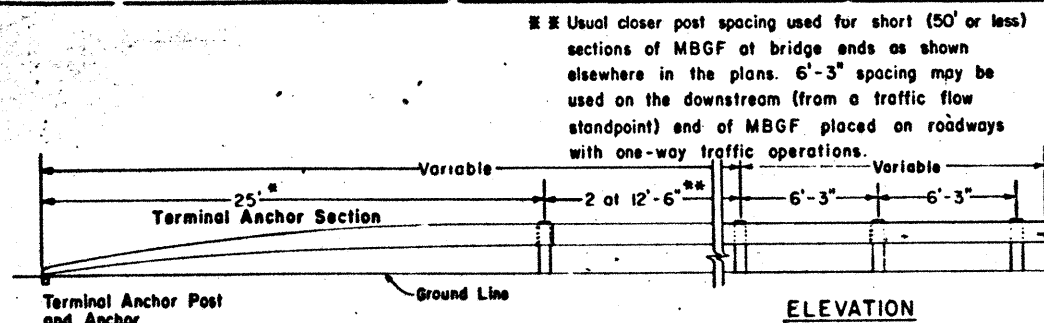


*NOTE: This dimension measured to center of splice when Terminal Connector is used.

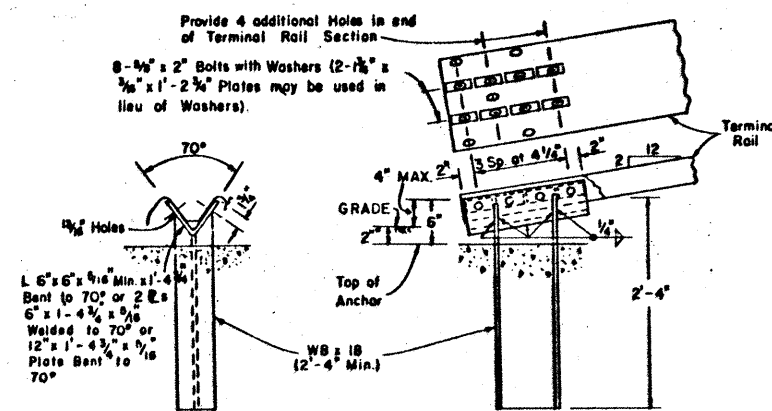


TERMINAL ANCHOR POST

NOTE: This Post requires 4 additional Holes (Shop or Field) in the Terminal Rail member with 8-1/8" Bolts and Washer Plates as shown for attachment.

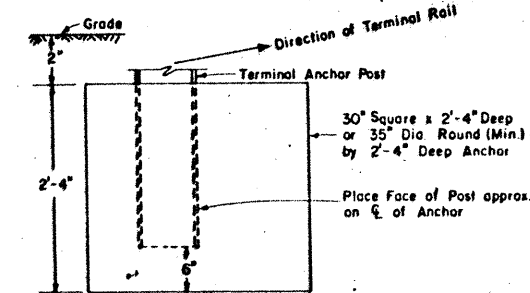


TERMINAL CONCRETE ANCHOR

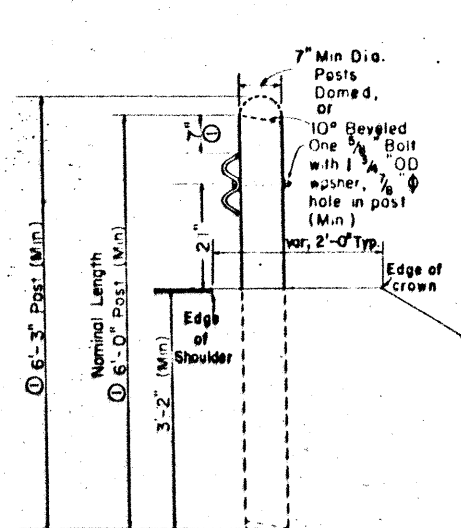


WOOD LINE POST

NOTE ①: Where a nominal length of 5'-6" is specified as acceptable elsewhere in the plans, these dimensions shall be reduced by 0'-6".

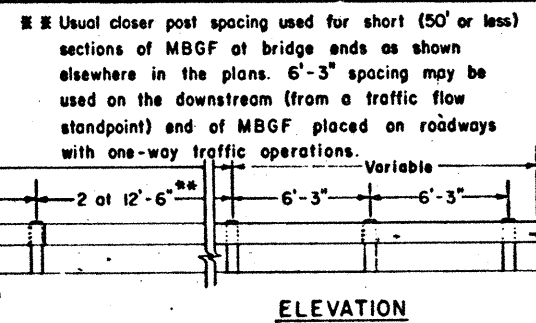



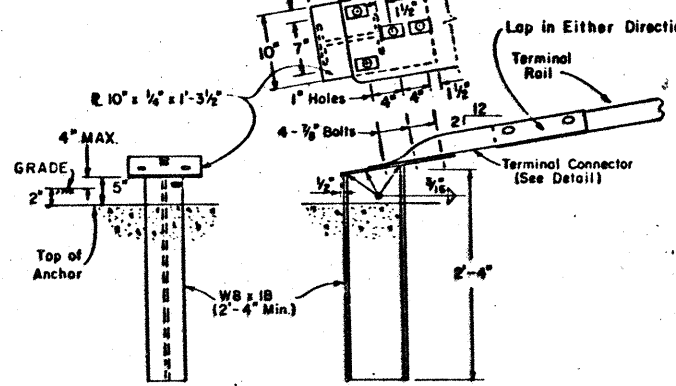


OPTIONAL TERMINAL ANCHOR POST


NOTE: This Optional Post requires the use of the 10 Ga. Terminal Connector with 4-1/8" Bolts for attachment to the Anchor Post.

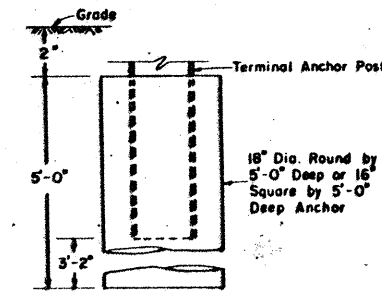

OPTIONAL TERMINAL CONCRETE ANCHOR

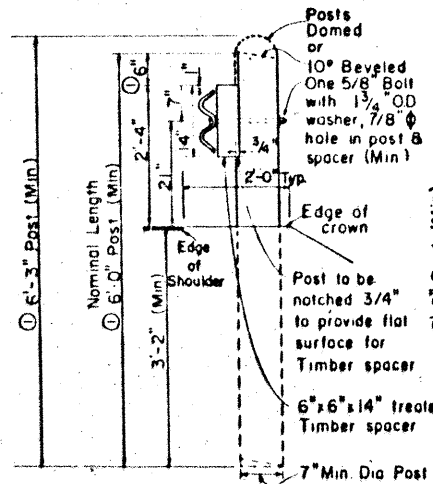


WOOD LINE POST (Blockout)

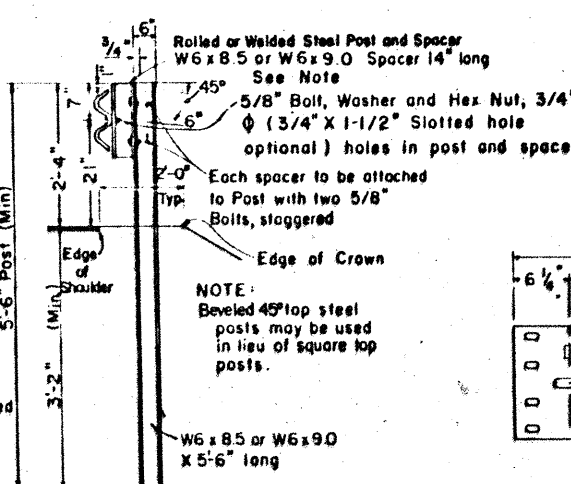


STEEL LINE POST (Blockout)

The designer should specify the reduced length only on highways where future ACP overlays are unlikely.

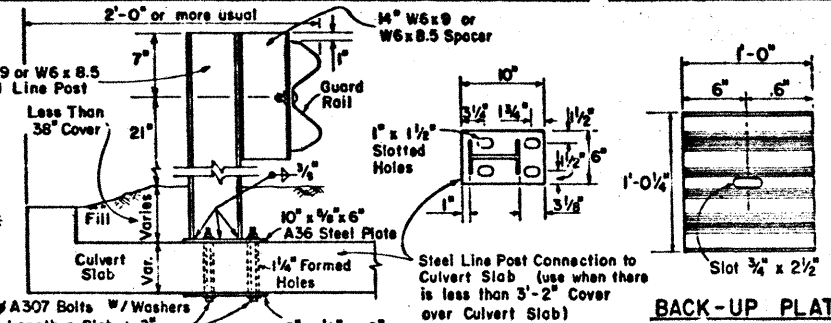


BACK-UP PLATE

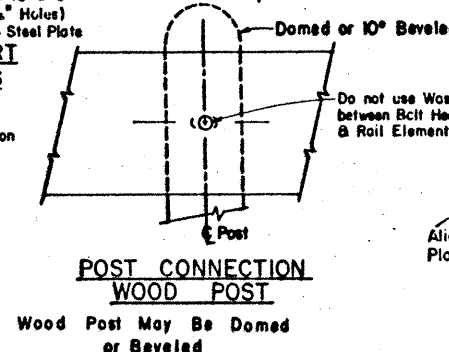


POST CONNECTION WOOD POST

Wood Post May Be Domed or Beveled

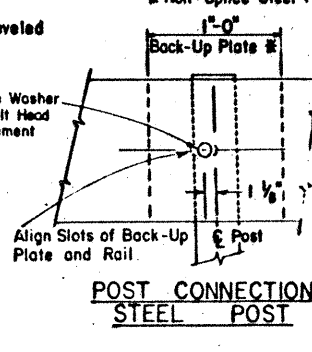


POST CONNECTION STEEL POST

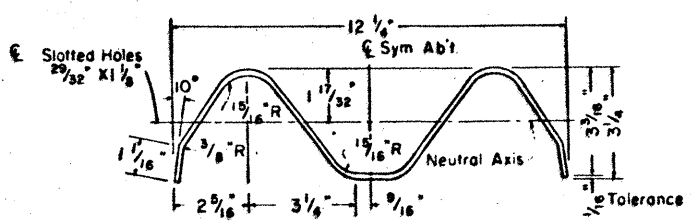


NOTE: Actual section may be slightly different depending upon the manufacturer.

SECTION THRU GUARD RAIL AND BACK-UP PLATE

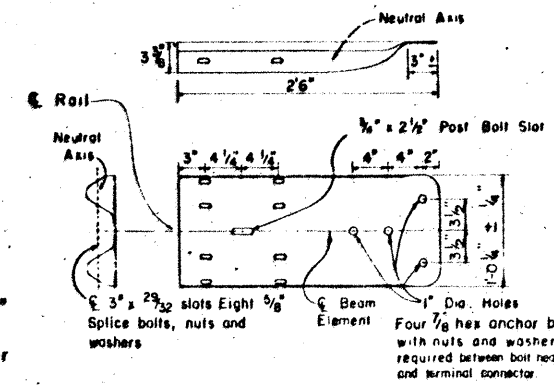


TERMINAL CONNECTOR (10 GAUGE MINIMUM)

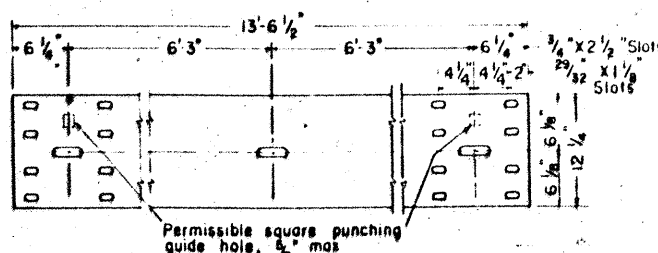


ELEVATION OF NOMINAL 12 1/2 FOOT GUARD RAIL

(25 Foot sections may also be supplied)

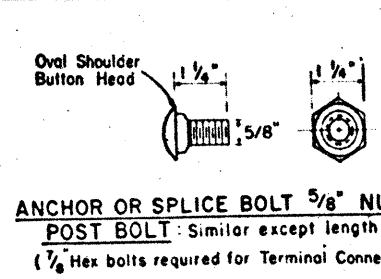

ANCHOR OR SPLICE BOLT 5/8" NUT POST BOLT: Similar except length (1/8" Hex bolts required for Terminal Connector)

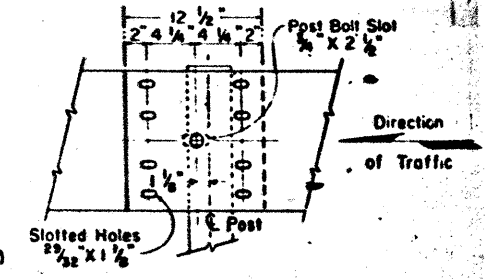

RAIL SPLICE

- GENERAL NOTES**
- THE EXACT POSITION OF GUARD FENCE SHALL BE AS SHOWN ELSEWHERE ON THE PLANS OR AS DIRECTED BY THE ENGINEER. GUARD FENCE SHALL BE TRANSITIONED TO A SMOOTH CONNECTION WITH OTHER GUARD FENCE OR STRUCTURE RAILING AS SHOWN ELSEWHERE ON PLANS.
 - AT THE OPTION OF THE CONTRACTOR THE RAIL ELEMENTS FOR THE GUARD FENCE MAY BE FURNISHED IN EITHER 12 1/2 OR 25 FOOT NOMINAL LENGTHS WITH POST BOLT SLOTS FOR CONNECTION TO POSTS.
 - BOLTS SHALL BE OF SUFFICIENT LENGTH TO EXTEND THROUGH THE FULL THICKNESS OF THE NUT AND NO MORE THAN 3/4" BEYOND IT.
 - THE TOP OF THE TERMINAL ANCHOR POST AND ALL STEEL FITTINGS THEREON SHALL BE GALVANIZED A MINIMUM OF 10" AS SHOWN.
 - WHERE SOLID ROCK IS ENCOUNTERED OR WHERE SHOWN ON THE PLANS, THE DIAMETER OF THE HOLES SHALL BE APPROXIMATELY 12 INCHES. THE BACKFILLING SHALL BE WITH A CONCRETELESS MATERIAL, AND EMBEDMENT DEPTH SHALL BE 1'-6" OR MORE AS DIRECTED BY THE ENGINEER. TIMBER POSTS SHALL NOT BE SET IN CONCRETE.
 - THE TERMINAL ANCHOR POST SHALL BE SET IN CLASS "A", "B" OR "C" CONCRETE IN ACCORDANCE WITH ITEM, "CONCRETE FOR STRUCTURES", OR SET IN CONCRETE IN ACCORDANCE WITH ITEM "CONCRETE PAVEMENT". CONCRETE SHALL BE SUBSIDIARY TO THE BID ITEM REQUIRING CONSTRUCTION OF THE TERMINAL RAIL SECTION AND ANCHORAGE SYSTEM.
 - TIMBER POSTS MAY BE REVEALED AT APPROXIMATELY 10 DEGREES ON THE TOP ON BOTH ENDS WITH RICH SIDE OF TOP OF POST PLACED TOWARD THE ROADWAY OR THEY MAY BE DOMED. WHEN "BLOCKED OUT", THE UPPER PORTION OF THE POST SHALL BE NOTCHED 3/4" TO PROVIDE FLAT SURFACE FOR TIMBER SPACER. A TOLERANCE OF + 1/8" WILL BE PERMITTED ON THE NOTCHED PORTION OF THE POST.
 - AN ANCHOR OTHER THAN A TERMINAL ANCHOR POST SHALL CONSIST OF A CONNECTION SIMILAR TO THE RAIL SPLICE OR SIMILAR TO THE TERMINAL CONNECTOR.
 - SPECIAL FABRICATION WILL BE REQUIRED IN INSTALLATIONS HAVING A CURVATURE OF LESS THAN 150' RADIUS.
 - POST SPACING WILL BE 6' - 3" EXCEPT THAT THE FIRST POST WILL BE 25' FROM THE TERMINAL ANCHOR POST AND THE NEXT TWO POSTS SPACED AT 12' - 6" WITH A MINIMUM OF 8 POSTS ADJACENT TO STRUCTURES SPACED AT 3' - 1 1/2".
 - THE 10 GAUGE TERMINAL CONNECTORS MUST BE USED WITH THE OPTIONAL TERMINAL ANCHOR POST. EITHER ANCHOR POST MAY BE USED WITH EITHER CONCRETE ANCHOR.
 - CROWN WILL BE WIDENED TO ACCOMMODATE GUARD FENCE.
 - STEEL POSTS SHALL BE BLOCKED OUT. A W6x8.5 OR W6x9.0 STEEL SPACER SHALL BE USED WITH STEEL POSTS. BACK-UP PLATES SHALL BE PROVIDED AT INTERMEDIATE (NON-SPLICE) STEEL POSTS.
 - WHEN BLOCKOUT GUARD FENCE IS SPECIFIED ELSEWHERE IN THE PLANS, A 6" x 6" x 14" TREATED TIMBER SPACER OF YELLOW PINE SHALL BE USED WITH WOOD POSTS.
 - UNLESS OTHERWISE SHOWN IN THE PLANS, GUARD FENCE PLACED IN THE VICINITY OF CURVES SHALL BE BLOCKED OUT SO THAT THE FACE OF CURVE IS LOCATED DIRECTLY BELOW OR BEHIND THE FACE OF RAIL. RAIL PLACED OVER CURVES SHALL BE INSTALLED SO THAT THE POST BOLT IS LOCATED APPROXIMATELY 21-INCHES ABOVE THE GUTTER PAN OR ROADWAY SURFACE.
 - WELDED STEEL POSTS AND SPACERS SHALL MEET THE REQUIREMENTS OF ASTM A-759. THE FLANGE WIDTH AND THICKNESS, WEB THICKNESS, AND DEPTH OF WELDED POSTS AND SPACERS SHALL EQUAL OR EXCEED THE DIMENSIONS OF A STANDARD ROLLED W6x8.5.
 - STEEL POSTS AND SPACERS SHALL MEET THE REQUIREMENTS OF ASTM A-36. BOLT HOLES SHALL BE APPROXIMATELY CENTERED BETWEEN WEB AND EDGE OF FLANGE OF SPACERS AND POSTS.
 - UNLESS OTHERWISE SHOWN IN THE PLANS, WOOD SHALL BE PLACED WITH THE FACE OF RAIL DIRECTLY ABOVE THE SHOULDER EDGE (OR CURBFACE) EXCEPT THE 25' TERMINAL ANCHOR SECTION AND ADJACENT 25' OF MBG SHALL BE FLARED AT 25:1 (LONGITUDINAL/LATERAL) TO PROVIDE A 2" OFFSET BETWEEN WELDED ANCHOR AND CURVED FACE (OR CURBFACE). FLARING THE 25' TERMINAL ANCHOR AND ADJACENT 25' MBG IS OPTIONAL FOR ONE-WAY TRAFFIC CONDITIONS ON THE DOWNSTREAM END OF GUARD FENCE.
 - WASHERS USED WITH THE EIGHT 5/8" SPLICE BOLTS AND NUTS THAT ARE PROVIDED FOR TERMINAL CONNECTORS AND OR TERMINAL ANCHOR POSTS SHALL BE 1 3/4" x 3" x 3/16", OR 1" I.D. AND 2" O.D. x 0.113" (ANSI B27.2) SERRATED TYPE A PLAIN WASHERS.
 - BACK-UP PLATES SHALL CONFORM TO THE MATERIALS AND GALVANIZING REQUIREMENTS SPECIFIED FOR THE RAIL ELEMENT, AND SHALL BE OF THE SAME NOMINAL THICKNESS AS THE RAIL ELEMENT USED.

STATE DEPARTMENT OF HIGHWAYS AND PUBLIC TRANSPORTATION

METAL BEAM GUARD FENCE




GF (TD) - 87

(DIST 16)

60

MODIFIED 2/90
MODIFIED GRADE AT TERMINAL ANCHOR POST



NO.	DATE	BY	CHKD.	DATE	BY	CHKD.	STATE	FEDERAL PROJECT NO.	SHEET NO.
1	2/90	ORIGINAL					TEXAS	HE 5 000 5 (606)	60
2		REVISED							
3		REVISED							
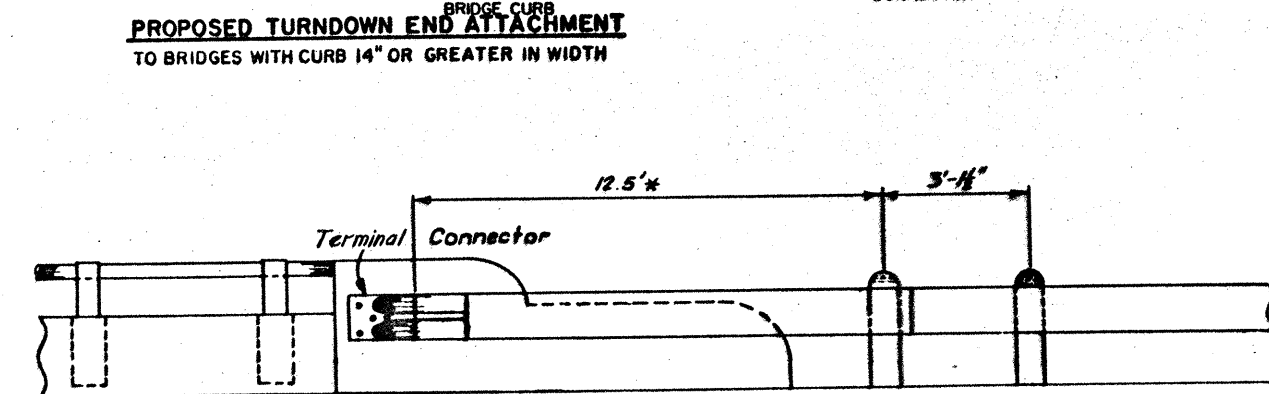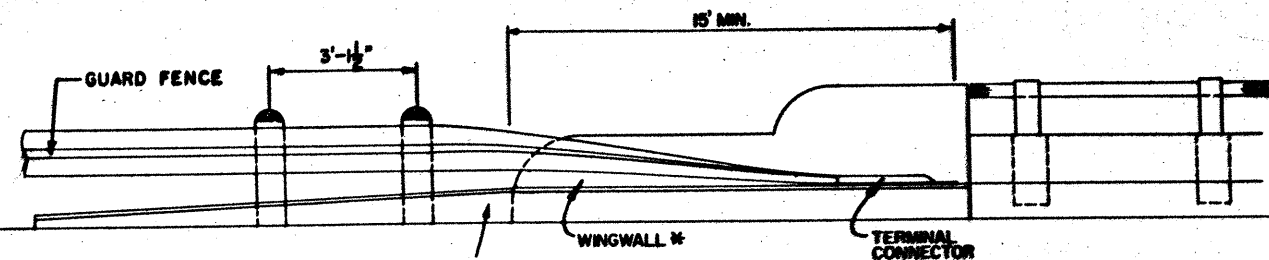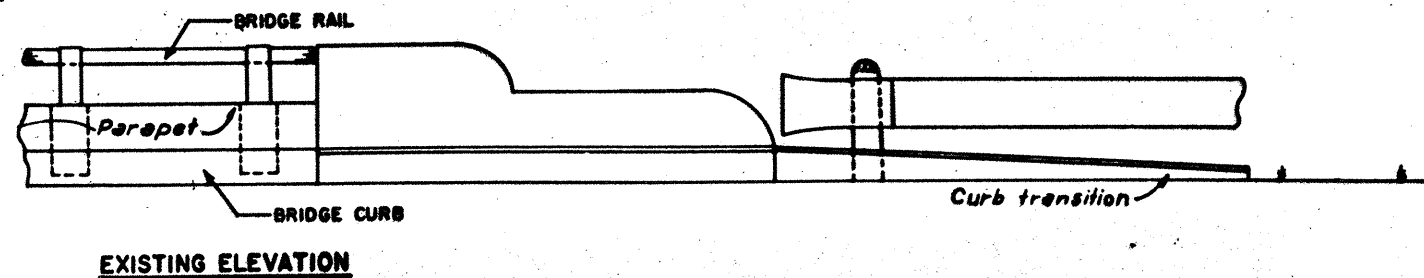


PROPOSED ELEVATION
FOR BRIDGES WITH NO CURB

← TRAFFIC FLOW


* ADDITIONAL POSTS SHOULD BE INSTALLED AT 3'-1 1/2" IF WINGWALL IS CURVED OR FLARED. THIS LENGTH MAY BE FIELD ADJUSTED DEPENDING ON THE STRENGTH AND AMOUNT OF WINGWALL AVAILABLE. THE GUARD FENCE SHOULD BE LOCATED FLUSH WITH THE FACE OF ANY BRIDGE CURB. SPECIAL LENGTH POSTS AND/OR SPECIALLY DESIGNED BLOCKOUTS MAY HAVE TO BE DEvised TO MEET FIELD CONDITIONS.

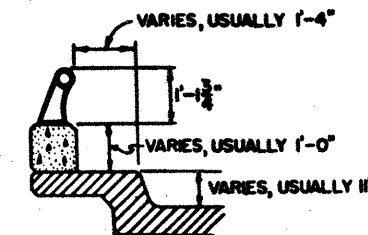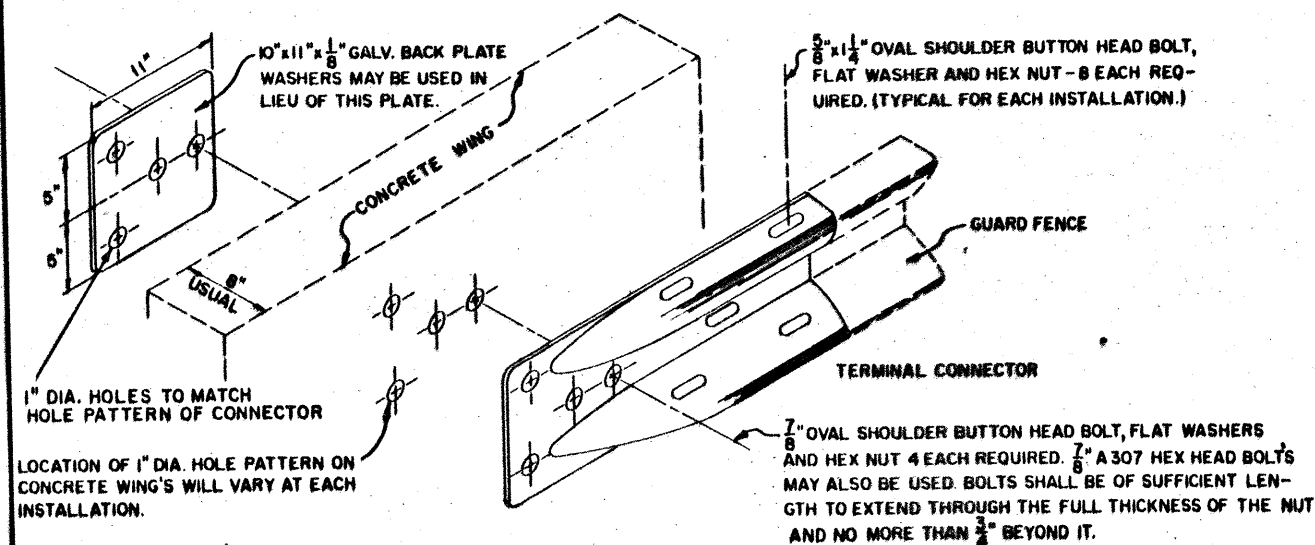

TYPE T RAIL
(ALUMINUM)

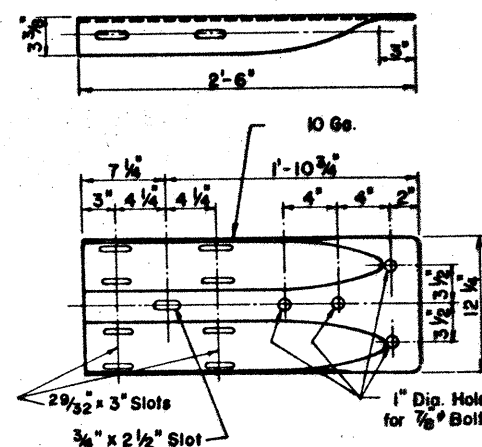

TERMINAL CONNECTOR

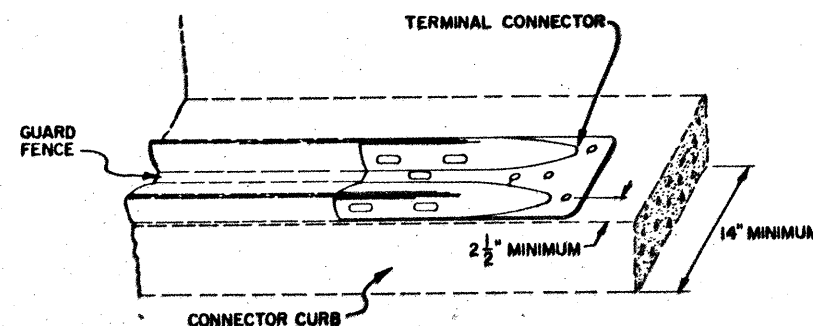

4- 7/8\"/>

EXPANSION TYPE BOLTS MAY BE USED WHICH REQUIRE A DRILLED HOLE ONLY AS LARGE AS THE BOLT

THE GUARD FENCE SHALL BE LAPPED UNDER THE TERMINAL CONNECTOR ON AN APPROACH END AND OVER THE TERMINAL CONNECTOR ON A DEPARTURE END.

GENERAL NOTES

EXCEPT WHERE USED AT STRUCTURES THAT ARE NARROWER THAN CROWN WIDTH OR WHERE OTHERWISE INDICATED ON PLANS, THE GUARD FENCE SHALL NOT INFRINGE ON THE SHOULDER AREA. THE EXACT POSITION SHALL BE AS SHOWN ELSEWHERE ON THE PLANS OR AS DIRECTED BY THE ENGINEER. RAIL SHALL BE TRANSITIONED TO A SMOOTH CONNECTION WITH OTHER STRUCTURES OR RAIL AS SHOWN ELSEWHERE ON THE PLANS.

AT THE OPTION OF THE CONTRACTOR THE RAIL ELEMENTS FOR THE GUARD FENCE MAY BE FURNISHED IN EITHER 12 1/2 OR 25 FOOT NOMINAL LENGTHS. RAIL SHALL BE FURNISHED WITH POST BOLT SLOTS FOR 5/8\"/>

BOLTS SHALL BE OF SUFFICIENT LENGTH TO EXTEND THROUGH THE FULL THICKNESS OF THE NUT AND NO MORE THAN 3/4\"/>

WHERE ROCK IS ENCOUNTERED OR WHERE SHOWN ON THE PLANS, THE DIAMETER OF THE HOLES AND THE MATERIAL FOR BACKFILLING SHALL BE AS DIRECTED BY THE ENGINEER. TIMBER POSTS SHALL NOT BE SET IN CONCRETE.

TIMBER POSTS MAY BE BEVELED AT APPROXIMATELY 10 DEGREES ON THE TOP OR BOTH ENDS WITH HIGH SIDE OF TOP POST PLACED TOWARD THE ROADWAY OR THEY MAY BE DOMED. WHEN "BLOCKED OUT", THE UPPER PORTION OF THE POST SHALL BE NOTCHED 3/4\"/>

IF BLOCKOUTS ARE USED ON BRIDGE RAILS, THEY SHALL BE SPACED AT 8'-3\"/>

FOR BRIDGES 100 FEET AND LESS IN LENGTH, THE APPROACH GUARD FENCE SHALL BE CONTINUED ACROSS THE ENTIRE STRUCTURE. FOR BRIDGES GREATER THAN 100 FEET IN LENGTH, THE GUARD FENCE TREATMENT SHALL BE AS DESCRIBED IN THE PLANS AND/OR AS DIRECTED BY THE ENGINEER.

THE TERMINAL CONNECTOR MAY BE USED WITH THE 18\"/>

AN ANCHOR OTHER THAN TO A TERMINAL ANCHOR POST SHALL CONSIST OF A CONNECTION SIMILAR TO THE RAIL SPLICE, TERMINAL CONNECTOR, OR ANY OTHER CONNECTION DEVELOPING A STRENGTH IN TENSION EQUAL TO A STANDARD SPLICE (8 SPLICE BOLTS).

A GUARD FENCE ANCHOR SECTION 25 FEET IN LENGTH SHALL BE REQUIRED AT THE APPROACH END OF THE GUARD FENCE. A SIMILAR ANCHOR SECTION SHALL BE REQUIRED AT THE DEPARTURE END, IF THE DEPARTURE END BECOMES AN APPROACH SITUATION FROM THE OPPOSITE DIRECTION OR IS NOT ANCHORED IN ANOTHER MANNER. A GUARD FENCE ANCHOR SECTION WILL NOT BE REQUIRED AT THE DEPARTURE END OF A BRIDGE CARRYING ONE-WAY TRAFFIC UNLESS OTHER GUARD FENCE WARRANTS ARE MET.

WHEN TWISTING THE GUARD FENCE, 90° AND ANCHORING IT TO A CURB AND/OR SIDEWALK, THE TERMINAL CONNECTOR SHOULD BE CAREFULLY INSTALLED SO THAT THE SPLICE CONNECTION TO THE GUARD FENCE IS MADE WITH THE BOLTS AT THE EXTREME END OF THE 3 INCH EXPANSION SLOTS SO THAT THERE WILL BE NO SPLICE SLACK IF THE TERMINAL CONNECTOR IS SHOWN FORWARD. IF 10 GAUGE MATERIAL IS USED, THEN FOUR 7/8 INCH BOLTS (A307) ARE NEEDED FOR ANCHORING. IF 12 GAUGE MATERIAL IS USED, SIX 3/4 INCH BOLTS (A307) ARE REQUIRED FOR ANCHORING. THIS ANCHORAGE SHOULD NOT BE PLACED CLOSER THAN 2 1/2 INCHES FROM THE EDGE OF THE CURB.

THE "NESTED BACKUP PLATE TERMINAL DESIGN" MAY BE USED ON APPROACHES TO BRIDGES ONLY IF 175 FEET OR MORE OF GUARD FENCE IS INSTALLED WITH ALL POSTS AT 8'-3\"/>

IF A BRIDGE HAS A CURB AND/OR SIDEWALK, THE GUARD FENCE SHALL BE TRANSITIONED AND ATTACHED SO THAT THE FACE OF THE GUARD FENCE IS FLUSH WITH THE FACE OF THE CURB. IF THE BRIDGE CURB IS LESS THAN 14 INCHES WIDE, THE GUARD FENCE SHALL BE BLOCKED OUT FROM THE EXISTING BRIDGE RAIL SO THAT IT IS FLUSH WITH THE FACE OF THE CURB. IF THE BRIDGE CURB AND/OR SIDEWALK IS GREATER THAN 14 INCHES WIDE, THE GUARD FENCE SHALL BE TWISTED 90° AND ANCHORED TO THE CURB AND/OR SIDEWALK SO THAT IT IS FLUSH WITH THE FACE OF THE CURB. EITHER OF THESE ANCHORAGE SYSTEMS SHALL BE CARRIED A MINIMUM OF 16 FEET ONTO THE BRIDGE, IF POSSIBLE.

STEEL POSTS SHALL BE SET IN CONCRETE AND BLOCKED OUT.


THE TOP OF THE TERMINAL ANCHOR POST ASSEMBLY AND ALL STEEL FITTINGS THEREON SHALL BE GALVANIZED AS SHOWN. THE TERMINAL ANCHOR POST SHALL BE SET IN CLASS "A", "B" OR "C" CONCRETE IN ACCORDANCE WITH ITEMS "CONCRETE FOR STRUCTURES" OR "CONCRETE PAVEMENT". CONCRETE SHALL BE SUBSIDIARY TO THE BID ITEM "METAL BEAM GUARD FENCE".

POST SPACING WILL BE 8'-3\"/>

STATE DEPARTMENT OF HIGHWAYS AND PUBLIC TRANSPORTATION	
GUARD FENCE ATTACHMENT TO BRIDGE RAIL TYPE T (ALUMINUM)	
61 GF(3)	
ORIGINAL DRAWING DATE: 12-78	STATE FEDERAL AID PROJECT
DN: 6-12-80	16 6 RES 0009 (606) 61
CR: 6-12-80	COUNTY CONTROL SECTION JOB
CR: 6-12-80	NUECES 74 6 164 (5818)

WORK ZONE PAVEMENT MARKINGS

Raised Markers

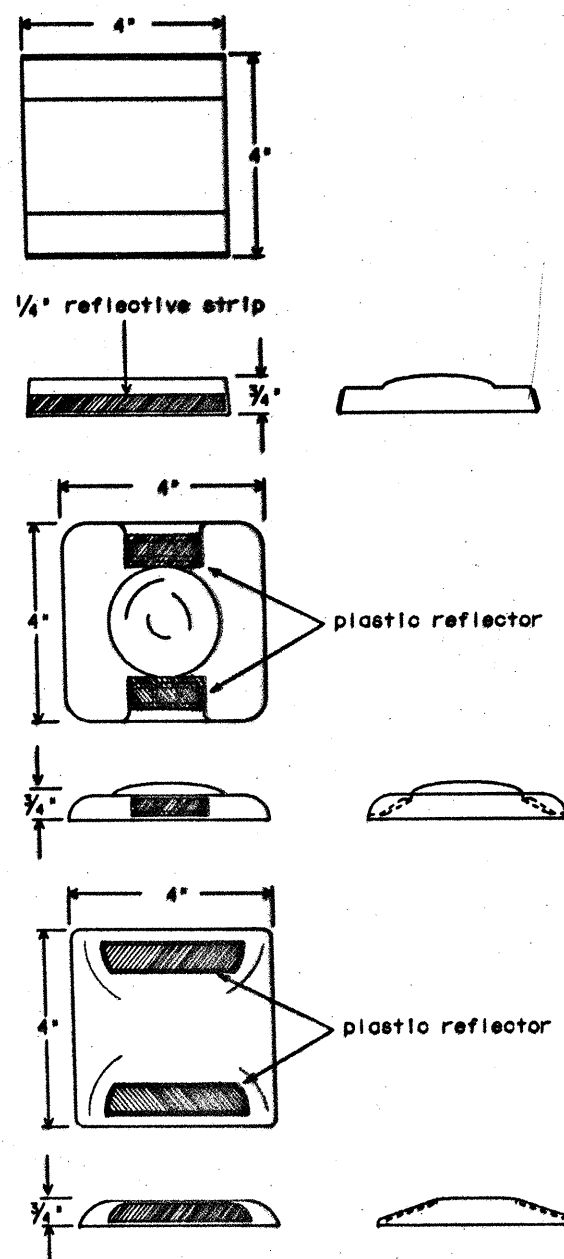

NOTES FOR WORK ZONE PAVEMENT MARKINGS

GENERAL

- 1) This sheet is to be used in conjunction with Standard Sheet TCP(5-2).
- 2) Dimensions indicated on this sheet are typical and approximate. Variations in size and height may occur between markers or devices made by manufacturers, by as much as 1/4 inch, unless otherwise noted.
- 3) Raised markers and temporary flexible-reflective roadway marker tabs will require normal maintenance replacement when used on roadways with an ADT per lane of up to 7500 vehicles with no more than 10% truck mix. When roadways exceed these values additional maintenance replacement of devices should be planned, or permanent individual unit pavement markings used, as detailed on sheets IPM(1), IPM(2), PM(0), PM(1), PM(2), PM(3) or as detailed elsewhere in the plans.

RAISED MARKERS

General

- 1) Raised Markers detailed on this sheet will be designated Type AA (two amber reflective surfaces with yellow body), Type A (one amber reflective surface with yellow body) or Type C (one silver reflective surface with white body). Color used shall be in accordance with the TMUTCD.

Sampling & Testing

- 1) Pavement Markings detailed on this sheet are to be inspected and accepted by the Project Engineer or designated representative. Sampling and testing is not normally required.

ABBREVIATED PAVEMENT MARKINGS

General

- 1) Temporary flexible-reflective roadway marker tabs detailed on this sheet will be designated Type Y-2 (two amber reflective surfaces with yellow body), Type Y (one amber reflective surface with yellow body), and Type W (one silver reflective surface with white body).

Material

- 1) Temporary flexible-reflective roadway marker tabs shall meet requirements of Department Material Specification D-9-8242.
- 2) The body of the temporary flexible-reflective roadway marker tabs shall consist of a base and vertical wall made of polyurethane, polyester elastomer or other material approved by the Materials and Tests Division.
- 3) The reflective material shall be protected with an easily removable heat resistant transparent cover capable of withstanding and protecting the reflective material from the application of 400 degree F asphalt. Stapling or clipping devices used to retain the protective cover shall not protrude through the reflective material.

Sampling & Testing

- 1) Temporary flexible-reflective roadway marker tabs for seal coat projects detailed on this sheet are to be inspected and accepted by the Project Engineer or designated representative. Sampling and testing is not normally required, however at the option of the Engineer, either "A" or "B" below may be imposed to assure quality before placement on the roadway.
 - A) Select five (5) or more temporary flexible-reflective roadway marker tabs at random from each lot or shipment and submit to the Materials and Tests Division to determine specification compliance.
 - B) Select five (5) temporary flexible-reflective roadway marker tabs and submit to the following test. Affix five (5) tabs at two (2) foot intervals on an asphaltic pavement in a straight line. Using a medium size passenger vehicle or pickup, run over the markers with front and rear wheels at a speed of 35 to 40 miles per hour, four times in each direction. No more than one (1) out of five reflective surfaces shall be lost or displaced as a result of this test.

Maintenance

- 1) When dry, the temporary flexible-reflective roadway marker tabs shall be visible for a minimum distance of 200 feet during normal daylight hours and when illuminated by automobile low-beam head light at night, unless sight distance is restricted by roadway geometrics.
- 2) No two consecutive tabs nor four tabs per 1000 feet of line shall be missing or fail to meet the visual performance requirements of note 1.
- 3) The Contractor will be responsible for maintaining the abbreviated pavement markings, when they are used, until the standard pavement markings are in place. When the Contractor is responsible for placement of the standard pavement markings, no segment of roadway shall remain without standard pavement markings for a period greater than two (2) weeks unless weather conditions prohibit placement. The standard pavement markings shall be placed as soon as weather permits.
- 4) After 72 hours following the seal coat operation, provided the standard pavement markings have not been placed, any temporary flexible-reflective roadway marker tabs not meeting the visibility requirements stated in note 1, shall be replaced as directed by the Engineer.

REMOVABLE - PREFABRICATED PAVEMENT MARKINGS

Sampling & Testing

- 1) Removable - Prefabricated Pavement Markings shall be a material of manufacture and product code or designation shown on the list of approved materials covered by the Department Materials Specification D-9-8241. The list of approved materials may be obtained from the Equipment and Procurement Division.


CONSTRUCTION GRADE - PREFABRICATED PAVEMENT MARKINGS (FOIL BACK)

Sampling & Testing

- 1) Construction Grade - Prefabricated Pavement Markings shall be a material of manufacture and product code or designation shown on the list of approved material covered by the Specification SDHPT - 550-74-01. The list of approved materials may be obtained from the Equipment and Procurement Division.

WORK ZONE PAVEMENT MARKINGS

Temporary Flexible-Reflective Roadway Marker Tabs for Seal Coat Projects

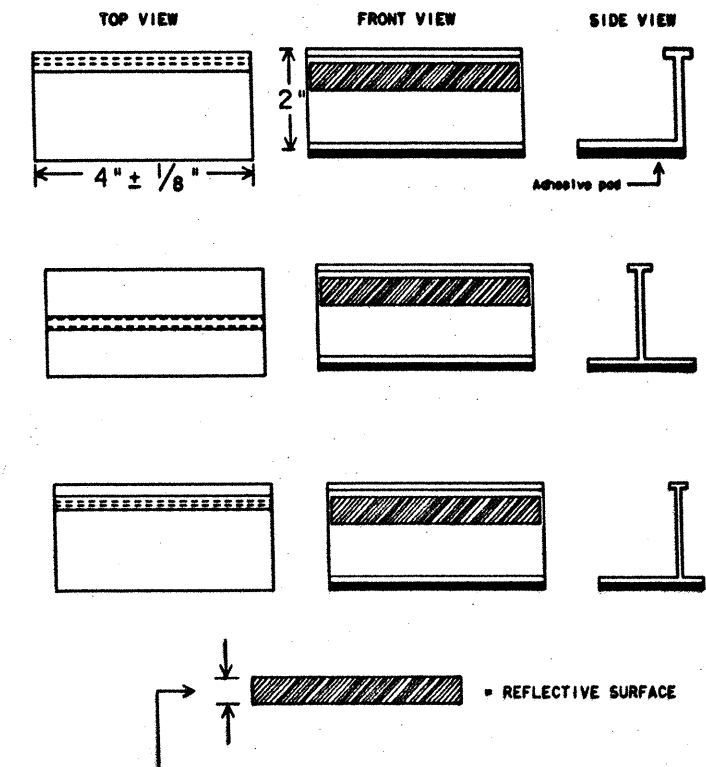

Height of sheeting will be determined by Note 1 under Maintenance of ABBREVIATED PAVEMENT MARKINGS. Usually more than .2 inch and less than 1 inch.

PREQUALIFICATION PROCEDURES MAY BE OBTAINED BY WRITING:

EQUIPMENT AND PROCUREMENT DIVISION
STATE DEPT. OF HIGHWAY & PUBLIC TRANS.
125 EAST 11th STREET
AUSTIN, TX 78701-2483

SPECIFICATION REFERENCE TABLE MATERIALS AND TEST SPECIFICATIONS (D-9)

PREFABRICATED PAVEMENT MARKINGS-REMOVABLE D-9-8241
TEMPORARY FLEXIBLE-REFLECTIVE ROADWAY MARKER TABS D-9-8242



STANDARD PLANS
STATE DEPARTMENT OF HIGHWAYS
AND PUBLIC TRANSPORTATION


WORK ZONE
PAVEMENT MARKINGS

(1 of 2)

TCP(5-1)-91


ORIGINAL DRAWING DATE: 5-88	STATE DISTRICT: 16	FEDERAL AID PROJECT: HES 0005 (606)	SHEET: 62
DATE: 3-91	QUANTITY: 14	CONTROL: 06	SECTION: 14

WORK ZONE PAVEMENT MARKINGS DETAILS

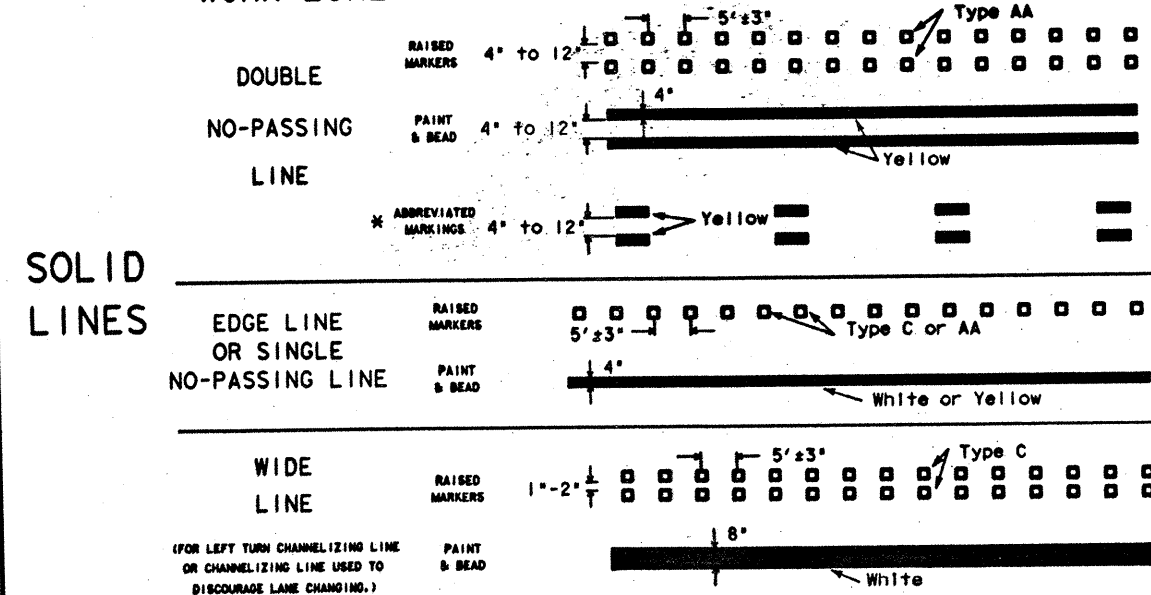

BROKEN LINE


(FOR CENTER LINE OR LANE LINE.)

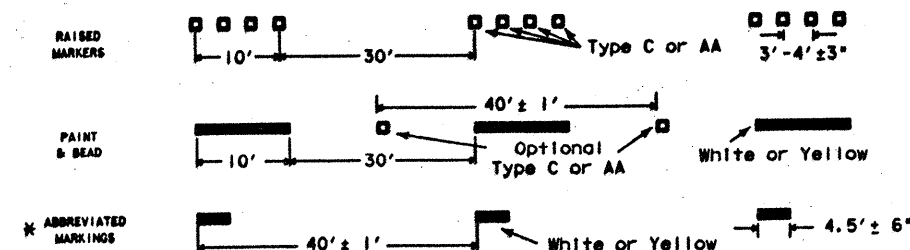

NOTES FOR STANDARD WORK ZONE PAVEMENT MARKINGS

- Standard Work Zone Pavement Markings may be of paint and beads, raised markers or combination of paint and raised markers. Thermoplastic paint and beads may be used in lieu of paint and beads unless otherwise specified elsewhere in the plans. Abbreviated marking patterns are not to be used for standard pavement markings.
- Raised markers detailed on TCP(5-1) are to be placed according to the patterns on this sheet. Standard, permanent, raised markers as detailed on sheets IPM(1) and IPM(2) shall be placed according to patterns on sheets IPM(1), IPM(2), PM(0), PM(1), PM(2) or PM(3).
- For additional details on Work Zone pavement markings see sheet TCP(5-1).
- Spacing for pavement markings on this sheet are maximum spacings and may be reduced to fit field conditions.
- Adhesive used for work zone raised pavement markings shall be Bituminous material hot applied, or Butyl Rubber/pad.
- Channelizing (wide) lines shall be minimum 8' wide.

ABBREVIATED (SHORT TERM) PAVEMENT MARKING DETAILS

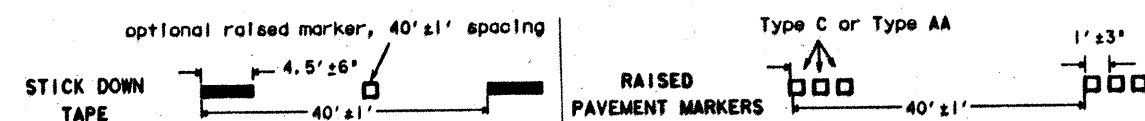




NOTES FOR ABBREVIATED (SHORT TERM) PAVEMENT MARKINGS

- Abbreviated pavement marking materials may be stick down tape, raised markers or paint and beads unless otherwise specified elsewhere in the plans.
- Abbreviated pavement markings for seal coat projects shall use temporary flexible-reflective roadway marker tabs. Temporary flexible-reflective roadway marker tabs are to be installed to provide true alignment for striping crews as directed by the Engineer.
- Temporary flexible-reflective roadway marker tabs for seal coat projects should be applied to the pavement no more than two days before the seal coat is applied. After the seal coat is rolled and swept the cover over the reflective strip shall be removed, and standard markings installed.
- Abbreviated pavement markings shall not be used to simulate edge lines.




USE OF ABBREVIATED (SHORT TERM) PAVEMENT MARKINGS

- On low volume two lane roadways, 4000 ADT or less, signs may be used to indicate no-passing zones for up to two weeks. Standard centerline markings should be placed within two weeks.
- On two lane roadways with more than 4000 ADT, signs may be used to indicate no-passing zones for up to three days. Standard centerline markings should be placed within three days.
- On undivided highways with four or more lanes, standard centerline and lane line pavement markings should be in place at the end of each workday on roadways open to traffic. On divided highways, abbreviated markings may be used for lane lines for up to two weeks. Standard markings should be in place after two weeks.



PAVEMENT MARKING PATTERNS

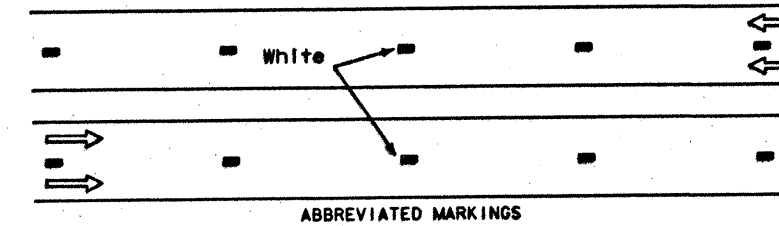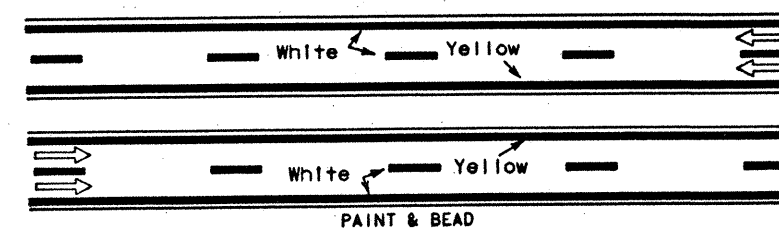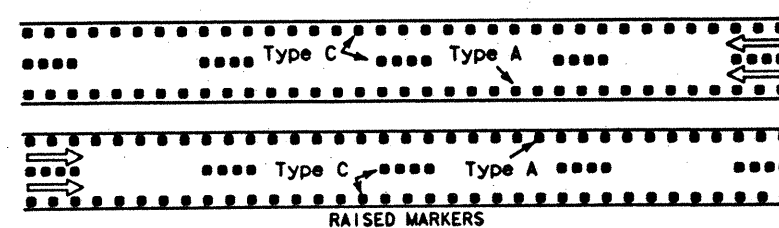




EDGE & LANE LINES FOR DIVIDED HIGHWAY

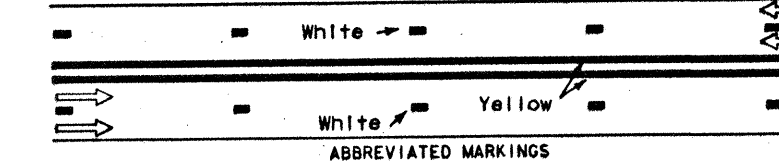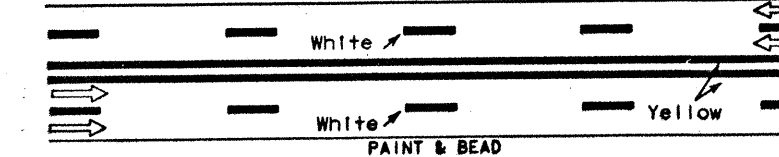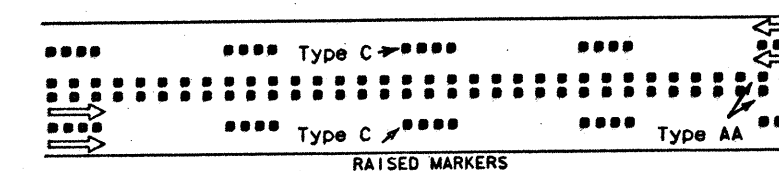

LANE & CENTER LINES FOR MULTILANE UNDIVIDED HIGHWAYS



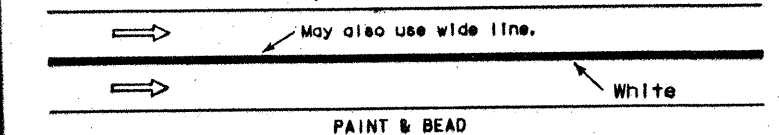
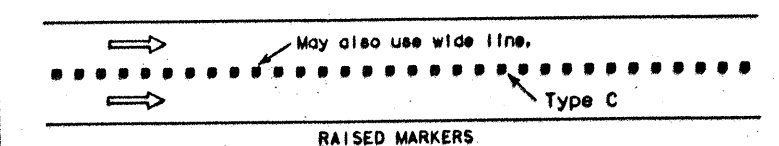


CHANNELIZING LINE TO DISCOURAGE LANE CHANGING

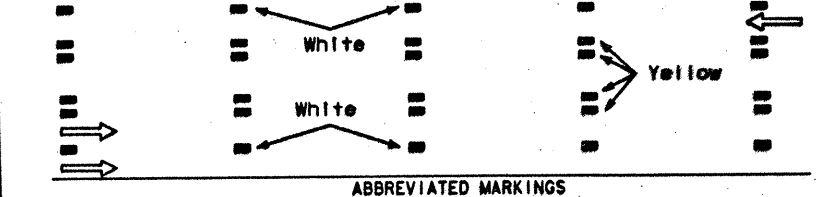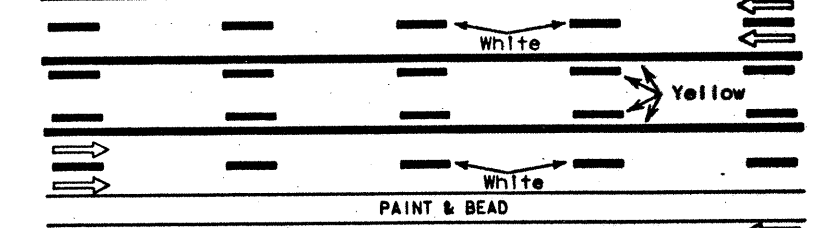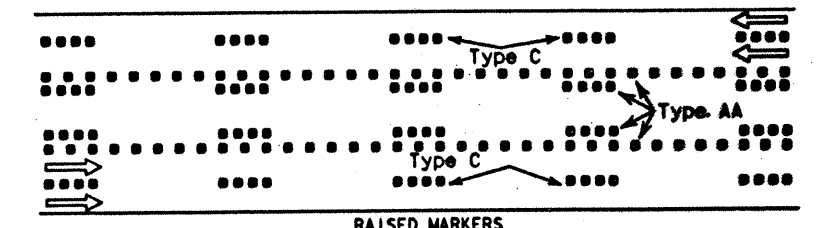

PAVEMENT MARKINGS FOR TWO-WAY LEFT TURN LANE


CENTER LINE & NO-PASSING ZONE BARRIER LINES FOR TWO LANE TWO-WAY HIGHWAYS

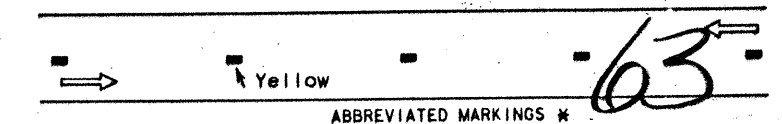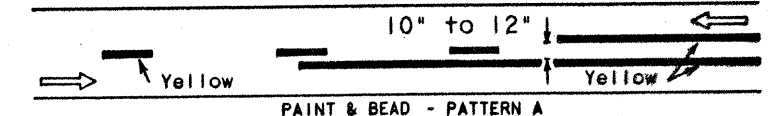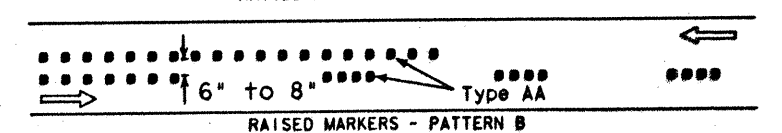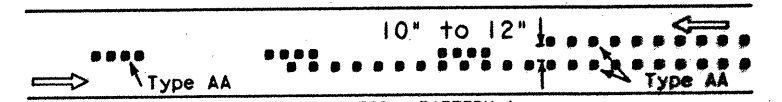


NOTE

- Spacing between markers shall be uniform with no more than a 10% variation in spacing.
- Pattern A is the Department Standard. Pattern B may be used if approved by the Engineer.
- When abbreviated markings are used in areas of no-passing zones, signs in accordance with the TMUTCD shall be used to indicate the limits of the no-passing zones.


STANDARD PLANS STATE DEPARTMENT OF HIGHWAYS AND PUBLIC TRANSPORTATION									
WORK ZONE PAVEMENT MARKINGS (2 of 2) TCP(5-2)-91									
ORIGINAL DRAWING DATE: 5-88	STATE: 16	FEDERAL REGION: 6	FEDERAL AID PROJECT: 6005000	SHEET: 191					
DATE: 6-89	COUNTY: 16	SECTION: 74	JOB: 164	191					
DATE: 3-91	COUNTY: 16	SECTION: 74	JOB: 164	191					

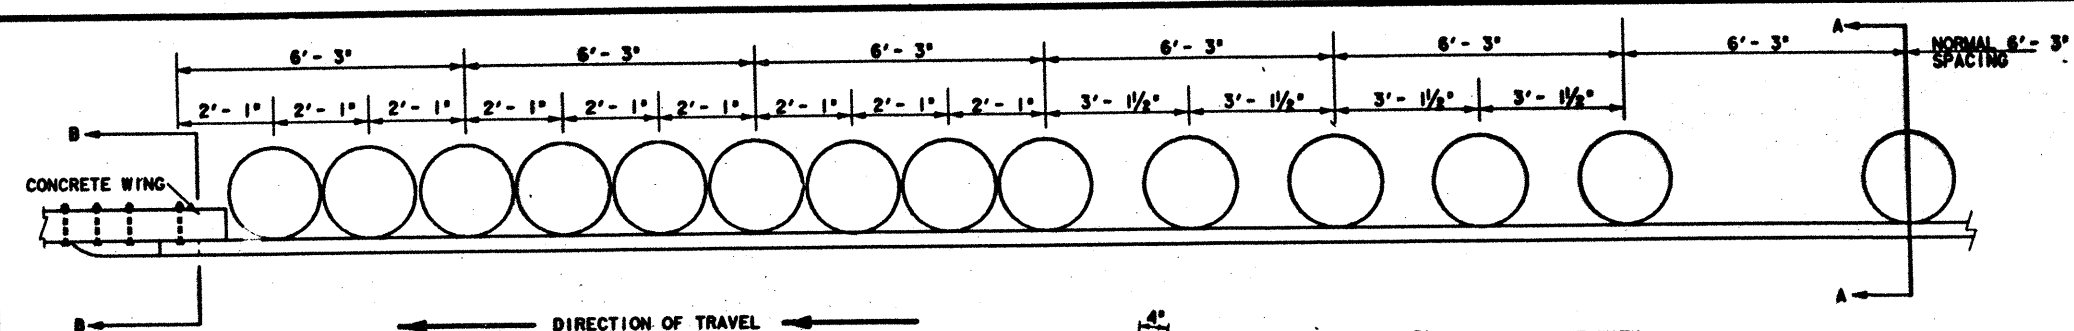

PLAN VIEW
ATTACHMENT TO BRIDGE RAIL
OR CONCRETE TRAFFIC BARRIER

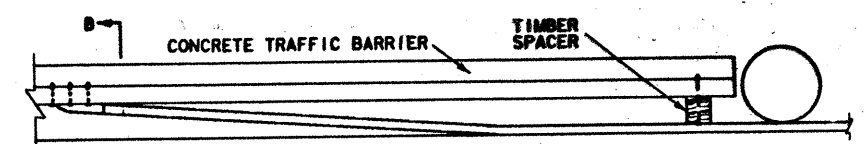


WHEN ATTACHING RAIL ELEMENTS TO TRAFFIC BARRIER, A 4" X 6" X 1/4" TREATED TIMBER SPACER SHALL BE REQUIRED AND THE RAIL ELEMENT SHALL BE EXTENDED AN ADDITIONAL 12'-6" BEYOND THE BLOCKOUT.

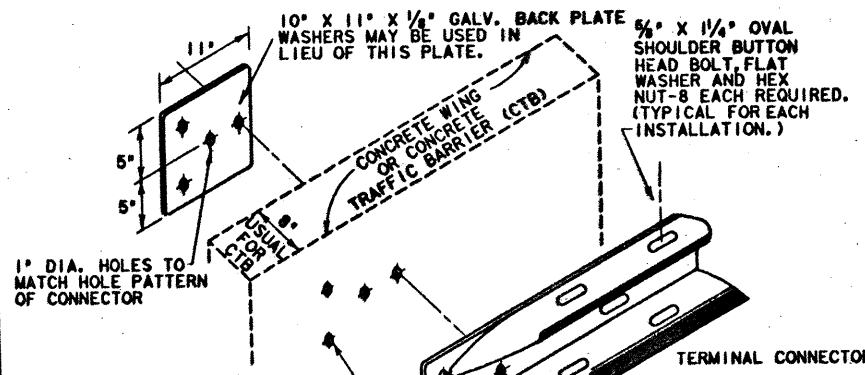


10" X 11" X 1/2" GALV. BACK PLATE WASHERS MAY BE USED IN LIEU OF THIS PLATE.


ATTACHMENT TO BRIDGE RAIL
OR CONCRETE TRAFFIC BARRIER
SECTION B-B

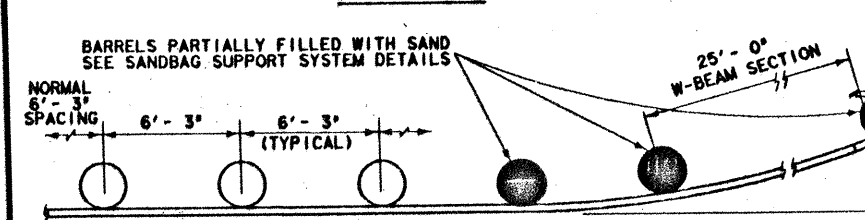

PLAN

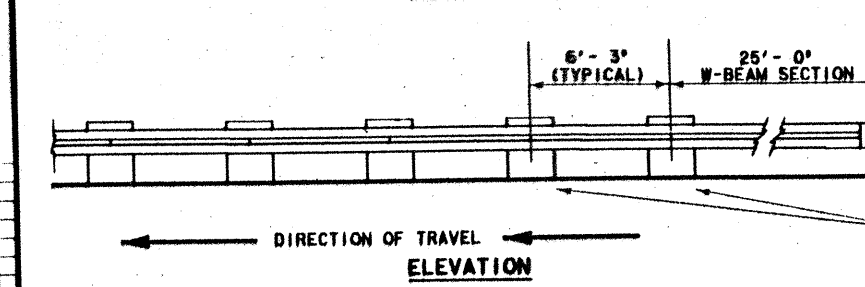


ELEVATION


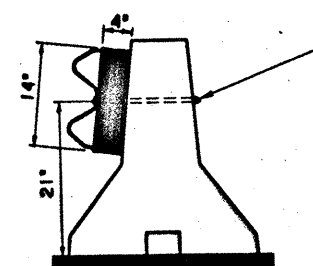


CONCRETE TRAFFIC BARRIER
SHOWING BLOCKOUT


ONE 3/4" BOLT AND NUT WITH 1-3/4" O.D. WASHER, 1/4" HOLE IN SPACER AND CONCRETE TRAFFIC BARRIER. BOLT LENGTH SHALL BE SUFFICIENT TO EXTEND THROUGH THE FULL THICKNESS OF THE NUT AND NO MORE THAN 1/4" BEYOND IT.

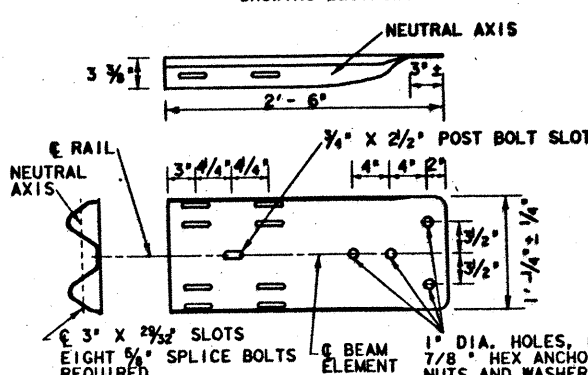


TERMINAL CONNECTOR
(10 GAUGE MINIMUM)

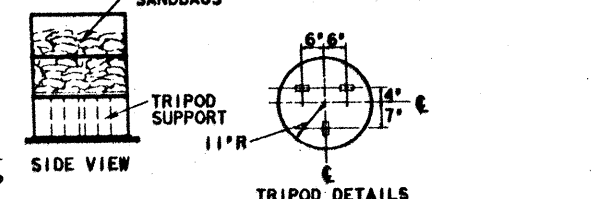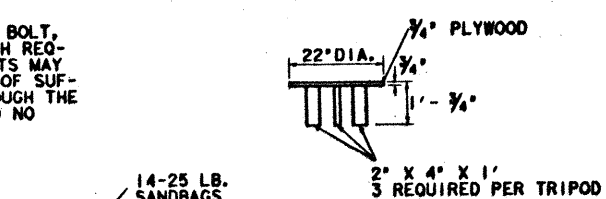



SANDBAG SUPPORT SYSTEM
(THREE BARRELS ON APPROACH END)

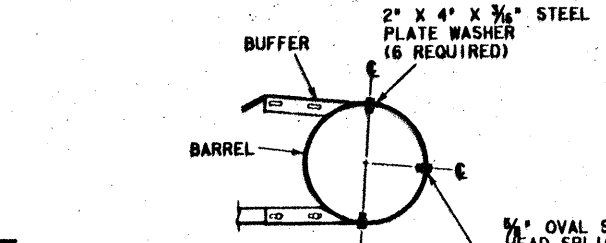


BARREL CONNECTION DETAILS

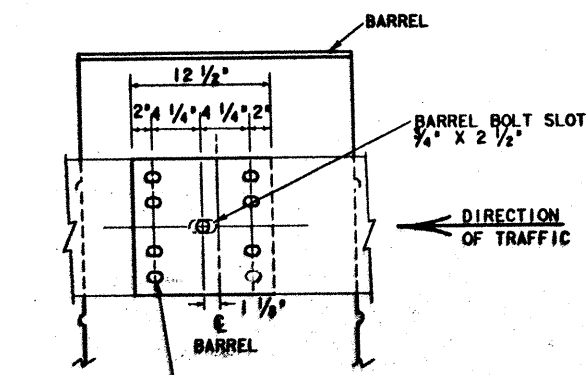

RAIL SPLICE

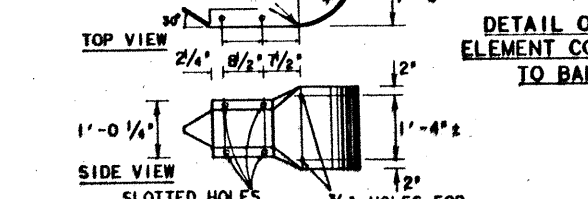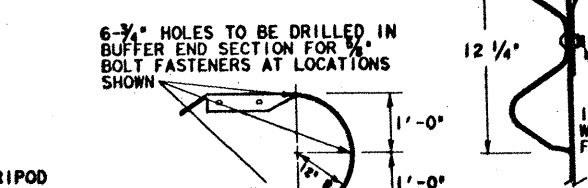


W-BEAM END SECTION (BUFFER)
DETAIL

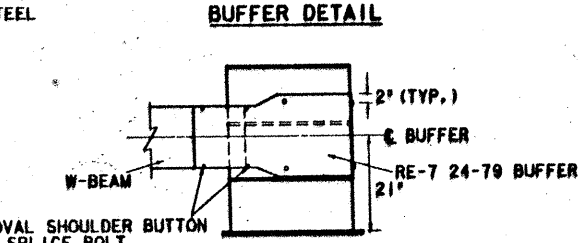


BARREL CONNECTION DETAILS

- GENERAL NOTES**
1. RAIL ELEMENT MAY BE EITHER 12.5 OR 25 FOOT LENGTHS, EXCEPT A 25 FOOT LENGTH IS REQUIRED ON THE APPROACH TERMINAL, AND EITHER 10 OR 12 GAUGE.
 2. MINIMUM LENGTH OF PLACEMENT EQUALS 100 FEET EXCEPT WHERE BOTH ENDS ARE CONNECTED TO A POSITIVE BARRIER (BRIDGE RAIL, CTB, ETC.) MINIMUM LENGTH OF PLACEMENT EQUALS 75 FEET WHERE ONE END IS CONNECTED TO A POSITIVE BARRIER.
 3. WHEN THE ROADWAY SURFACE IS ASPHALT, PLYWOOD SHALL BE PLACED UNDER THE BARRELS TO PREVENT DAMAGE TO THE PERMANENT ASPHALTIC PAVEMENT.
 4. LOCATION OF BARREL MOUNTED GUARD FENCE IS SHOWN ELSEWHERE IN THE PLANS.
 5. RAIL ELEMENT SPLICES SHALL BE LAPPED IN THE DIRECTION OF TRAFFIC.
 6. RAIL SPLICES SHALL BE CONNECTED WITH THE NORMAL EIGHT 1 1/4" LONG OVAL SHOULDER BUTTON HEAD BOLTS WHICH ARE 3/4" IN DIAMETER.
 7. BARREL SPACING SHALL BE 6'-3", EXCEPT CLOSER SPACING SHALL BE USED AS SHOWN TO TRANSITION INTO A CONNECTION WITH A BRIDGE RAIL, CONCRETE TRAFFIC BARRIER, OR SIMILAR FIXED OBJECT. WHEN USED AS A TRANSITION SPACING OF BARRELS SHOULD BE (FROM FRONT BARREL) ONE SPACE AT 25', 3 SPACES AT 6'-3", 4 SPACES AT 3'-1 1/2" AND 8 SPACES AT 2'-1".
 8. DRAINAGE HOLES SHALL BE DRILLED IN THE BOTTOM OF THE BARRELS TO ALLOW FOR DRAINAGE OF WATER.
 9. APPROACH END OF THE TEMPORARY BARRIER SHALL BE FLARED AWAY FROM THE ROADWAY AND SHALL BE TREATED AS SHOWN.
 10. IF THE BARRIER IS USED AS A CHANNELIZING DEVICE IN NIGHTTIME SITUATIONS, IT SHALL BE SUPPLEMENTED BY DELINEATION OR CHANNELIZATION MARKINGS OR DEVICES, REFLECTORIZED MARKINGS ON DRUMS AS DETAILED ON THE BC STANDARD SHEETS, OR VERTICAL PANELS, OR DELINEATORS SHALL BE USED TO PROVIDE SUPPLEMENTAL DELINEATION.

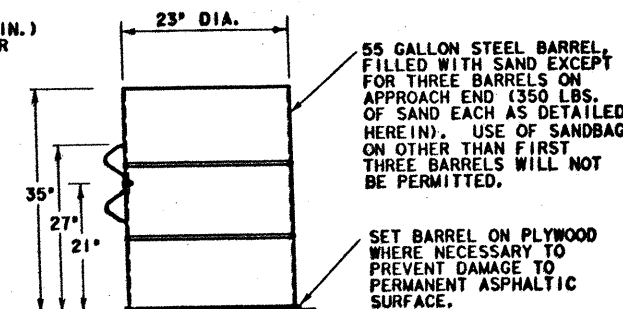

SECTION A-A

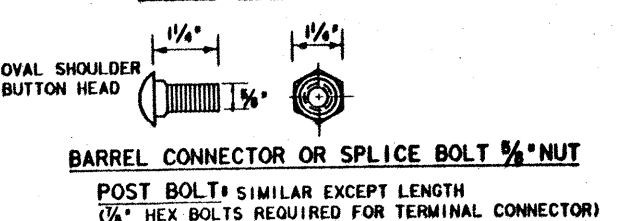

BARREL CONNECTOR OR SPLICE BOLT 3/4" NUT
POST BOLT: SIMILAR EXCEPT LENGTH
(3/4" HEX BOLTS REQUIRED FOR TERMINAL CONNECTOR)

STATE DEPARTMENT OF HIGHWAYS
AND PUBLIC TRANSPORTATION

TEMPORARY BARRIER
BARREL-MOUNTED GUARD FENCE

TB (BMGF)-88

64

REVISIONS	FED. NO.	STATE	FEDERAL AID PROJECT NO.	SHEET NO.
	6	TEXAS	HE50005(606)	64
	16	HUECES	74 6 164/05/18	164

† Precast versions of this detail may be covered by patents held by The Reinforced Earth Company. The Contractor shall indemnify and save harmless the State from all claims for infringement by reason of the use of the process by others without the consent of The Reinforced Earth Company.

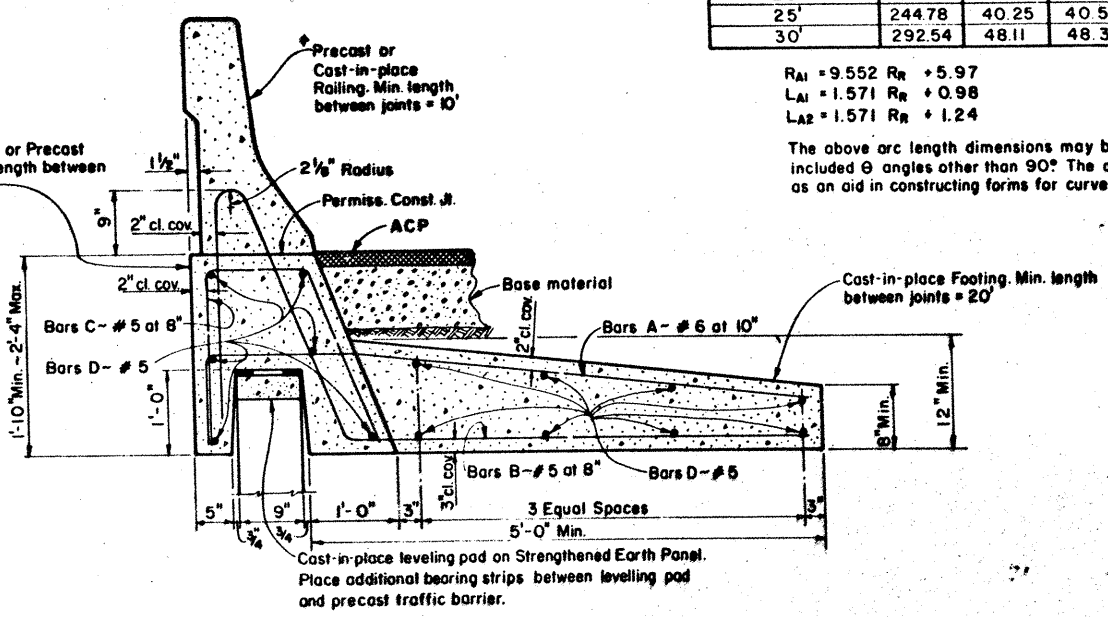
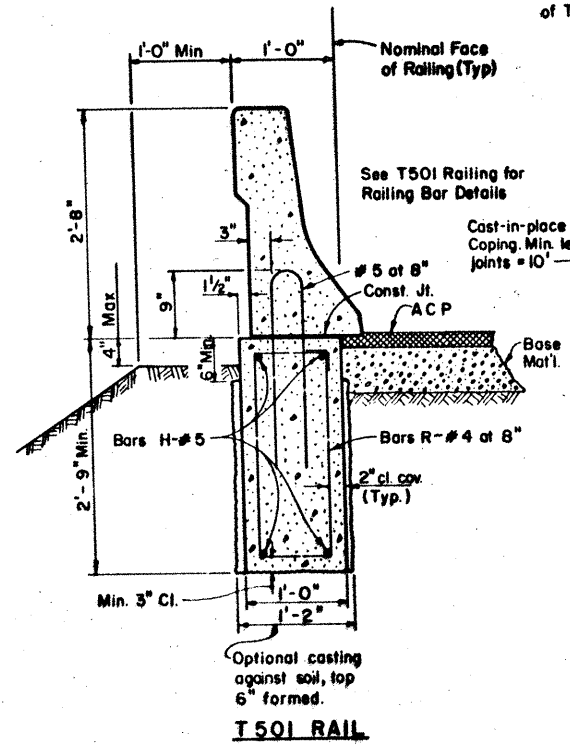


TABLE OF DEVELOPED SURFACES DIMENSIONS FOR $\theta = 90^\circ$						
Reference Radius R_R to Back of Rail	Radius		Arc Length		Radius	
	R_{A1} ft.	L_{A1} ft.	L_{A2} ft.	R_{B1} ft.	L_{B1} ft.	L_{B2} ft.
10'	101.50	16.69	16.95	18.82	16.95	17.87
15'	149.26	24.54	24.81	27.54	24.81	25.72
20'	197.02	32.40	32.66	36.26	32.66	33.58
25'	244.78	40.25	40.51	44.98	40.51	41.43
30'	292.54	48.11	48.37	53.69	48.37	49.28

$$R_{A1} = 9.552 R_R + 5.97$$

$$L_{A1} = 1.571 R_R + 0.98$$

$$L_{A2} = 1.571 R_R + 1.24$$



$$R_{B1} = 1.744 R_R + 1.38$$

$$L_{B1} = 1.571 R_R + 1.24$$

$$L_{B2} = 1.571 R_R + 2.16$$

The above arc length dimensions may be linearly ratioed for included θ angles other than 90° . The dimensions are intended as an aid in constructing forms for curved T501 Railing.

DESIGN NOTE: The curved end treatment at bridge ends should only be used in areas where traffic speed is 40 mph or less.

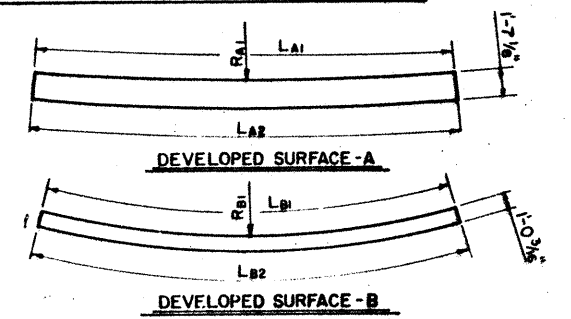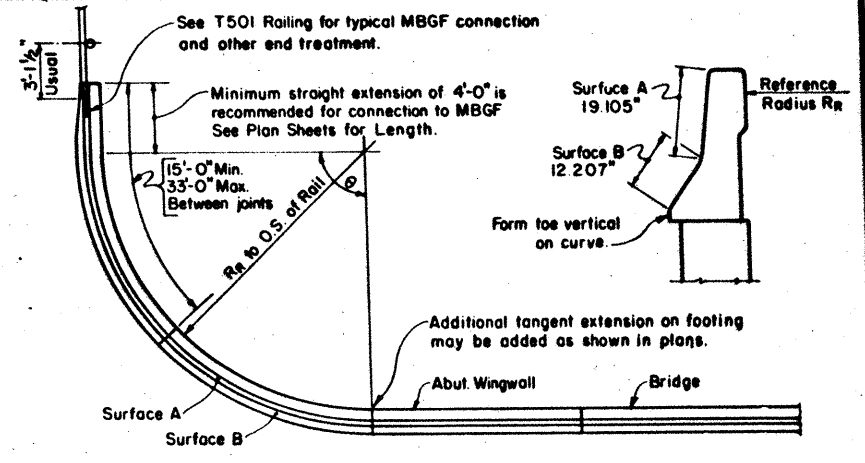

GENERAL NOTES:

The foundations indicated are suitable for mounting typical concrete bridge barrier type railings. The design resistance is based on the current AASHTO bridge railing requirements with the assumption of fair to good soil support conditions. Poor soil conditions will require suitably deeper foundations.

The primary use of the curved railing detail is to avoid the necessity of curved MBGF at the ends of bridges adjacent to at grade intersections.




All concrete shall be Class C or better and all reinforcement shall be Grade 60.

This detail is intended for use as a guide to unusual railing anchorage situations but may be included in the plans, modified as necessary to apply to specific installations required on the project.

For railing installed on retaining walls, the railing foundation will be considered subsidiary to the item "Retaining Walls".

Payment for railing foundations will be by CY of Class C Concrete except those copings and/or footings necessary for strengthened earth retaining walls shall be considered subsidiary to the item "Retaining Walls". The associated bridge railing will be paid for by the linear foot which includes the concrete and reinforcement.

Excavation will be considered subsidiary to other items.

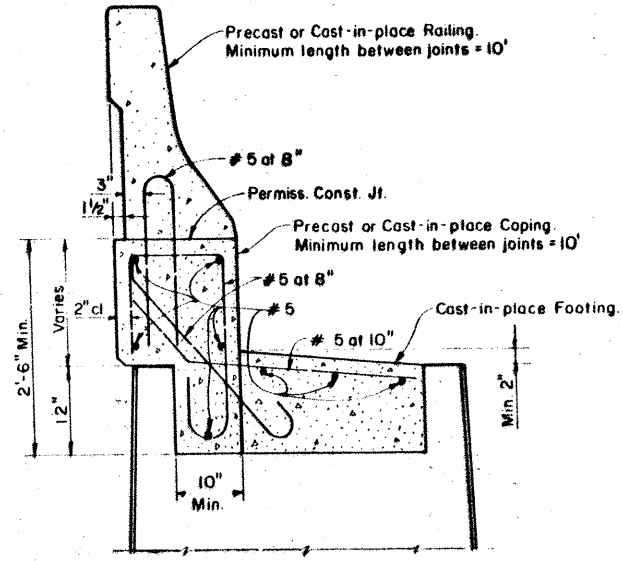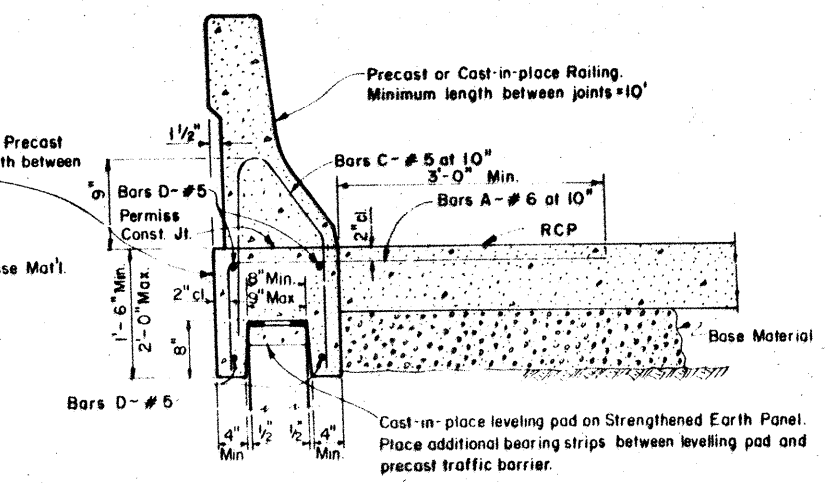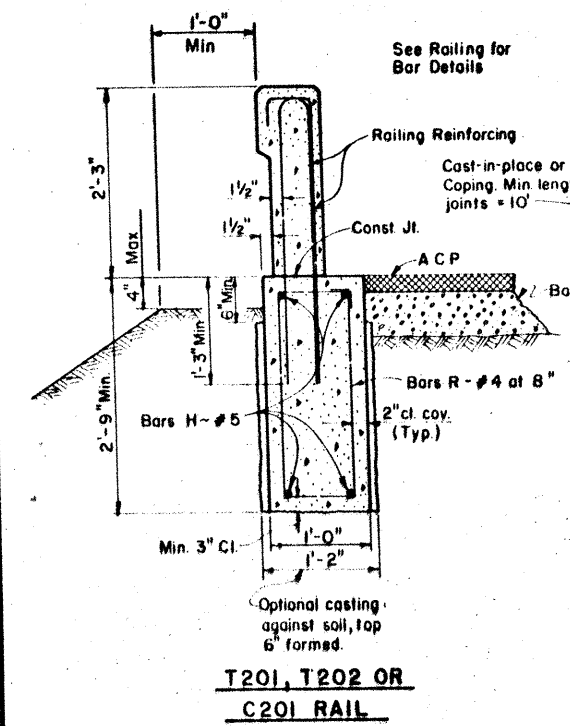

NOTE: The configurations shown for railing anchorage on strengthened earth walls may be used, or other similar configurations of equivalent strength may be submitted for approval by the Engineer.

NOTE: The configurations shown for railing on Doublewall walls may be used, or other similar configurations of equivalent strength may be submitted for approval by the Engineer.

NOTE: The above footings for T501, T201, or T202 Railing have approx. CIO C.Y. per L.F. of Concrete and 10.77 lbs. per L.F. of reinforcement.

STATE DEPARTMENT OF HIGHWAYS
AND PUBLIC TRANSPORTATION

**BRIDGE TRAFFIC
RAILING FOUNDATIONS**

65 TRF

ORIGINAL DRAWING DATE	JUNE 1985	STATE	FEDERAL	FEDERAL AID PROJECT	0	SHEET	
BY	JTP	REVISIONS	16	6	HE30005(606)	65	
CD	MM	Rev. 8 85	12	H/Added note			
DR	ET	Rev. 1 88 (Per Notes)					
CR	JTP	Jan 89 (Payment, Fig)					

APPENDIX PLANS 12-A-50







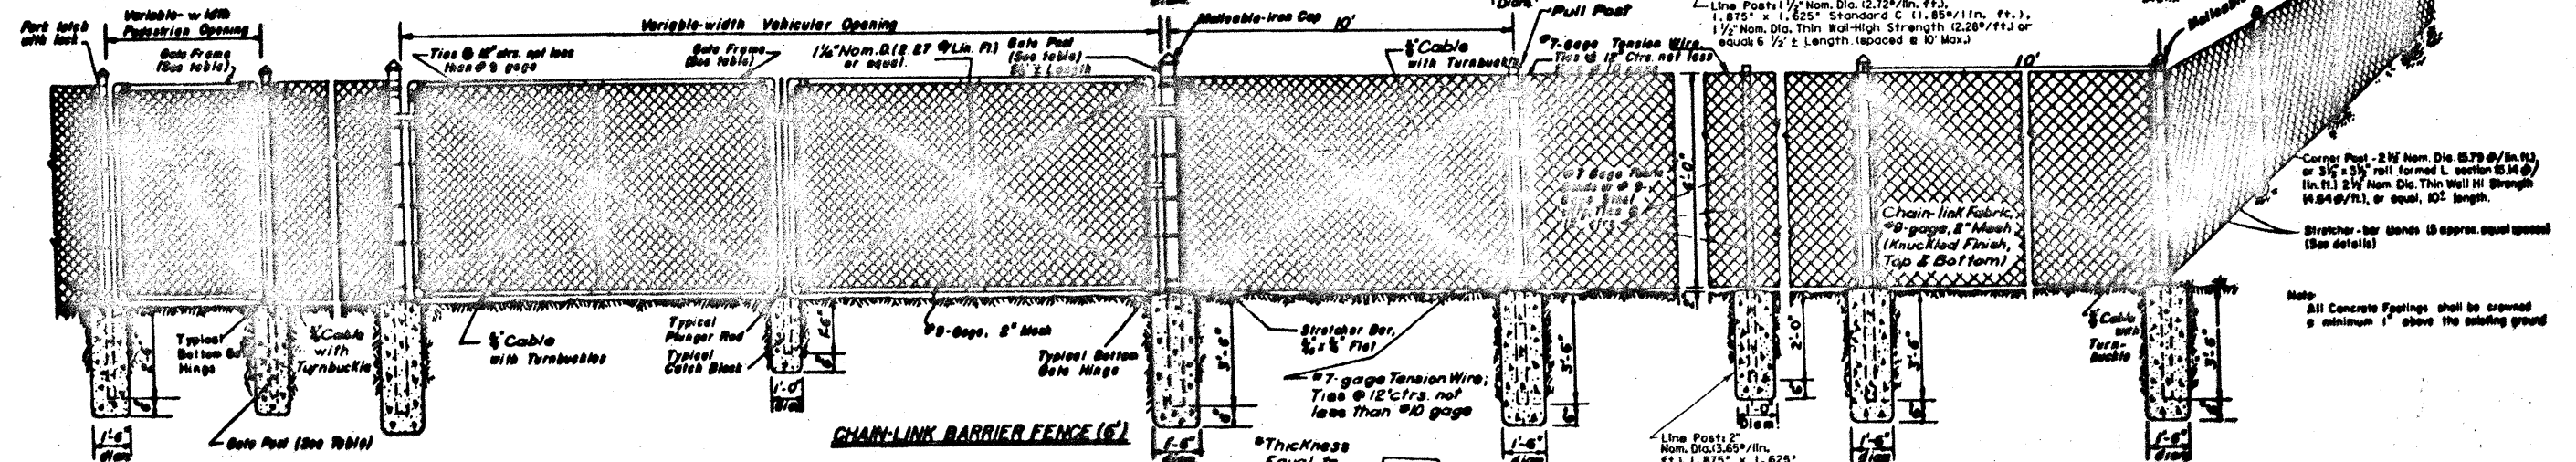


TABLE OF MINIMUM SIZES & WEIGHTS					
<u>GATE OPENING</u>		<u>GATE FRAME</u>		<u>GATE POSTS</u>	
<u>TYPE</u>		<u>SIZE</u>		<u>SIZE</u>	
<u>SINGLE</u>	<u>DOUBLE</u>	<u>WT./IN. FT.</u>	<u>WT./LIN. FT.</u>	<u>WT./LIN. FT.</u>	<u>WT./LIN. FT.</u>

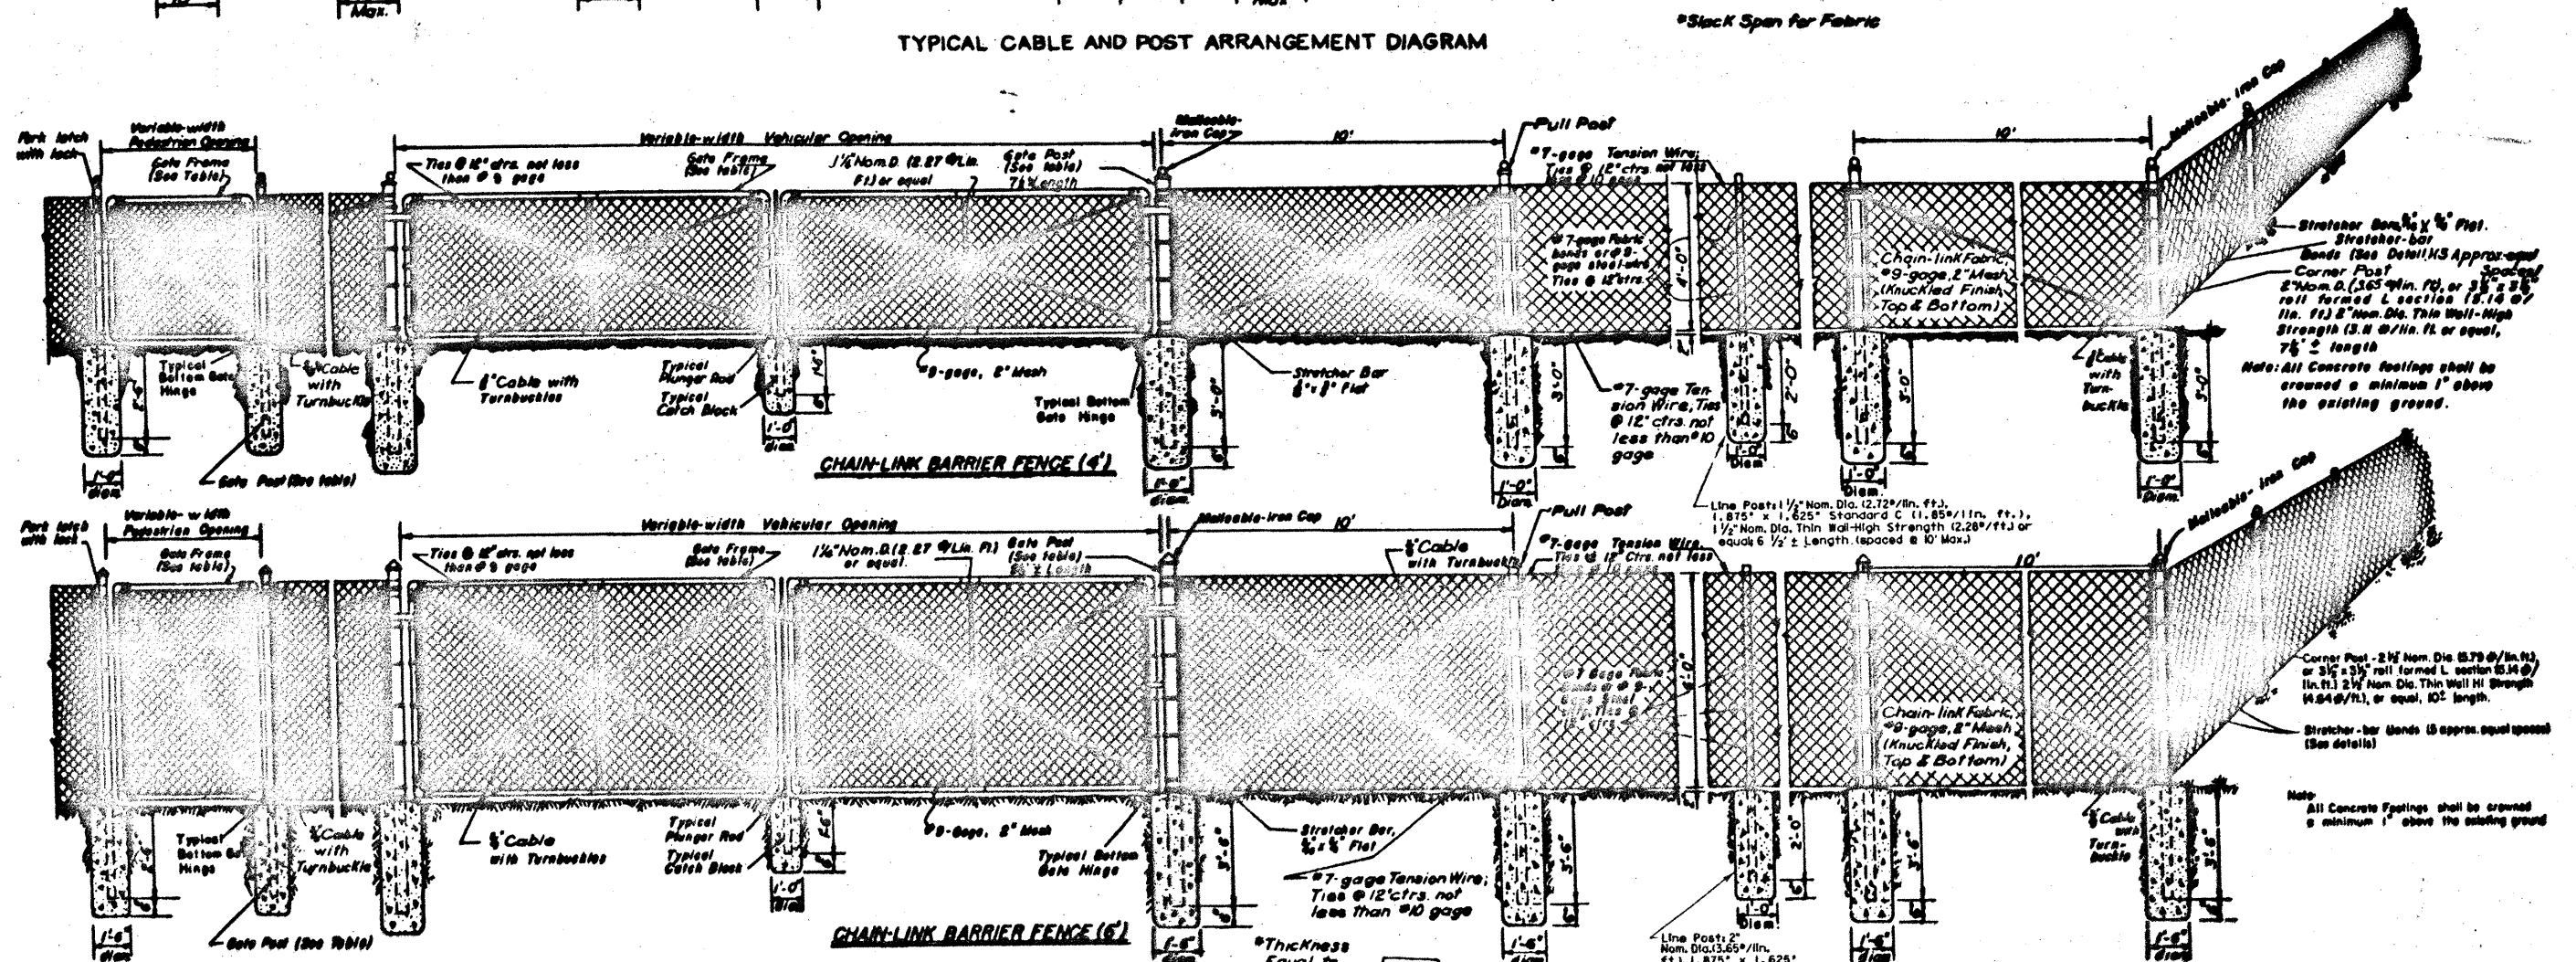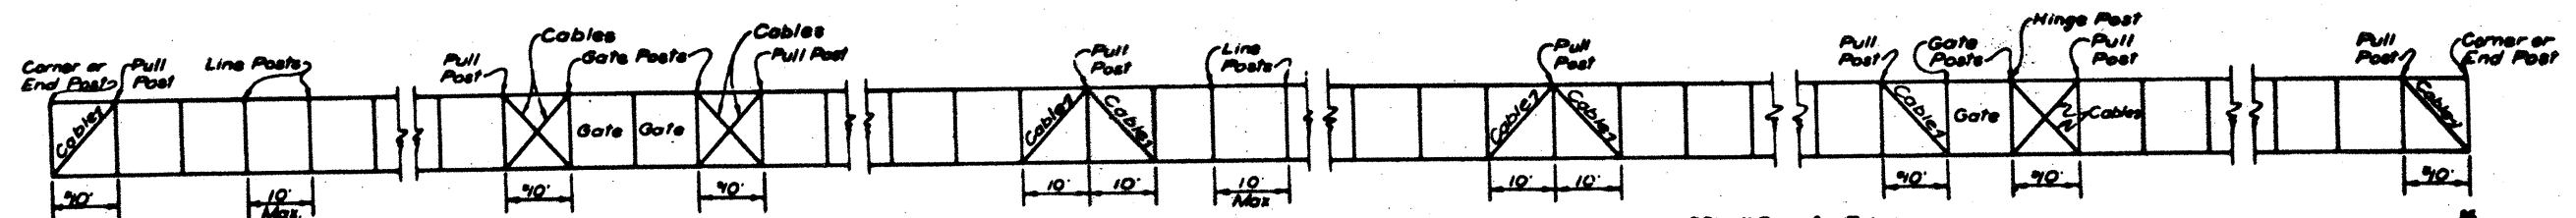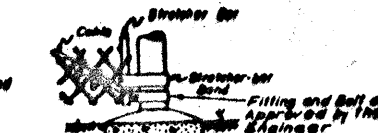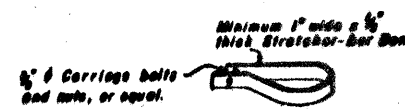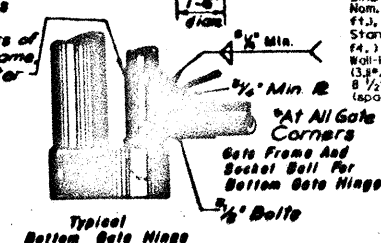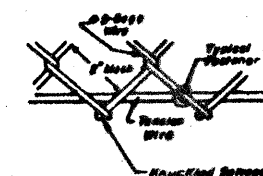

GENERAL NOTES


1. SHALL BE AS SHOWN ELSEWHERE ON THE PLANS OR AS DIRECTED BY THE ENGINEER. LOCATION OF

2. SHALL BE AT FRAME CORNERS, TO JOINT FITTINGS WITH FOUR 1/2" BOLTS PER JOINT.

3. SHALL BE MADE WITH TWO 3/8" CABLE CLAMPS.

4. AND THEIR FOUNDATIONS SHALL HAVE THE SAME RESPECTIVE DIMENSIONS AS THOSE SHOWN FOR

5. SHALL BE ATTACHED DIRECTLY TO FITTINGS WITH A CLEVIS.



STATE DEPARTMENT OF HIGHWAYS
AND PUBLIC TRANSPORTATION








CHAIN-LINK BARRIER FENCE

4 AND 6 FOOT HEIGHT

CLF-90 666

REVISIONS	FED. RD. DIV. NO.	STATE	FEDERAL AID PROJECT NO.	SHEET NO.
	6	TEXAS	HES 0005 (6047)	66
	STATE DIST. NO.	COUNTY	CONTR. SECT. JOB	HIGHWAY NO.
	16	Nueces	74 C 164	45181

A-13

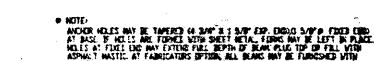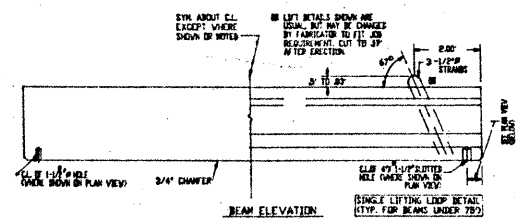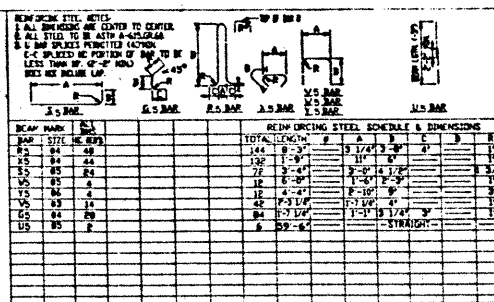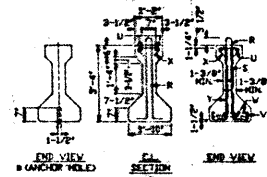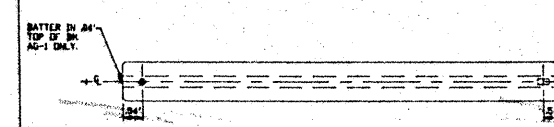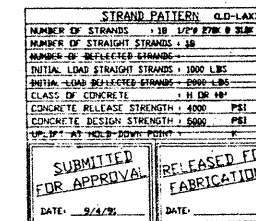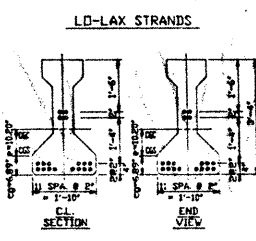[illegible]

SEE STL. DET. 'A
MARKED END


PLAN TYPE NUMBER 1

SEC STL DE1 '4

[illegible]

STATE DEPARTMENT OF HIGHWAYS
AND PUBLIC TRANSPORTATION
APPROVED
BRIDGE DIVISION
SEP 22 1991

APPROVAL OF THIS DRAWING DOES NOT
RELIEVE THE CONTRACTOR OF THE
RESPONSIBILITY FOR THE CORRECTNESS
OF DETAIL.

FOR ERECTION PLANS SEE SHEET 02-1
PLAN NO.
AG-1-3
SPAN #1-3
BEAM #1

TEXAS CONCRETE COMPANY
P.O. BOX 1070 VICTORIA, TEXAS 77901
CUSTOMER HAS PAVING INC
OWNER S.D.H.P.T.
ENGINEER S.D.H.P.T.
STRUCTURE BELDEN STREET DPASS. WIDEN

[illegible]


LEGEND
O.D.-OPTIONAL DESIGN
'e'-ECCENTRICITY

STATE DEPARTMENT OF HIGHWAYS
AND PUBLIC TRANSPORTATION.
APPROVED
BRIDGE DIVISION
SEP 20 1991

APPROVAL OF THIS DRAWING DOES NOT
RELIEVE THE CONTRACTOR OF THE
RESPONSIBILITY FOR THE CORRECTNESS
OF DETAIL





SUBMITTED FOR APPROVAL
RELEASED FOR FABRICATION

BEAM INDEX

 TEXAS CONCRETE COMPANY P.O. DRAWER 1070 VICTORIA, TEXAS 77901	
CUSTOMER	HAS PAVING INC.
OWNER	SUBMIT
ARCHITECT	
ENGINEER	SUBMIT
STRUCTURE	BILLEN STREET (PASS WIDEN)
LOCATION	ARMEDS COUNTY
Drawn by: 10/1/74 Date: 10/1/74 Scale: 1" = 1'-0"	

PAD MARK	NO. REQD.	L	V	H	R	S	T	Z	TYPE	COND. NO. HOLE
PH-30	4	8' 9"	0"	4.50'					1	20 APP.
PH-31	2	8' 9"	0"	4.50'					3	20 APP.
TOTAL	6									

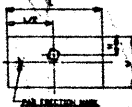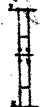ELASTOMERIC PAD SCHEDULE FOR TYPE "C" BEAMS
CONDITION: 20

TYPE #1 TYPE #2 TYPE #3

STATE DEPARTMENT OF HIGHWAY AND PUBLIC TRANSPORTATION
APPROVED
BRIDGE DIVISION

SEP 25 1991

APPROVAL OF THIS DRAWING DOES NOT RELIEVE THE CONTRACTOR OF THE RESPONSIBILITY FOR THE CORRECTNESS OF DETAIL.

NOTE:
1. ALL PADS TO BE 70 DIAMETERS.
2. PADS TO BE PER T&E STANDARD SPEC. 1982, ITEM 435.

ELASTOMERIC BEARING PAD SCHEDULE

TEXAS CONCRETE COMPANY
P.O. BOX 1070 VICTORIA, TEXAS 77901




CUSTOMER: MAAS PAYING, INC.
DESIGN: SCMP
ARCHITECT:
ENGINEER: SCMP
PROJECT: RECONSTRUCTION CONT. 80074-96-104

SUBMITTED FOR APPROVAL

DATE: 9/4/91

RELEASED FOR FABRICATION

DATE:

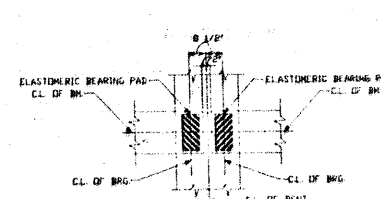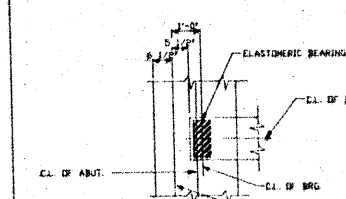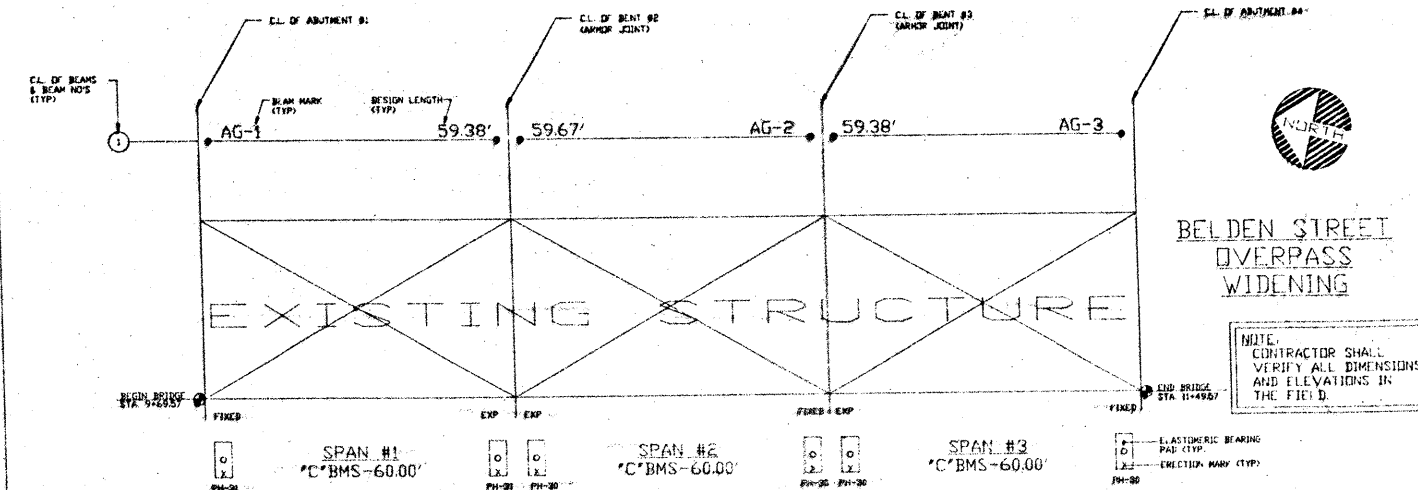

ABUTMENT DETAIL
(TYP. ABUT. #1; OPP. HAND ABUT. #4)

BENT DETAIL
(TYP. BENTS #2&3)

STATE DEPARTMENT OF HIGHWAYS
AND PUBLIC TRANSPORTATION
APPROVED
BIRDGE COUNTY
SEP 26 1991

APPROVAL OF THIS WORKING DRAFT TO
RELIEVE THE CONTRACTOR OF THE
RESPONSIBILITY FOR THE COMPLETION
OF DETAIL

GENERAL NOTES:
1. MARKED END OF BEAMS TO BE PLACED AS SHOWN
2. FOR ELASTOMERIC BEARING PAD NOTES & DETAILS
SEE SH. NP-1
3. FOR FABRICATION DETAILS: SEE SH. F-1
4. -- INDICATES LOCATION OF ANCHOR PINS IN

TOTAL LINEAR 17'-0" RMS = 176.42'	
CONTRACTOR'S OPTIONS	
END DIAGRAM NONE	SLAB OPTION NONE
INT. DIAGRAM NONE	INSERTS NONE

SUBMITTED
 FOR APPROVAL
 DATE: 5/4/79

RELEASED
 LABRICAL
 DATE:

ERECTION PL

TEXAS CONCRETE CORP
PO BOX 1076 VICTORIA TEXAS

CUSTOMER JAMES PAVING INC
OWNER SMCPT
ARCHITECT
ENGINEER SMCPT

TEXAS DEPARTMENT OF HIGHWAYS AND PUBLIC TRANSPORTATION
PRESTRESSED CONCRETE BEAM DESIGN/ANALYSIS - 224179 VER 3.0 MAR 90

PSP NO. 1 COUNTY NUECES HIGHWAY NO. U. S. 181 CONTROL-SECTION-JOB 0074-06-164 CODED BY DATE AUG 30, 1991

1 BELDEN STREET O'PASS O.D. #2 SPAN NO. 2 RM. 1

INPUT DATA SUBMITTED									
BEAM TYPE	SPAN LENGTH C-C BRNG (FT)		BEAM SPAC (FT)	SLAB THICKNESS (IN)	RELATIVE HUMIDITY (PERCENT)				
C	✓	58.58	✓ 7.63	✓ 7.50	✓	75.			
CENTERLINE DESIGN STRESSES				REQUIRED	BEAM CONCRETE STRENGTHS				
TOP (PSI)	BOTTOM (PSI)	ULTIMATE MOMENT (K-FT)	RELEASE (PSI)	28-DAY (PSI)					
✓ 1875.	✓ -2301.	2196.	4000.	5000.					
PRESTRESSING STRANDS			MODULUS OF ELASTICITY	SLAB 28-DAY CONCRETE STRENGTH	LIVE LOAD				
SIZE (IN)	TYPE	STRENGTH (KSI)	BEAM (KSI)	SLAB (KSI)	(PSI)				
1/2*	LO-RLX*	270.*	5000.	5000.	3600.*	HS20*			
CENTERLINE STRAND PATTERN			STRANDS PER ROW / DIST. FROM BEAM BOT. (IN)						
8	6	2	2	0	0	0	0	0	0
2.0	4.0	20.0	22.0	0.0	0.0	0.0	0.0	0.0	0.0
COMPUTED CL ECCENTRICITY = 10.20 IN				NO. OF STRANDS = 18					
END STRAND PATTERN			STRANDS PER ROW / DIST. FROM BEAM BOT. (IN)						
8	6	2	2	0	0	0	0	0	0
2.0	4.0	20.0	22.0	0.0	0.0	0.0	0.0	0.0	0.0
COMPUTED END ECCENTRICITY = 10.20 IN									
ORIGINAL DESIGNED BEAM AS SHOWN ON CONTRACT PLANS:									
NO. OF STRANDS = 16* END ECCENTRICITY = 10.84*				CENTERLINE ECCENTRICITY = 14.34*					
STRAND SIZE = 1/2" IN*				STRAND TYPE = LO-RLX		STRAND STRENGTH = 270. KSI*			

ORIGINAL DESIGNED BEAM AS SHOWN ON CONTRACT PLANS:
NO. OF STRANDS = 16 END ECCENTRICITY = 10.84 CENTERLINE ECCENTRICITY = 14.34
STRAND SIZE = 1/2 IN* STRAND TYPE = LO-RLX STRAND STRENGTH = 270. KSI*

COMPUTED RESULTS									
-- RELEASE --					-- FINAL --				
BEAM TOP FIBER STRESS (PSI)	END HOLD-DOWN	CL	END	CL	BEAM TOP FIBER STRESS (PSI)	END HOLD-DOWN	CL	END	CL
-425.	290.	311.	-379.	1496.	-425.	290.	311.	-379.	1496.
BEAM BOT FIBER STRESS (PSI)	END HOLD-DOWN	CL	END	CL	BEAM BOT FIBER STRESS (PSI)	END HOLD-DOWN	CL	END	CL
2171.	1637.	1621.	1934.	-367.	2171.	1637.	1621.	1934.	-367.
CONC STRENGTH, REQ'D. (PSI)	END HOLD-DOWN	CL	END	CL	CONC STRENGTH, REQ'D. (PSI)	END HOLD-DOWN	CL	END	CL
4000.	4000.	4000.	4000.	5000.	4000.	4000.	4000.	4000.	5000.
BEAM ALLOWABLE TENSION (PSI)	END HOLD-DOWN	CL	END	CL	BEAM ALLOWABLE TENSION (PSI)	END HOLD-DOWN	CL	END	CL
-474.	(RELEASE)	-424.	(FINAL)	-474.	-474.	(RELEASE)	-424.	(FINAL)	-474.
BEAM ALLOWABLE COMPRESSION (PSI)	END HOLD-DOWN	CL	END	CL	BEAM ALLOWABLE COMPRESSION (PSI)	END HOLD-DOWN	CL	END	CL
2400.	(RELEASE)	2000.	(FINAL)	2400.	2400.	(RELEASE)	2000.	(FINAL)	2400.
ULTIMATE MOMENT PROVIDED (K-FT)	END HOLD-DOWN	CL	END	CL	ULTIMATE MOMENT PROVIDED (K-FT)	END HOLD-DOWN	CL	END	CL
2369.					2369.				

*** BEAM SATISFIES ALL DESIGN REQUIREMENTS ***
WARNING: RATIO OF INPUT BEAM TOP FIBER STRESS TO CALCULATED TOTAL EXTERNAL LOAD TOP FIBER STRESS = 0.95238

MAXIMUM CAMBER, ORIGINAL DESIGN (FT) = 0.098 UPWARD IS POSITIVE
MAXIMUM CAMBER, (FT) = 0.077 UPWARD IS POSITIVE

TEXAS DEPARTMENT OF HIGHWAYS AND PUBLIC TRANSPORTATION
PRESTRESSED CONCRETE BEAM DESIGN/ANALYSIS - 224179 VER 3.0 MAR 90

PSP NO. 1 COUNTY NUECES HIGHWAY NO. U. S. 181 CONTROL-SECTION-JOB 0074-06-164 CODED BY DATE AUG 30, 1991

1 BELDEN STREET O'PASS O.D. #1 SPANS NO. 1 & 3 RM. NO. 1

INPUT DATA SUBMITTED									
BEAM TYPE	SPAN LENGTH C-C BENTH (FT)		BEAM SPAC (FT)	SLAB THICKNESS (IN)	RELATIVE HUMIDITY (PERCENT)				
C	58.30		7.63	7.50	75.				
CENTERLINE DESIGN STRESSES									
TOP (PSI)		BOTTOM (PSI)		REQUIRED ULTIMATE MOMENT (K-FT)	BEAM CONCRETE STRENGTHS RELEASE 28-DAY (PSI)				
1994.		-2384.		2233.	4000.	5000.			
PRESTRESSING STRANDS					MODULUS OF ELASTICITY		SLAB 28-DAY CONCRETE STRENGTH (PSI)	LIVE LOAD	
SIZE (IN)	TYPE	STRENGTH (KSI)		BEAM (KSI)	SLAB (KSI)	3600.*		HS20*	
1/2"	LO-RLX*	270.*		5000.	5000.				
CENTERLINE STRAND PATTERN					STRANDS PER ROW / DIST. FROM BEAM BOT. (IN)				
8 6 2 0 0 0 0 0 0 0					0 0 0 0 0 0 0 0 0 0				
2.0 4.0 20.0 22.0 0.0 0.0 0.0 0.0 0.0 0.0					0.0 0.0 0.0 0.0 0.0 0.0 0.0 0.0 0.0				
COMPUTED CL ECCENTRICITY =					10.20 IN		NO. OF STRANDS = 18		
END STRAND PATTERN					STRANDS PER ROW / DIST. FROM BEAM BOT. (IN)				
8 6 2 2 0 0 0 0 0 0					0 0 0 0 0 0 0 0 0 0				
2.0 4.0 20.0 22.0 0.0 0.0 0.0 0.0 0.0 0.0					0.0 0.0 0.0 0.0 0.0 0.0 0.0 0.0 0.0				
COMPUTED END ECCENTRICITY =					10.20 IN				
ORIGINAL DESIGNED BEAM AS SHOWN ON CONTRACT PLANS:									
NO. OF STRANDS = 16 AND ECCENTRICITY = 10.84" CENTERLINE ECCENTRICITY = 14.3"									
STRAND SIZE = 1/2 IN" STRAND TYPE = LO-RLX STRAND STRENGTH = 270. KSI									


ORIGINAL DESIGNED BEAM AS SHOWN ON CONTRACT PLANS:
NO. OF STRANDS = 16 END ECCENTRICITY = 10.84 CENTERLINE ECCENTRICITY = 14.34
STRAND SIZE = 1/2 IN* STRAND TYPE = LO-RLX STRAND STRENGTH = 270. KSI*

COMPUTED RESULTS									
-- RELEASE --					-- FINAL --				
BEAM TOP FIBER STRESS (PSI)	END HOLD-DOWN	CL	END	CL	BEAM TOP FIBER STRESS (PSI)	END HOLD-DOWN	CL	END	CL
-425.	283.	304.	-378.	1616.	-425.	283.	304.	-378.	1616.
BEAM BOT FIBER STRESS (PSI)	END HOLD-DOWN	CL	END	CL	BEAM BOT FIBER STRESS (PSI)	END HOLD-DOWN	CL	END	CL
2170.	1643.	1627.	1933.	-451.	2170.	1643.	1627.	1933.	-451.
CONC STRENGTH, REQ'D. (PSI)	END HOLD-DOWN	CL	END	CL	CONC STRENGTH, REQ'D. (PSI)	END HOLD-DOWN	CL	END	CL
4000.	4000.	4000.	4000.	5000.	4000.	4000.	4000.	4000.	5000.
BEAM ALLOWABLE TENSION (PSI)	END HOLD-DOWN	CL	END	CL	BEAM ALLOWABLE TENSION (PSI)	END HOLD-DOWN	CL	END	CL
-474.	(RELEASE)	-424.	(FINAL)	-474.	-474.	(RELEASE)	-424.	(FINAL)	-474.
BEAM ALLOWABLE COMPRESSION (PSI)	END HOLD-DOWN	CL	END	CL	BEAM ALLOWABLE COMPRESSION (PSI)	END HOLD-DOWN	CL	END	CL
2400.	(RELEASE)	2000.	(FINAL)	2400.	2400.	(RELEASE)	2000.	(FINAL)	2400.
ULTIMATE MOMENT PROVIDED (K-FT)	END HOLD-DOWN	CL	END	CL	ULTIMATE MOMENT PROVIDED (K-FT)	END HOLD-DOWN	CL	END	CL
2369.					2369.				

*** BEAM DOES NOT SATISFY DESIGN REQUIREMENTS ***
1- FINAL BOTTOM FIBER TENSION AT CL IS HIGH.
2- RATIO OF INPUT P' C TO CALCULATED REQ' D, P' C = 0.88386

MAXIMUM CAMBER, ORIGINAL DESIGN (FT) = 0.098 UPWARD IS POSITIVE
MAXIMUM CAMBER, (FT) = 0.076 UPWARD IS POSITIVE

M.L.R.
PLEASE REVIEW
THANKS
9-3-91
OK
mte

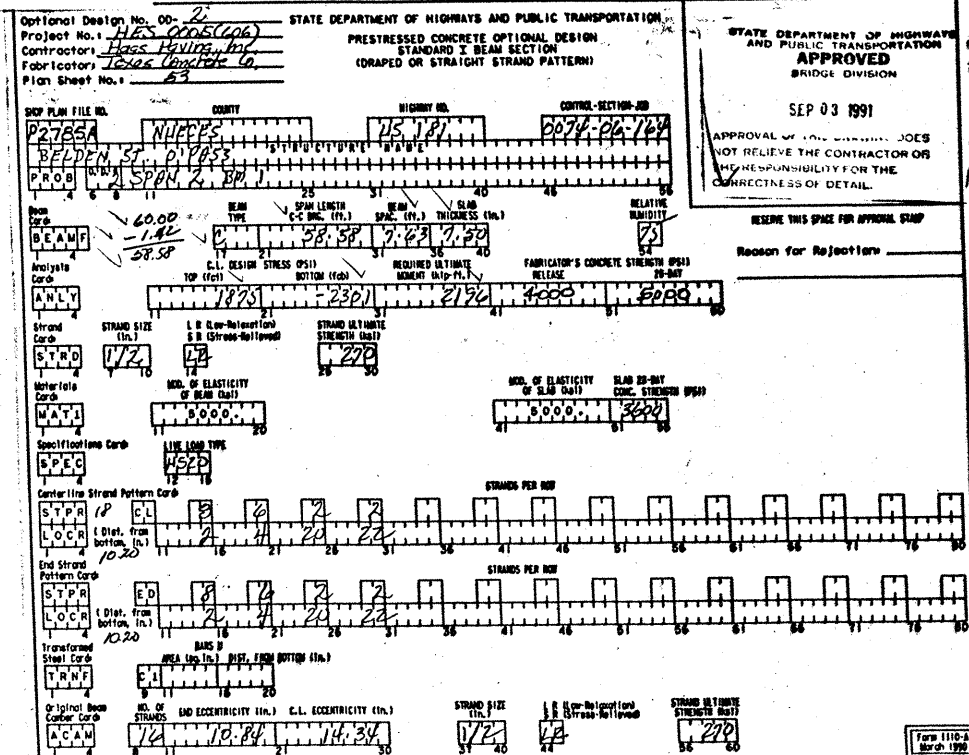

TEXAS CONCRETE COMPANY
POST OFFICE DRAWER - 1070
VICTORIA, TEXAS 77901
Phone (512) 572-9145

TO: Mr. Arnold W. Oliver
State Dept. of Highways & Public Transp.
11th and Brazos Streets
Austin, Texas 78701

DATE: 8/27/91 JOB NO. 393
ATTENTION: Mr. Luis Ybanez D-5
RE: Nueces Co. S S
Project HES 0005 (606)
Control 0074-06-164
P-2785-A
LET: 7/91

Gentlemen: We are forwarding ☒ attached ☐ under separate cover via the following route:
☒ Shop Drawings ☐ Prints ☐ Specification
☐ Copy of Letter ☐ Plans ☐

COPIES	DATE	DWG. NO.	SHEET NO.	DESCRIPTION
1		001-2	Optional Designs	

These are transmitted as checked below:
☒ For Approval ☐ As Built Drawings ☐ For Your File
☐ Final Approval ☐ Plans for Deposit Refund of ☐ Setting & Erection
☐ For Your Use ☐ For Review & Comments ☐ Descriptive Literature Requested

REMARKS:
RECEIVED
AUG 30 1991
BRIDGE DIVISION

C. C. TO: SIGNED: [Signature]

County: Nueces
Controls: 0074-06-164
Projects: HES 0005 (606)
Highways: US 181
Structure: Belden Street O'Pass

Texas Concrete Company, Inc.
P. O. Drawer 1070
Victoria, TX 77902-1070

Attention: Mr. Burson Patton

Gentlemen:

We are returning herewith your Optional Design Data, O.D. Nos. 1 through 2, approved for preparation of shop drawings.

Sincerely,
Original Signed For
Luis Ybanez, P.E.
Luis Ybanez, P.E.
Bridge Engineer 8991



cc: Corpus Christi District (Dist. 16)

8-2

[illegible]

SCHEDULE OF PANEL DIMENSIONS	TOTAL AREA THIS TABLE	SCHEDULE OF PANEL DIMENSIONS	TOTAL AREA THIS TABLE	SCHEDULE OF PANEL DIMENSIONS	TOTAL AREA THIS TABLE	SCHEDULE OF PANEL DIMENSIONS	TOTAL AREA THIS TABLE
PANEL MARK	NO. REOD	PANEL MARK	NO. REOD	PANEL MARK	NO. REOD	PANEL MARK	NO. REOD
MIN. WY. WIDTH	MIN. WY. WIDTH	MIN. WY. WIDTH	MIN. WY. WIDTH	MIN. WY. WIDTH	MIN. WY. WIDTH	MIN. WY. WIDTH	MIN. WY. WIDTH
BAR U TYPE	BAR U TYPE	BAR U TYPE	BAR U TYPE	BAR U TYPE	BAR U TYPE	BAR U TYPE	BAR U TYPE
BAR A	BAR A	BAR A	BAR A	BAR A	BAR A	BAR A	BAR A
AREA/PANEL	AREA/PANEL	AREA/PANEL	AREA/PANEL	AREA/PANEL	AREA/PANEL	AREA/PANEL	AREA/PANEL
AREA/STRIP	AREA/STRIP	AREA/STRIP	AREA/STRIP	AREA/STRIP	AREA/STRIP	AREA/STRIP	AREA/STRIP

TEXAS DEPARTMENT OF TRANSPORTATION
APPROVED
NOV 27 1991
APPROVAL OF THIS DRAWING DOES NOT RELIEVE THE CONTRACTOR OF THE RESPONSIBILITY FOR THE CORRECTNESS OF DETAIL.

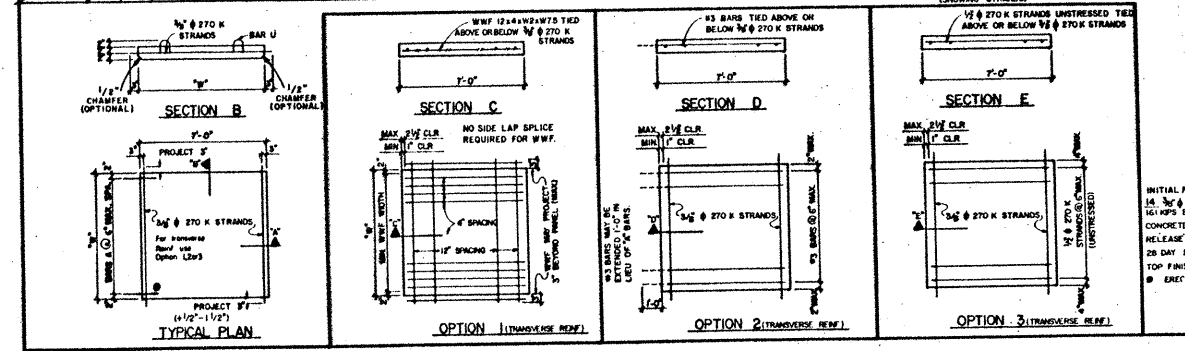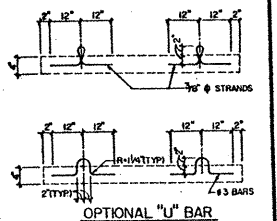



INITIAL FORCE 2,000 LB STRAND
CONCRETE CLASS H
RELEASE STRENGTH 5,000 PSI
28 DAY STRENGTH 5,000 PSI
TOP FINISH 3,000 PSI
ELECTION MARK


GIFFORD-HILL PRESTRESS CO., INC.
VICTORIA, TEXAS
CONTRACTOR: HELDENFELD BROS., INC.

SCHEDULE OF PANEL DIMENSIONS	TOTAL AREA THIS TABLE	SCHEDULE OF PANEL DIMENSIONS	TOTAL AREA THIS TABLE	SCHEDULE OF PANEL DIMENSIONS	TOTAL AREA THIS TABLE	SCHEDULE OF PANEL DIMENSIONS	TOTAL AREA THIS TABLE
PANEL MARK	NO. REOD	PANEL MARK	NO. REOD	PANEL MARK	NO. REOD	PANEL MARK	NO. REOD
MIN. WY. WIDTH	MIN. WY. WIDTH	MIN. WY. WIDTH	MIN. WY. WIDTH	MIN. WY. WIDTH	MIN. WY. WIDTH	MIN. WY. WIDTH	MIN. WY. WIDTH
BAR U TYPE	BAR U TYPE	BAR U TYPE	BAR U TYPE	BAR U TYPE	BAR U TYPE	BAR U TYPE	BAR U TYPE
BAR A	BAR A	BAR A	BAR A	BAR A	BAR A	BAR A	BAR A
AREA/PANEL	AREA/PANEL	AREA/PANEL	AREA/PANEL	AREA/PANEL	AREA/PANEL	AREA/PANEL	AREA/PANEL
AREA/STRIP	AREA/STRIP	AREA/STRIP	AREA/STRIP	AREA/STRIP	AREA/STRIP	AREA/STRIP	AREA/STRIP

TEXAS DEPARTMENT OF TRANSPORTATION
APPROVED
NOV 27 1991
APPROVAL OF THIS DRAWING DOES NOT RELIEVE THE CONTRACTOR OF THE RESPONSIBILITY FOR THE CORRECTNESS OF DETAIL.

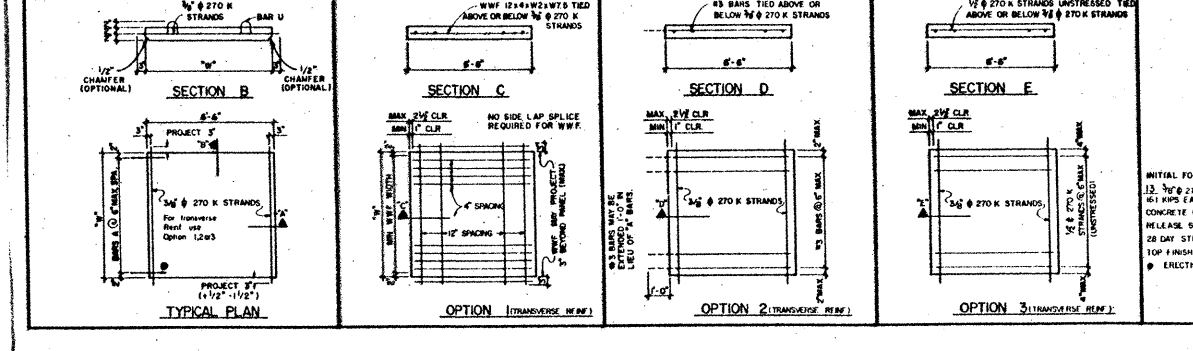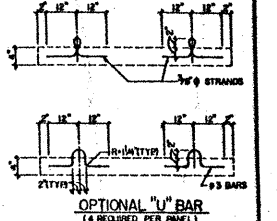



INITIAL FORCE 2,000 LB STRAND
CONCRETE CLASS H
RELEASE STRENGTH 5,000 PSI
28 DAY STRENGTH 5,000 PSI
TOP FINISH 3,000 PSI
ELECTION MARK


GIFFORD-HILL PRESTRESS CO., INC.
VICTORIA, TEXAS
CONTRACTOR: HELDENFELD BROS., INC.

SCHEDULE OF PANEL DIMENSIONS	TOTAL AREA THIS TABLE	SCHEDULE OF PANEL DIMENSIONS	TOTAL AREA THIS TABLE	SCHEDULE OF PANEL DIMENSIONS	TOTAL AREA THIS TABLE	SCHEDULE OF PANEL DIMENSIONS	TOTAL AREA THIS TABLE
PANEL MARK	NO. REOD	PANEL MARK	NO. REOD	PANEL MARK	NO. REOD	PANEL MARK	NO. REOD
MIN. WY. WIDTH	MIN. WY. WIDTH	MIN. WY. WIDTH	MIN. WY. WIDTH	MIN. WY. WIDTH	MIN. WY. WIDTH	MIN. WY. WIDTH	MIN. WY. WIDTH
BAR U TYPE	BAR U TYPE	BAR U TYPE	BAR U TYPE	BAR U TYPE	BAR U TYPE	BAR U TYPE	BAR U TYPE
BAR A	BAR A	BAR A	BAR A	BAR A	BAR A	BAR A	BAR A
AREA/PANEL	AREA/PANEL	AREA/PANEL	AREA/PANEL	AREA/PANEL	AREA/PANEL	AREA/PANEL	AREA/PANEL
AREA/STRIP	AREA/STRIP	AREA/STRIP	AREA/STRIP	AREA/STRIP	AREA/STRIP	AREA/STRIP	AREA/STRIP

TEXAS DEPARTMENT OF TRANSPORTATION
APPROVED
NOV 27 1991
APPROVAL OF THIS DRAWING DOES NOT RELIEVE THE CONTRACTOR OF THE RESPONSIBILITY FOR THE CORRECTNESS OF DETAIL.

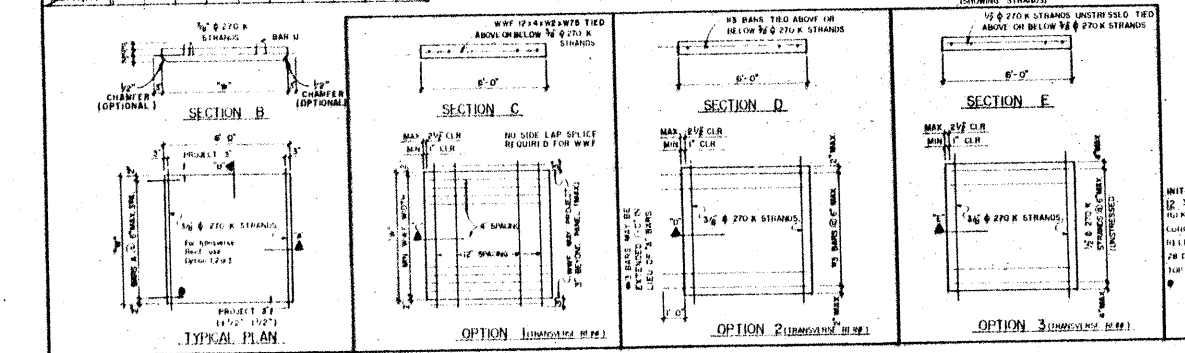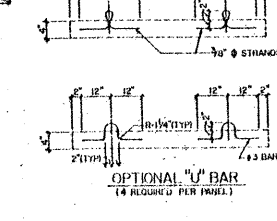



INITIAL FORCE 2,000 LB STRAND
CONCRETE CLASS H
RELEASE STRENGTH 5,000 PSI
28 DAY STRENGTH 5,000 PSI
TOP FINISH 3,000 PSI
ELECTION MARK


GIFFORD-HILL PRESTRESS CO., INC.
VICTORIA, TEXAS
CONTRACTOR: HELDENFELD BROS., INC.

SCHEDULE OF PANEL DIMENSIONS	TOTAL AREA THIS TABLE	SCHEDULE OF PANEL DIMENSIONS	TOTAL AREA THIS TABLE	SCHEDULE OF PANEL DIMENSIONS	TOTAL AREA THIS TABLE	SCHEDULE OF PANEL DIMENSIONS	TOTAL AREA THIS TABLE
PANEL MARK	NO. REOD	PANEL MARK	NO. REOD	PANEL MARK	NO. REOD	PANEL MARK	NO. REOD
MIN. WY. WIDTH	MIN. WY. WIDTH	MIN. WY. WIDTH	MIN. WY. WIDTH	MIN. WY. WIDTH	MIN. WY. WIDTH	MIN. WY. WIDTH	MIN. WY. WIDTH
BAR U TYPE	BAR U TYPE	BAR U TYPE	BAR U TYPE	BAR U TYPE	BAR U TYPE	BAR U TYPE	BAR U TYPE
BAR A	BAR A	BAR A	BAR A	BAR A	BAR A	BAR A	BAR A
AREA/PANEL	AREA/PANEL	AREA/PANEL	AREA/PANEL	AREA/PANEL	AREA/PANEL	AREA/PANEL	AREA/PANEL
AREA/STRIP	AREA/STRIP	AREA/STRIP	AREA/STRIP	AREA/STRIP	AREA/STRIP	AREA/STRIP	AREA/STRIP

TEXAS DEPARTMENT OF TRANSPORTATION
APPROVED
NOV 27 1991
APPROVAL OF THIS DRAWING DOES NOT RELIEVE THE CONTRACTOR OF THE RESPONSIBILITY FOR THE CORRECTNESS OF DETAIL.



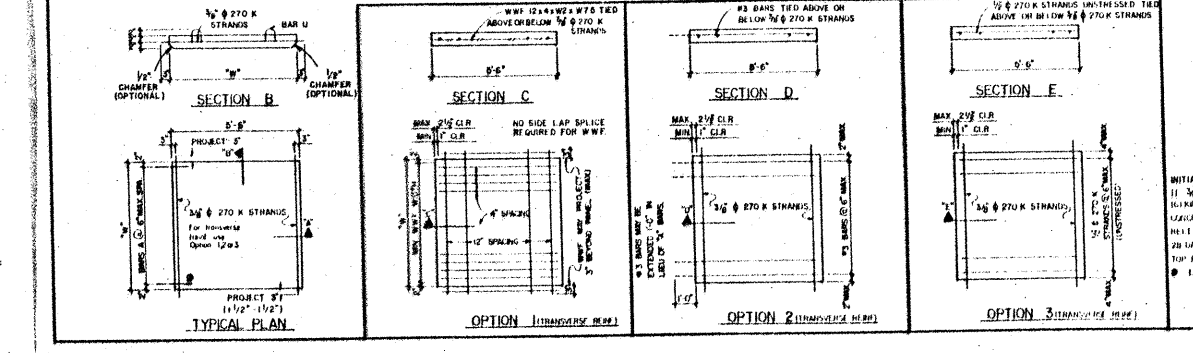
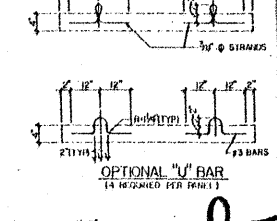


INITIAL FORCE 2,000 LB STRAND
CONCRETE CLASS H
RELEASE STRENGTH 5,000 PSI
28 DAY STRENGTH 5,000 PSI
TOP FINISH 3,000 PSI
ELECTION MARK


GIFFORD-HILL PRESTRESS CO., INC.
VICTORIA, TEXAS
CONTRACTOR: HELDENFELD BROS., INC.

8-5

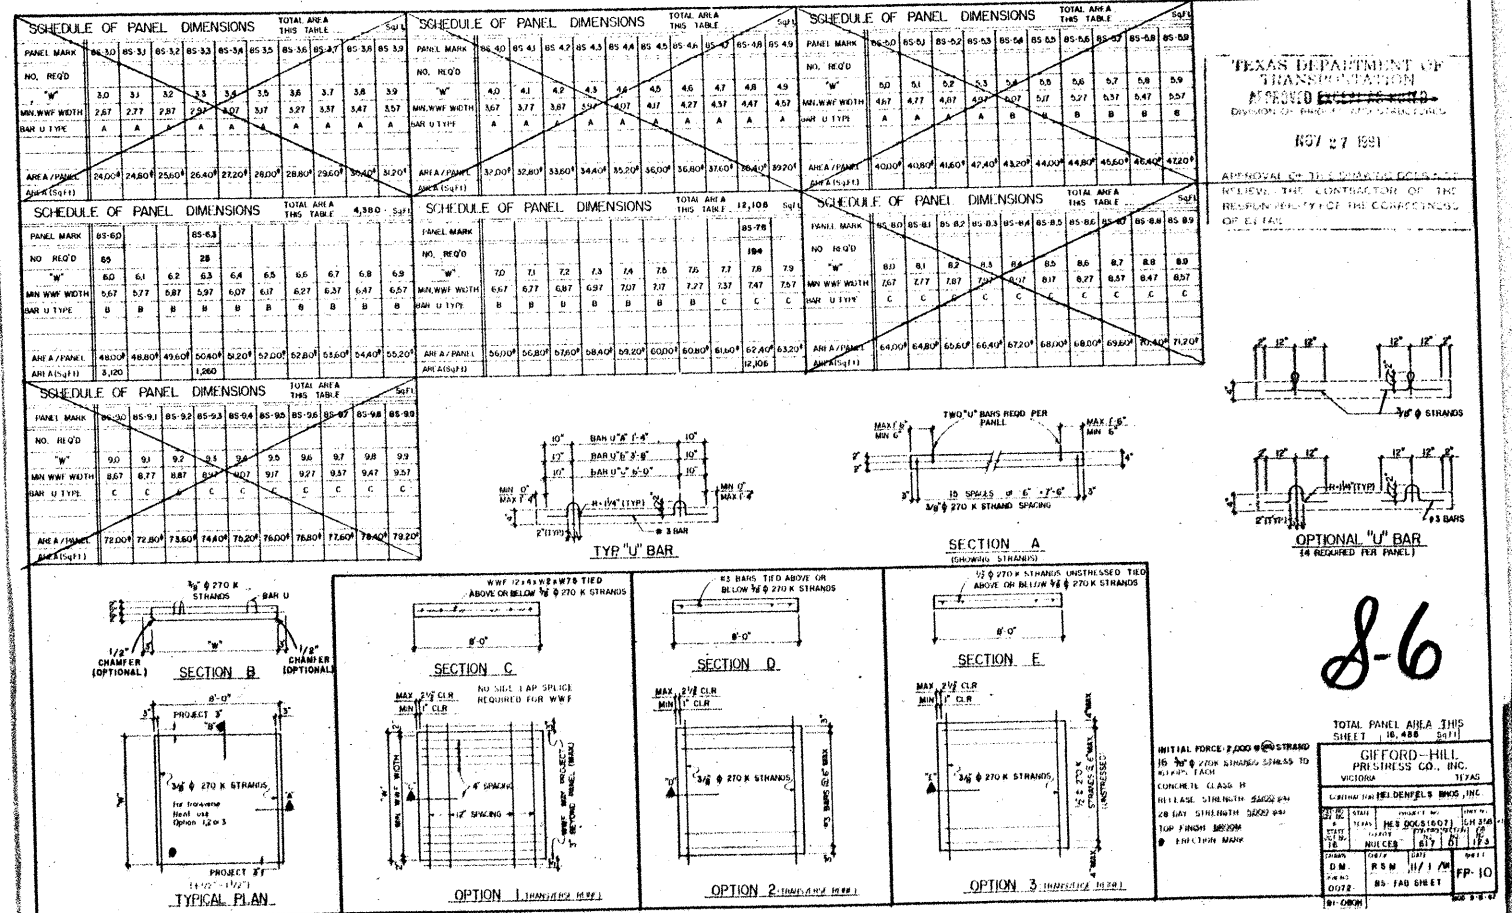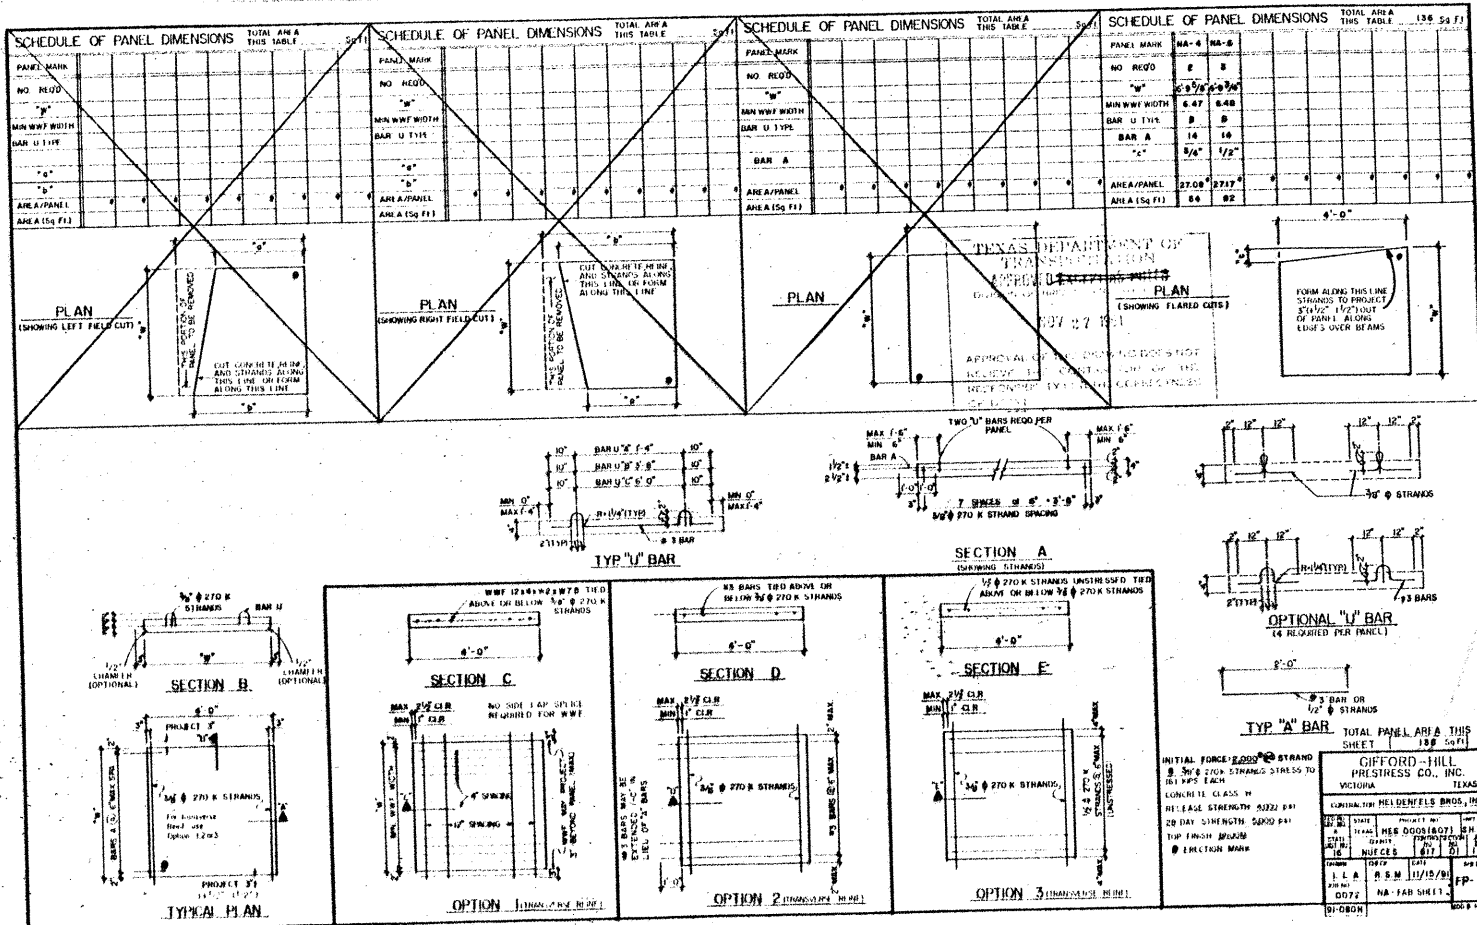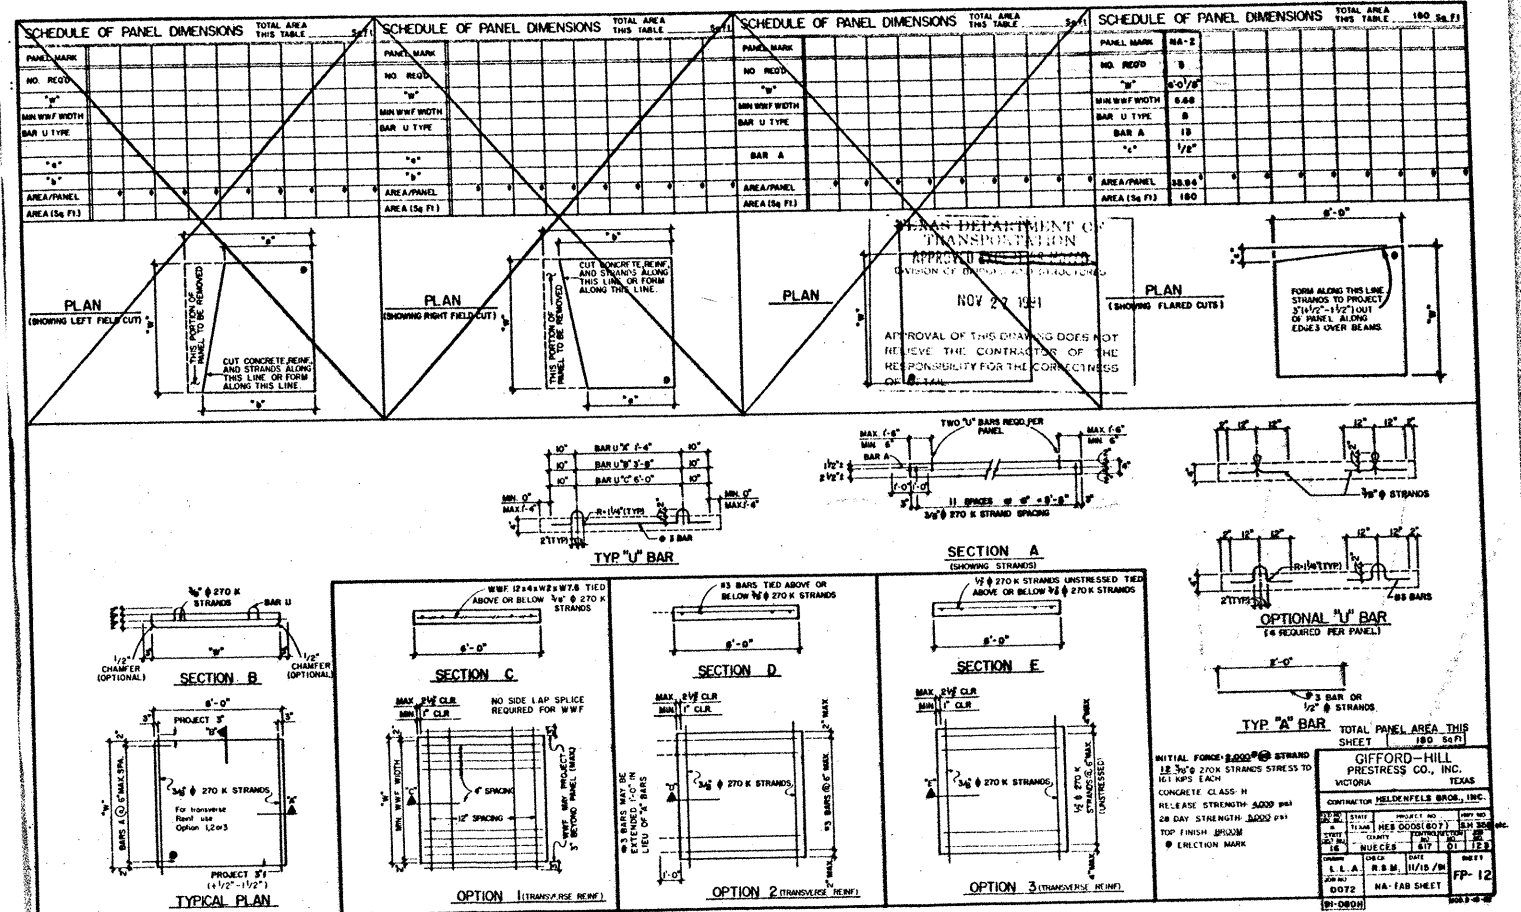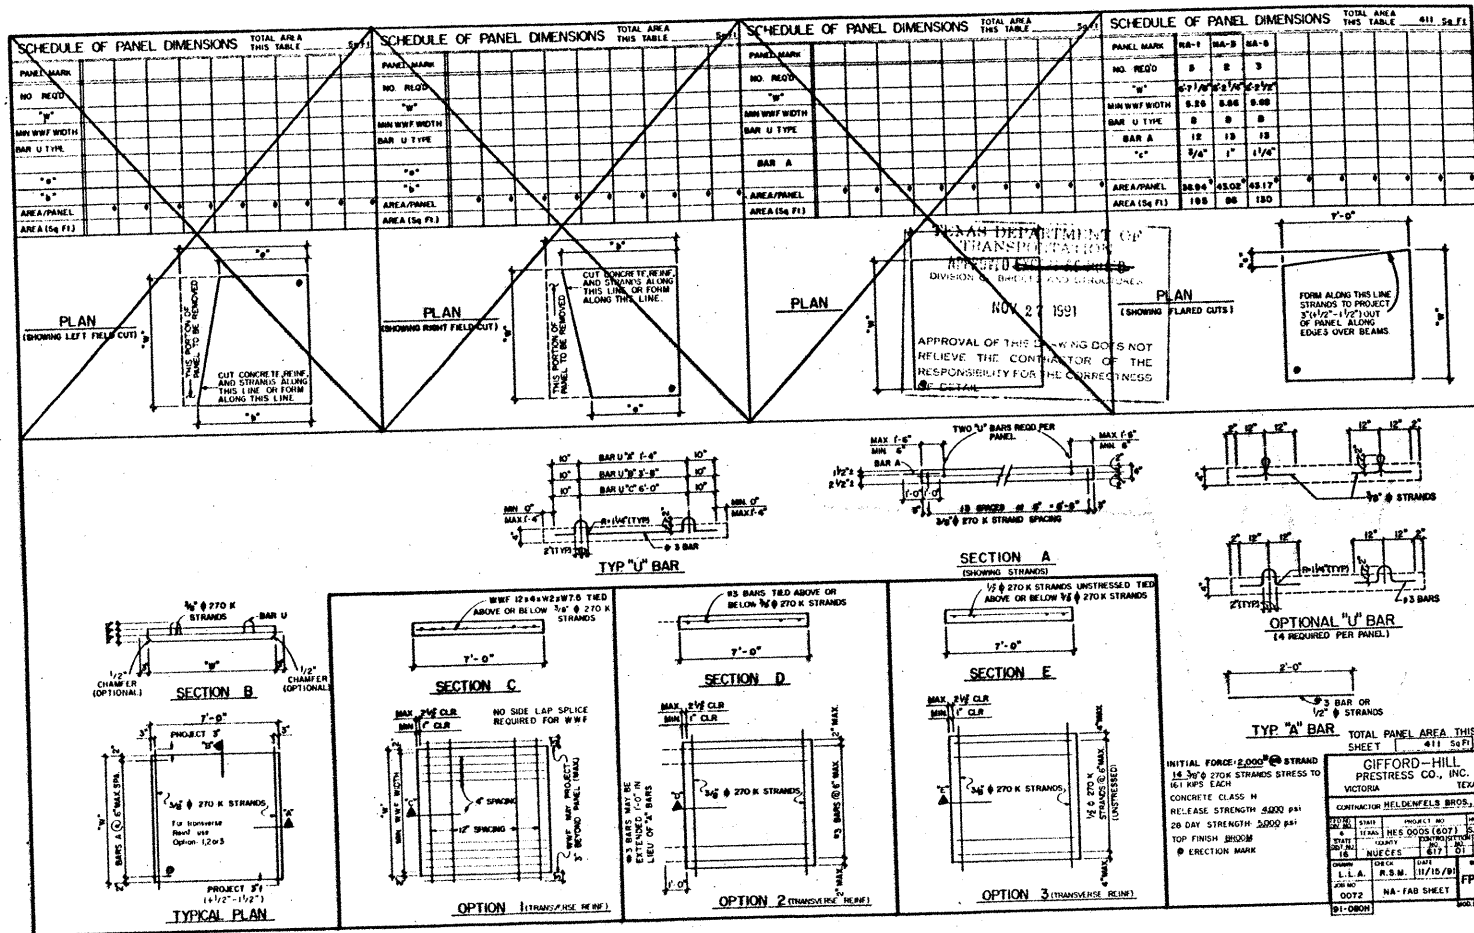

8-6

